




S.S. UPPER VERICAL PLATE
 MARK: EUA1
 PL 1/2" x 5 1/2" x 14 1/2"
 ASTM A240 TYPE 304 (UNPAINTED)
 (32) REQUIRED

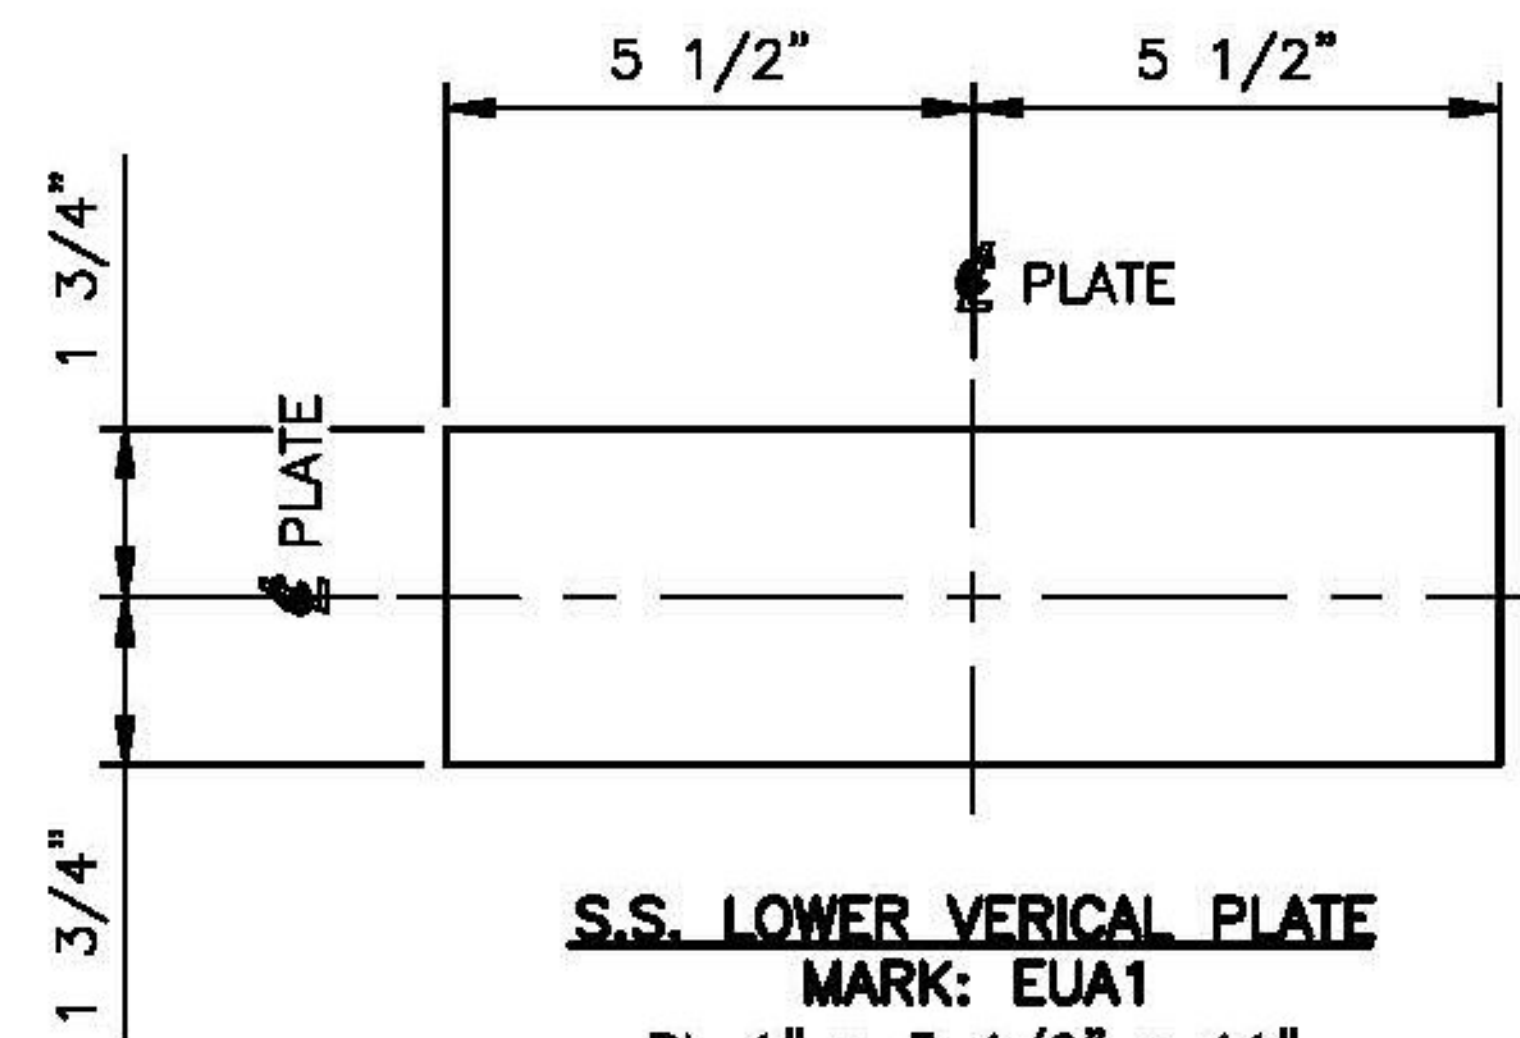

S.S. LOWER VERICAL PLATE
 MARK: EUA1
 PL 1" x 3 1/2" x 11"
 ASTM A240 TYPE 304 (UNPAINTED)
 (32) REQUIRED

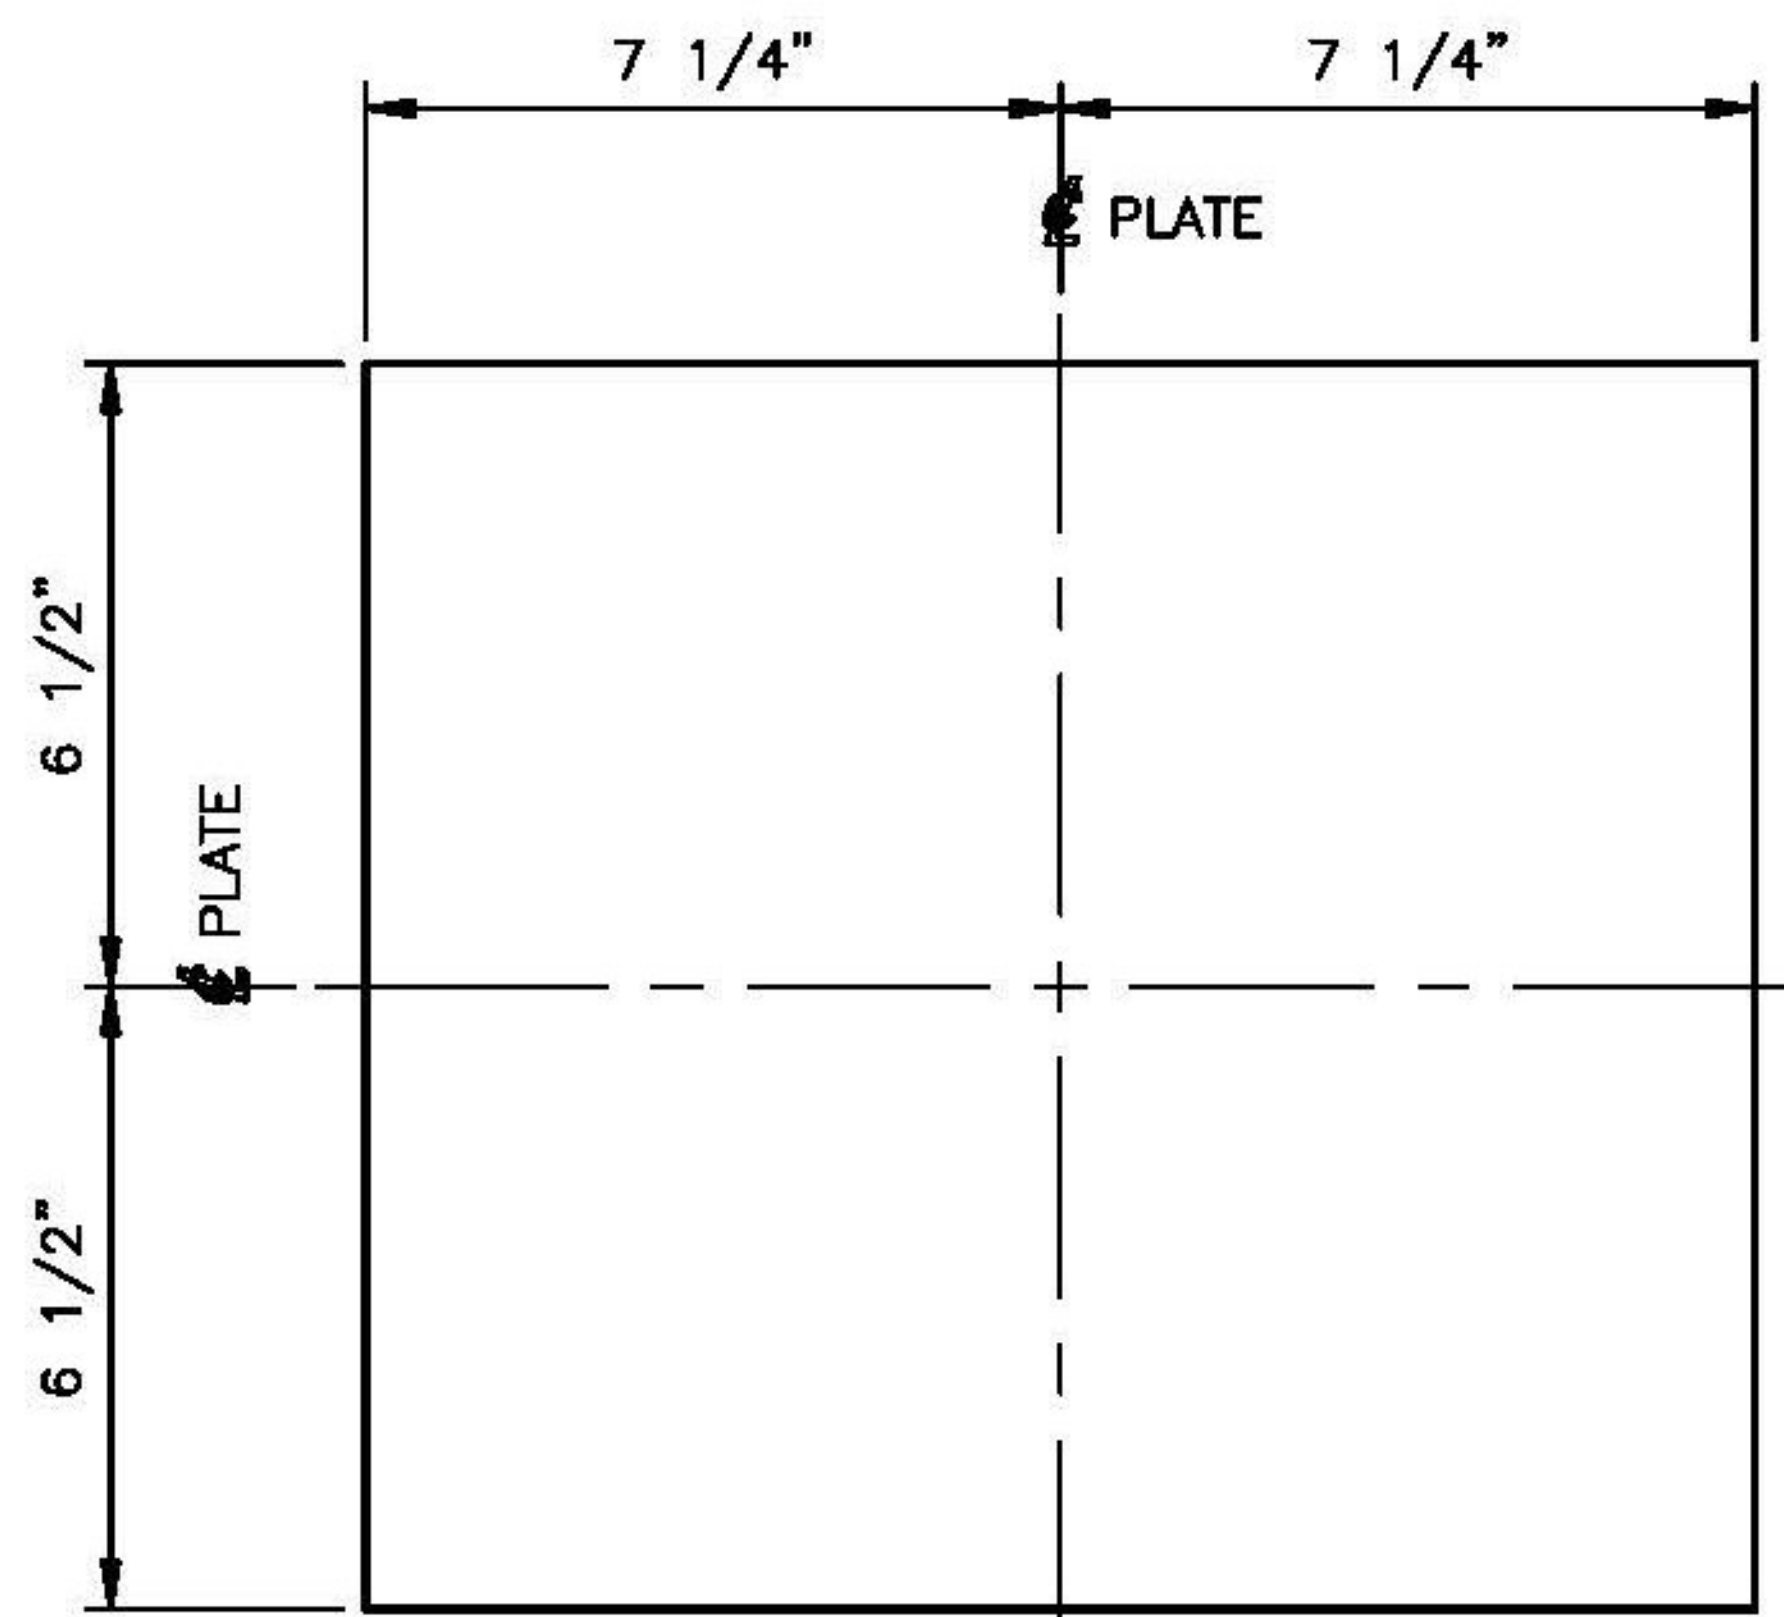

S.S. UPPER BASE PLATE
 MARK: EUA1
 PL 3/8" x 13" x 14 1/2"
 ASTM A240 TYPE 304 (UNPAINTED)
 (16) REQUIRED

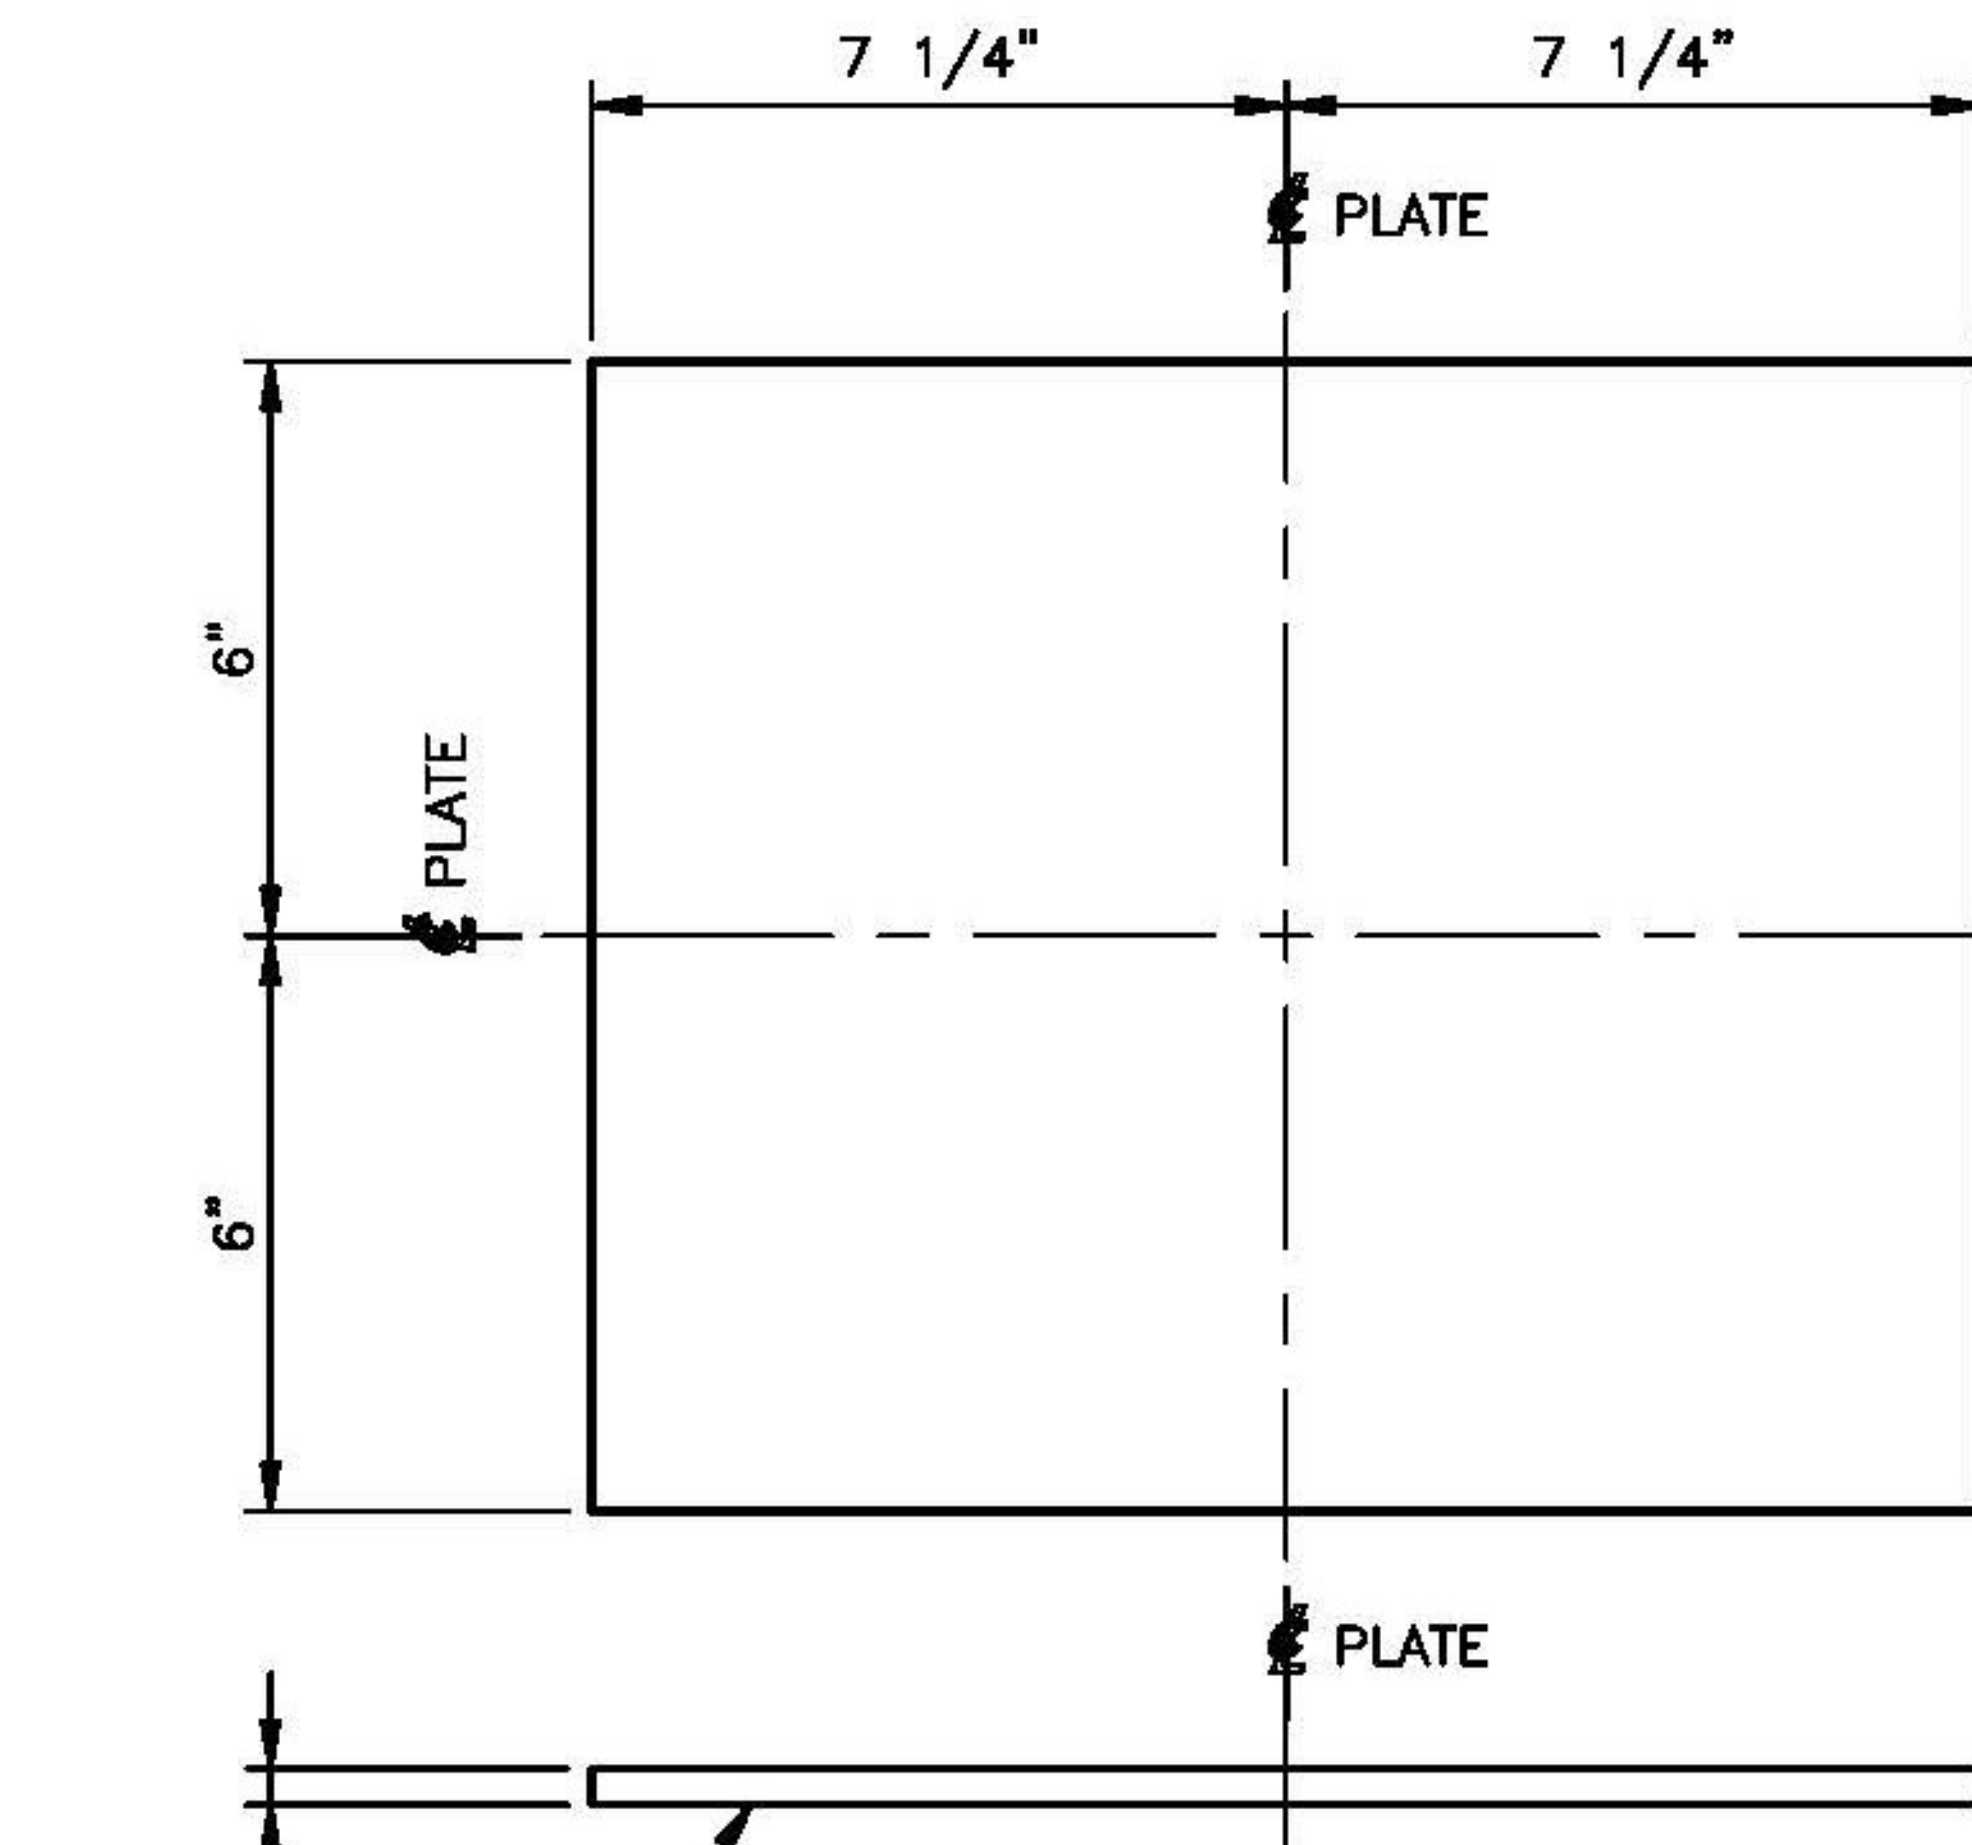

S.S. LOWER BASE PLATE
 MARK: EUA1
 PL 3/8" x 12" x 14 1/2"
 ASTM A240 TYPE 304 (UNPAINTED)
 (16) REQUIRED

Vermont Agency of Transportation

RECEIVED

ON: June 11, 2014

and Checked for

CONFORMANCE

BY: Jennifer Fitch DATE: 06/18/2014

T.Y. LIN INTERNATIONAL

THE STAMPED DOCUMENTS ARE HEREBY:

- APPROVED
- APPROVED AS NOTED
- REVISE AND RESUBMIT

SEE TRANSMITTAL FOR ADDITIONAL INFORMATION AS APPLICABLE.

THIS REVIEW IS FOR GENERAL CONFORMANCE WITH DESIGN CONCEPT ONLY. ANY DEVIATION FROM THE PLANS OR SPECIFICATIONS NOT CLEARLY NOTED BY THE CONTRACTOR HAS NOT BEEN REVIEWED. REVIEW BY THE ENGINEER SHALL NOT RELIEVE THE CONTRACTOR OF THE CONTRACTUAL RESPONSIBILITY FOR ANY ERRORS OR DEVIATION FROM THE CONTRACT REQUIREMENTS.

JOSH OLUND
 REVIEWER

06/17/2014
 DATE

SEE SHEET 1
 FOR GENERAL NOTES

SEE SHEET 5
 FOR ASSEMBLY DETAILS

STATE OF VERMONT
 AGENCY OF TRANSPORTATION
 VT ROUTE 65 (MINOR COLLECTOR)
 BRIDGE NO. 2
 TOWN OF BROOKFIELD

STATE	COUNTY	CONTROL NO.
VT	ORANGE	NA

PROJECT NO.: BRF FLBR(2)

COSMEC, INC.
 STAINLESS STEEL BEARING ASSY.'S

Cosmec 1501 ROCKY RIDGE ROAD
 P.O. BOX 2159
 ATHENS, TEXAS 75751

SCALE: NONE	DRAWN BY: MH	CHECKED BY: SL
	DATE: 05/28/14	DATE: 05/08/14

SHEET 6 OF 7 **JOB NO.: 12445**

REV.	DESCRIPTION	BY	DATE	CHK'D	DATE	CUSTOMER	DRAWING NUMBER	REV.
						MILLER CONSTRUCTION, INC.	12445-D6	0