



**FLOATING SPAN DECK
PANEL TYPE A - PLAN**
SCALE: 1/2" = 1'-0"

**FLOATING SPAN DECK
PANEL TYPE B - PLAN**
SCALE: 1/2" = 1'-0"


**FLOATING SPAN DECK
PANEL TYPE C - PLAN**
SCALE: 1/2" = 1'-0"

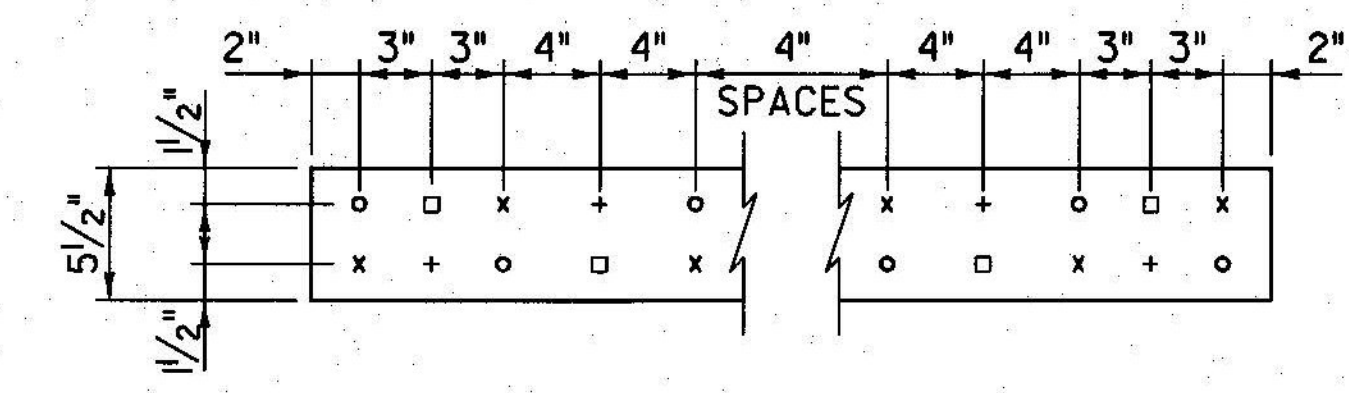





FLOATING SPAN DECK PANEL - NAIL PATTERN
SCALE: 1/2" = 1'-0"

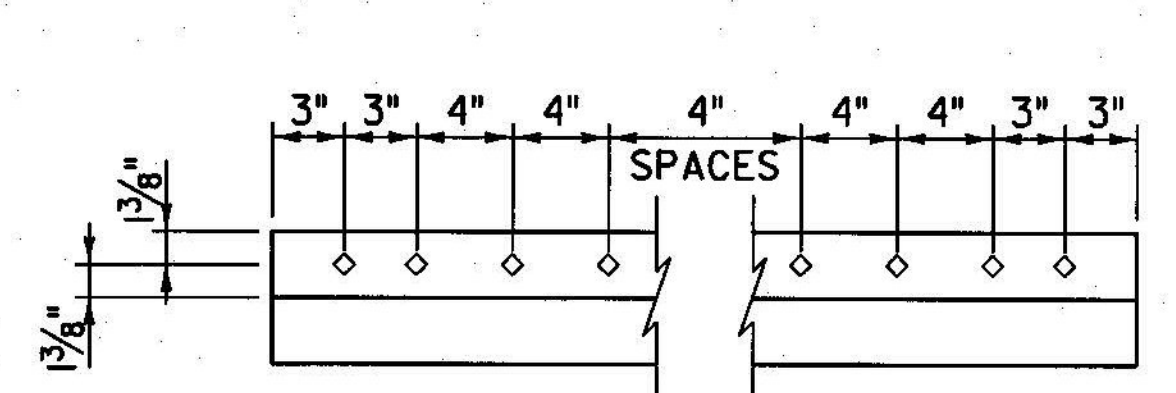

SHIP LAP BOARD - NAIL PATTERN
SCALE: 1/2" = 1'-0"
(TOP SHIP LAP BOARD SHOWN, BOTTOM SIMILAR)

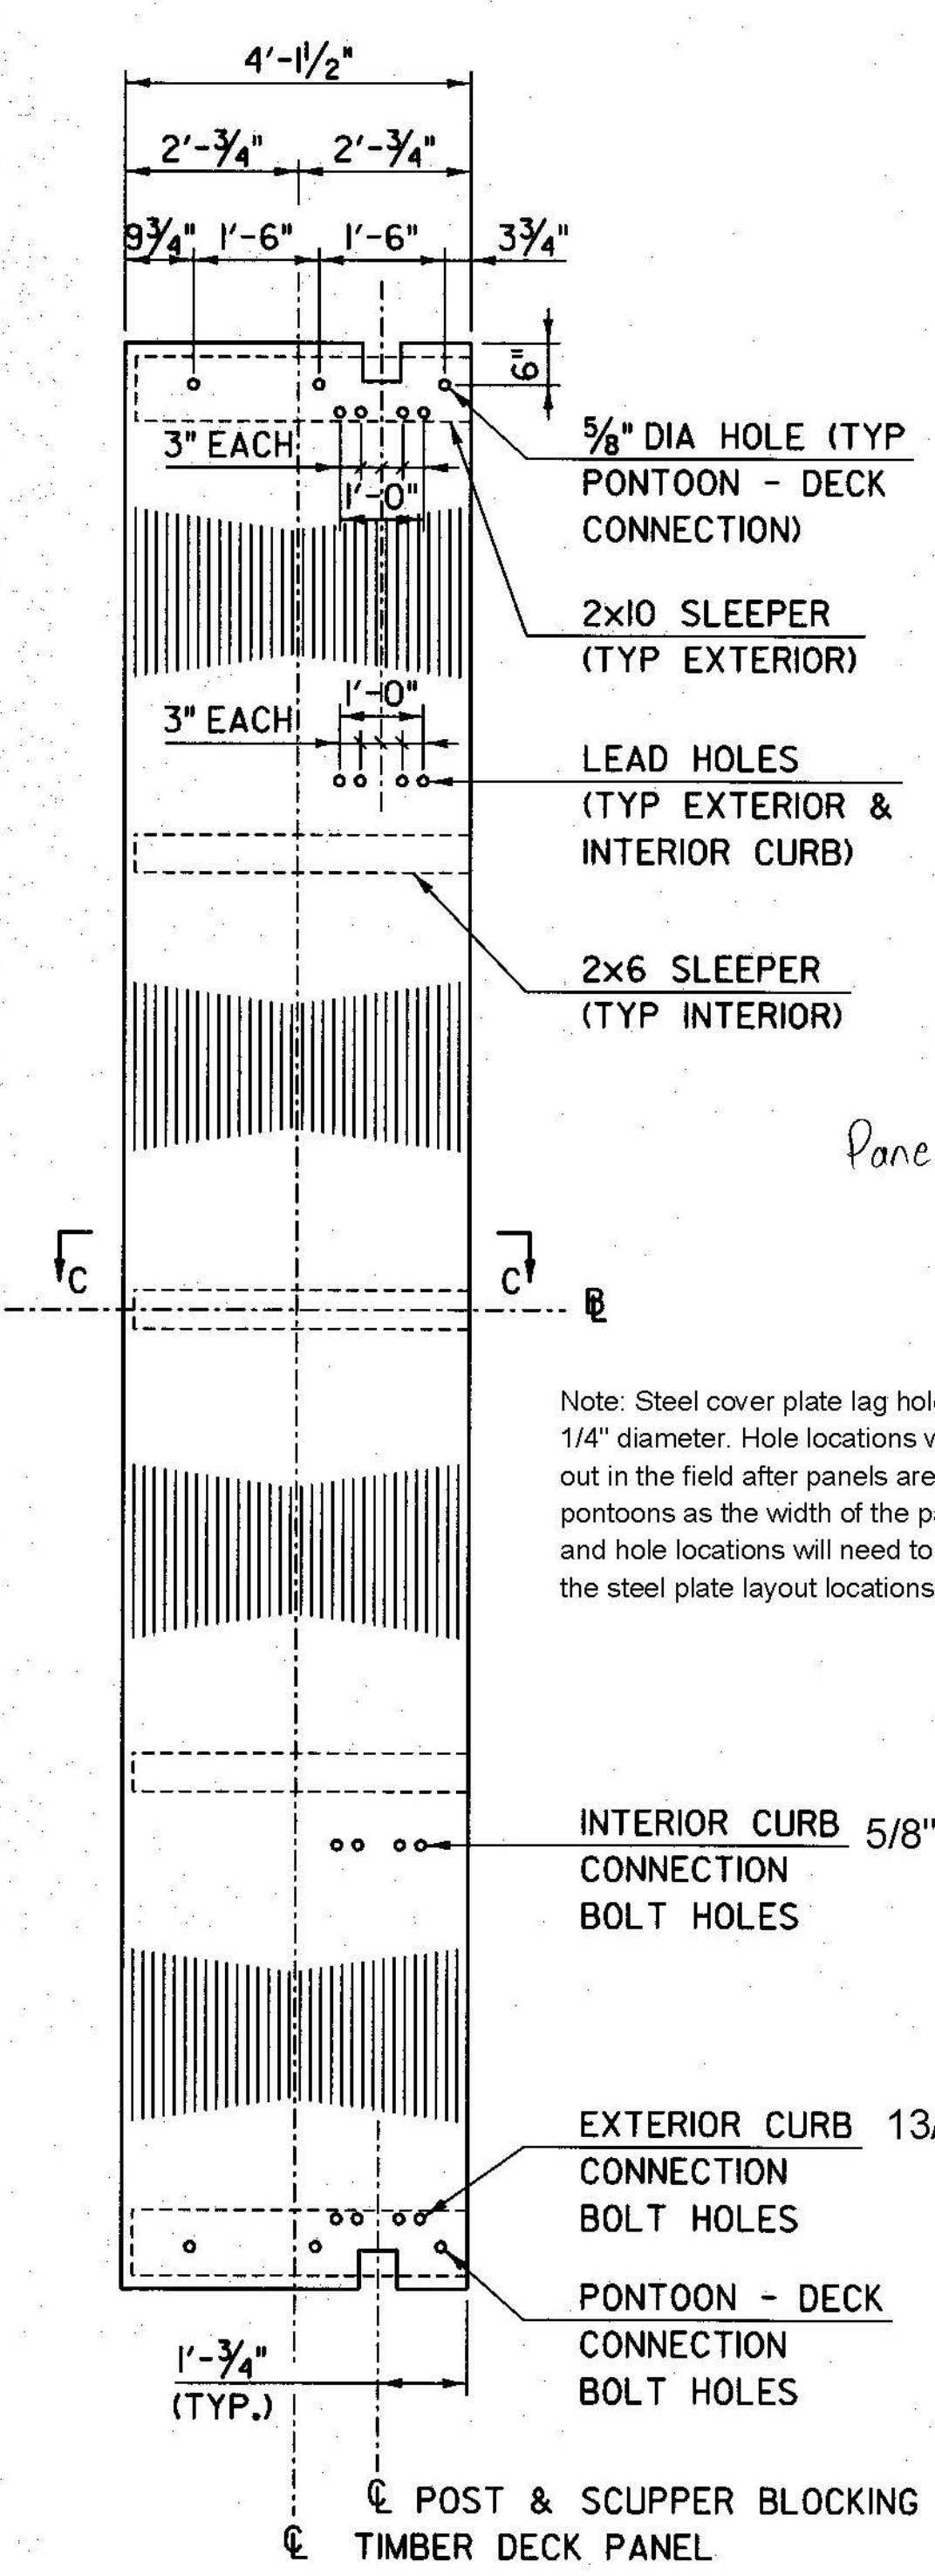

Note: Steel cover plate lag holes to be predrilled 1/4" diameter. Hole locations will need to be laid out in the field after panels are assembled on the pontoons as the width of the panels will vary and hole locations will need to be adjusted to match the steel plate layout locations.

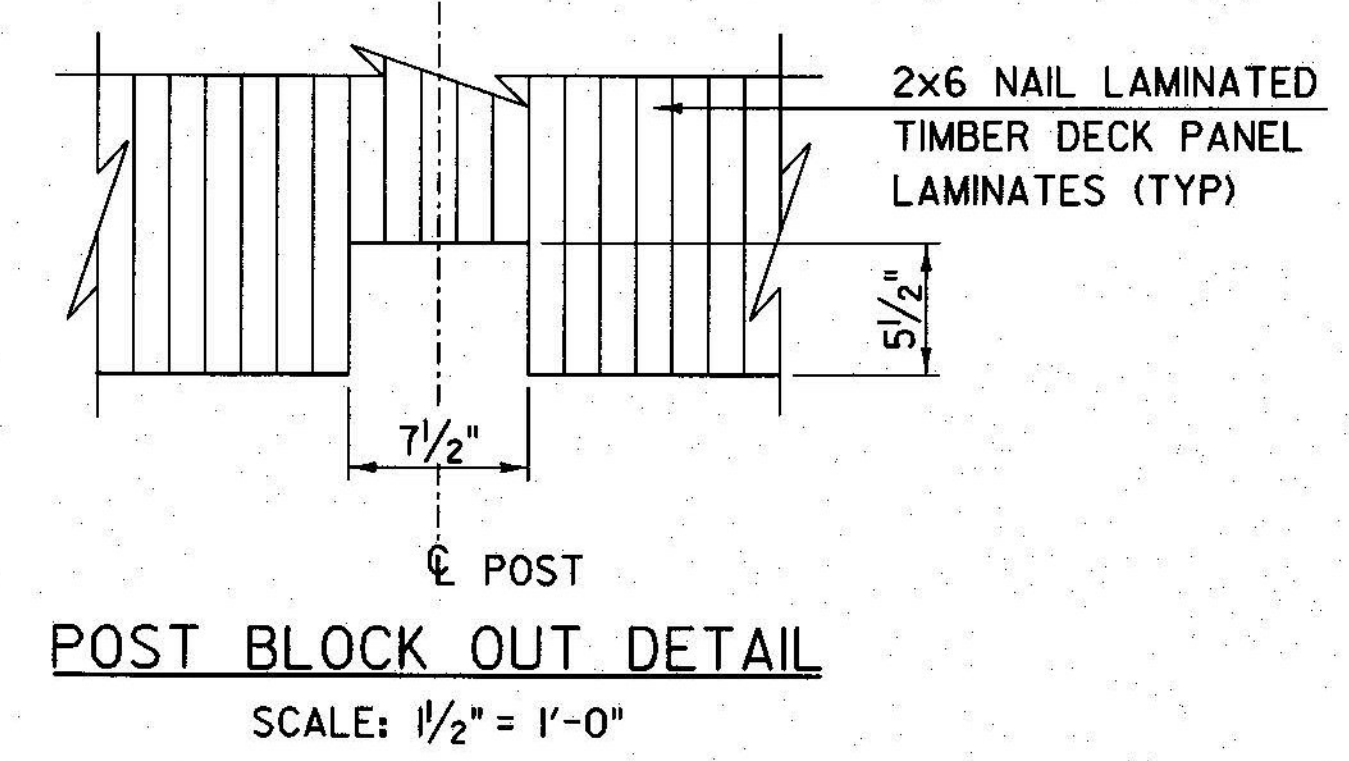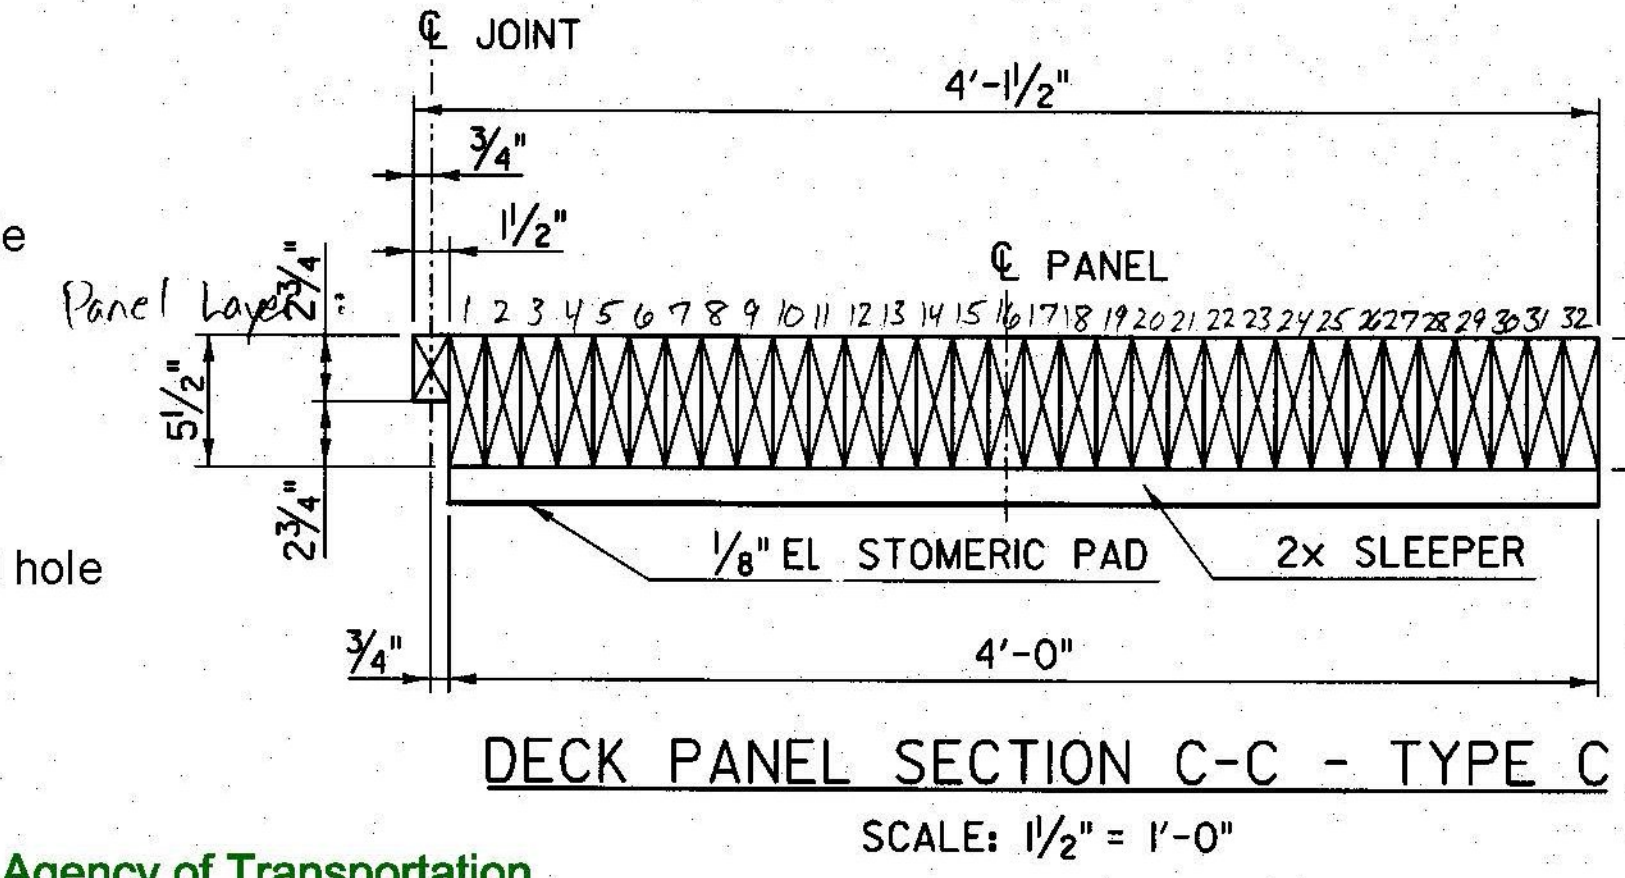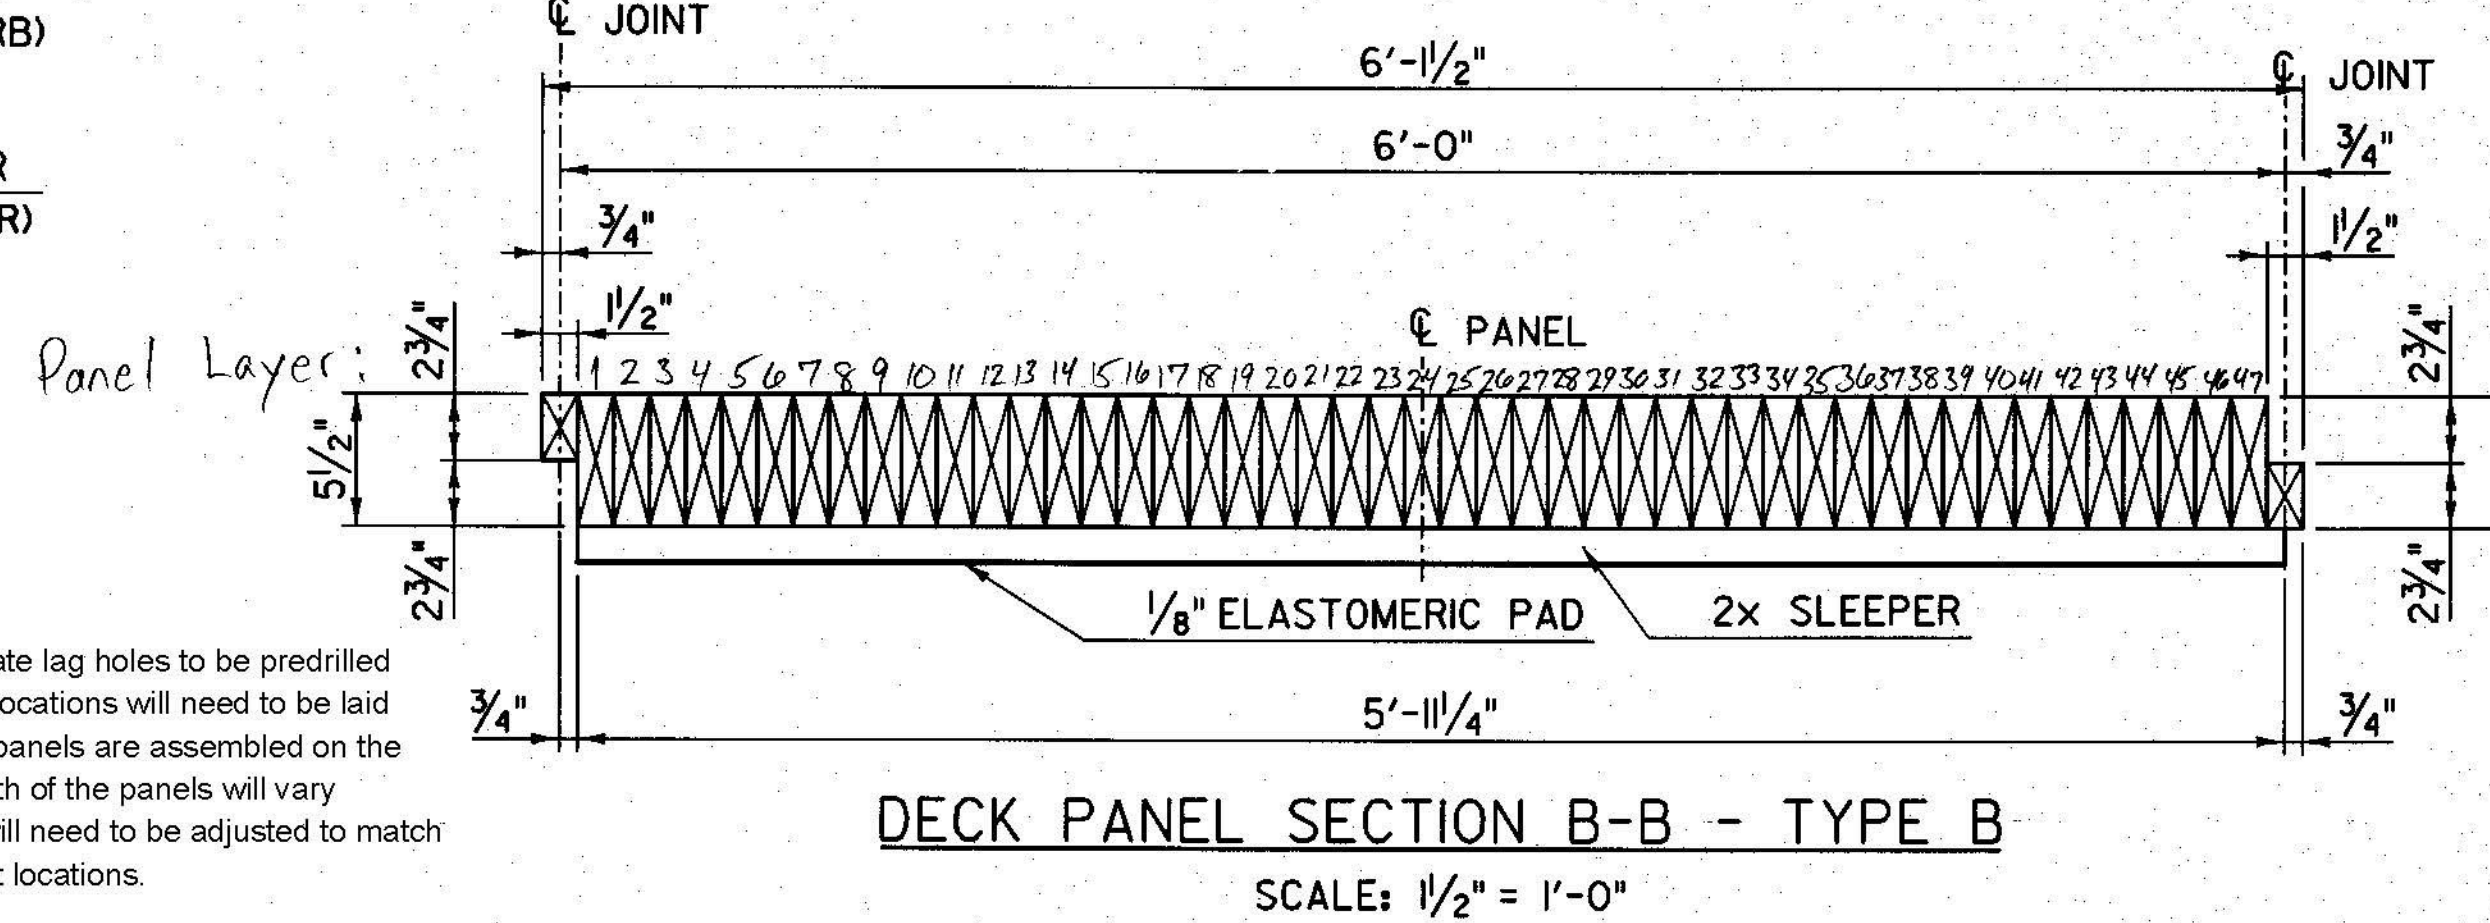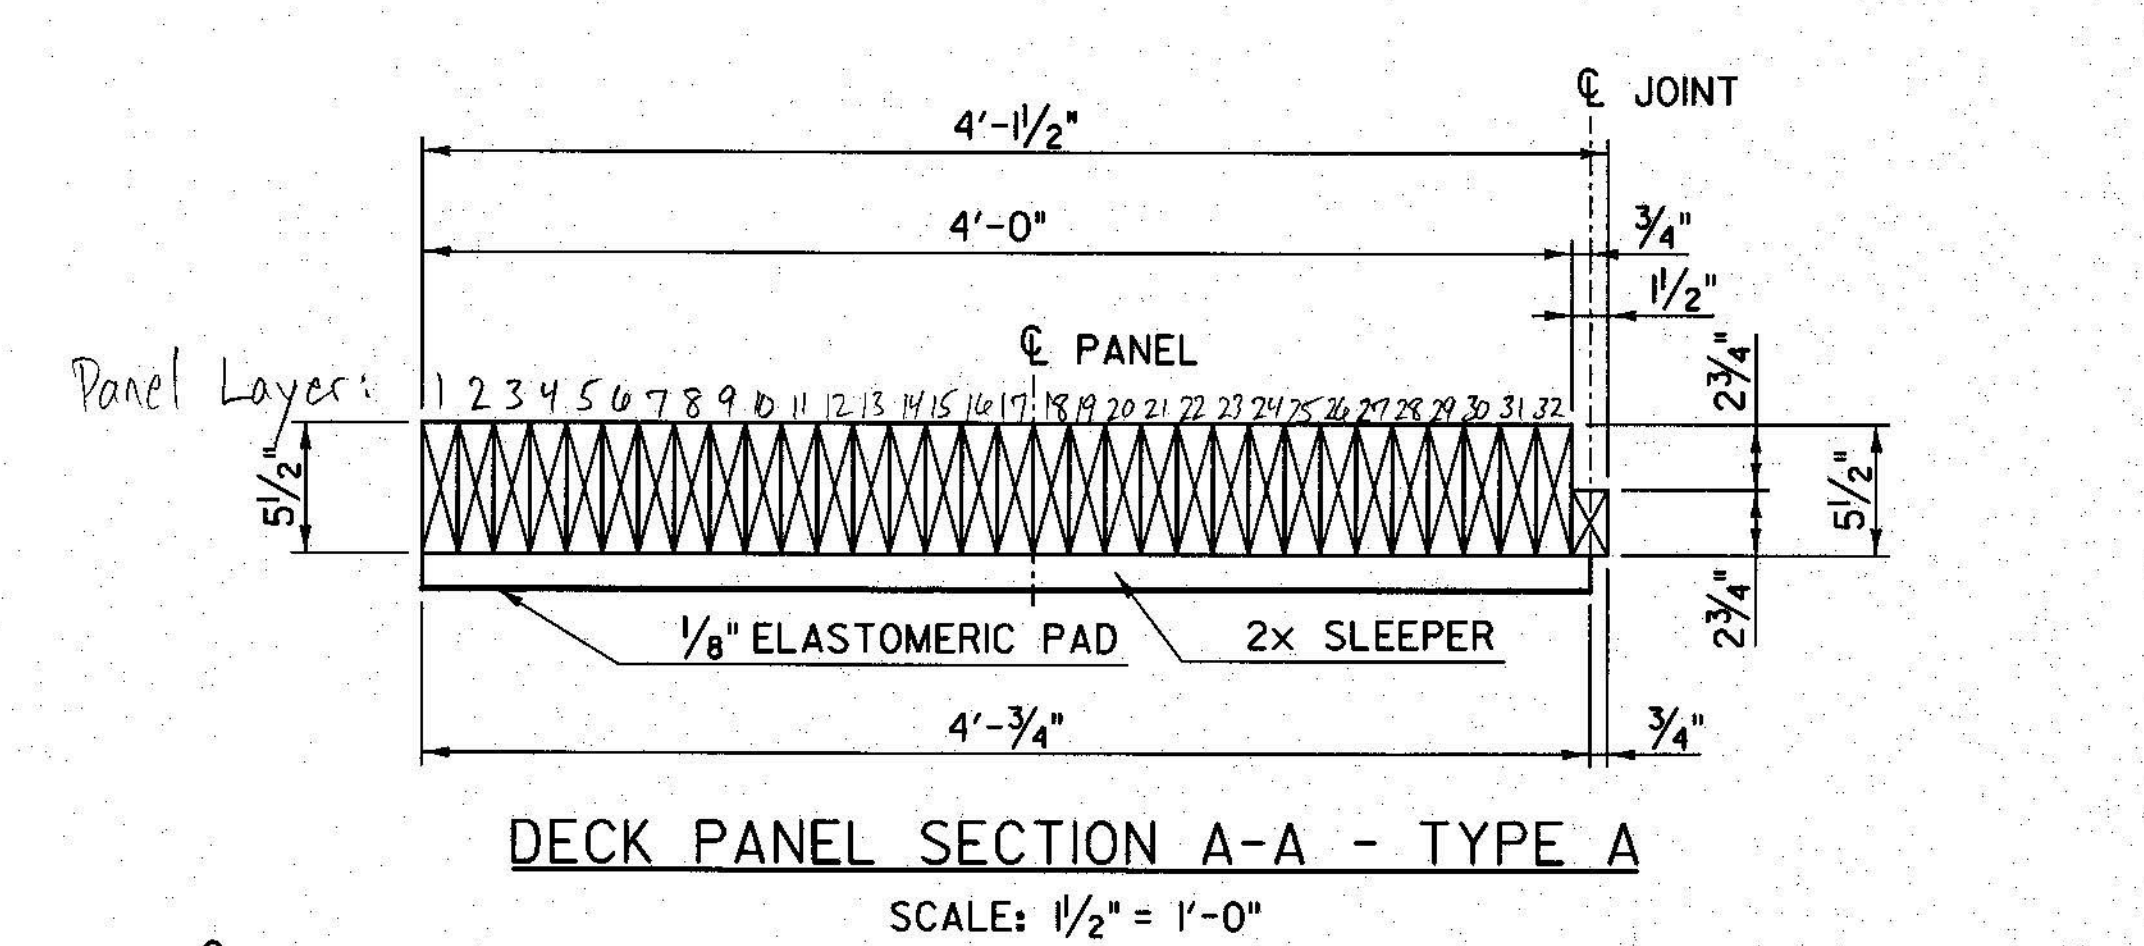

T.Y. LIN INTERNATIONAL
THE STAMPED DOCUMENTS ARE HEREBY:

X APPROVED
 APPROVED AS NOTED
 REVISE AND RESUBMIT

SEE TRANSMITTAL FOR ADDITIONAL INFORMATION AS APPLICABLE.

THIS REVIEW IS FOR GENERAL CONFORMANCE WITH DESIGN CONCEPT ONLY. ANY DEVIATION FROM THE PLANS OR SPECIFICATIONS NOT CLEARLY NOTED BY THE CONTRACTOR HAS NOT BEEN REVIEWED. REVIEW BY THE ENGINEER SHALL NOT RELIEVE THE CONTRACTOR OF THE CONTRACTUAL RESPONSIBILITY FOR ANY ERRORS OR DEVIATION FROM THE CONTRACT REQUIREMENTS.

Tim Poulin 08/07/2014
 REVIEWER DATE

Vermont Agency of Transportation
RECEIVED
 ON: July 17, 2014
 and Checked for
CONFORMANCE
 BY: Jennifer Fitch DATE: 8/8/2014

PROJECT NAME: BROOKFIELD
 PROJECT NUMBER: BRFLBR(2)