

Vermont Agency of Transportation




RECEIVED

ON: June 30, 2014




and Checked for

CONFORMANCE


BY: Jennifer Fitch DATE: 07/07/2014

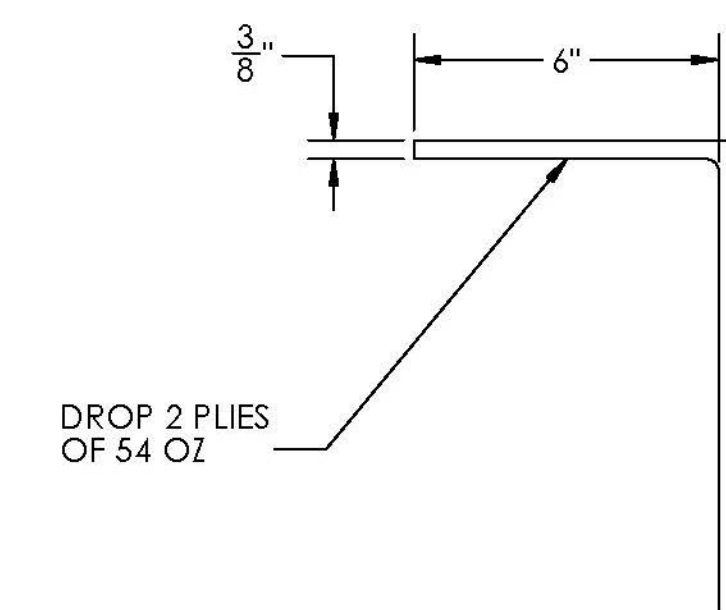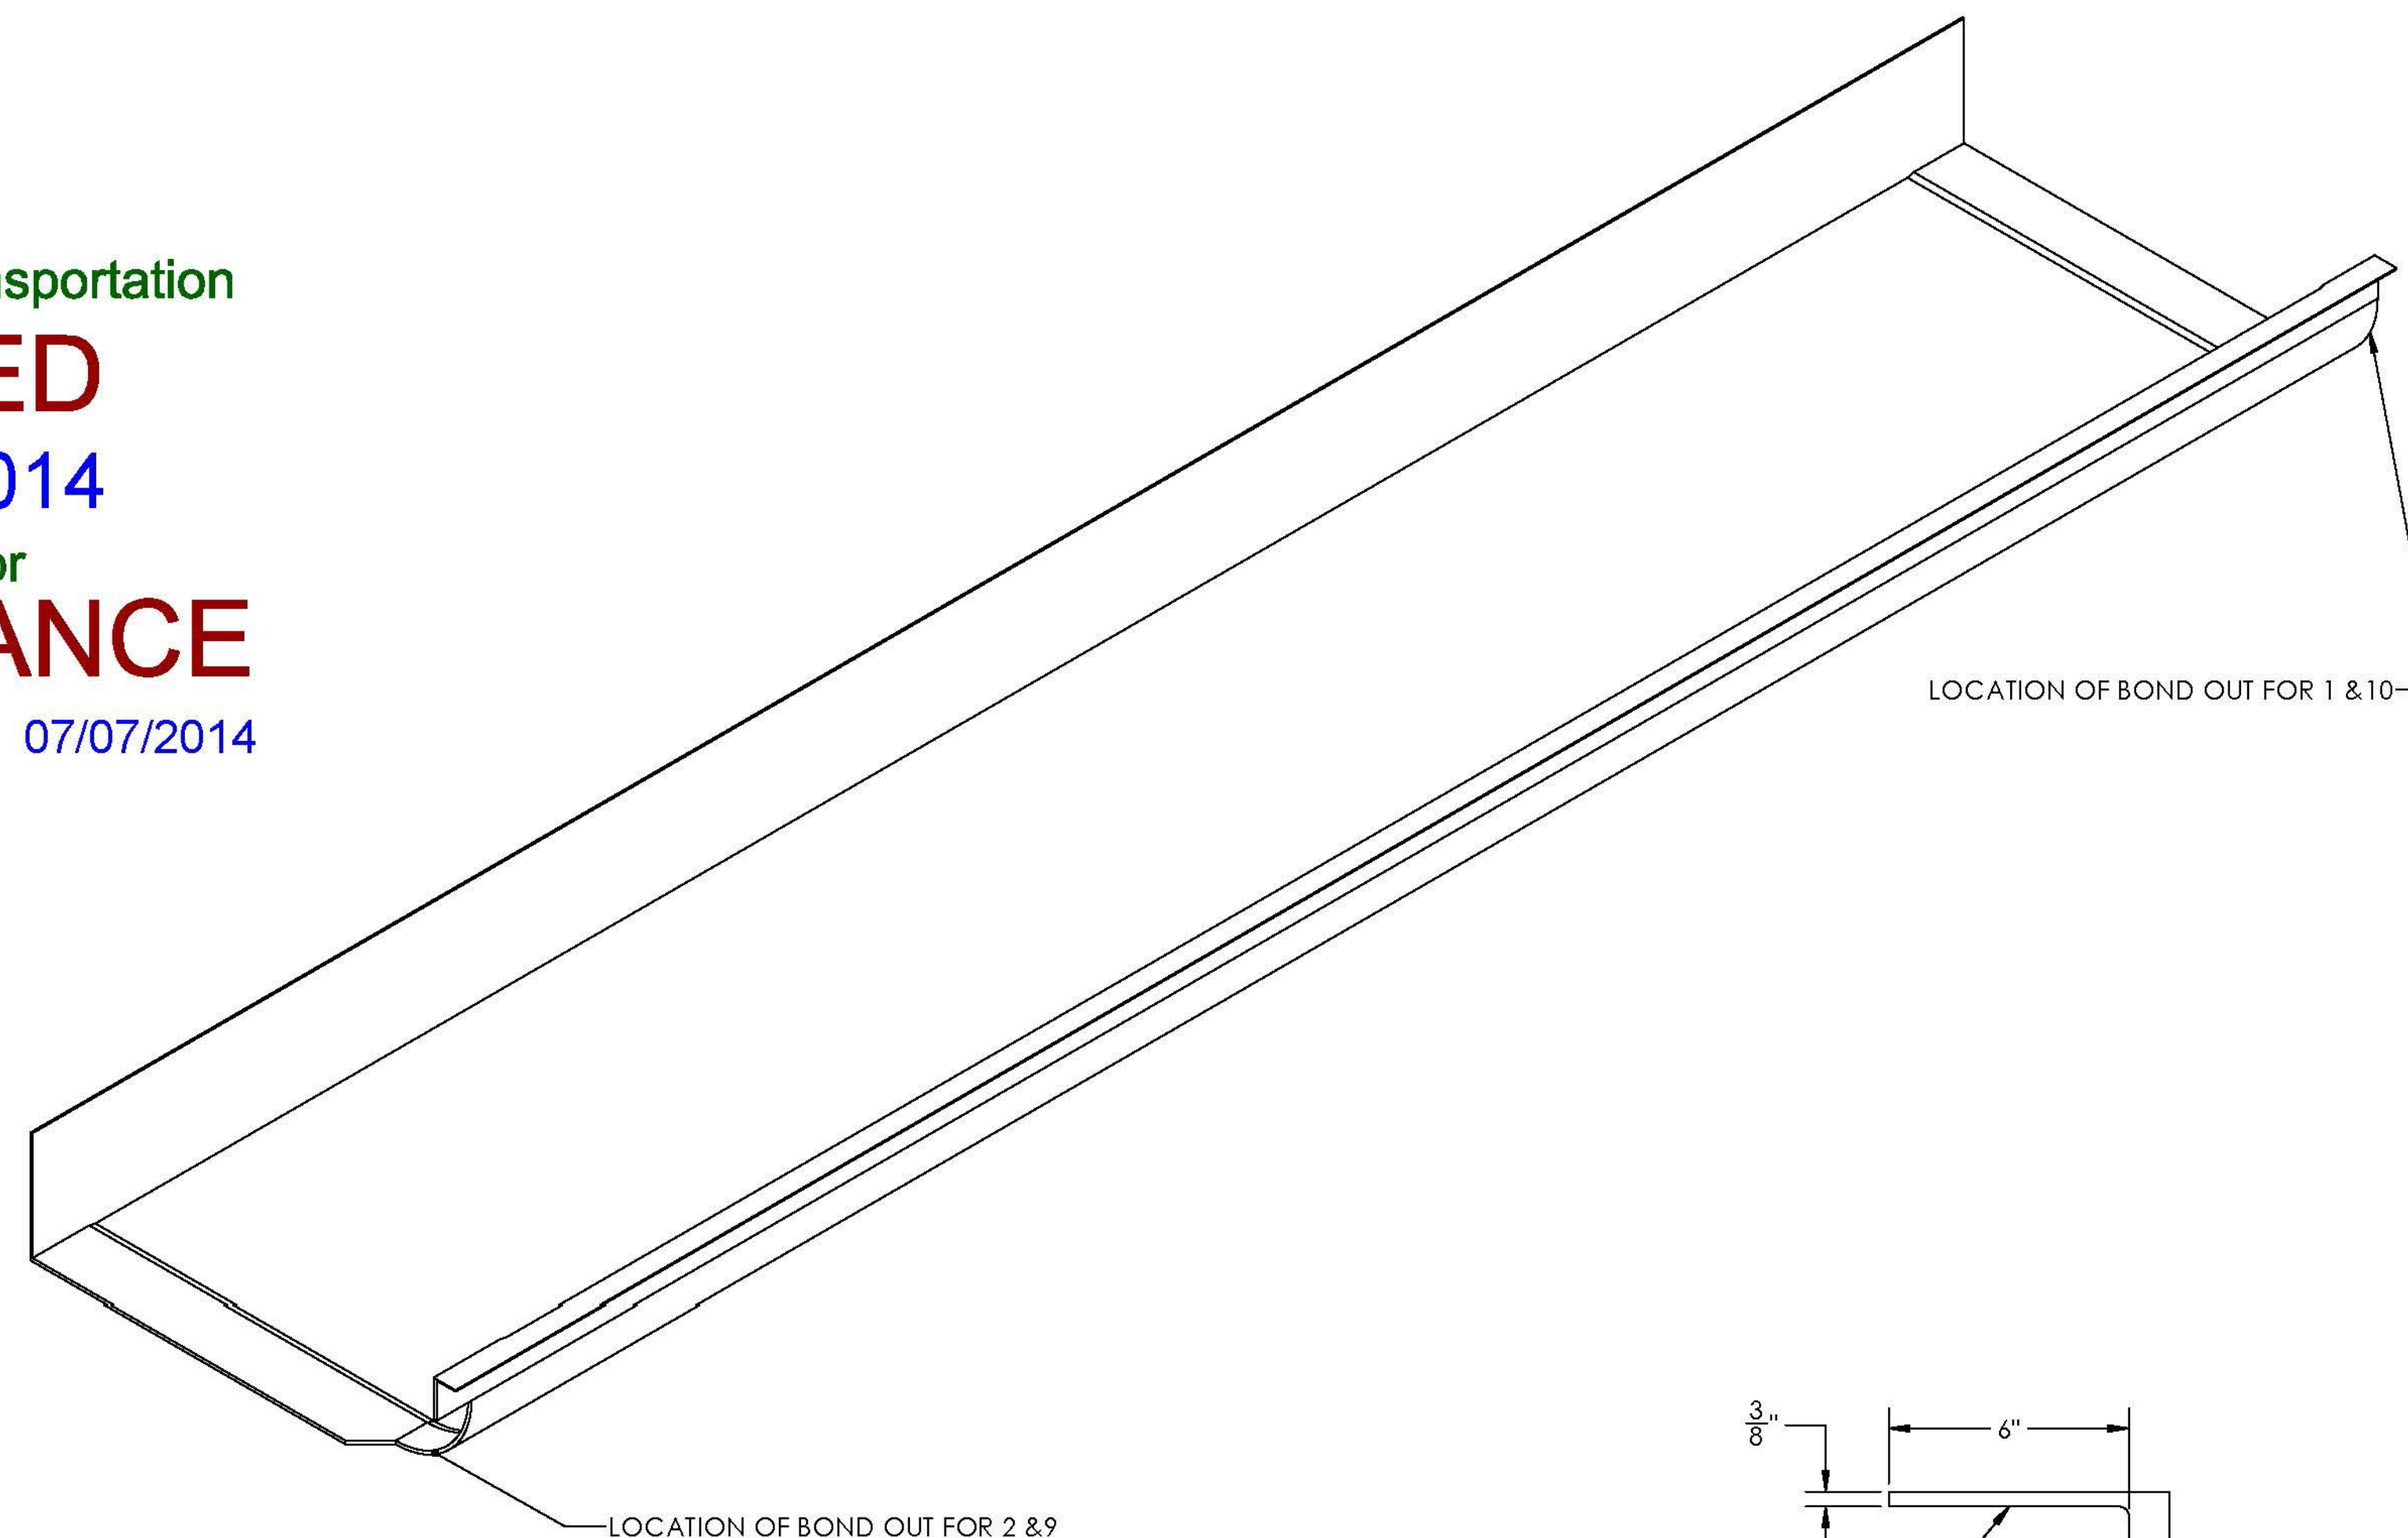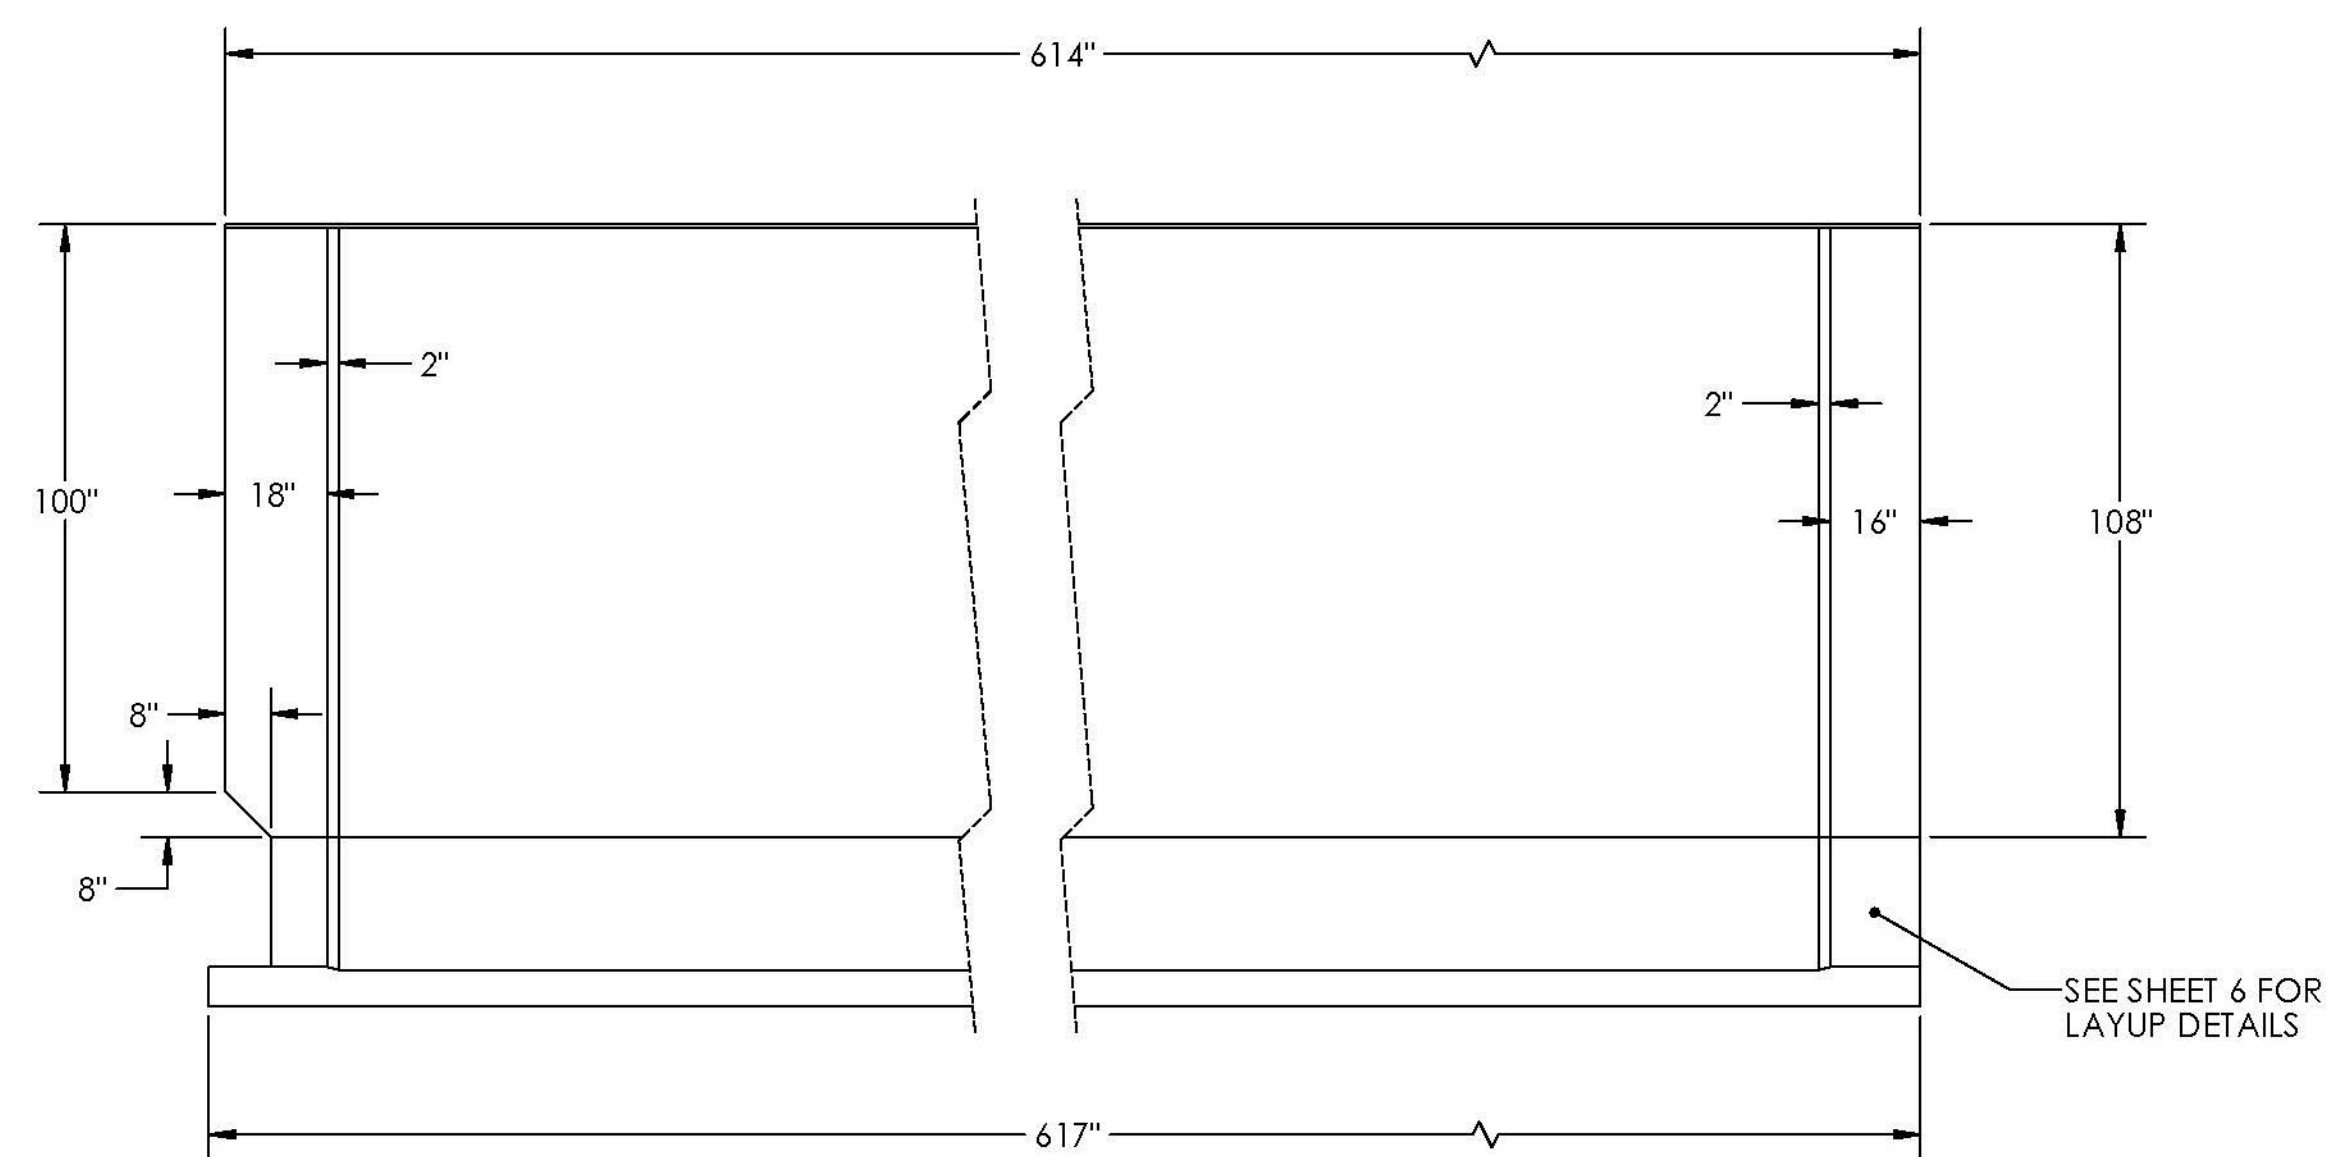

DETAIL C
SCALE 1 : 4

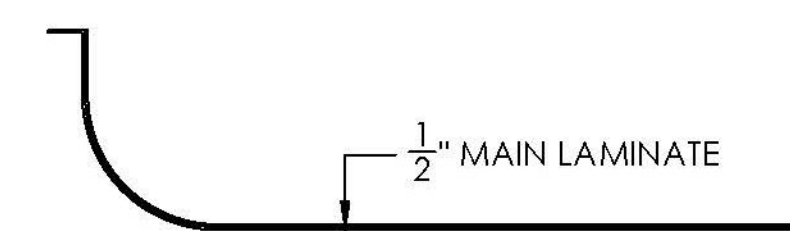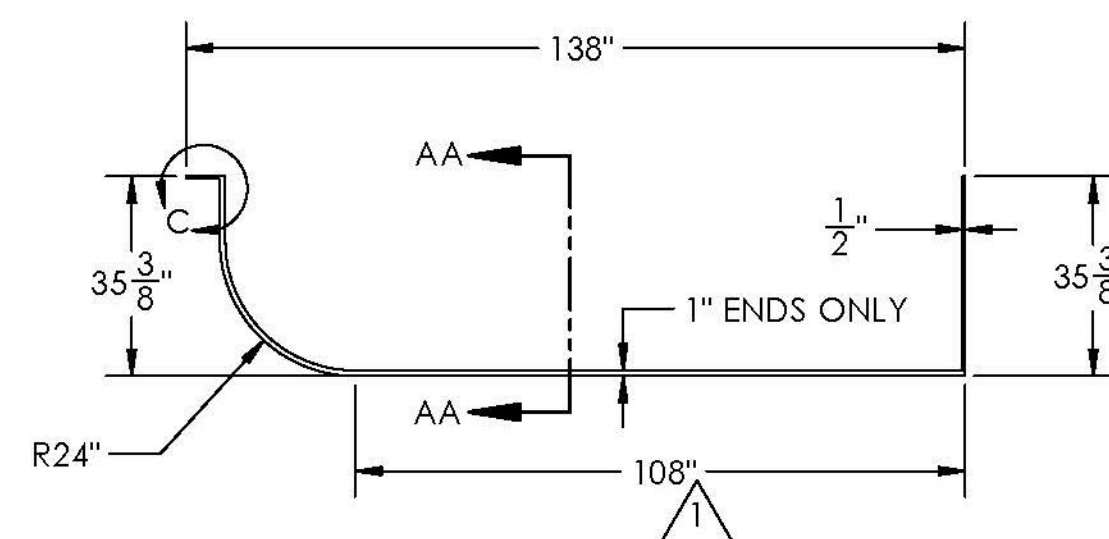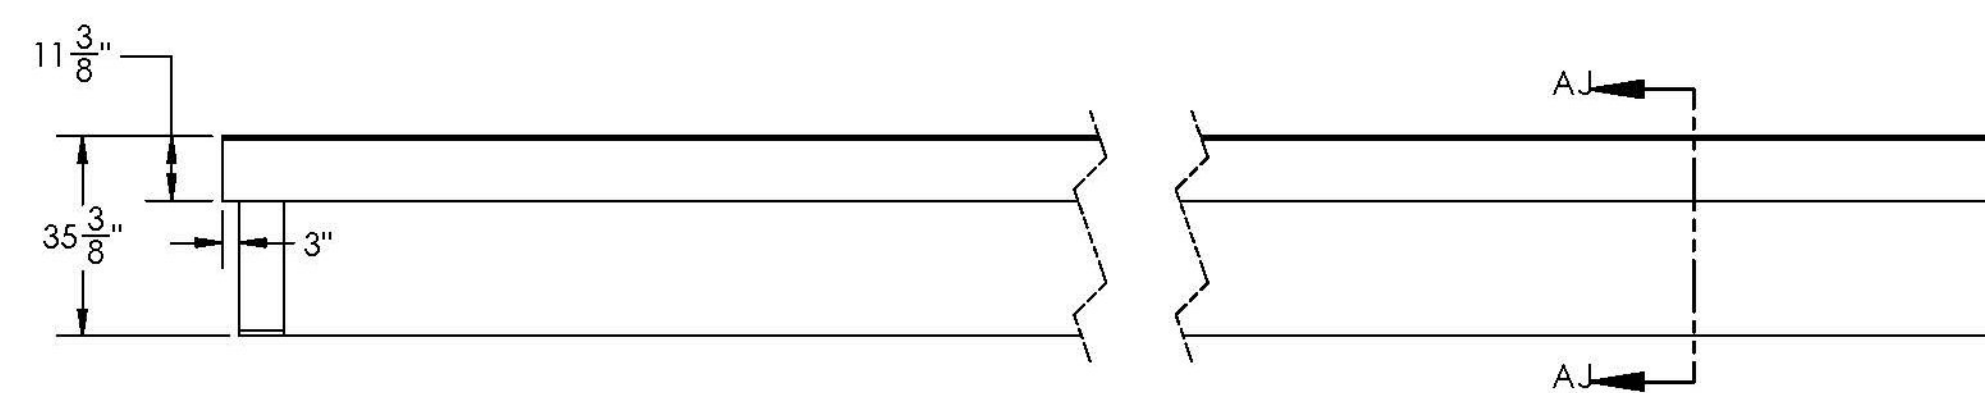

SECTION AJ-AJ
SCALE 1 : 36

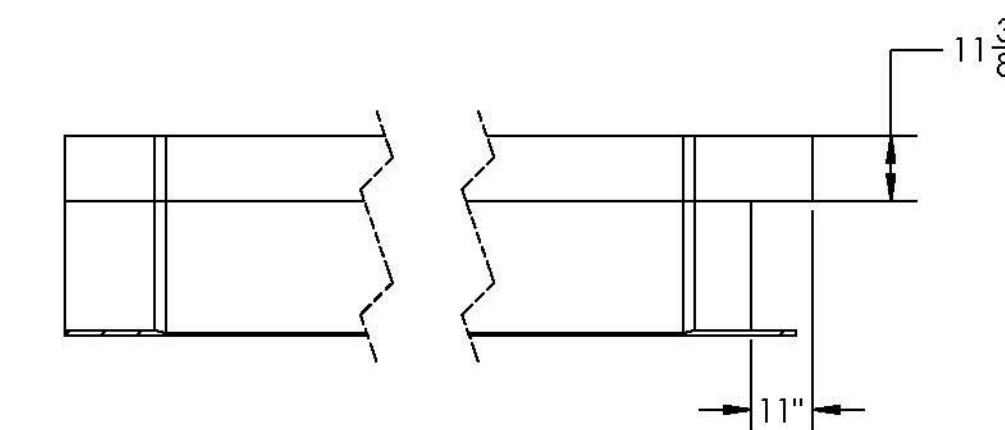

SECTION AA-AA
SCALE 1 : 36

NOTE:
PONTOON HULLS 2 & 9 SHOWN - SWAP MOLD INSERT END FOR END
TO PROPERLY ORIENTATE CONFIGURATION FOR HULLS 1 & 10

T.Y. LIN INTERNATIONAL

THE STAMPED DOCUMENTS ARE HEREBY:

APPROVED
 APPROVED AS NOTED
 REVISE AND RESUBMIT

SEE TRANSMITTAL FOR ADDITIONAL INFORMATION AS APPLICABLE.

THIS REVIEW IS FOR GENERAL CONFORMANCE WITH DESIGN CONCEPT ONLY. ANY DEVIATION FROM THE PLANS OR SPECIFICATIONS NOT CLEARLY NOTED BY THE CONTRACTOR HAS NOT BEEN REVIEWED. REVIEW BY THE ENGINEER SHALL NOT RELIEVE THE CONTRACTOR OF THE CONTRACTUAL RESPONSIBILITY FOR ANY ERRORS OR DEVIATION FROM THE CONTRACT REQUIREMENTS.

JOSH OLUND
 REVIEWER

07/03/2014
 DATE

REV	DESCRIPTION	DATE
1	ADDED SECTION AA-AA AND FIXED DIMENSION SNAP	6/25/14

SEAL

DIMENSIONS ARE IN INCHES
TOLERANCES: +0, -1/16"
FRACTIONAL +
ANGULAR: MACH +
BEND ±
TWO PLACE DECIMAL +
THREE PLACE DECIMAL ±

DRAWN BY	DATE
ML	6/4/14

CHKD BY	DATE
JM	6/4/14

PROJECT
BROOKFIELD FRP PONTOONS

CUSTOMER
MILLER CONST. / VTRANS
SHEET
END HULL DIMENSIONS

WEIGHT:	4,205 lb
DESCRIPTION:	FABRICATION
SCALE	1 : 48
WO NO.	8420
CONTRACT NO.	9185
DWG NO.	8420-6
SHEET	4 OF 16
PONTOON	1,2,9,10
PART NO.	1