




PLY # 1 - C-VEIL

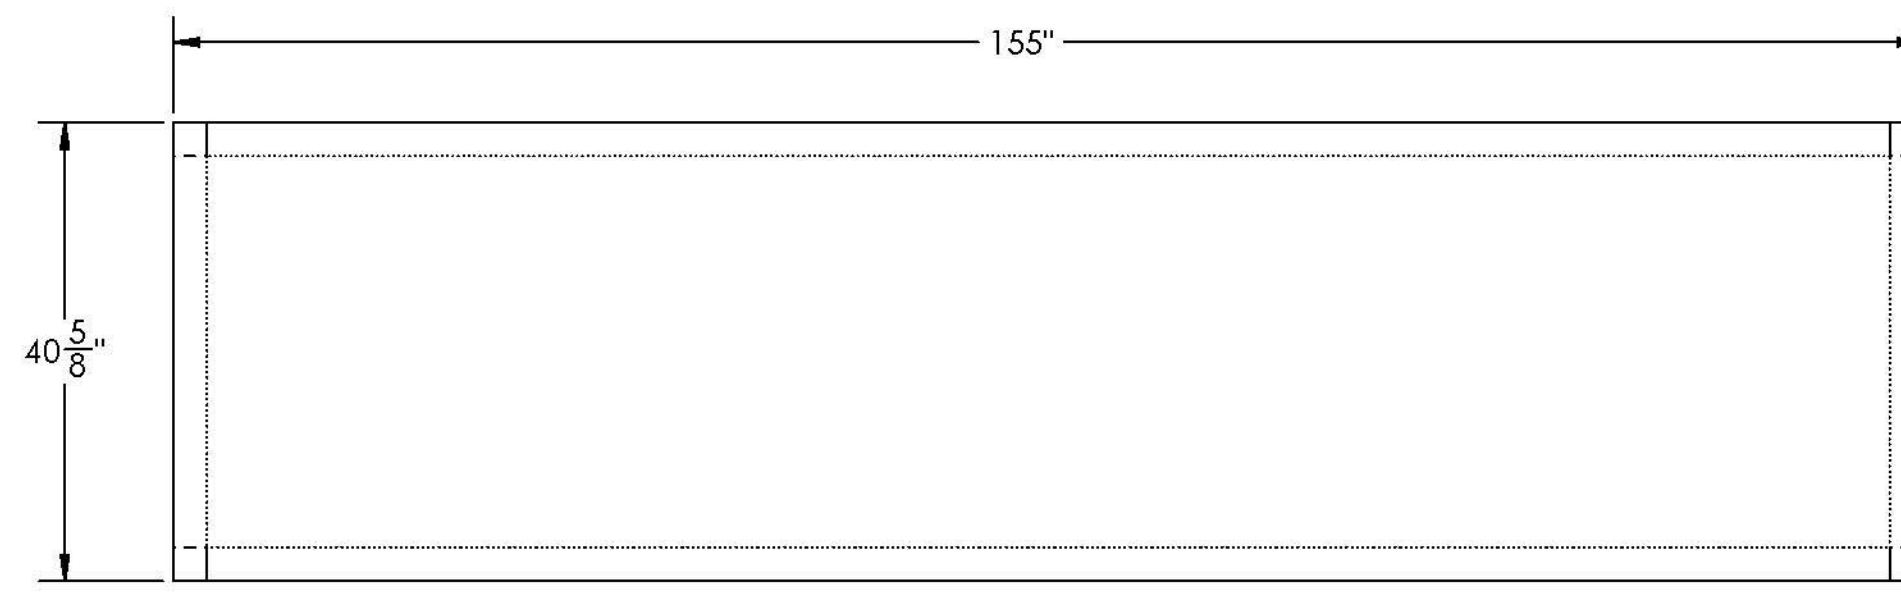


PLY # 2 - 4008

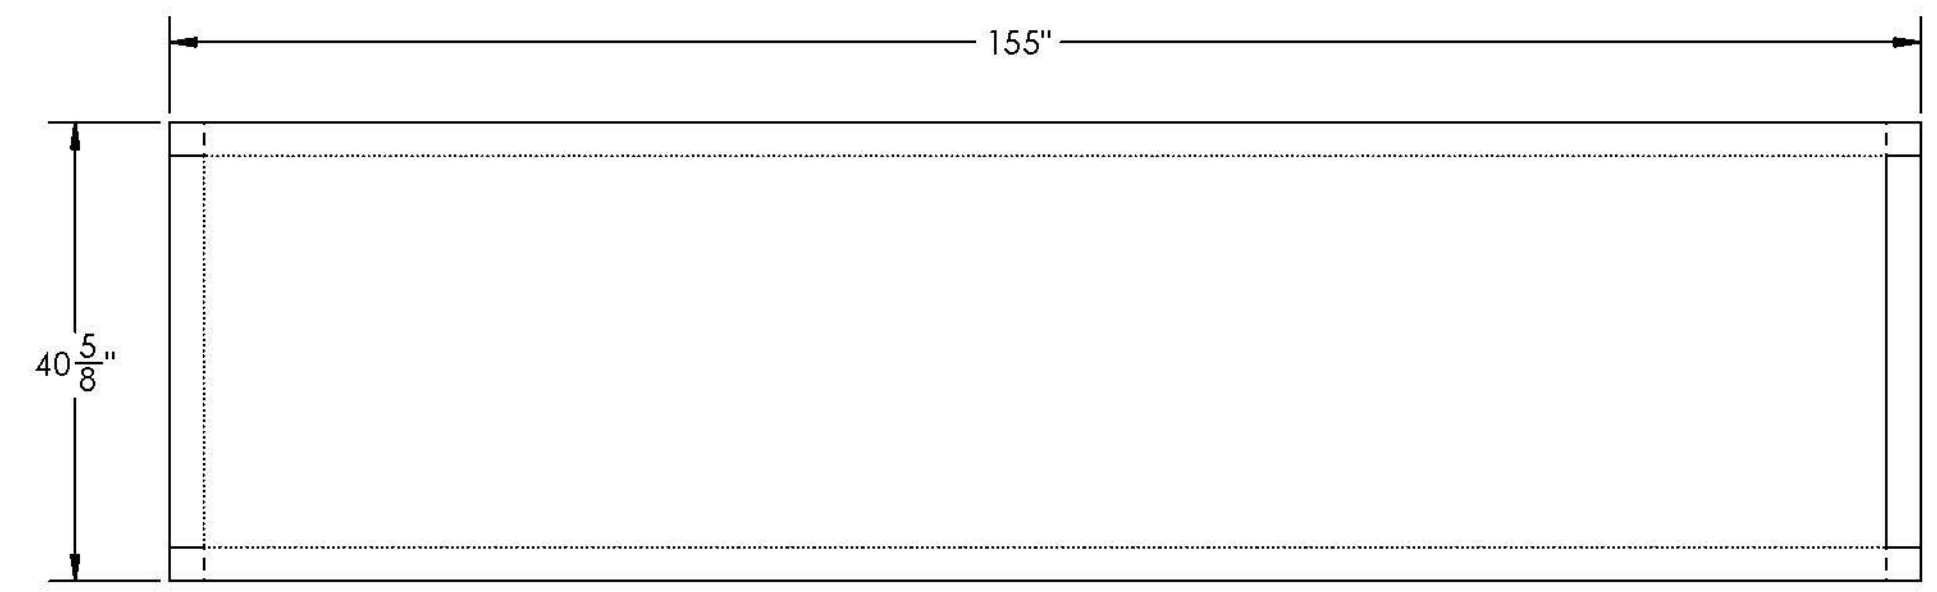


PLY # 3 - 54 oz

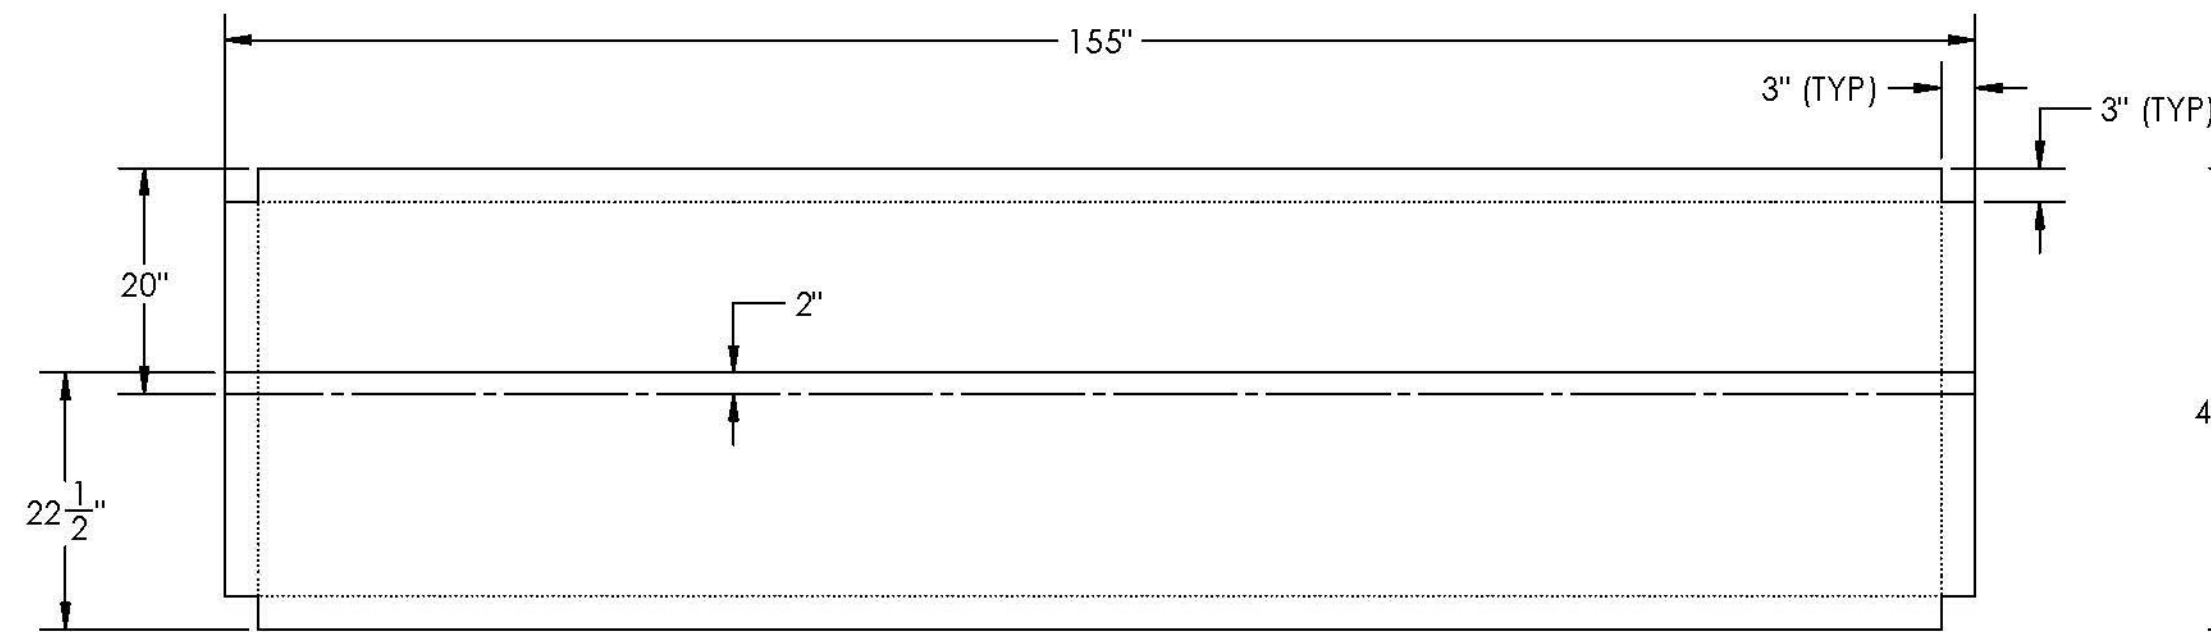


PLY # 4 - 54 oz

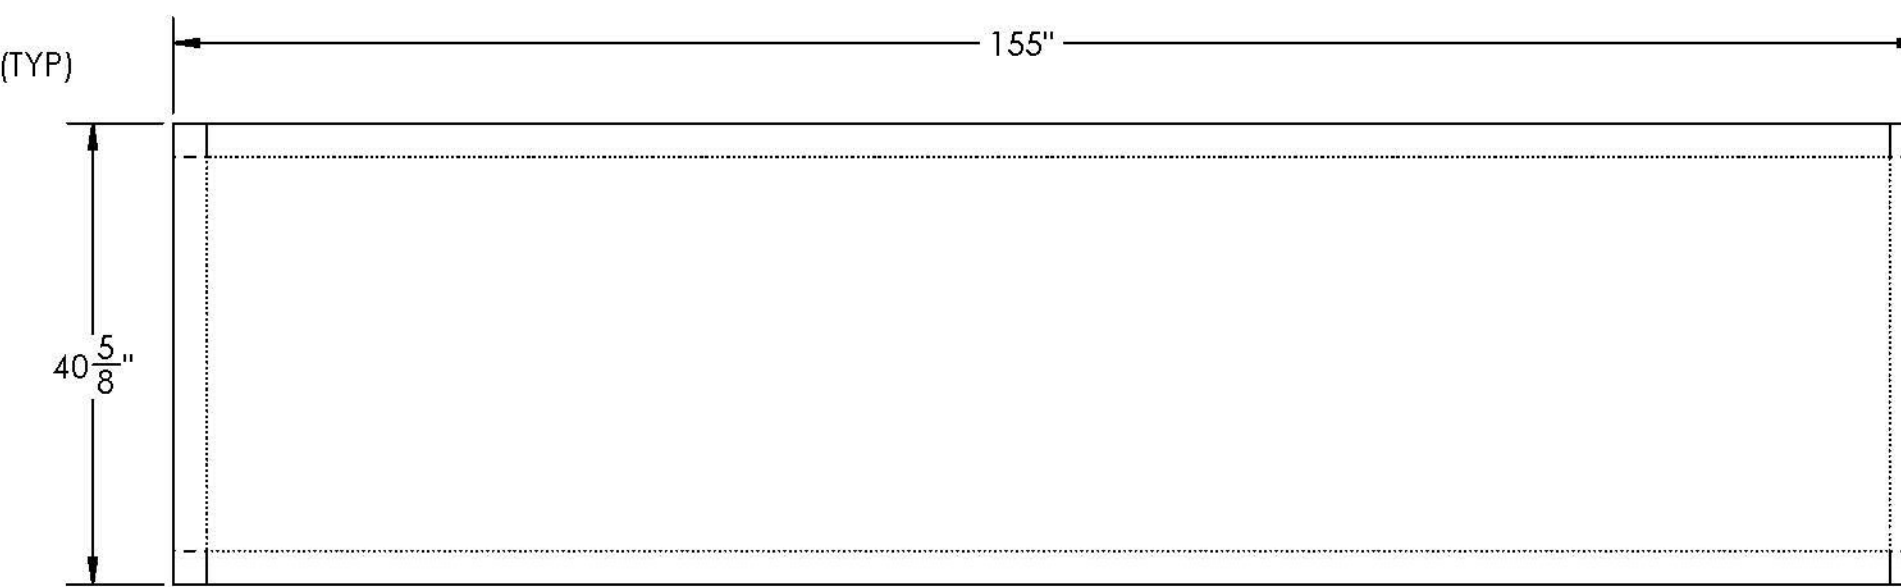


PLY # 5 - 54 oz

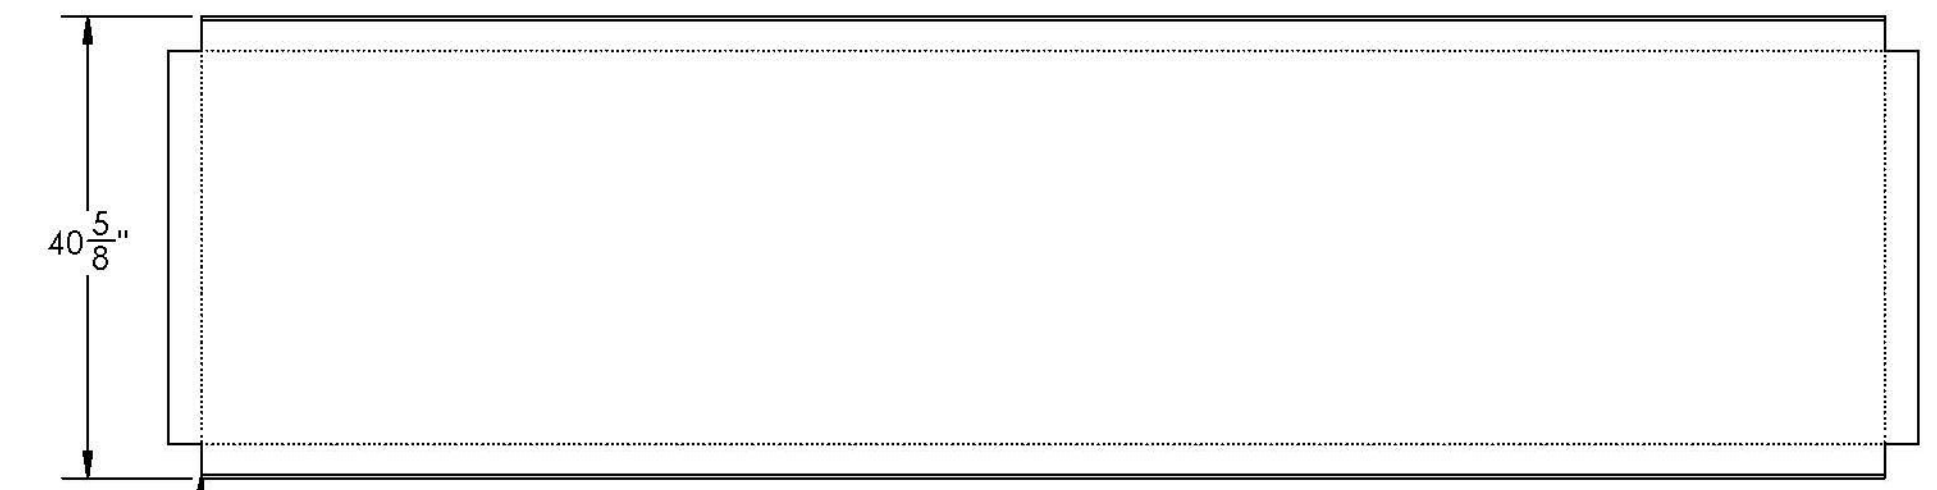


PLY # 6 - 54 oz

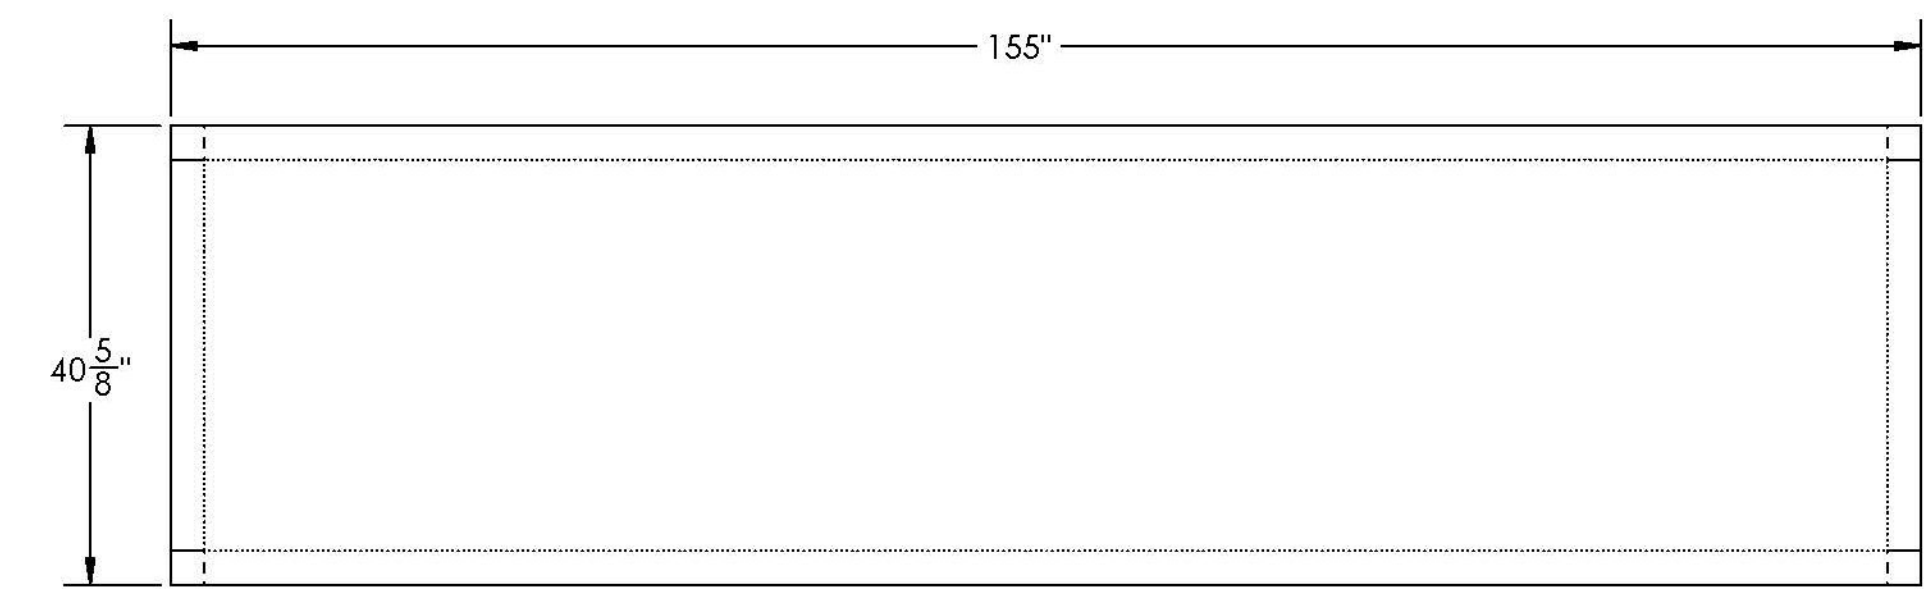


PLY # 7 - 54 oz

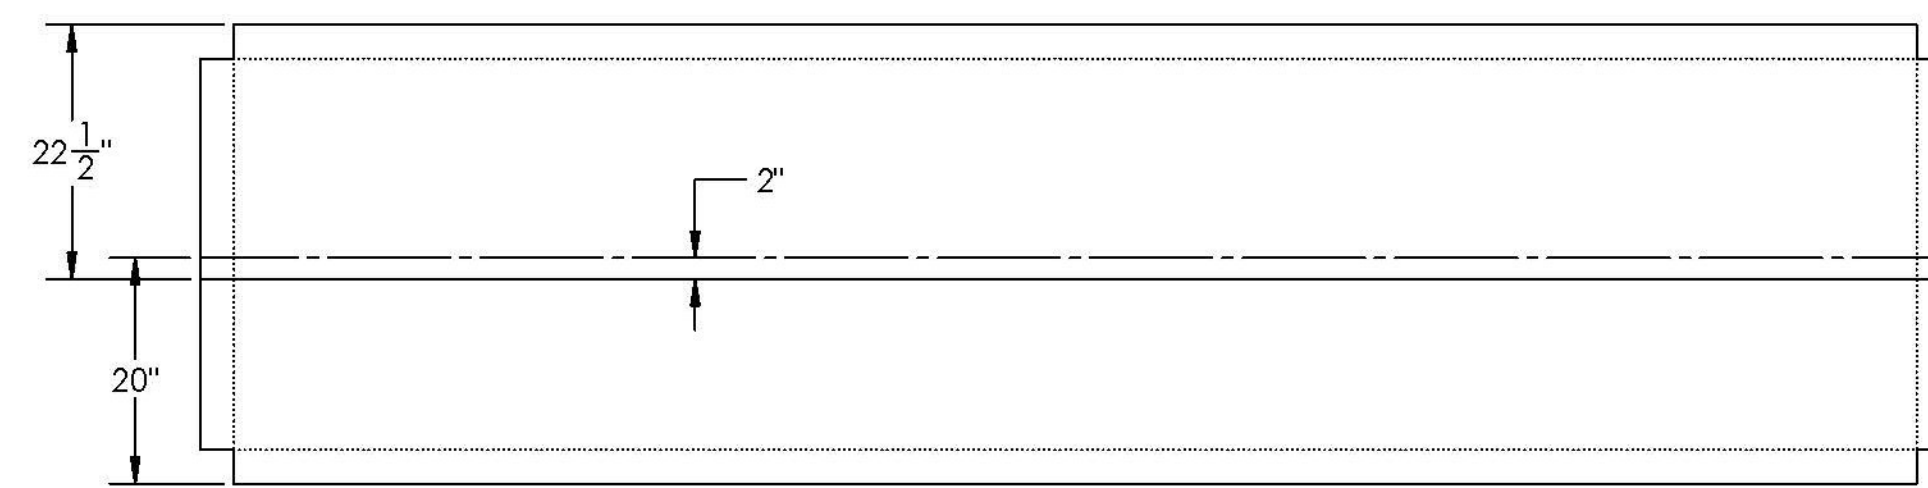

PLY # 8 - 54 oz

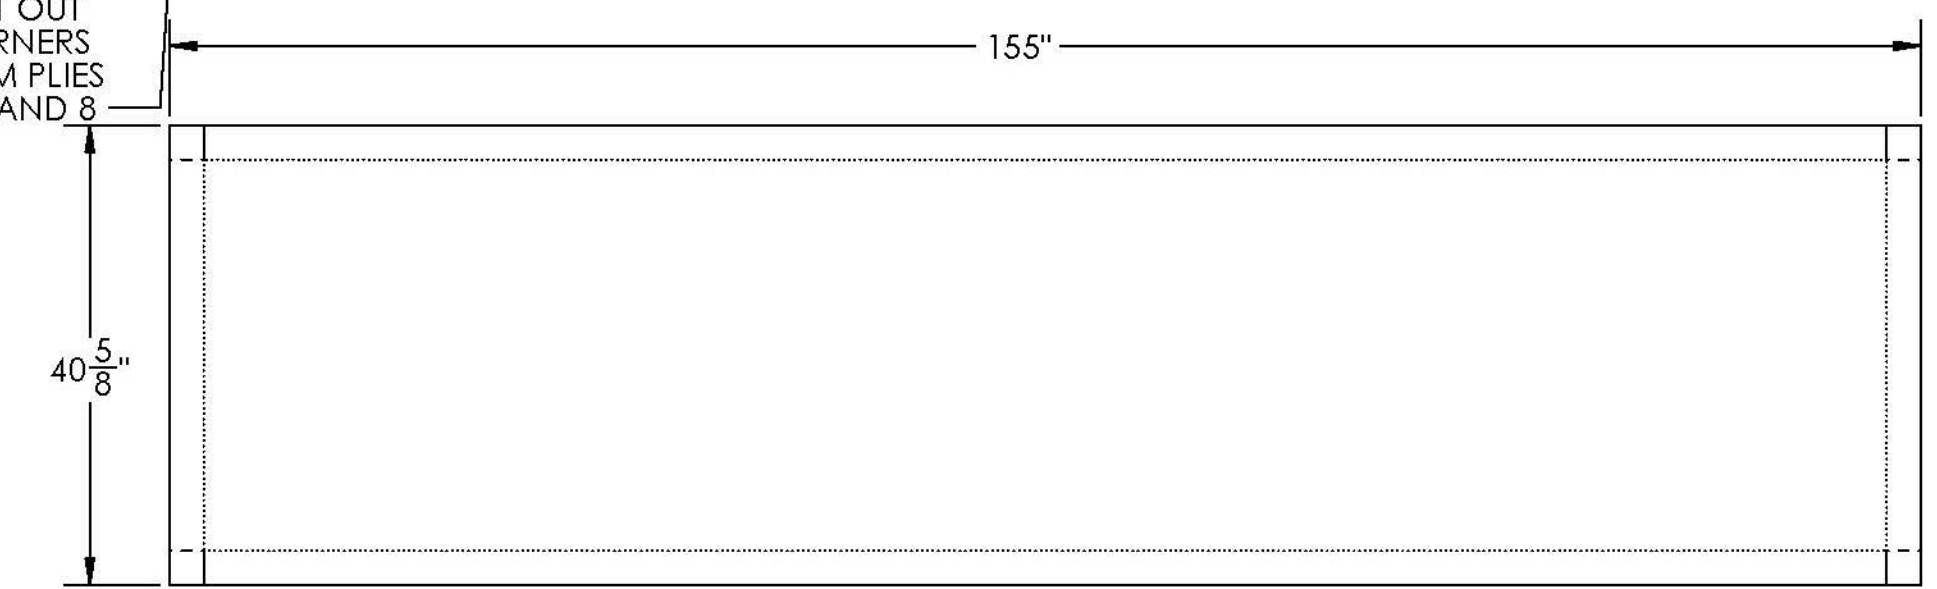

PLY # 9 - 54 oz

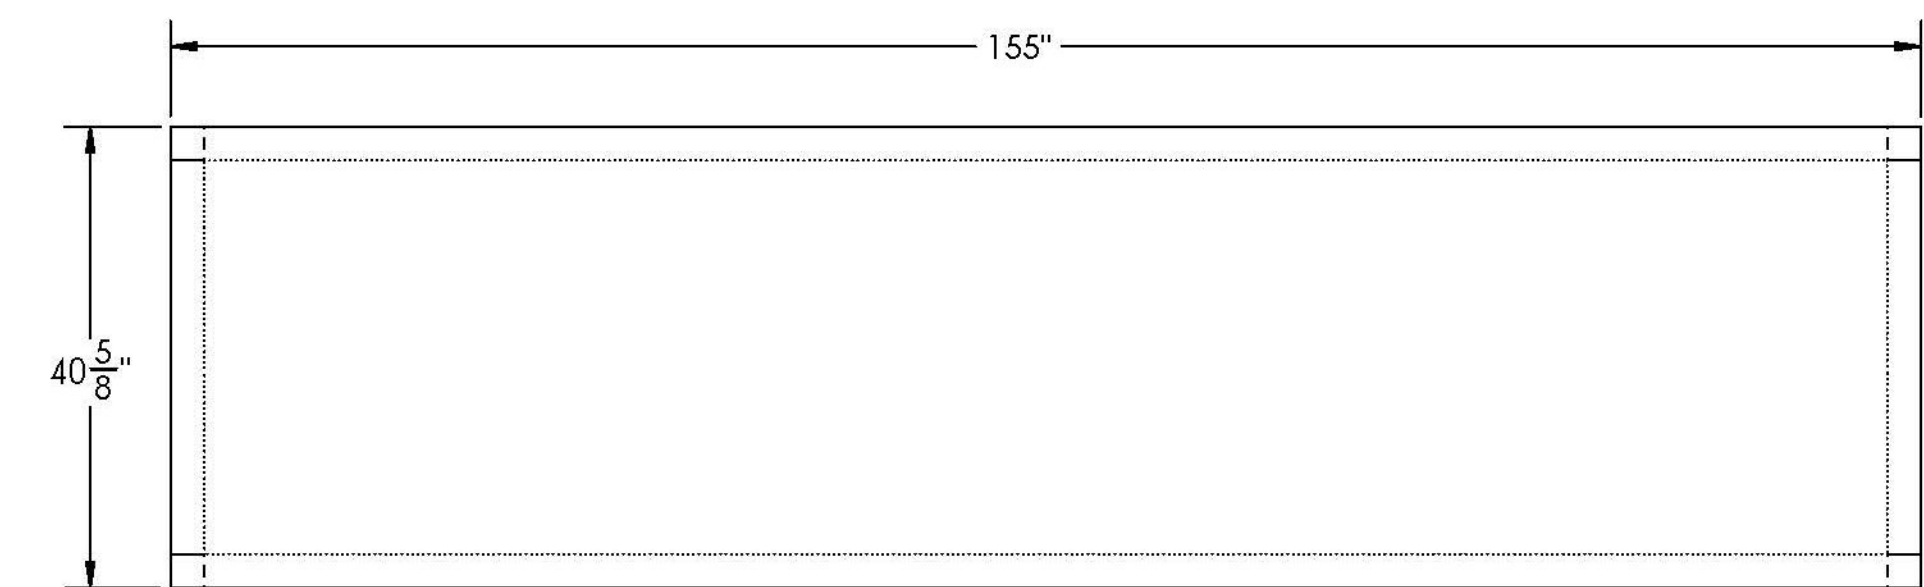

PLY # 10 - 4008



REV	DESCRIPTION	DATE
1	ADDED CORNER CUT OUT NOTE	6/26/14
1	ADDED 2" OVERLAP ON NOTED 54 OZ PLYS	6/26/14

SEAL

DIMENSIONS ARE IN INCHES
 TOLERANCES: +0, -1/16"
 FRACTIONAL ±
 ANGULAR: MACH ±
 TWO PLACE DECIMAL ±
 THREE PLACE DECIMAL ±

DRAWN BY	DATE
ML	6/4/14
CHKD BY	DATE
JM	6/4/14

PROJECT: BROOKFIELD FRP PONTOONS

CUSTOMER: MILLER CONST. / VTRANS

SHEET: MIDDLE LONGITUDINAL BULKHEAD LAYUP SCHEDULE

WEIGHT:	203 LB
DESCRIPTION:	FABRICATION
SCALE:	1 : 18
WO NO.	8420
CONTRACT NO.	9185
DWG NO.	8420-6
SHEET	10 OF 16
PONTOON	1-10
PART NO.	3

Vermont Agency of Transportation
RECEIVED
 ON: **June 30, 2014**
 and Checked for
CONFORMANCE
 BY: Jennifer Fitch DATE: 07/07/2014

T.Y. LIN INTERNATIONAL

THE STAMPED DOCUMENTS ARE HEREBY:

APPROVED
 APPROVED AS NOTED
 REVISE AND RESUBMIT

SEE TRANSMITTAL FOR ADDITIONAL INFORMATION AS APPLICABLE.

THIS REVIEW IS FOR GENERAL CONFORMANCE WITH DESIGN CONCEPT ONLY. ANY DEVIATION FROM THE PLANS OR SPECIFICATIONS NOT CLEARLY NOTED BY THE CONTRACTOR HAS NOT BEEN REVIEWED. REVIEW BY THE ENGINEER SHALL NOT RELIEVE THE CONTRACTOR OF THE CONTRACTUAL RESPONSIBILITY FOR ANY ERRORS OR DEVIATION FROM THE CONTRACT REQUIREMENTS.

JOSH OLUND 07/03/2014
 REVIEWER DATE