



DATE	6/26/14
DESCRIPTION	CHANGED STIFFENER NOTE AND ADDED FACING LAYUP
REV	1

SEAL

DIMENSIONS ARE IN INCHES
TOLERANCES: +0, -1/16"
FRACTIONAL +
ANGULAR: MACH +
BEND ±
TWO PLACE DECIMAL +
THREE PLACE DECIMAL ±

DRAWN BY	ML	DATE	6/4/14
CHKD BY	JM	DATE	6/4/14

PROJECT: BROOKFIELD FRP PONTOONS

CUSTOMER: MILLER CONST. / VTRANS

SHEET: END HALF TOP PLATE DIMENSIONS

WEIGHT: 1,490 lb

DESCRIPTION: FABRICATION

SCALE: 1 : 24

WO NO. 8420

CONTRACT NO. 9185

DWG NO. 8420-6

SHEET 14 OF 16

PONTOON 1,2,9,10 PART NO. 9

T.Y. LIN INTERNATIONAL

THE STAMPED DOCUMENTS ARE HEREBY:

APPROVED



APPROVED AS NOTED

REVISE AND RESUBMIT

SEE TRANSMITTAL FOR ADDITIONAL INFORMATION AS APPLICABLE.

THIS REVIEW IS FOR GENERAL CONFORMANCE WITH DESIGN CONCEPT ONLY. ANY DEVIATION FROM THE PLANS OR SPECIFICATIONS NOT CLEARLY NOTED BY THE CONTRACTOR HAS NOT BEEN REVIEWED. REVIEW BY THE ENGINEER SHALL NOT RELIEVE THE CONTRACTOR OF THE CONTRACTUAL RESPONSIBILITY FOR ANY ERRORS OR DEVIATION FROM THE CONTRACT REQUIREMENTS.

JOSH OLUND REVIEWER 07/03/2014 DATE

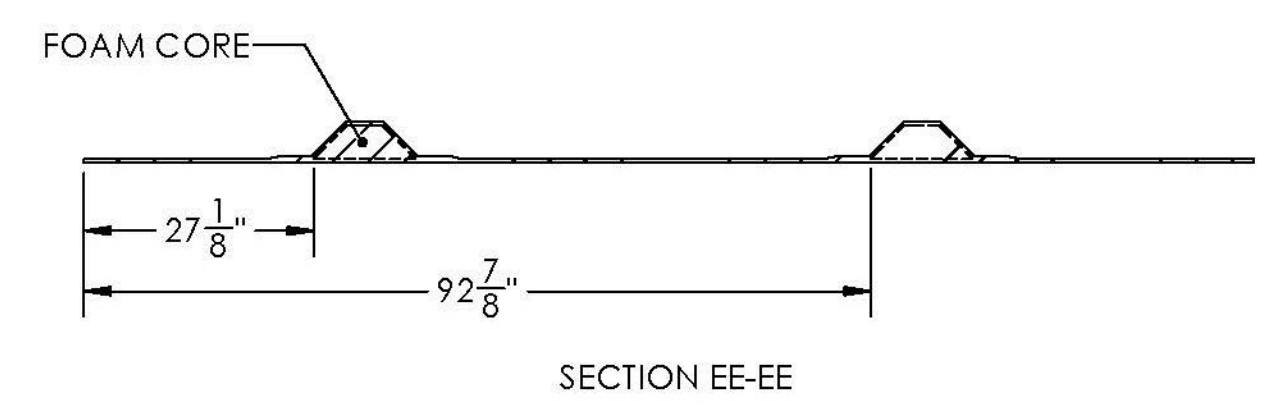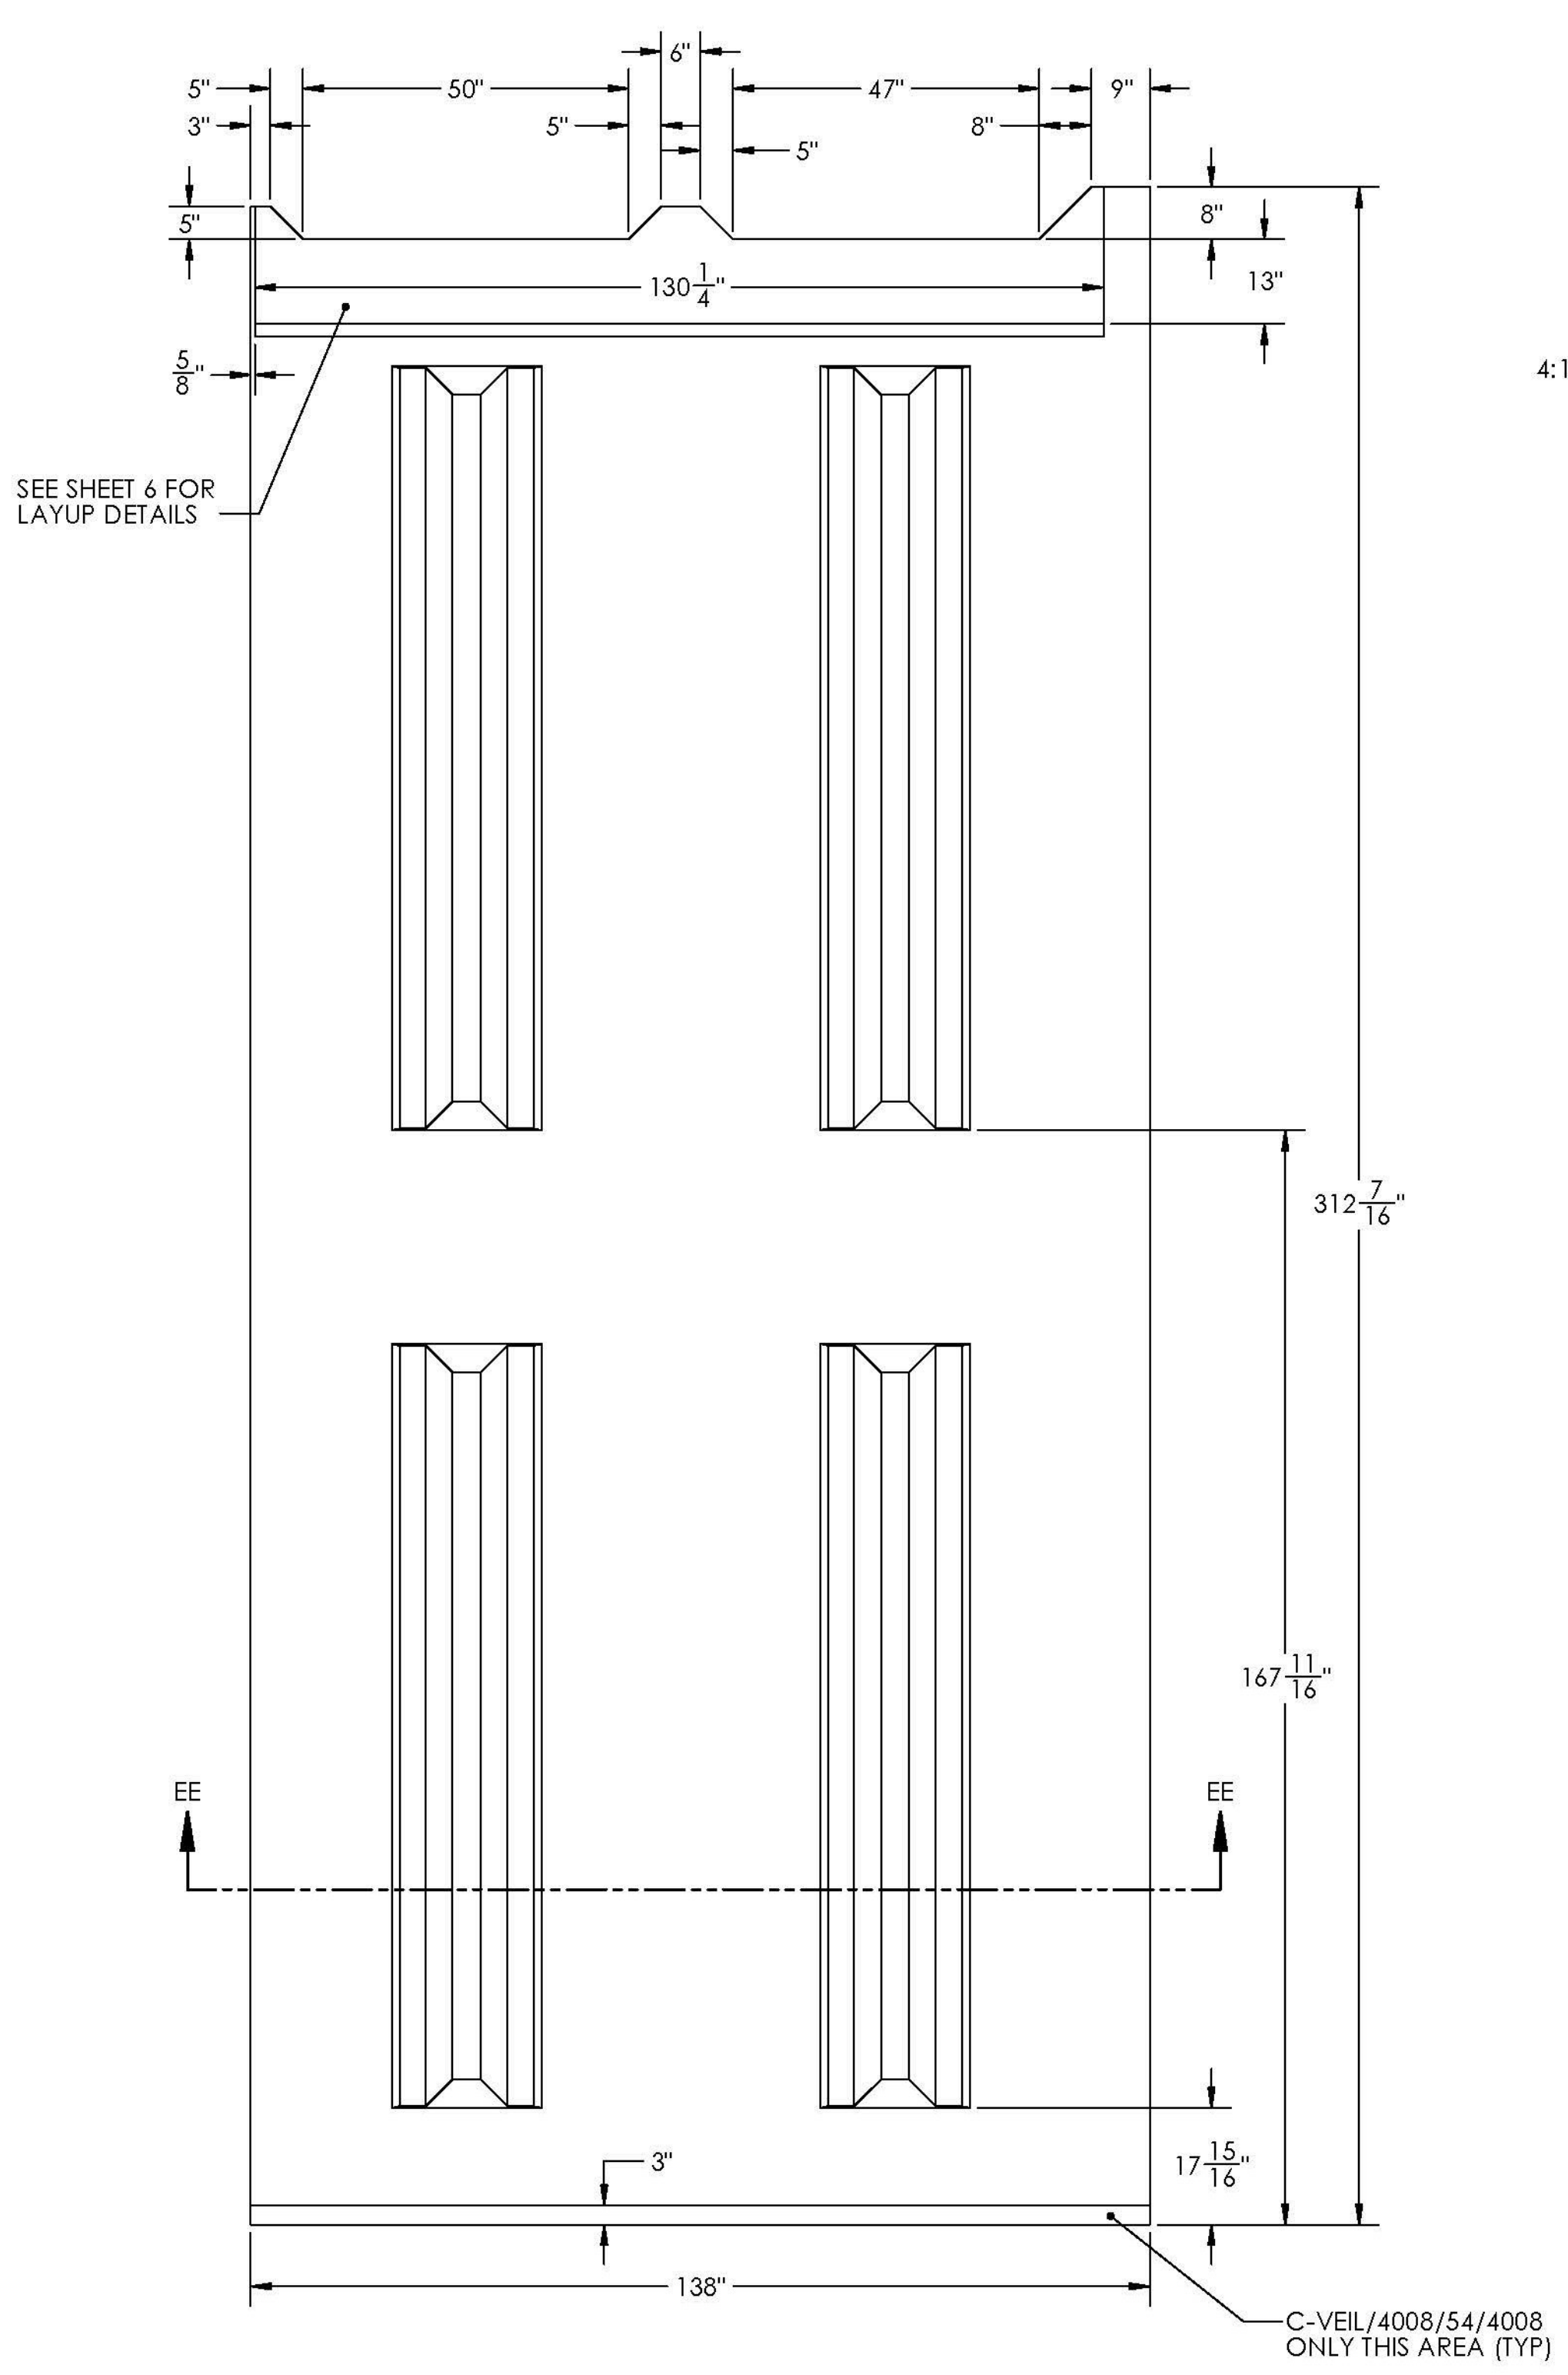

TOP PLATE SIDE A



TOP SIDE A SHOWN FOR PONTOONS 2 & 9 - MIRROR ABOUT LONGITUDINAL AXIS FOR PONTOONS 1 & 10

NOTE:
2 LAYERS OF 2" PERFORATED FOAM CORE WITH 1.5OZ CFM BETWEEN FOAM INFUSED WITH PRIMARY LAMINATE

FACING LAYUP SCHEDULE: (1) 4008 / (5) 54 / (1) 4008

SEE DETAIL M ON SHEET 13

Vermont Agency of Transportation
RECEIVED
ON: June 30, 2014
and Checked for
CONFORMANCE
BY: Jennifer Fitch DATE: 07/07/2014

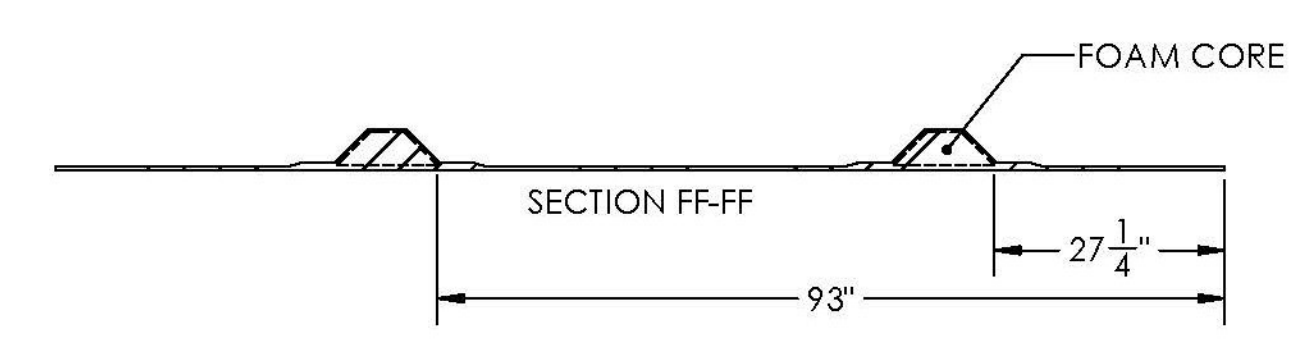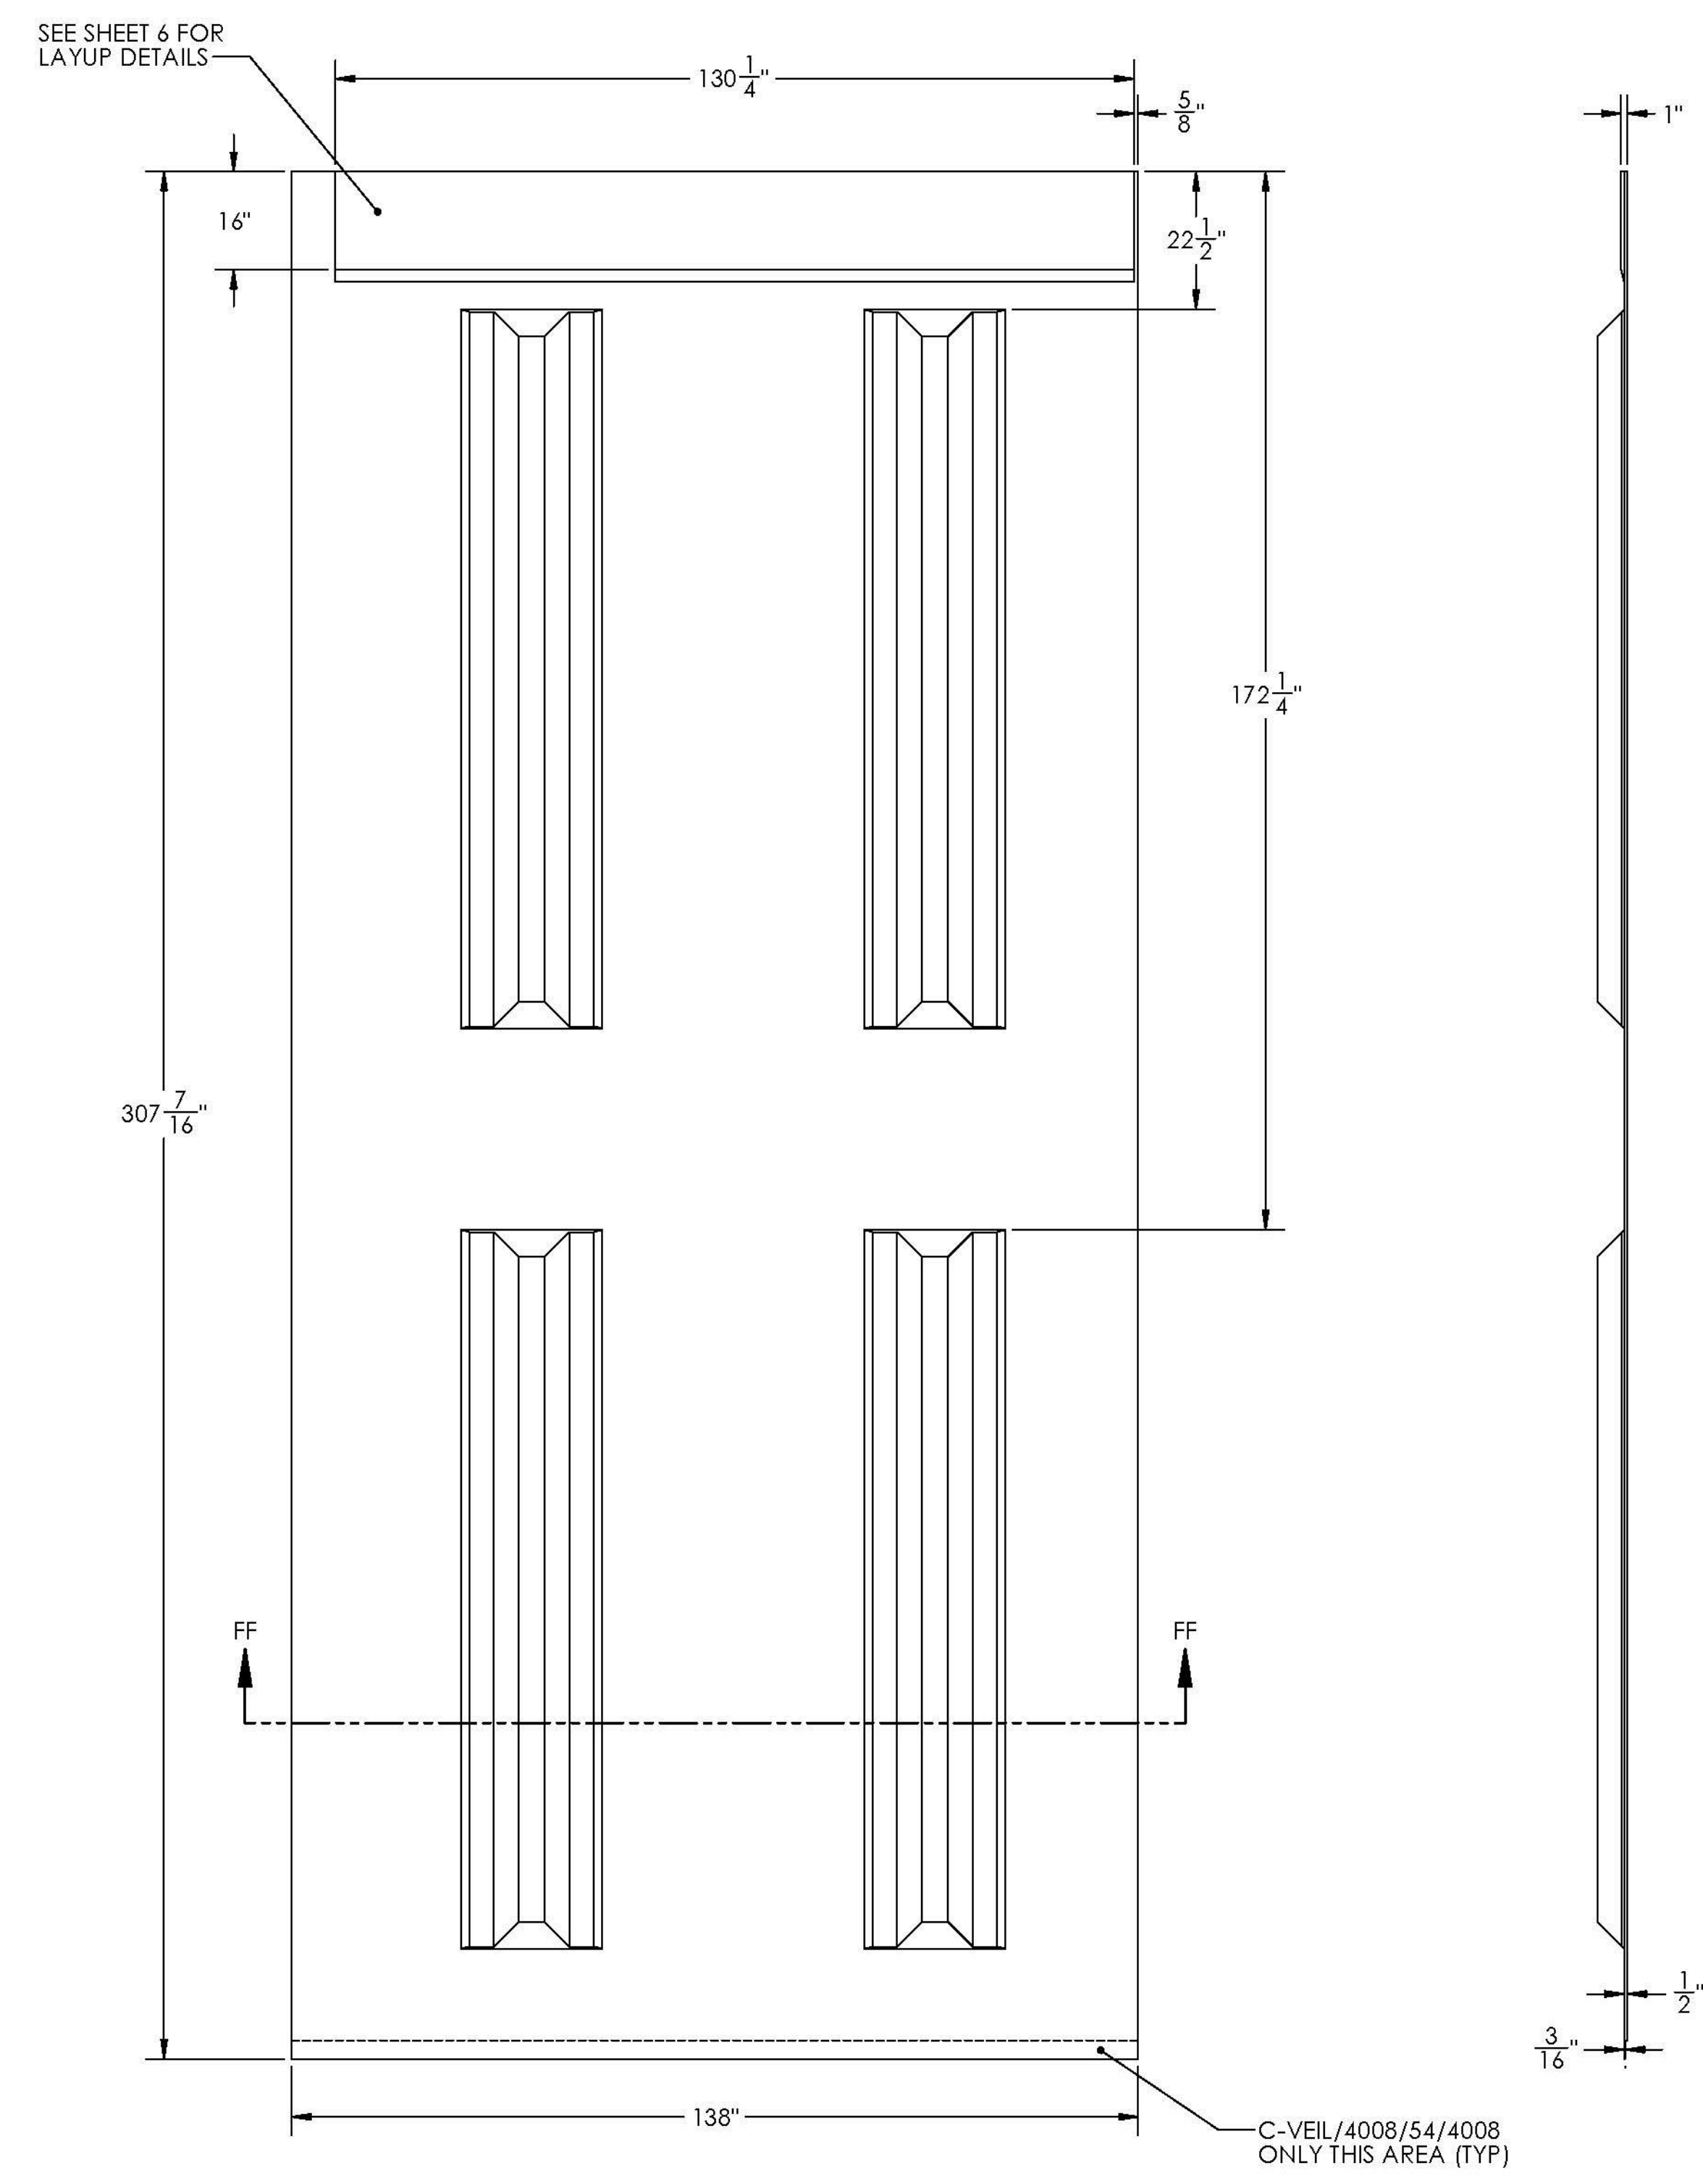

TOP PLATE SIDE B