



| DATE | REV | DESCRIPTION |
|------|-----|-------------|
| | | |
| | | |
| | | |

SEAL

DIMENSIONS ARE IN INCHES
 TOLERANCES: +0, -1/16"
 FRACTIONAL ±
 ANGULAR: MACH ±
 TWO PLACE DECIMAL ±
 BEND ±
 THREE PLACE DECIMAL ±


| | |
|----------|--------|
| DRAWN BY | DATE |
| ML | 6/4/14 |
| CHKD BY | DATE |
| JM | 6/4/14 |

PROJECT: BROOKFIELD FRP PONTOONS

CUSTOMER: MILLER CONST. / VTRANS

SHEET: HALF TOP PLATE INFUSION LAYOUT AND DETAILS

| | |
|-------------------|-------------|
| WEIGHT: | N/A |
| DESCRIPTION: | FABRICATION |
| SCALE: | 1 : 24 |
| WO NO.: | 8420 |
| CONTRACT NO.: | 9185 |
| DWG NO.: | 8420-6 |
| SHEET: | 16 OF 16 |
| PONTOON PART NO.: | N/A |
| PART NO.: | N/A |

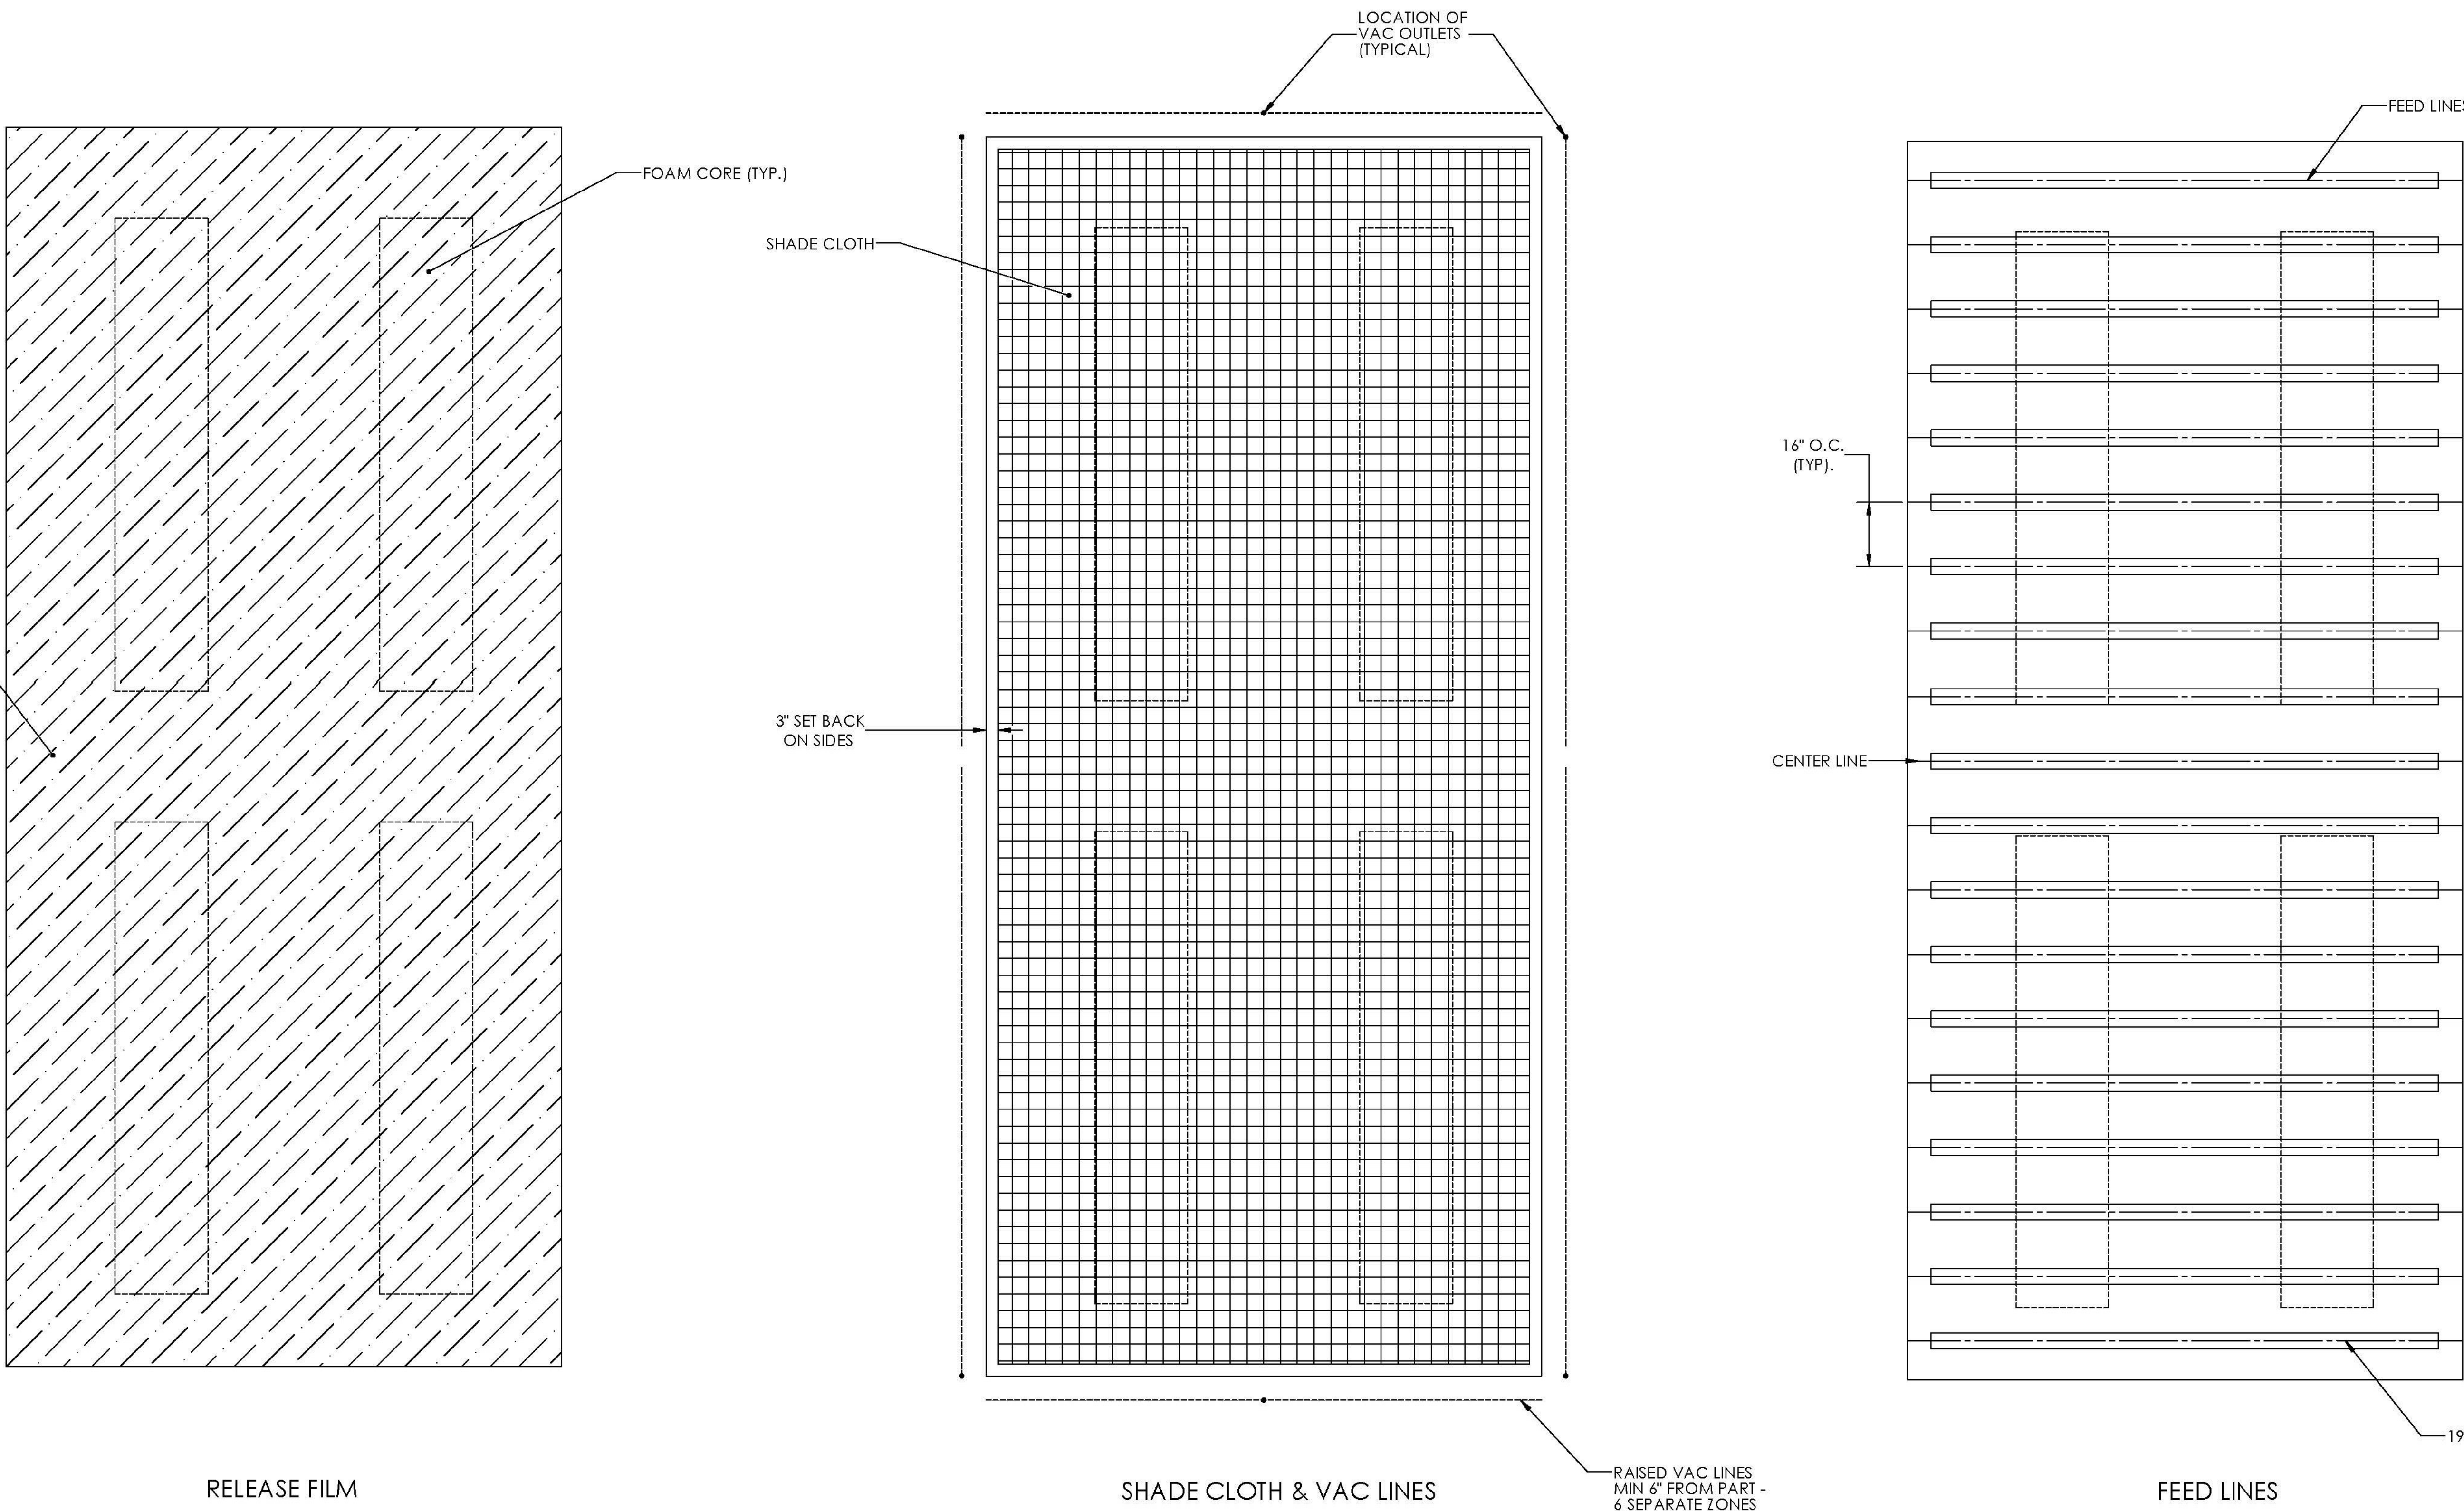

Vermont Agency of Transportation
RECEIVED
 ON: June 30, 2014
 and Checked for
CONFORMANCE
 BY: Jennifer Fitch DATE: 07/07/2014

INFUSION SET-UP DETAILS

T.Y. LIN INTERNATIONAL

THE STAMPED DOCUMENTS ARE HEREBY:

APPROVED
 APPROVED AS NOTED
 REVISE AND RESUBMIT

SEE TRANSMITTAL FOR ADDITIONAL INFORMATION AS APPLICABLE.

THIS REVIEW IS FOR GENERAL CONFORMANCE WITH DESIGN CONCEPT ONLY. ANY DEVIATION FROM THE PLANS OR SPECIFICATIONS NOT CLEARLY NOTED BY THE CONTRACTOR HAS NOT BEEN REVIEWED. REVIEW BY THE ENGINEER SHALL NOT RELIEVE THE CONTRACTOR OF THE CONTRACTUAL RESPONSIBILITY FOR ANY ERRORS OR DEVIATION FROM THE CONTRACT REQUIREMENTS.

JOSH OLUND REVIEWER 07/03/2014 DATE