


**STEEL ASSEMBLY BY OTHERS**

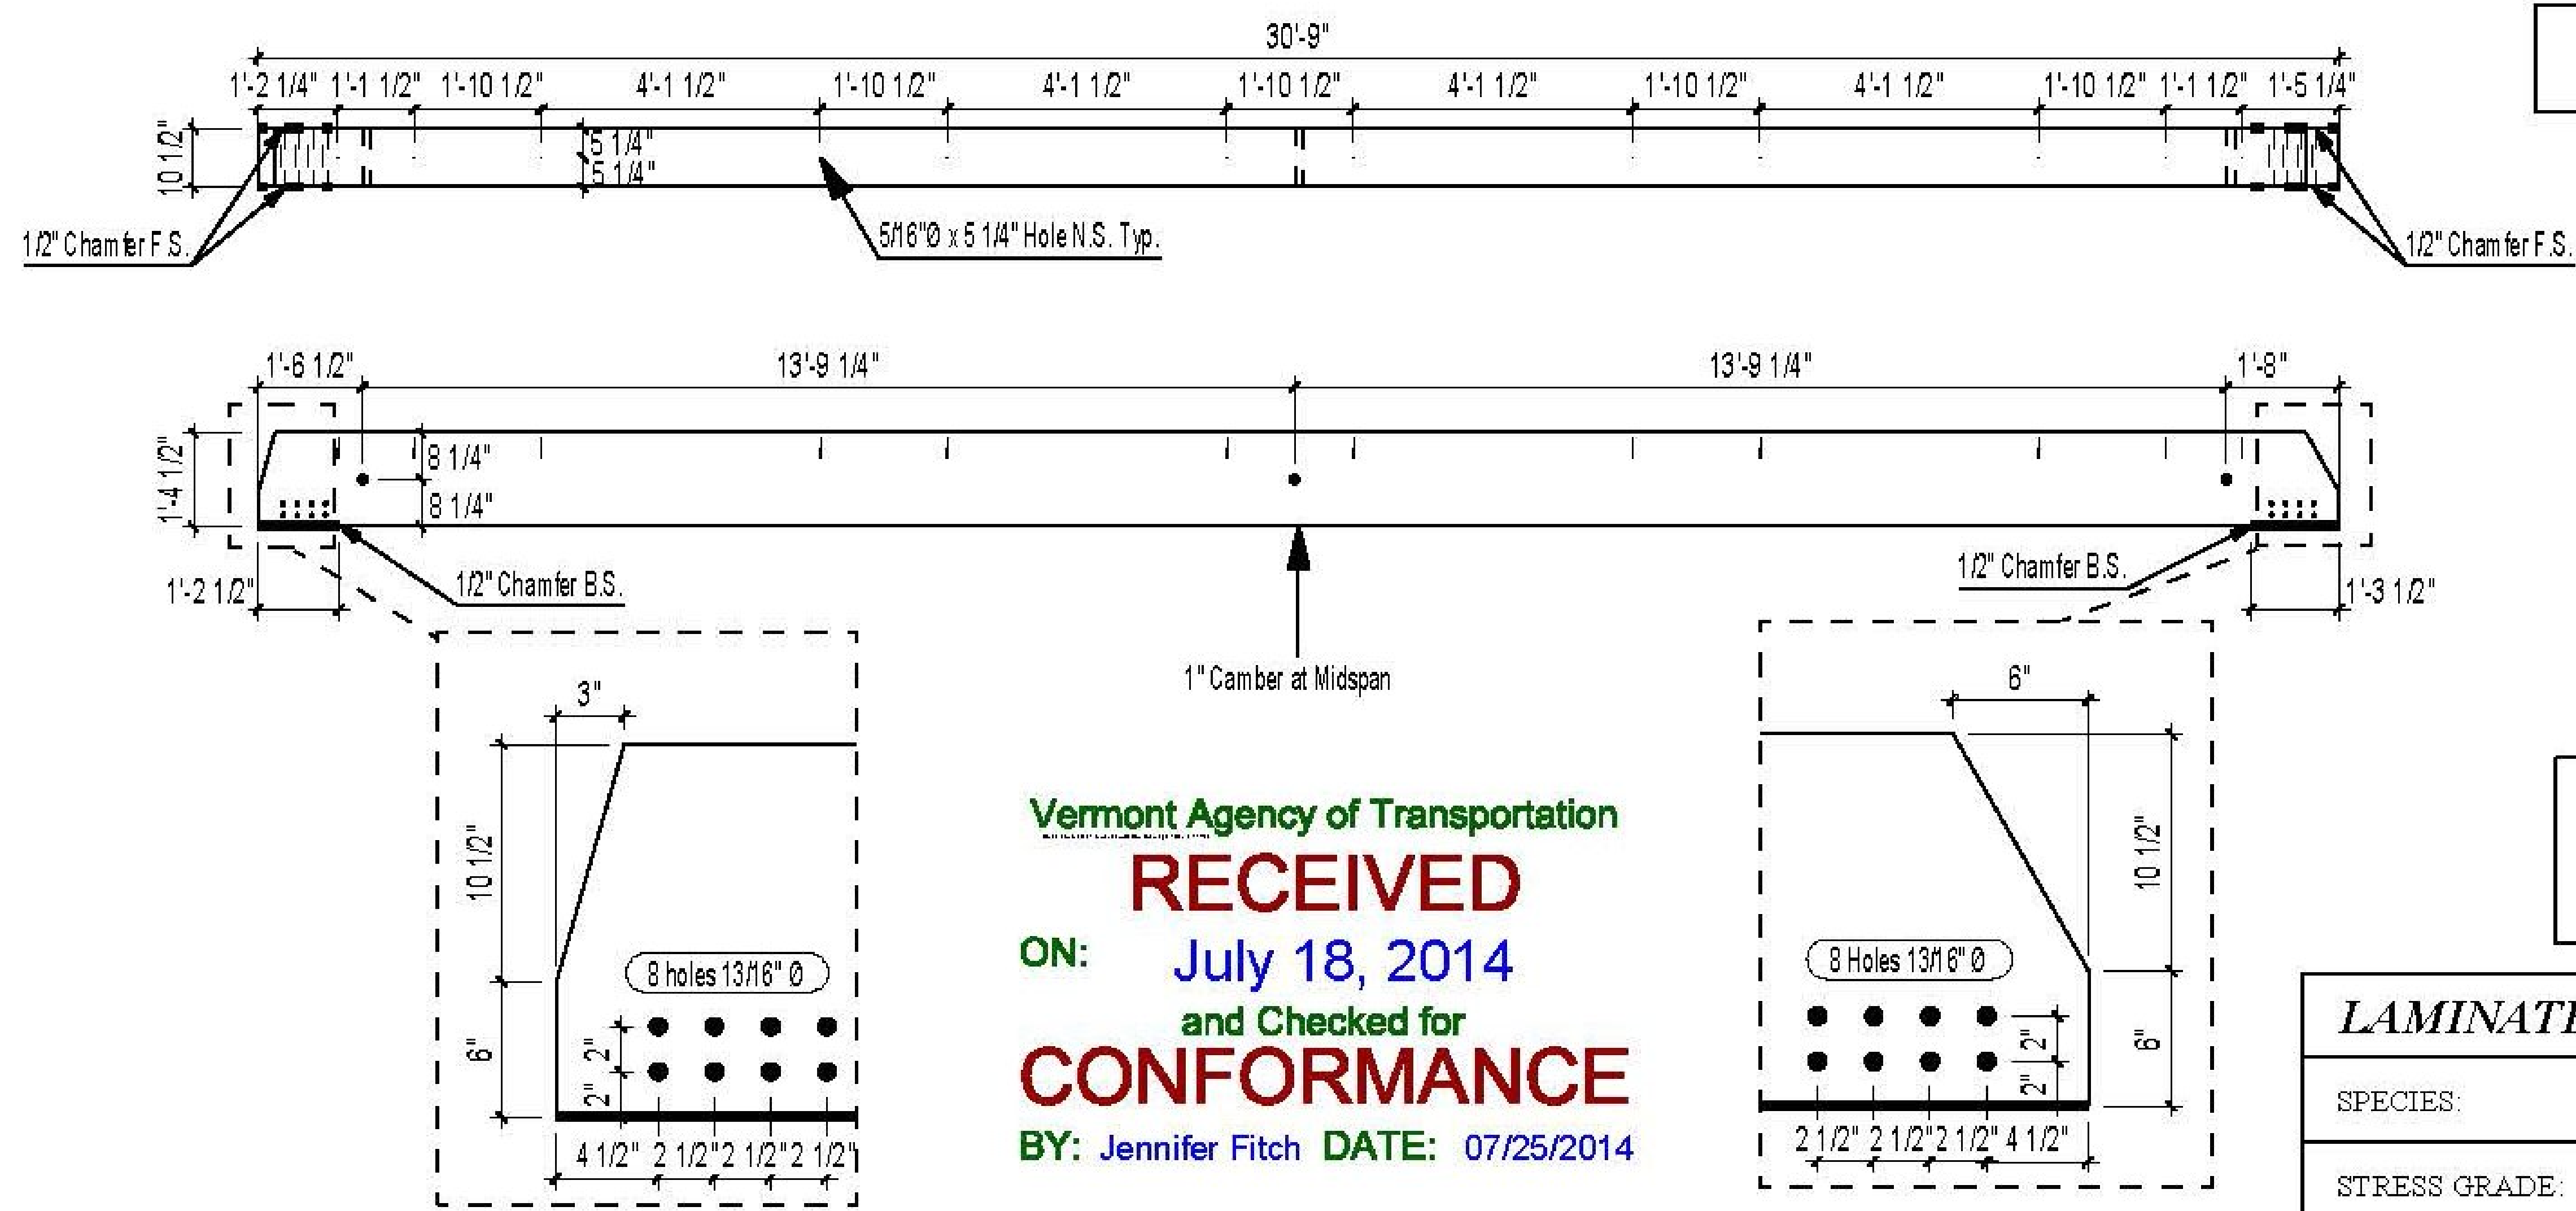

**T.Y. LIN INTERNATIONAL**  
 THE STAMPED DOCUMENTS ARE HEREBY:  
 APPROVED  
 APPROVED AS NOTED  
 REVISE AND RESUBMIT  
 SEE TRANSMITTAL FOR ADDITIONAL INFORMATION AS APPLICABLE.  
 THIS REVIEW IS FOR GENERAL CONFORMANCE WITH DESIGN CONCEPT ONLY. ANY DEVIATION FROM THE PLANS OR SPECIFICATIONS NOT CLEARLY NOTED BY THE CONTRACTOR HAS NOT BEEN REVIEWED. REVIEW BY THE ENGINEER SHALL NOT RELIEVE THE CONTRACTOR OF THE CONTRACTUAL RESPONSIBILITY FOR ANY ERRORS OR DEVIATION FROM THE CONTRACT REQUIREMENTS.  
 JOSH OLUND REVIEWER 07/22/2014 DATE

**FOR APPROVAL  
 NOT FOR CONSTRUCTION**

Vermont Agency of Transportation  
**RECEIVED**  
 ON: July 18, 2014  
 and Checked for  
**CONFORMANCE**  
 BY: Jennifer Fitch DATE: 07/25/2014

**LAMINATED TIMBER SPECIFICATION**

SPECIES:	SOUTHERN PINE
STRESS GRADE:	26F-1.9E
CAMBER:	1"
LAMINATIONS:	STANDARD 1-3/8"
AS PER ANSI/AITC A 190.1 IN ACCORDANCE W/ AITC 117 - CERTIFIED APA	
APPEARANCE GRADE:	INDUSTRIAL
MOISTURE CONTENT OF LAMINATIONS: MAXIMUM 16%	
ADHESIVE:	COMPLYING TO AITC A 190.1 WET-USE CONFORMING TO ASTM D 2559
LAMINATION LAYUP: COMPLYING TO AITC 117 ANNEX B TABLE B1	

Grade	Slope of grain	#of Lams
Top: 302-26	1:16	1
N1D	1:14	2
N1D	1:8	1
N1M	1:8	4
N1D	1:8	1
N1D	1:14	2
Bottom: 302-26	1:16	1

Lam splices are random

**Prod: B1**

<b>Glue Laminated Timber Beams 2-7</b>		PRINTED: 17.07.2014	HOLE TYP. U.N.O. 1 1/2" Ø	Qty: 12	Scale: 1/4" = 1'0"	Date: 05-02-2014	<b>Goodfellow inc.</b> 225, Goodfellow Street DELSON, QUEBEC, J5B 1V5 Tel.: 450-635-6511 Fax : 450-635-8304 www.goodfellowinc.com
Project: Floating Bridge (Brookfield) No.: 1314-150-U // G-28107 Customer: Wright Construction Co. Inc.	FABRICATION	July 17 Approval #3 June 25 Added Holes & Notes	Stress Grade: 26F-1.9E App. Grade: Industrial Treatment: Preservative Type II Penta Type A 0.60# AWPA Use Category UC4B Commodity 6F	X-section: 10 1/2" / 16-1/2" Length: 30'-9" Material: Southern Pine	By: J.R. Checked: M.R.		