
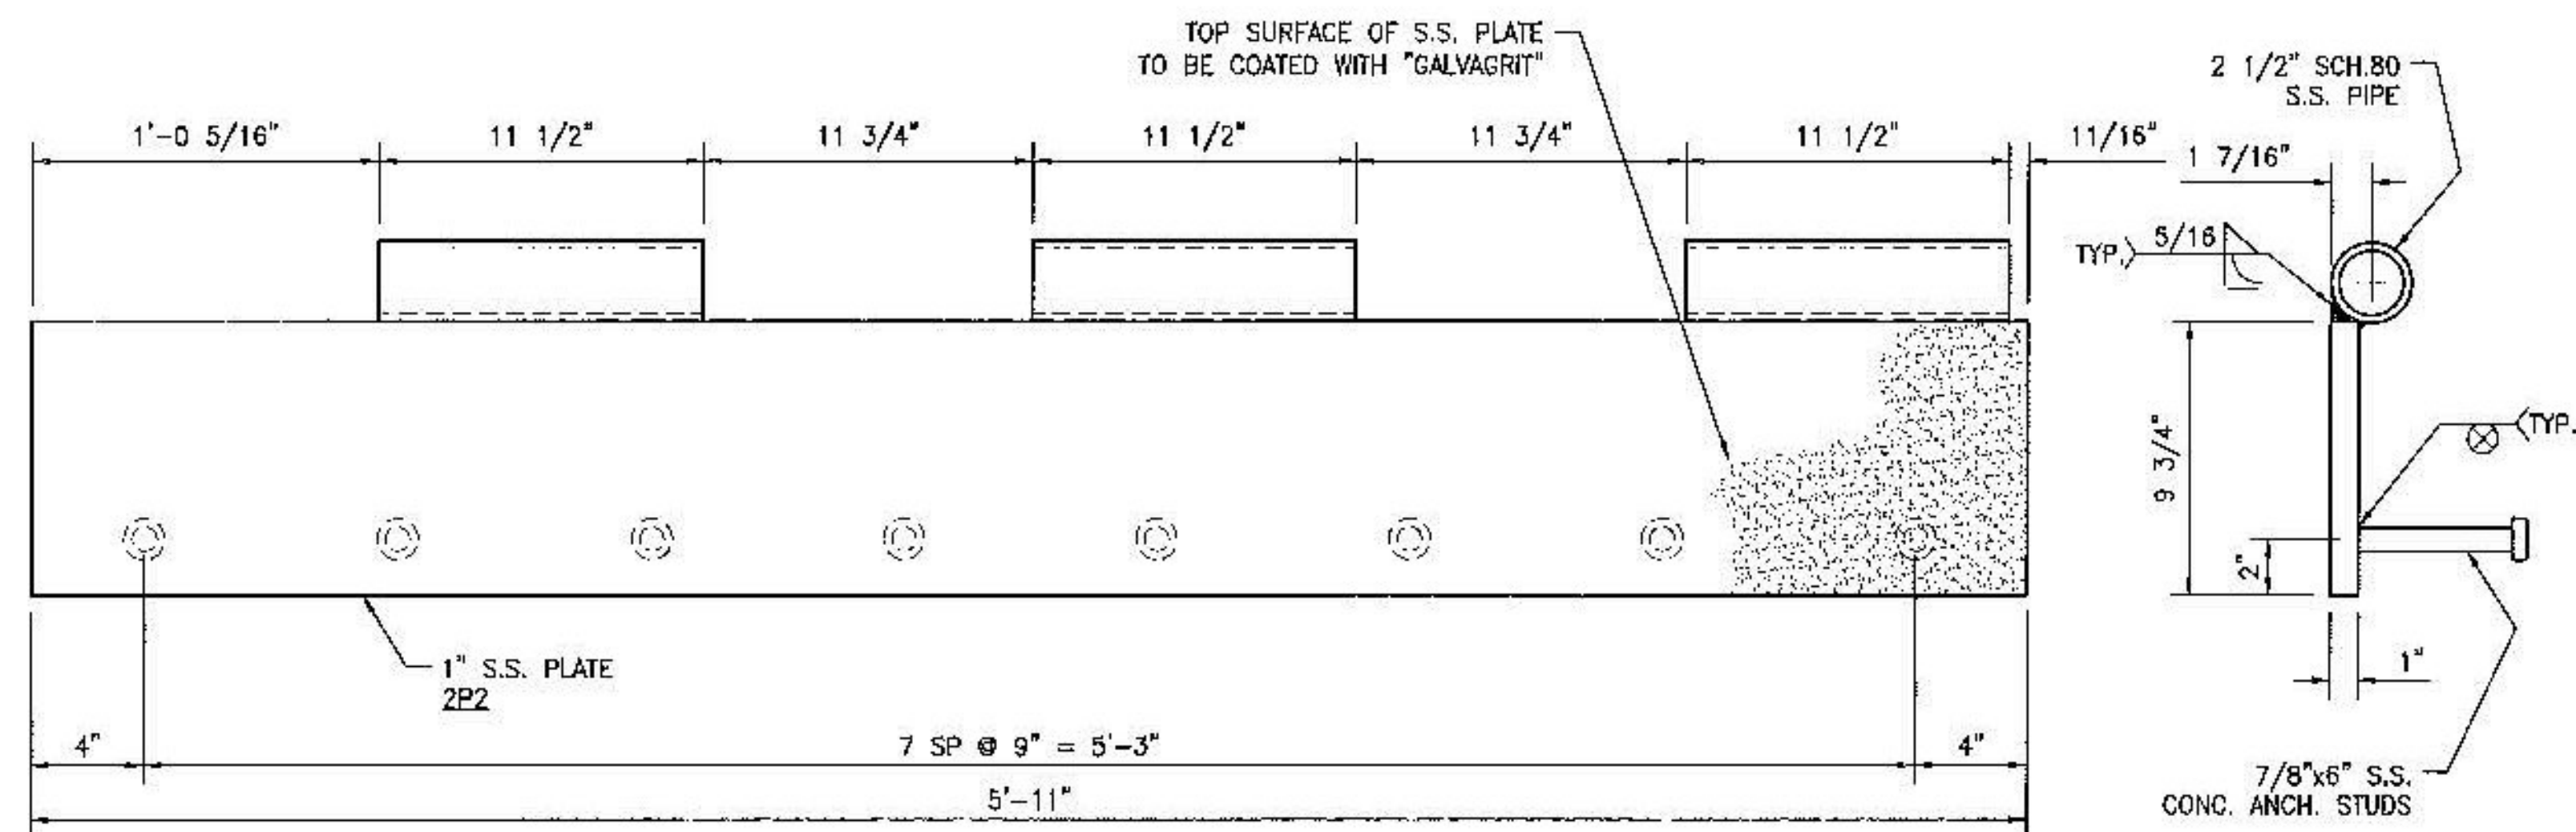
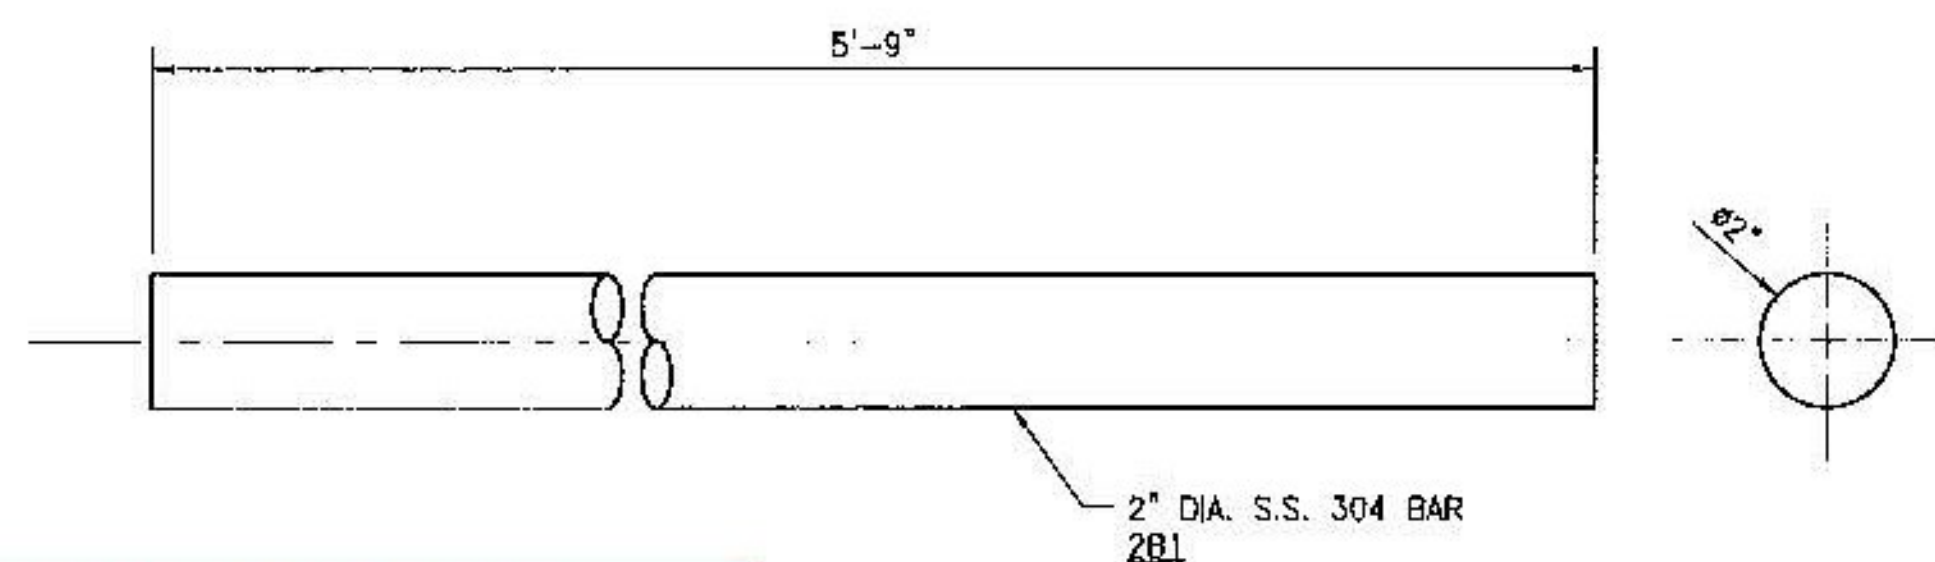



(4) - EMB154768AA
 ABUTMENT / RAMP - ROADWAY ASSEMBLY

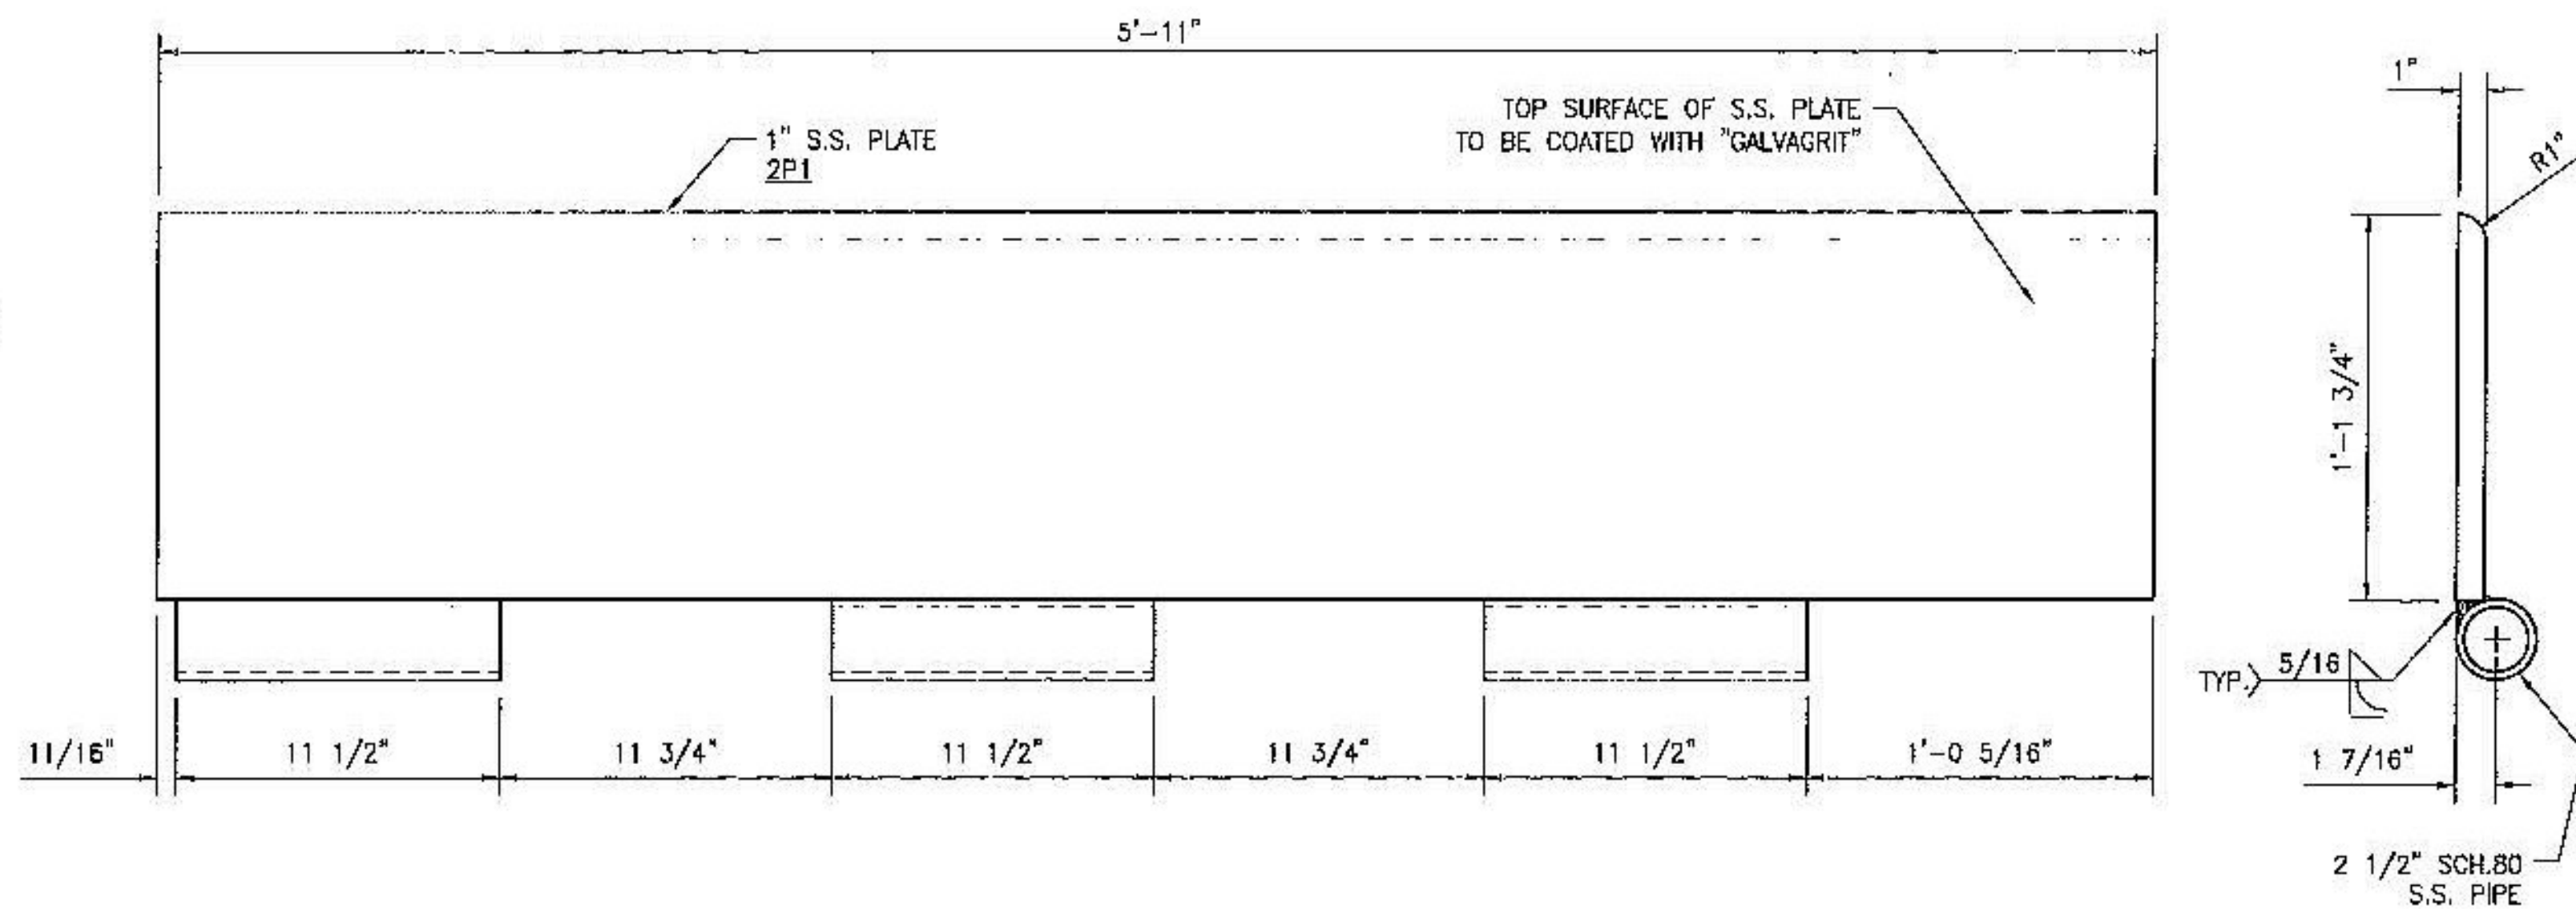

T.Y. LIN INTERNATIONAL
 THE STAMPED DOCUMENTS ARE HEREBY:
 X APPROVED
 APPROVED AS NOTED
 REVISE AND RESUBMIT
 SEE TRANSMITTAL FOR ADDITIONAL INFORMATION AS APPLICABLE.
 THIS REVIEW IS FOR GENERAL CONFORMANCE WITH DESIGN CONCEPT ONLY. ANY DEVIATION FROM THE PLANS OR SPECIFICATIONS NOT CLEARLY NOTED BY THE CONTRACTOR HAS NOT BEEN REVIEWED. REVIEW BY THE ENGINEER SHALL NOT RELIEVE THE CONTRACTOR OF THE CONTRACTUAL RESPONSIBILITY FOR ANY ERRORS OR DEVIATION FROM THE CONTRACT REQUIREMENTS.
 JOSH OLUND 06/25/2014
 REVIEWER DATE

Vermont Agency of Transportation
RECEIVED
 ON: June 20, 2014
 and Checked for
CONFORMANCE
 BY: Jennifer Fitch DATE: 06/26/2014

LV	PART NO.	QTY	UM	DESCRIPTION	MATERIAL	REVISION
0	EMB154768AA	1.00	EA	EMB, ABUT/RAMP - ROADWAY ASSY.; 5.92'	UNCOATED SHIPPING LENGTH = 6'	
				GALVAGRIT (FINE) COATING ON TOP SURFACES OF 1" PLATES	APPROX. SHIPPING WEIGHT = 650 lb	
1	NTS154768A	520.00	LB	STNLS STL 1" TYPE 304 NO FIN	2P1, 2P2	
1	NTS154768B	6.00	FT	2 1/2" SCH.80 S.S. PIPE (A)		
1	NTS154768C	6.00	EA	7/8" x 6" CONC. ANCH. STUDS S.S. ASTM F593 (A)		
1	NTS154768D	5.75	FT	ROUND BAR 2" S.S. 304 (A)	2B1	
				#N/A #N/A		

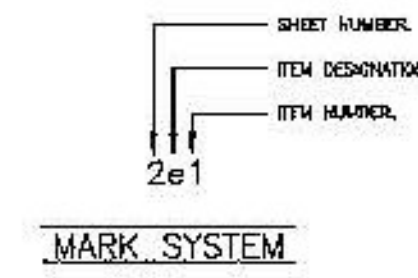

STATE: VERMONT
 COUNTY: ORANGE
 PROJECT NO.: BRFLBR(2)
 REFERENCE NO.: XXXXXXXXX
 DISTRICT: XXX ROUTE: 65
 WBA PRODUCT NO.: EMB154768AA-AF

DRAWING ACTION:
 SUBMITTED FOR APPROVAL
 DATE: 6/5/14

REVISOR: TEB
 REVISION: 1
 REVISION DESCRIPTION: REVISED PER REVIEWERS COMMENTS
 INFORMATION PROVIDED HEREIN, INCLUDING BUT NOT LIMITED TO, ANY DRAWING, DESIGN, PHOTOGRAPH, GRAPHIC, OR STATEMENT(S) ("MATERIALS") ARE PROPRIETARY AND THE PROPERTY OF WATSON-BOWMAN ACMA CORPORATION ("COMPANY"). REPRODUCTION, TRANSMISSION, OR REDUCTION TO ANY ELECTRONIC MEDIA OR MACHINE-READABLE FORM, IN WHOLE OR PART, IS STRICTLY PROHIBITED, EXCEPT FOR THE EXPRESS PURPOSE FOR WHICH IT HAS BEEN FURNISHED, WITHOUT PRIOR WRITTEN CONSENT OF COMPANY. ALL MATERIALS CONTAINED HEREIN ARE PROVIDED BY COMPANY FOR INFORMATION PURPOSES ONLY. COMPANY RESERVES THE RIGHT TO AMEND OR WITHDRAW ANY INFORMATION CONTAINED IN THE MATERIALS WITHOUT NOTICE. ALL TECHNICAL OR OTHER ADVICE BY COMPANY, WHETHER VERBAL OR WRITTEN, CONCERNING PRODUCTS, OR THE USE OF PRODUCTS IN SPECIFIC SITUATIONS ("ADVICE") IS GIVEN BY COMPANY AND IS USED AT THE USER'S OWN RISK.

PROJECT: VERMONT RTE. 65
 REPLACEMENT OF FLOATING BRIDGE
 WABO EMB HINGED SLIDING PLATE JOINT DETAILS
 SCALE: NONE
 SHEET NO.: 2 OF 6
 DATE: 6/4/14
 DATE: 6/6/14
 WBA JOB NO.: 154768
 DRAWING NO.: D-31790