




(4) - EMB154768AAP
ABUTMENT / RAMP - ROADWAY ASSEMBLY

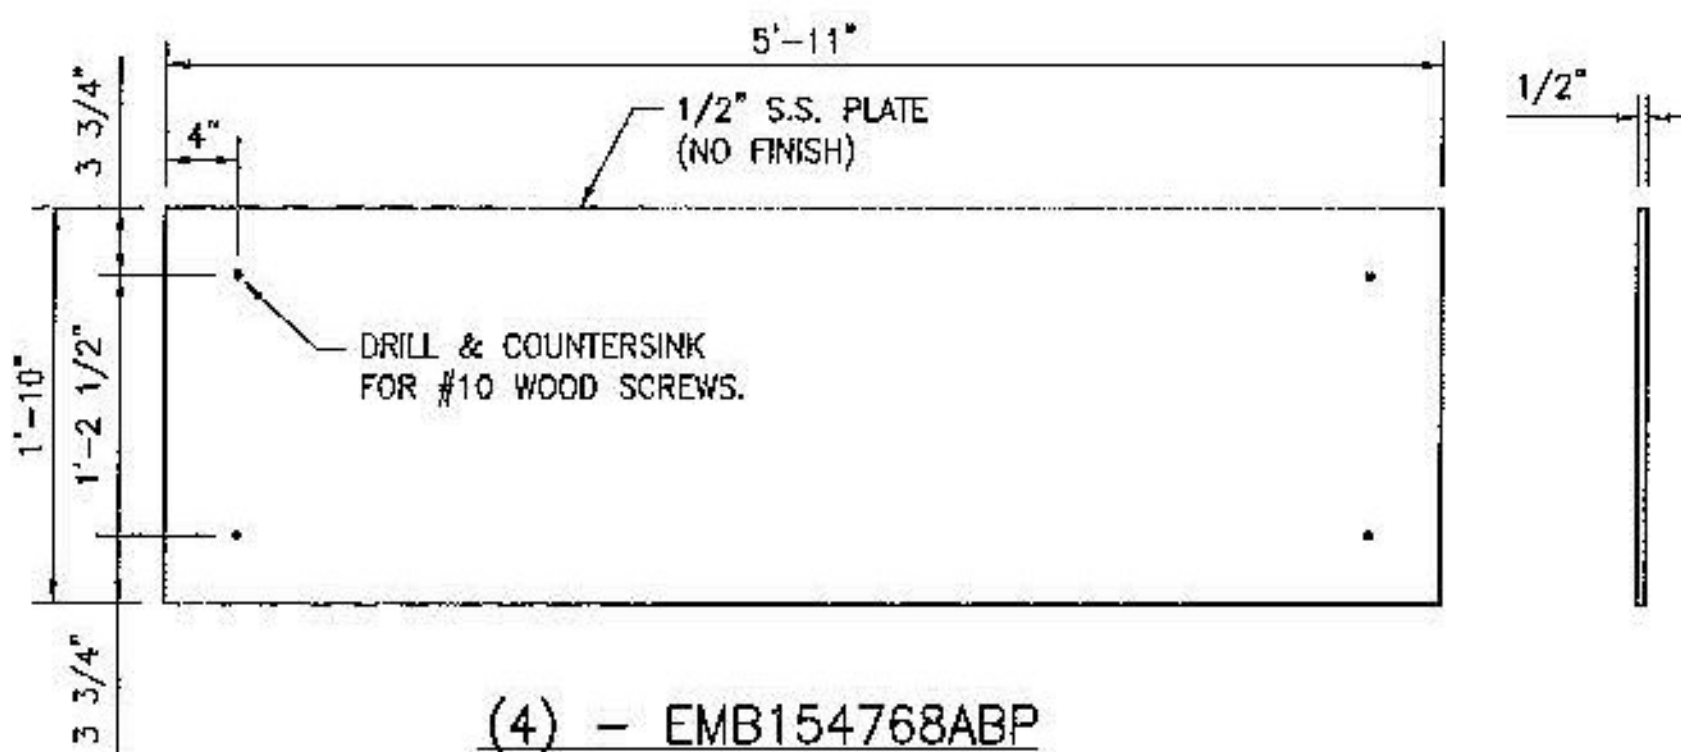

(4) - EMB154768ABP
RAMP / FLOAT - ROADWAY ASSEMBLY

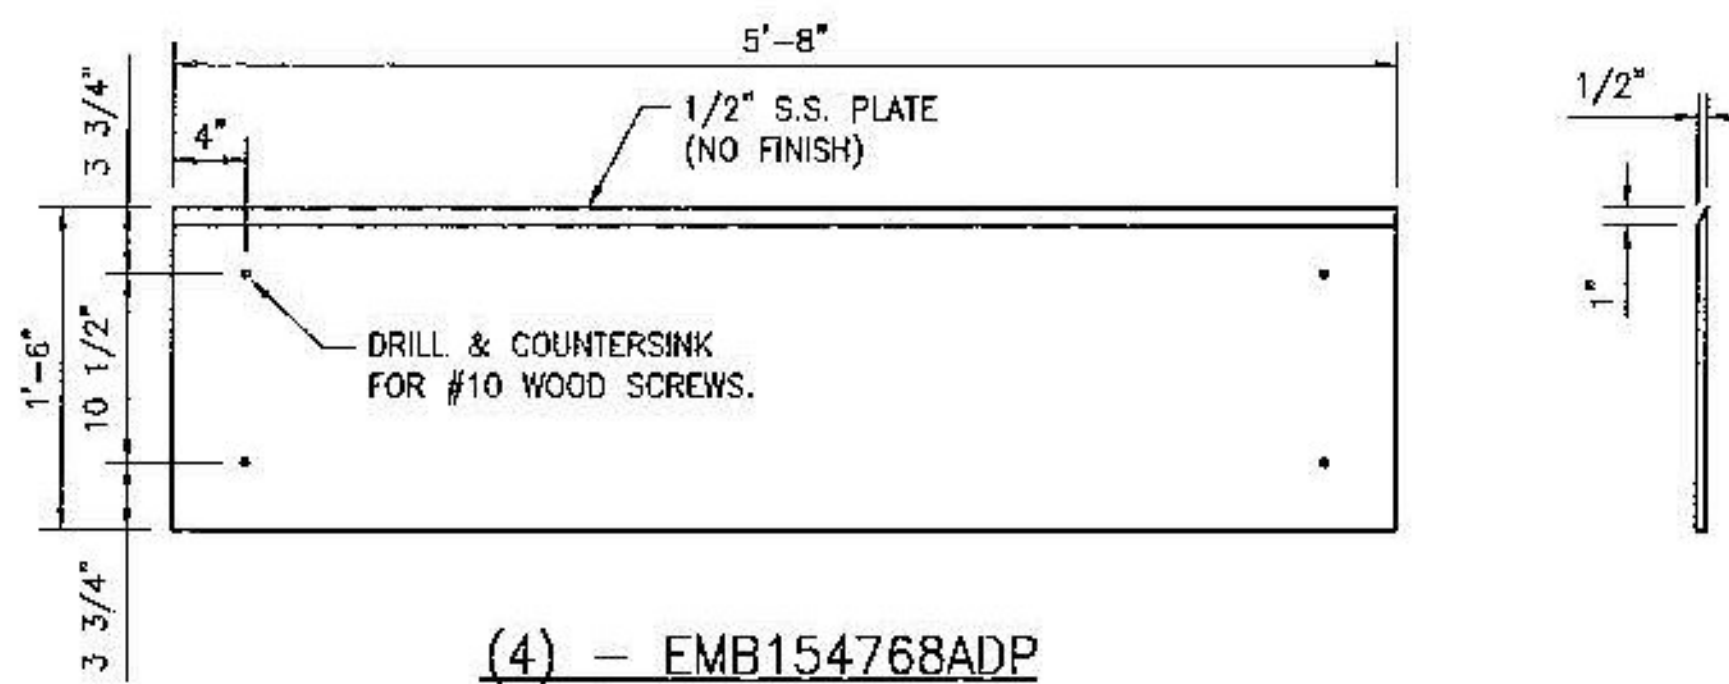

(4) - EMB154768ADP
ABUTMENT / RAMP - SIDEWALK ASSEMBLY

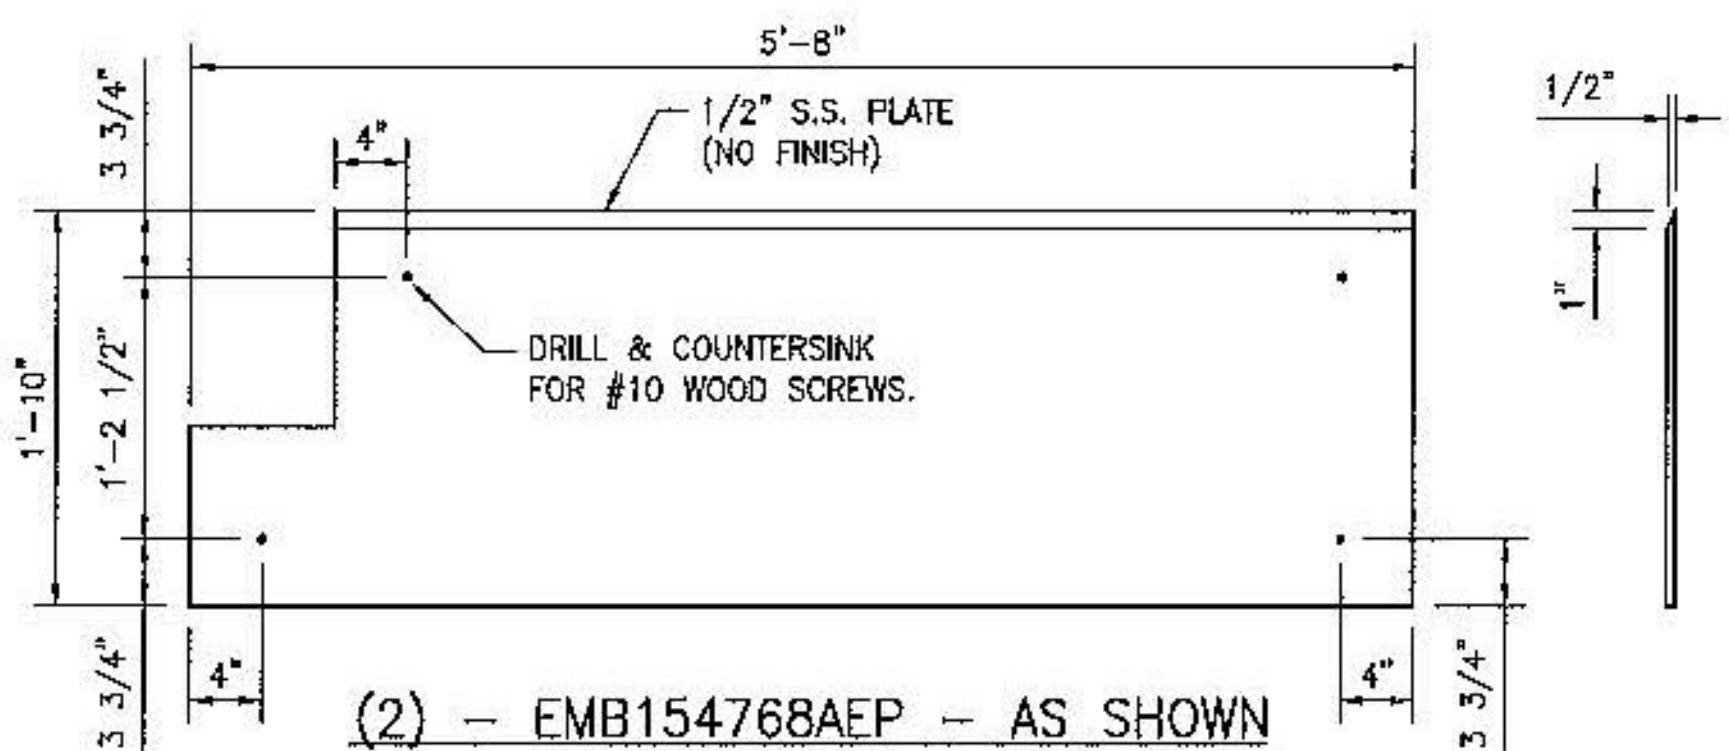

(2) - EMB154768AEP - AS SHOWN
(2) - EMB154768AFP - OPP. HAND
RAMP / FLOAT - SIDEWALK ASSEMBLY

LV	PART NO.	QTY	UM	DESCRIPTION	MATERIAL	REVISION
0	EMB154768AAP	1.00	EA	EMB ABUT/RAMP - ROADWAY BEARING PLATE.	UNCOATED	
					SHIPPING LENGTH = 6±	
					APPROX. SHIPPING WEIGHT = 195 lb	
1	8591	195.00	LB	STNLS STL 1/2 TYPE 304 NO FIN		

LV	PART NO.	QTY	UM	DESCRIPTION	MATERIAL	REVISION
0	EMB154768ABP	1.00	EA	EMB RAMP/FLOAT - ROADWAY BEARING PLATE.	UNCOATED	
					SHIPPING LENGTH = 6±	
					APPROX. SHIPPING WEIGHT = 240 lb	
1	8591	240.00	LB	STNLS STL 1/2 TYPE 304 NO FIN		

LV	PART NO.	QTY	UM	DESCRIPTION	MATERIAL	REVISION
0	EMB154768ADP	1.00	EA	EMB ABUT/RAMP - SIDEWALK BEARING PLATE.	UNCOATED	
					SHIPPING LENGTH = 6±	
					APPROX. SHIPPING WEIGHT = 185 lb	
1	8591	185.00	LB	STNLS STL 1/2 TYPE 304 NO FIN		

LV	PART NO.	QTY	UM	DESCRIPTION	MATERIAL	REVISION
0	EMB154768AEP	1.00	EA	EMB RAMP/FLOAT - SIDEWALK BEARING PLATE.	UNCOATED	
					SHIPPING LENGTH = 6±	
					APPROX. SHIPPING WEIGHT = 225 lb	
1	8591	225.00	LB	STNLS STL 1/2 TYPE 304 NO FIN		

LV	PART NO.	QTY	UM	DESCRIPTION	MATERIAL	REVISION
0	EMB154768AFP	1.00	EA	EMB RAMP/FLOAT - SIDEWALK BEARING PLATE.	UNCOATED	
					SHIPPING LENGTH = 6±	
					APPROX. SHIPPING WEIGHT = 225 lb	
1	8591	225.00	LB	STNLS STL 1/2 TYPE 304 NO FIN		

LV	PART NO.	QTY	UM	DESCRIPTION	MATERIAL	REVISION
0	EMB154768PB1	1.00	EA	PARTS FOR SHIPPING		
1	NTS154768H	32.00	EA	LAG BOLT 1/2"x6" S.S. (A)		
1	NTS154768J	8.00	EA	LAG BOLT 1/2"x8" S.S. (A)		
1	NTS154768K	75.00	EA	WOOD SCREW #10x3 1/2" S.S. (A)		
1	7540	45.00	EA	WASHER 1/2 (A) STAINLESS STEEL		



**FULL DIMENSION
PLATES ONLY**

Vermont Agency of Transportation
RECEIVED
ON: June 20, 2014
and Checked for
CONFORMANCE
BY: Jennifer Fitch DATE: 06/26/2014

T.Y. LIN INTERNATIONAL
THE STAMPED DOCUMENTS ARE HEREBY:
 APPROVED
 APPROVED AS NOTED
 REVISE AND RESUBMIT
SEE TRANSMITTAL FOR ADDITIONAL INFORMATION AS APPLICABLE.
THIS REVIEW IS FOR GENERAL CONFORMANCE WITH DESIGN CONCEPT ONLY. ANY DEVIATION FROM THE PLANS OR SPECIFICATIONS NOT CLEARLY NOTED BY THE CONTRACTOR HAS NOT BEEN REVIEWED. REVIEW BY THE ENGINEER SHALL NOT RELIEVE THE CONTRACTOR OF THE CONTRACTUAL RESPONSIBILITY FOR ANY ERRORS OR DEVIATION FROM THE CONTRACT REQUIREMENTS.
JOSH OLUND 06/25/2014
REVIEWER DATE

SHEET NUMBER: 261
REV DESCRIPTION:
REV NUMBER:
MARK SYSTEM

STATE: VERMONT
COUNTY: ORANGE
PROJECT NO.: BRP FLBR(2)
REFERENCE NO.: XXXXXXXXX
DISTRICT: XXX ROUTE: 65
WBA PRODUCT NO.: EMB154768AA-AF

DRAWING ACTION:
SUBMITTED FOR APPROVAL
DATE: 6/5/14

REVISOR: TEB
DATE: 6/5/14
REVISIONS:
REVISED PER REVIEWERS COMMENTS
Information provided herein, including but not limited to, any drawing, design, photograph, graphic, or statement(s) ("Materials") are proprietary and the property of Watson Bowman Arme Corporation ("Company"). Reproduction, translation, or retransmission to any electronic medium or machine readable form, in whole or part, is strictly prohibited, except for the express purpose for which it has been furnished, without prior written consent of Company. All Materials contained herein are provided by Company for information purposes only. Company reserves the right to amend or withdraw any information provided in the Materials without notice. All technical or other advice by Company, whether verbal or written, concerning products, or the use of products in specific situations ("Advice") is given by Company and is used at the Users own risk.

Watson Bowman Arme
Vermont Bridge & Arme Corp.
55 Main St., 2nd Fl.
Winooski, VT 05410
Phone: 802-239-1188
Fax: 802-239-1189
www.wbcorp.com

BASF
The Chemical Company

DESIGNED BY: TEB DATE: 6/4/14
CHECKED BY: TPL DATE: 6/6/14
SCALE: NONE WBA JOB NO.: 154768
SHEET NO.: 6 OF 6 DRAWING NO.: D-31790

PROJECT: VERMONT RTE 65
REPLACEMENT OF FLOATING BRIDGE
WAGO EMB HINGED SLIDING PLATE JOINT DETAILS