

Vermont Agency of Transportation


RECEIVED

ON: April 18, 2014


and Checked for

CONFORMANCE

BY: Jennifer Fitch DATE: 04/22/2014

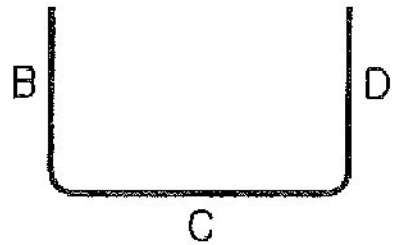

17

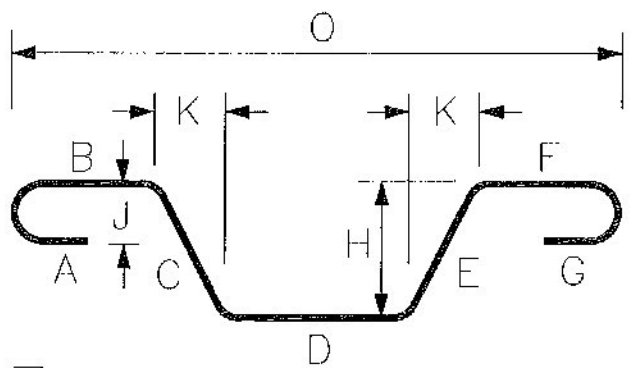

3 Hooks A & G optional