

189 SB ST. ALBANS - SWANTON

VT 105 TROY - NEWPORT

189 NB & SB COLCHESTER

VT 15 COLCHESTER - ESSEX

191NB & SB DERBY

189 NB SO. BURLINGTON - COLCHESTER

189 NB RICHMOND - SO. BURLINGTON

US 302 GROTON - RYEGATE

US 302 RYEGATE-NEWBURY (CO #001)

US 302 BARRE TOWN

VT 25 TOPSHAM - ORANGE

NORWICH STATE HIGHWAY

US 5 HARTFORD


VT 30 CASTLETON - SUDBURY

191NB SPRINGFIELD

US 7 MANCHESTER - DORSET

191NB & SB GUILFORD - BRATTLEBORO

~~& GUILFORD WELCOME CENTER~~ NOT DONE W.O. #001

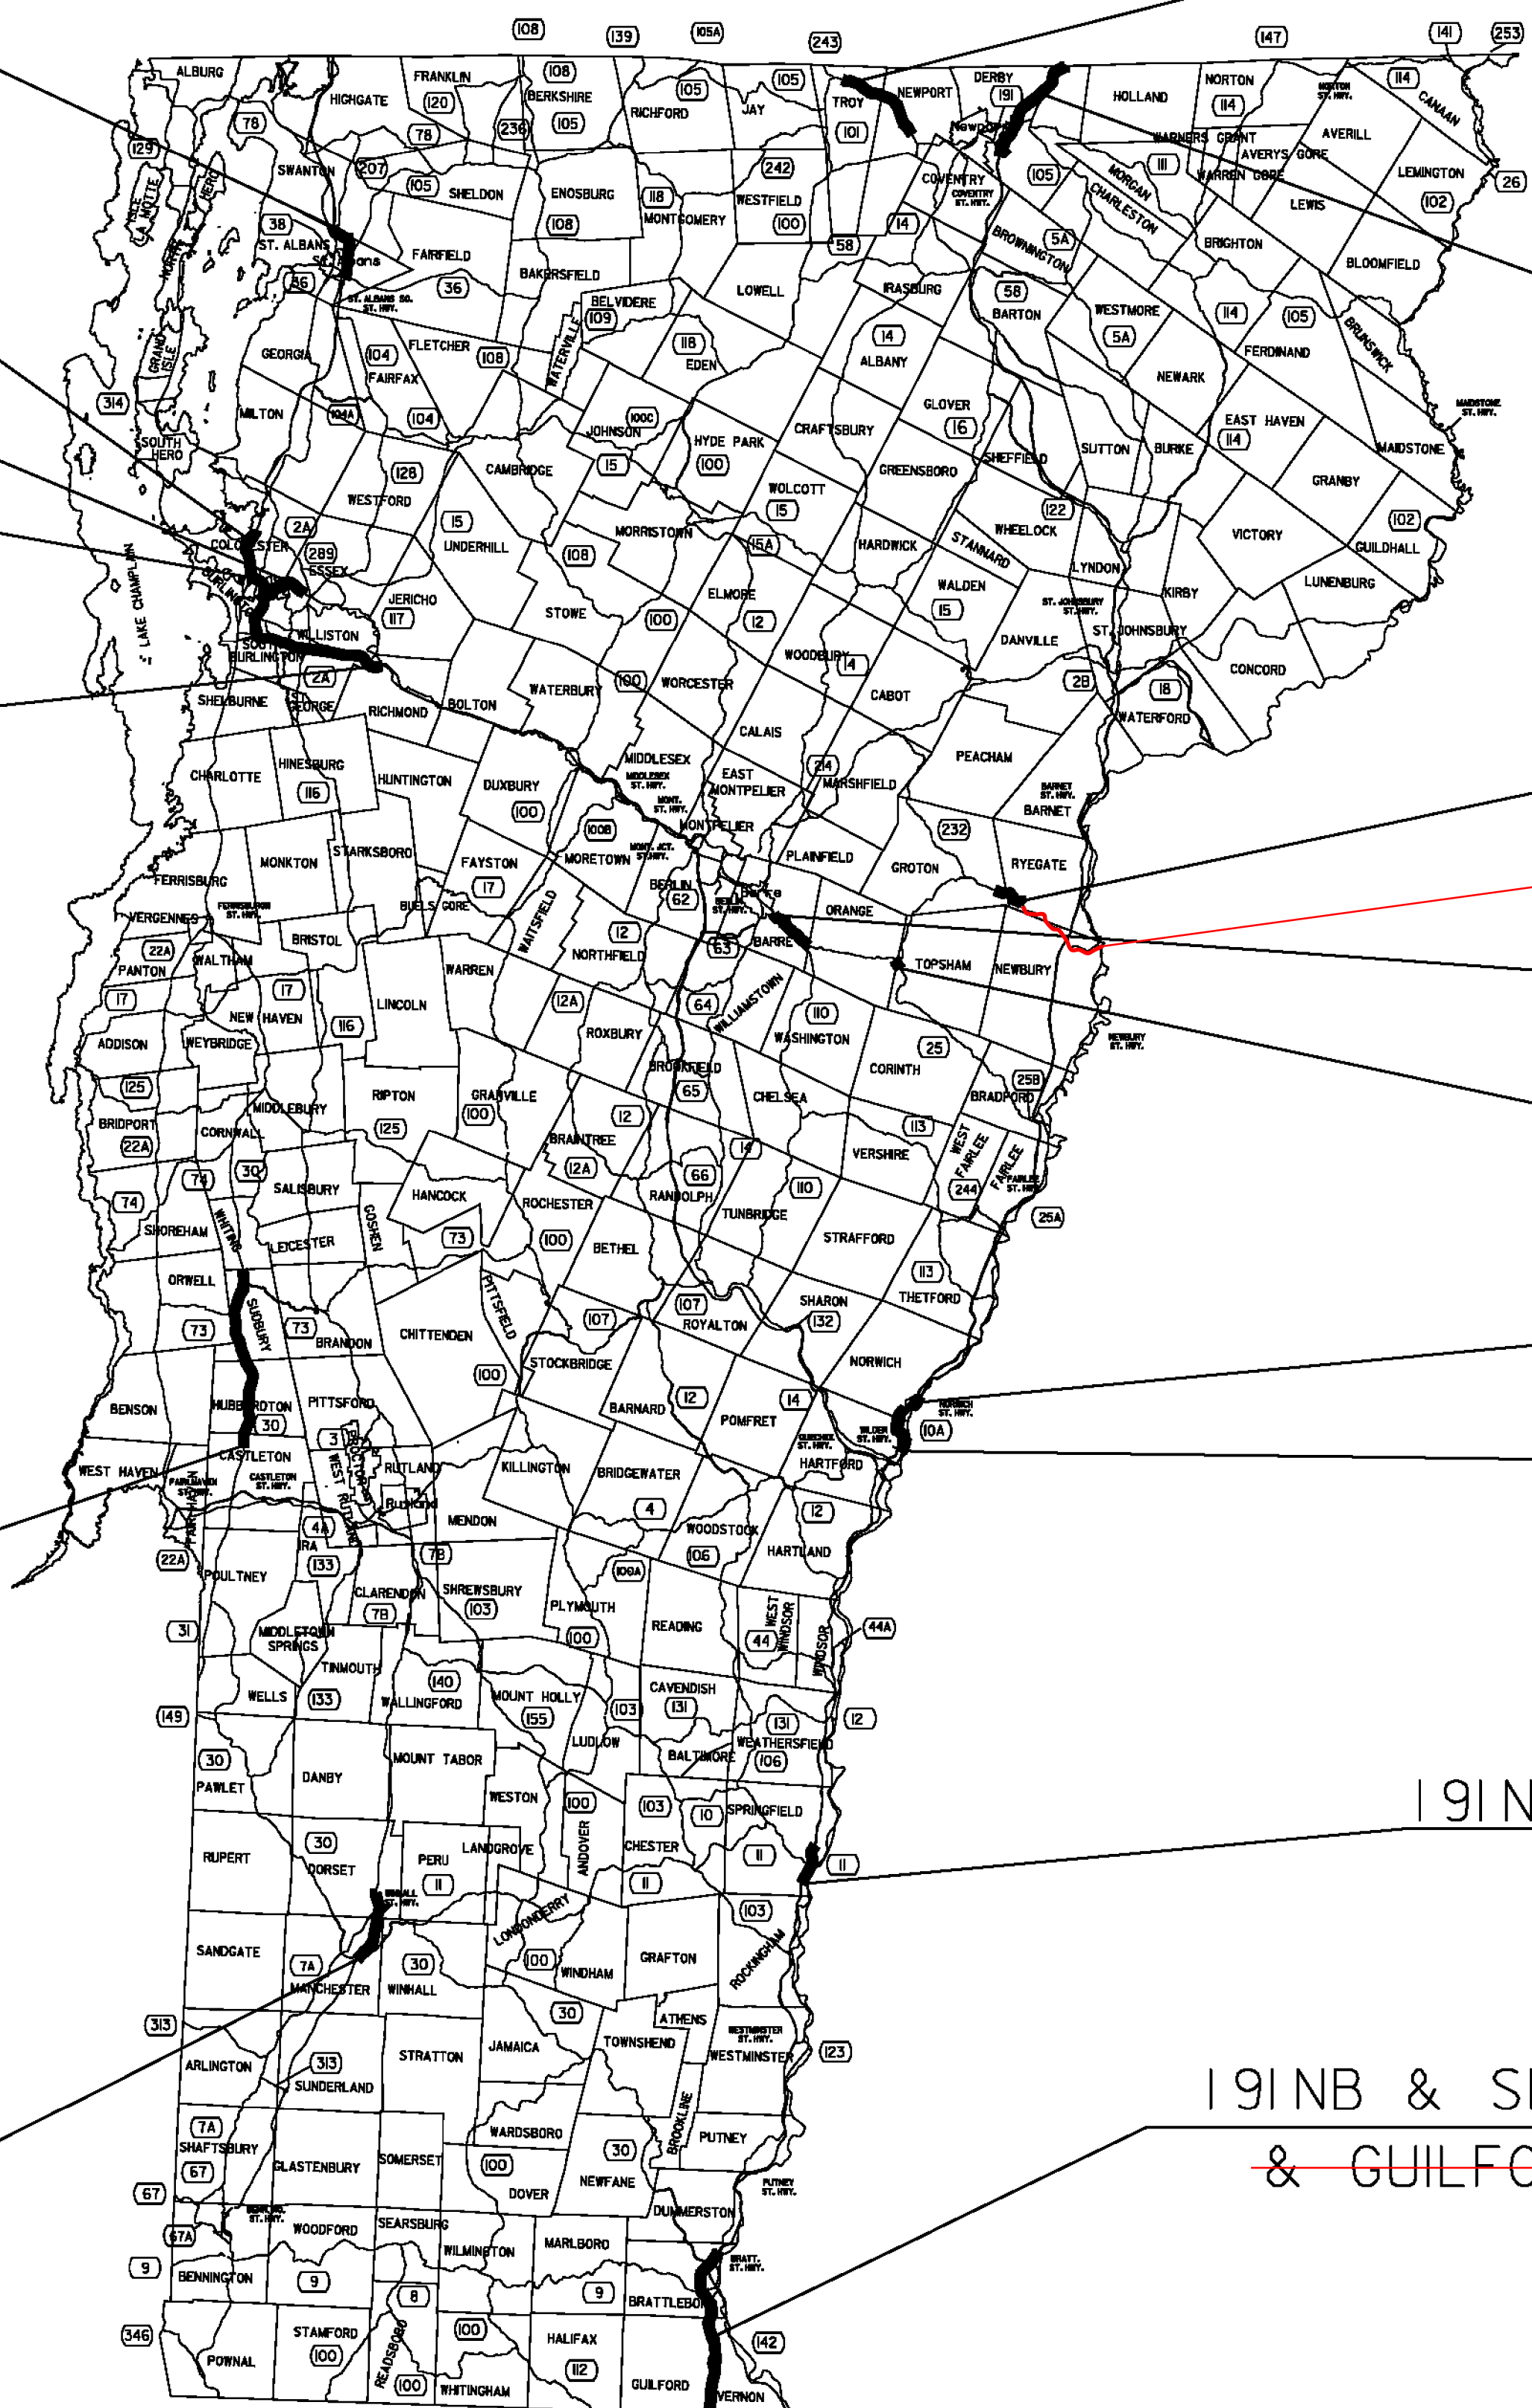

RCD
10-31-2012

**LOCATION
LAYOUT**

PROJECT NAME:	STATEWIDE
PROJECT NUMBER:	STP CRAK(30)
FILE NAME:	p12k010.dgn
PROJECT LEADER:	FOWLER
DESIGNED BY:	LOCKE
p12k0101.I	
PLOT DATE:	12-APR-2012
DRAWN BY:	LOCKE
CHECKED BY:	PAVT MGMT
SHEET	4 OF 18