




BURLINGTON INTERCHANGE #14
I-89

NOT TO SCALE

RAMPS REQUIRING CRACK SEALING

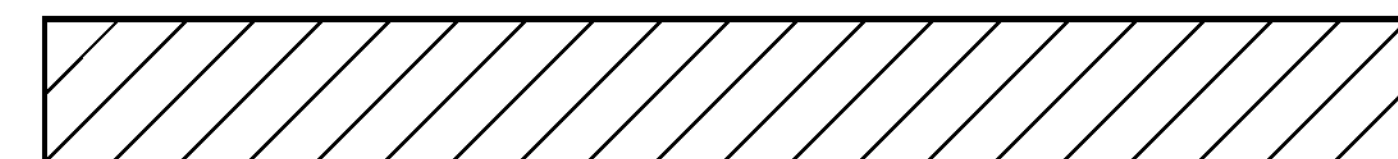

INTERCHANGE
DETAIL
SHEET # 3

PROJECT NAME: STATEWIDE
 PROJECT NUMBER: STP CRAK(30)

FILE NAME: pl2k010.dgn
 PROJECT LEADER: FOWLER
 DESIGNED BY: LOCKE
 pl2k010Int3.1

PLOT DATE: 12-APR-2012
 DRAWN BY: LOCKE
 CHECKED BY: PAVT MGMT
 SHEET 8 OF 18