


RAMPS REQUIRING CRACK SEALING

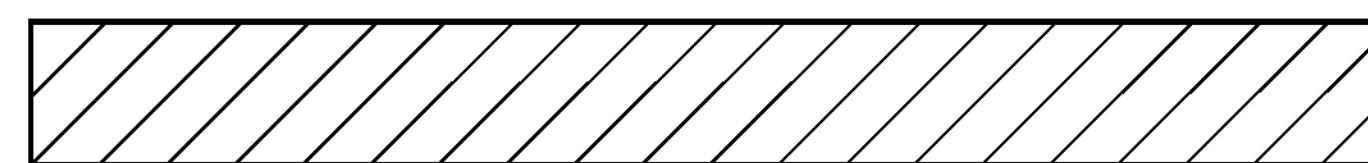

ST. ALBANS NORTH INTERCHANGE #20
I-89

NOT TO SCALE

INTERCHANGE
DETAIL
SHEET # 6

PROJECT NAME: STATEWIDE
 PROJECT NUMBER: STP CRAK(30)

FILE NAME: pl2k010.dgn
 PROJECT LEADER: FOWLER
 DESIGNED BY: LOCKE
 pl2k010Int6.I

PLOT DATE: 12-APR-2012
 DRAWN BY: LOCKE
 CHECKED BY: PAVT MGMT
 SHEET 11 OF 18