


NEWPORT INTERCHANGE # 27
I-91

RAMPS REQUIRING CRACK SEALING

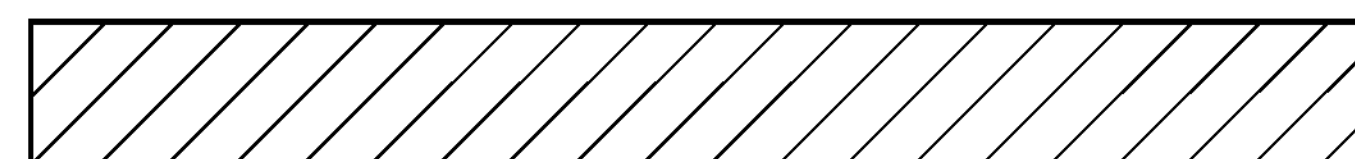

INTERCHANGE
DETAIL
SHEET # 8

PROJECT NAME: STATEWIDE
 PROJECT NUMBER: STP CRAK(30)

FILE NAME: pl2k010.dgn
 PROJECT LEADER: FOWLER
 DESIGNED BY: LOCKE
 pl2k010In+8.1

PLOT DATE: 12-APR-2012
 DRAWN BY: LOCKE
 CHECKED BY: PAVT MGMT
 SHEET 13 OF 18

NOT TO SCALE