


DERBY INTERCHANGE # 28
I-91

RAMPS REQUIRING CRACK SEALING

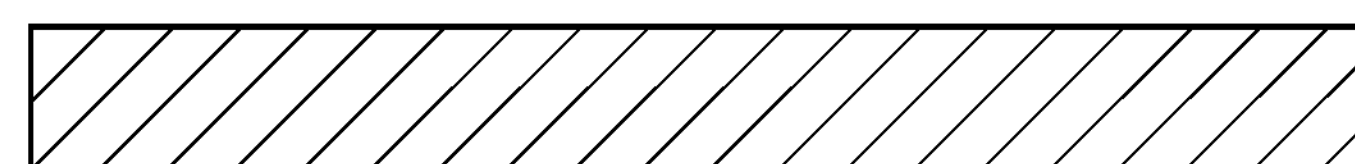

INTERCHANGE
DETAIL
SHEET # 9

PROJECT NAME: STATEWIDE
 PROJECT NUMBER: STP CRAK(30)

FILE NAME: pl2k010.dgn
 PROJECT LEADER: FOWLER
 DESIGNED BY: LOCKE
 pl2k010t9.1

PLOT DATE: 12-APR-2012
 DRAWN BY: LOCKE
 CHECKED BY: PAVT MGMT
 SHEET 14 OF 18

NOT TO SCALE