


MANCHESTER INTERCHANGE #4
US 7

RAMPS REQUIRING CRACK SEALING

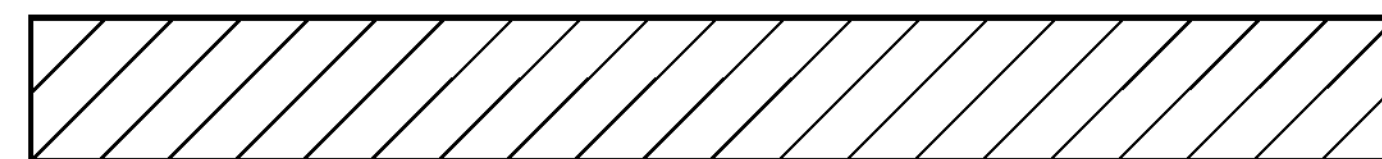

NOT TO SCALE

INTERCHANGE
DETAIL
SHEET # 12

PROJECT NAME: STATEWIDE	PLOT DATE: 12-APR-2012
PROJECT NUMBER: STP CRAK(30)	DRAWN BY: LOCKE
FILE NAME: pl2k010.dgn	CHECKED BY: PAVT MGMT
PROJECT LEADER: FOWLER	SHEET 17 OF 18
DESIGNED BY: LOCKE	
pl2k010In+12.1	