


**RANDOLPH INTERCHANGE # 4**  
**I-89**

NOT TO SCALE

RAMPS REQUIRING CRACK SEALING

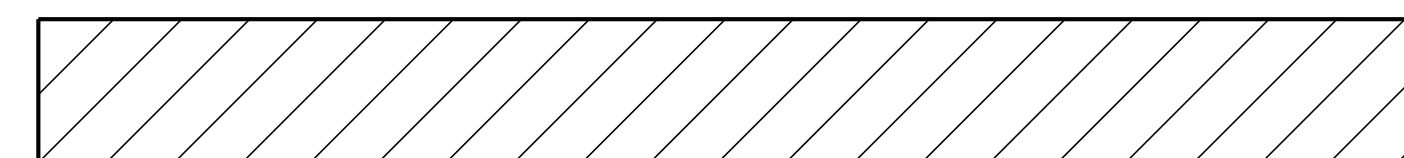

<b>INTERCHANGE DETAIL SHEET # 2</b>	PROJECT NAME: STATEWIDE	PLOT DATE: 28-FEB-2014 16:17
	PROJECT NUMBER: STP CRAK(3I)	DRAWN BY: LOCKE
	FILE NAME: p12k558.dgn	CHECKED BY: HARRINGTON
	PROJECT LEADER: FOWLER	SHEET 8 OF 14
	DESIGNED BY: LOCKE	
	p12k558in+2.i	