


RAMPS REQUIRING CRACK SEALING

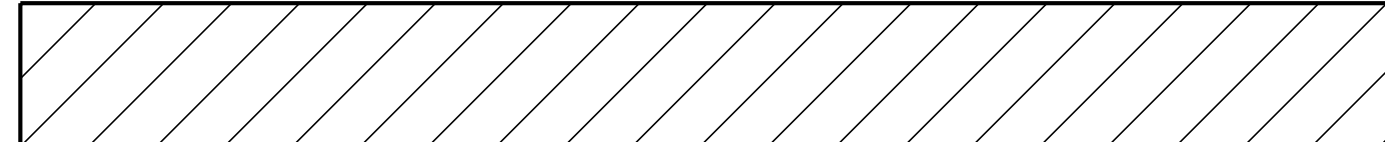

HARTLAND INTERCHANGE # 9
I-91

NOT TO SCALE

INTERCHANGE DETAIL SHEET # 6	PROJECT NAME: STATEWIDE	PLOT DATE: 28-FEB-2014 16:17
	PROJECT NUMBER: STP CRAK(3I)	DRAWN BY: LOCKE
	FILE NAME: p12k558.dgn	CHECKED BY: HARRINGTON
	DESIGNED BY: LOCKE	SHEET 12 OF 14
	p12k558in+6.i	