



STATE OF VERMONT  
AGENCY OF TRANSPORTATION

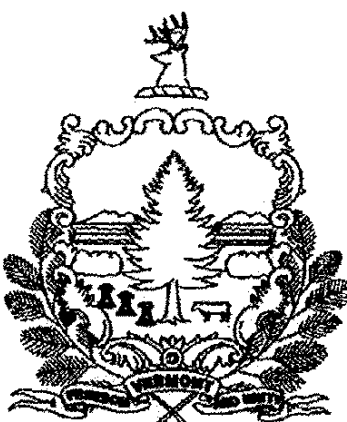

PROPOSED IMPROVEMENT  
TOWNS OF HARTFORD, SHARON, ROYALTON, RANDOLPH  
COUNTIES OF WINDSOR AND ORANGE  
MAJOR COLLECTOR VT ROUTE 14

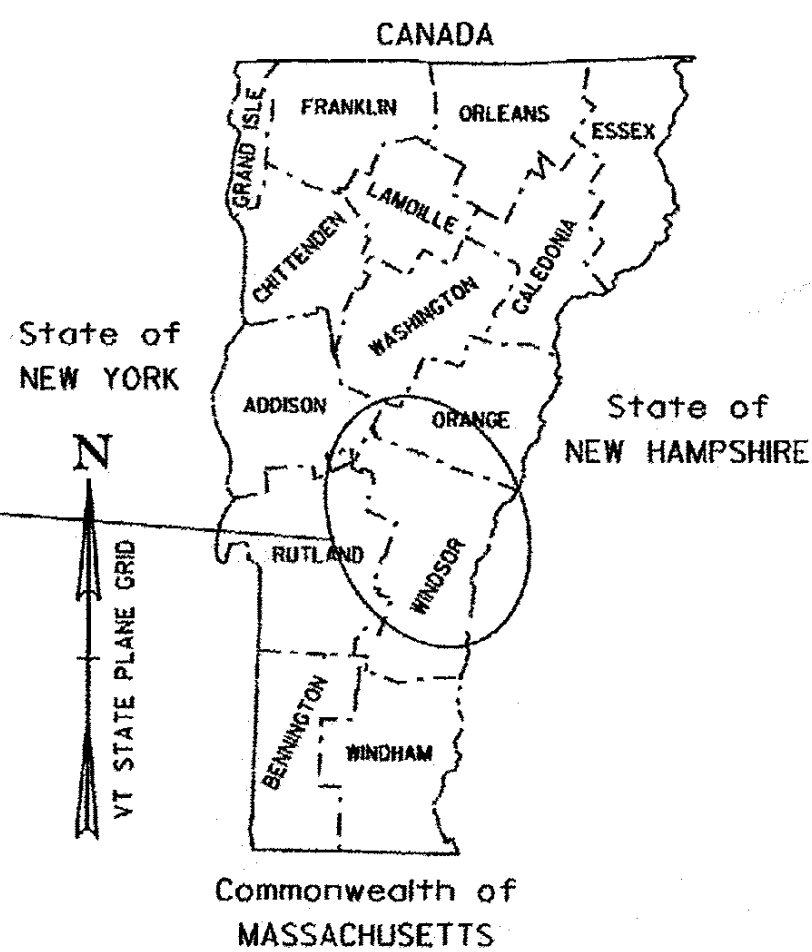

PROJECT LOCATION  
HARTFORD-RANDOLPH  
ER-0147(21)

RECORD PLANS

CONTRACTOR: WILLEY EARTHMOVING CORP. - WINDSOR, VT

RESIDENT ENGINEER: AL JONES

CONSTRUCTION BEGAN: OCTOBER 1<sup>ST</sup>, 2013


CONSTRUCTION COMPLETE: MAY 22<sup>ND</sup>, 2014

RECORD PLANS BY: AL JONES & PERCY BANNERMAN

I HEREBY CERTIFY THAT ALL THE CONSTRUCTION REQUIRED BY THIS SET OF DRAWINGS HAS BEEN ACCOMPLISHED AS INDICATED HEREIN.

BY AL JONES RESIDENT ENGINEER  
DATE 6/22/15

NOTE: Any further information concerning final quantities, amounts or other details relative to this project may be found at Central Files in the electronic archives.

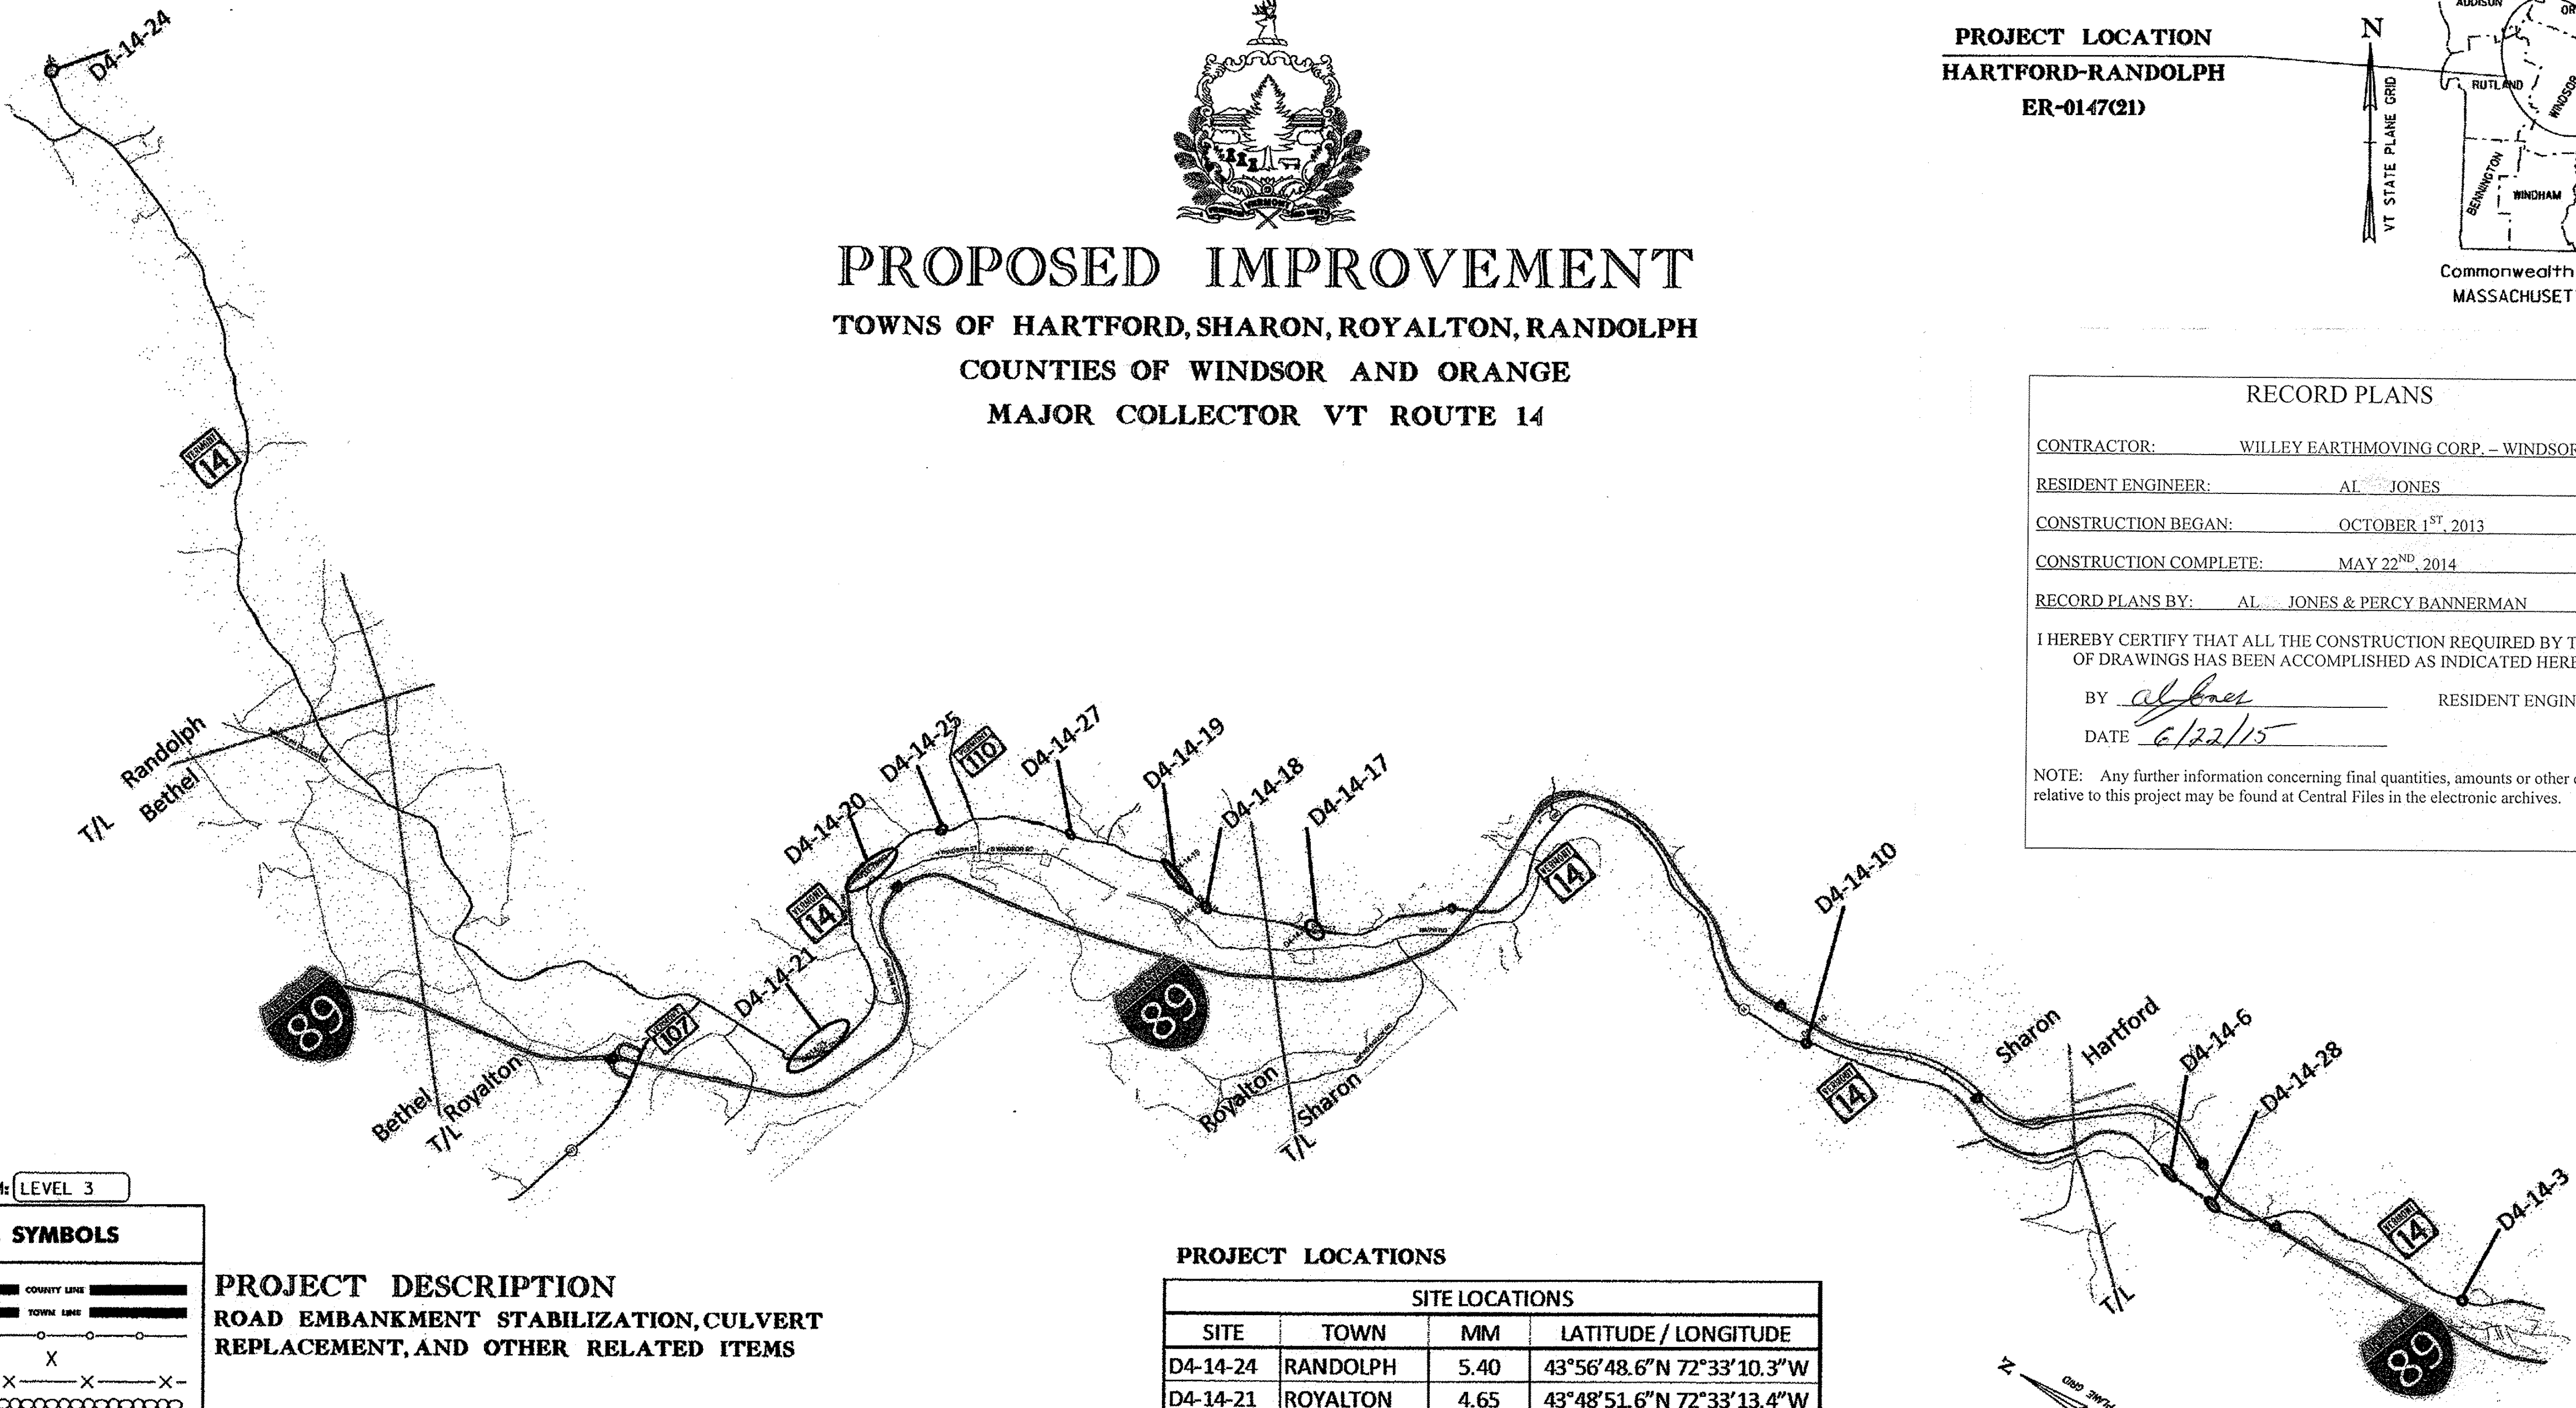

QUALITY ASSURANCE PROGRAM: LEVEL 3

CONVENTIONAL SYMBOLS

|                    |  |
|--------------------|--|
| COUNTY LINE        |  |
| TOWN LINE          |  |
| LIMITS OF ACCESS   |  |
| POINT OF ACCESS    |  |
| FENCE LINE         |  |
| STONE WALL         |  |
| TRAVELED WAY       |  |
| GUARD RAIL         |  |
| RAILROAD           |  |
| SURVEY LINE        |  |
| CULVERT            |  |
| POWER POLE         |  |
| TELEPHONE POLE     |  |
| TREES              |  |
| CONTROL OF ACCESS  |  |
| PROPERTY LINE      |  |
| R.O.W. TAKING LINE |  |
| SLOPE RIGHTS       |  |
| TOP OF CUT         |  |
| TOE OF SLOPE       |  |

PROJECT DESCRIPTION  
ROAD EMBANKMENT STABILIZATION, CULVERT  
REPLACEMENT, AND OTHER RELATED ITEMS

PROJECT LOCATIONS

| SITE LOCATIONS |          |         |                           |
|----------------|----------|---------|---------------------------|
| SITE           | TOWN     | MM      | LATITUDE / LONGITUDE      |
| D4-14-24       | RANDOLPH | 5.40    | 43°56'48.6"N 72°33'10.3"W |
| D4-14-21       | ROYALTON | 4.65    | 43°48'51.6"N 72°33'13.4"W |
| D4-14-20       | ROYALTON | 3.30    | 43°49'36.3"N 72°32'12.8"W |
| D4-14-25       | ROYALTON | 2.57    | 43°49'29.3"N 72°31'23.7"W |
| D4-14-27       | ROYALTON | 1.68    | 43°49'0.4"N 72°30'36.7"W  |
| D4-14-19       | ROYALTON | 0.6-0.9 | 43°48'19"N 72°30'4.9"W    |
| D4-14-18       | ROYALTON | 0.42    | 43°48'1.9"N 72°30'3.3"W   |
| D4-14-17       | SHARON   | 7.16    | 43°47'26.4"N 72°29'22.9"W |
| D4-14-10       | SHARON   | 2.24    | 43°44'57.8"N 72°26'48.1"W |
| D4-14-6        | HARTFORD | 7.06    | 43°42'52.4"N 72°25'5.1"W  |
| D4-14-28       | HARTFORD | 6.74    | 43°42'36.4"N 72°24'59.1"W |
| D4-14-3        | HARTFORD | 4.62    | 43°41'3.2"N 72°23'50.3"W  |

THESE PLANS ARE SUBJECT TO SUCH ENGINEERING CHANGES AS MAY BE REQUIRED BY THE FEDERAL HIGHWAY ADMINISTRATION OR THE DIRECTOR OF PROGRAM DEVELOPMENT.

CONSTRUCTION IS TO BE CARRIED ON IN ACCORDANCE WITH THESE PLANS AND THE STANDARD SPECIFICATIONS FOR CONSTRUCTION DATED 2011, AS APPROVED BY THE FEDERAL HIGHWAY ADMINISTRATION ON JULY 20, 2011 FOR USE ON THIS PROJECT, INCLUDING ALL SUBSEQUENT REVISIONS AND SUCH REVISED SPECIFICATIONS AND SPECIAL PROVISIONS AS ARE INCORPORATED IN THESE PLANS.

|                                                 |
|-------------------------------------------------|
| DIRECTOR OF OPERATIONS                          |
| APPROVED <u>[Signature]</u> DATE <u>6/25/15</u> |
| PROJECT MANAGER : CHRIS BUMP                    |
| PROJECT NAME : HARTFORD-RANDOLPH                |
| PROJECT NUMBER : ER 0147 (21)                   |
| SHEET 1 OF 20 SHEETS                            |