


D4-14-19
ROYALTON

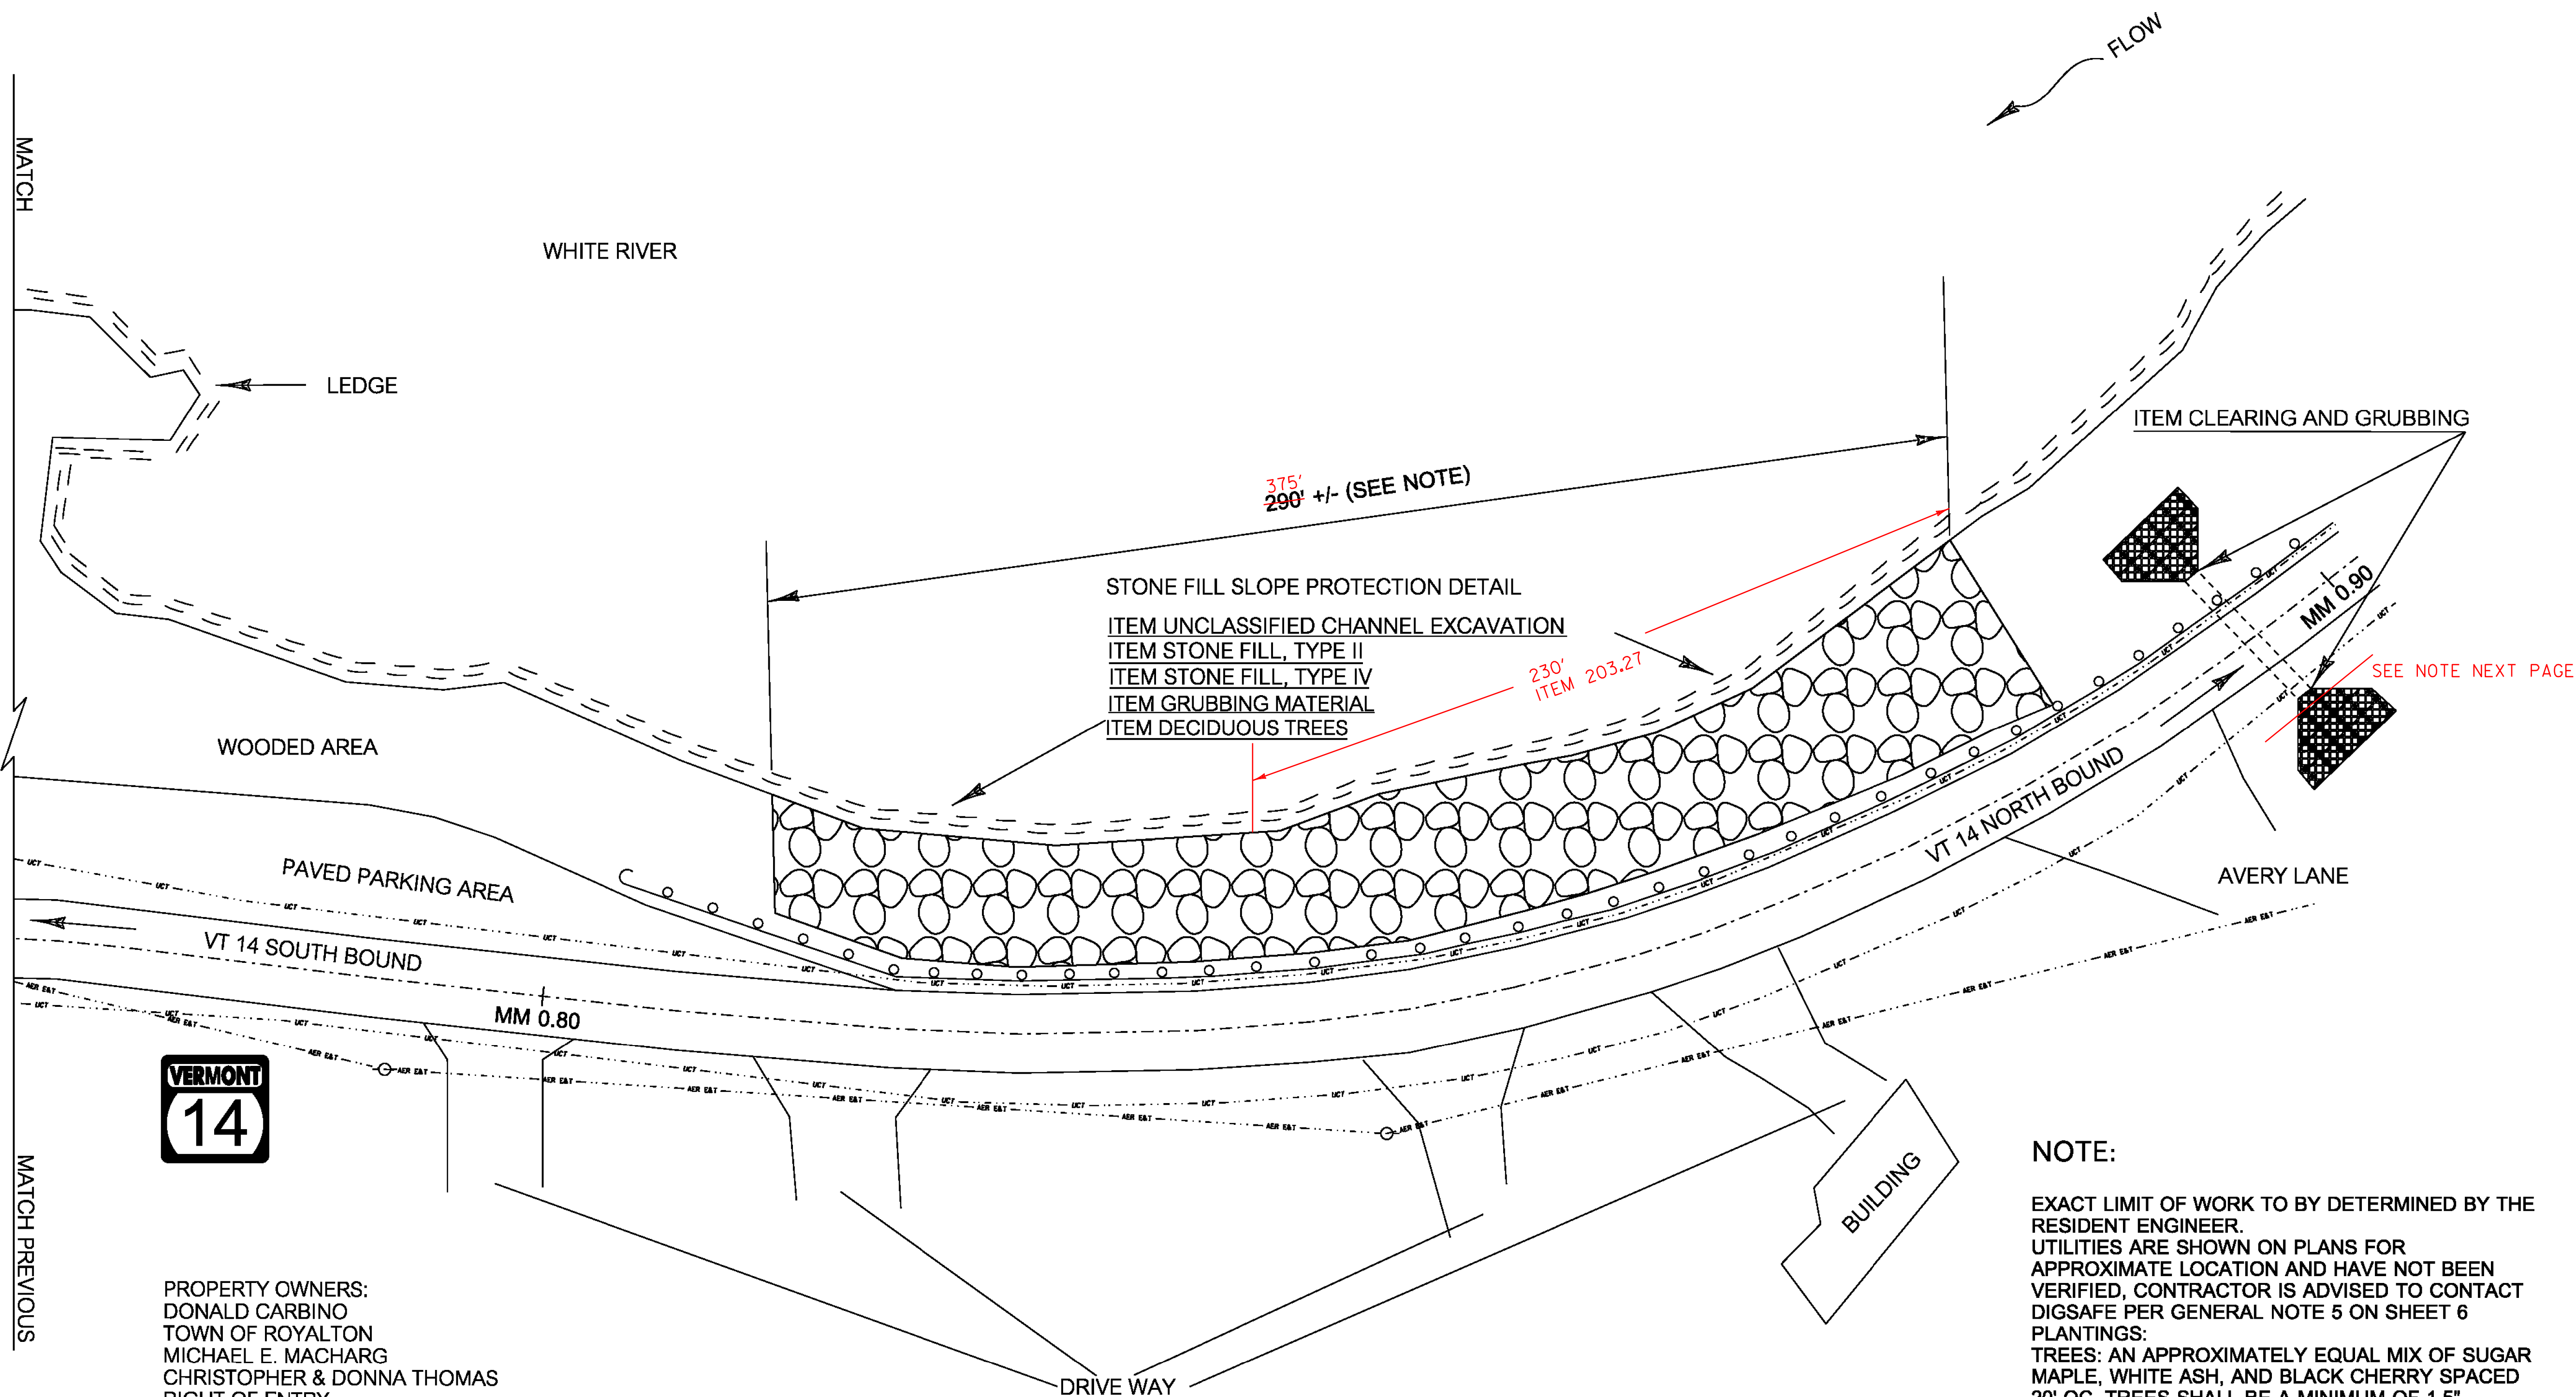

PROPERTY OWNERS:
DONALD CARBINO
TOWN OF ROYALTON
MICHAEL E. MACHARG
CHRISTOPHER & DONNA THOMAS
RIGHT OF ENTRY

NOTE:

EXACT LIMIT OF WORK TO BY DETERMINED BY THE RESIDENT ENGINEER.
UTILITIES ARE SHOWN ON PLANS FOR APPROXIMATE LOCATION AND HAVE NOT BEEN VERIFIED, CONTRACTOR IS ADVISED TO CONTACT DIGSAFE PER GENERAL NOTE 5 ON SHEET 6
PLANTINGS:
TREES: AN APPROXIMATELY EQUAL MIX OF SUGAR MAPLE, WHITE ASH, AND BLACK CHERRY SPACED 20' OC. TREES SHALL BE A MINIMUM OF 1.5" CALIPER, AND SHOULD BE PROVIDED WITH RODENT GUARDS.

*NTS

PROJECT NAME: HARTFORD-RANDOLPH	
PROJECT NUMBER: ER 014-7(21)	
FILE NAME:	PLOT DATE: 11-JUL-2013
PROJECT LEADER: CHRIS BUMP	DRAWN BY: ANDREW BERNIER
DESIGNED BY: ANDREW BERNIER	CHECKED BY: MICHELLE REDMOND
PLAN SHEETS	SHEET 13 OF 20