


D4-14-10 SHARON

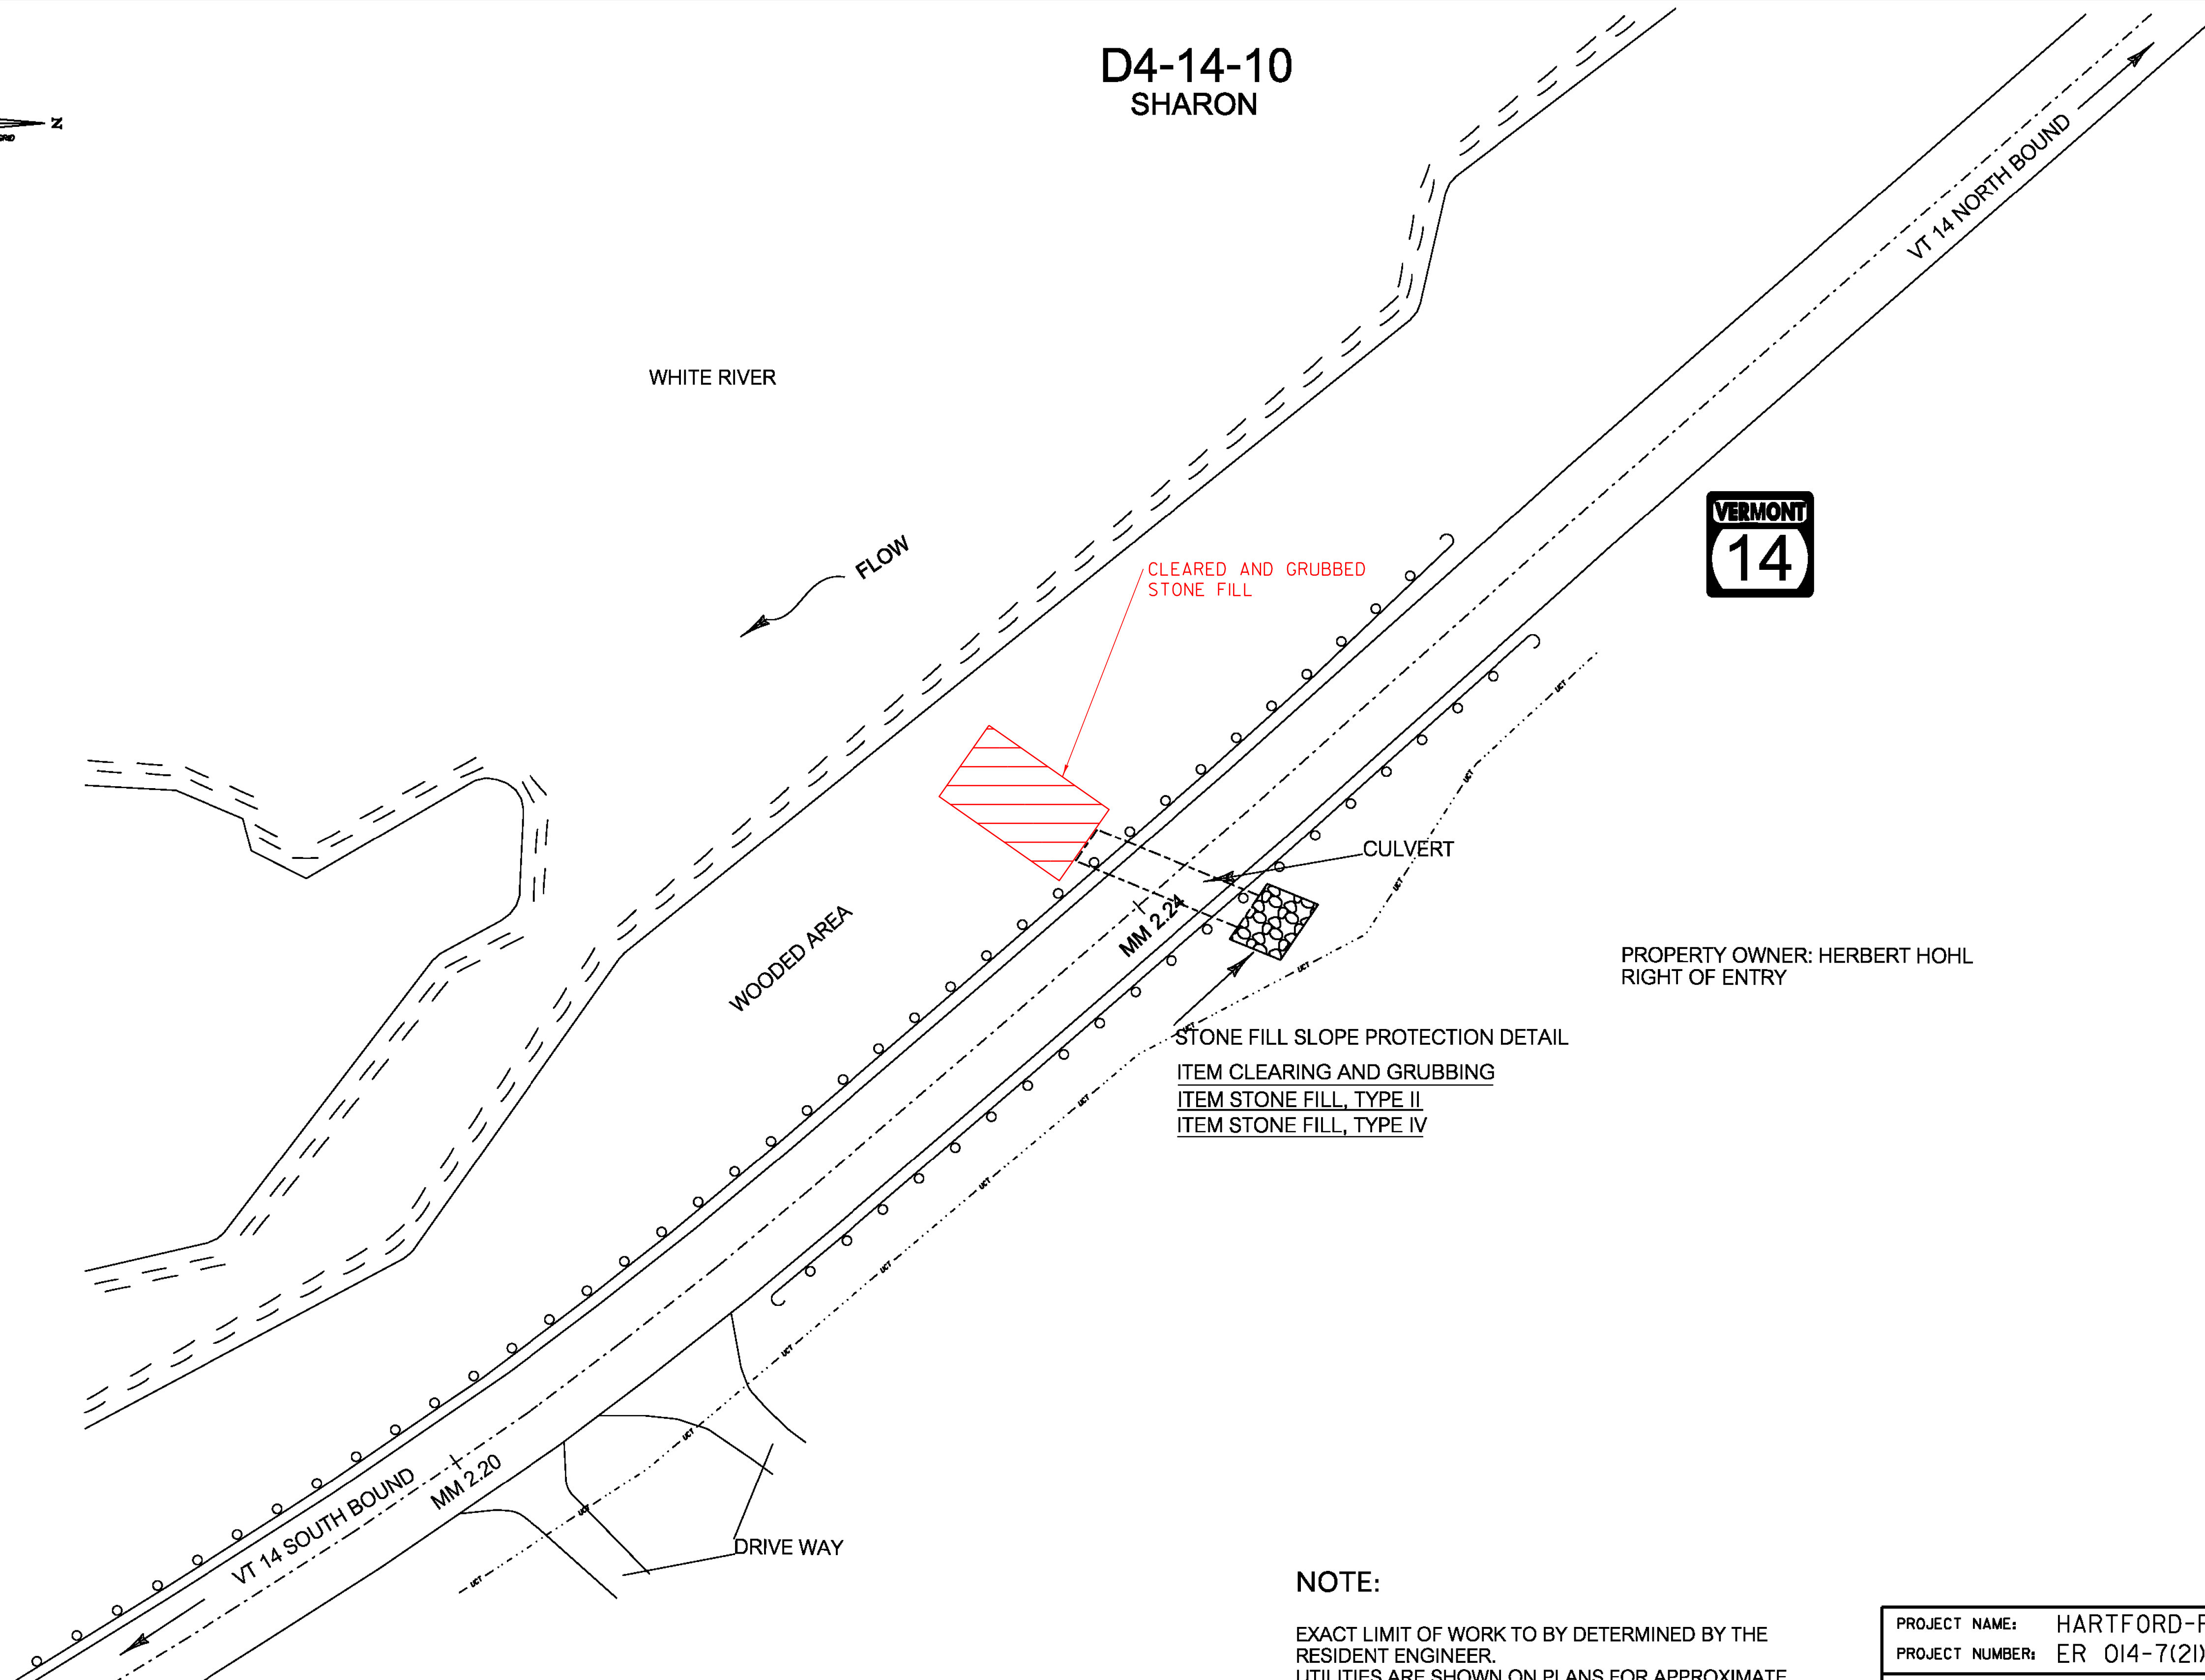

NOTE:

EXACT LIMIT OF WORK TO BY DETERMINED BY THE
RESIDENT ENGINEER.
UTILITIES ARE SHOWN ON PLANS FOR APPROXIMATE
LOCATION AND HAVE NOT BEEN VERIFIED,
CONTRACTOR IS ADVISED TO CONTACT DIGSAFE PER
GENERAL NOTE 5 ON SHEET 6

*NTS

PROJECT NAME: HARTFORD-RANDOLPH	
PROJECT NUMBER: ER 014-7(21)	
FILE NAME:	PLOT DATE: 11-JUL-2013
PROJECT LEADER: CHRIS BUMP	DRAWN BY: ANDREW BERNIER
DESIGNED BY: ANDREW BERNIER	CHECKED BY: MICHELLE REDMOND
PLAN SHEETS	SHEET 17 OF 20