


**D4-14-24  
RANDOLPH**

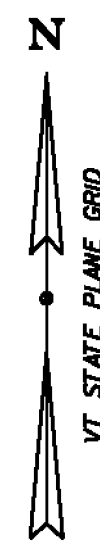

DRIVE WAY

SAND PIT

VT 14 NORTH BOUND

WOODED AREA

STONE FILL ADDED

BRIDGE 37

FLOW

FLOW

STONE FILL SLOPE PROTECTION DETAIL  
10'+/- WIDE BY 23'+/- LONG

- ITEM CLEARING AND GRUBBING INCLUDING INDIVIDUAL TREE AND STUMPS
- ITEM UNCLASSIFIED CHANNEL EXCAVATION
- ITEM STONE FILL, TYPE IV
- ITEM GEOTEXTILE UNDER STONE FILL
- ITEM GRUBBING MATERIAL

OUTLET PAD  
10'+/- WIDE BY 12'+/- LONG

- ITEM UNCLASSIFIED CHANNEL EXCAVATION
- ITEM STONE FILL, TYPE IV



VT 14 SOUTH BOUND

MM 5.40

**NOTE:**

EXACT LIMIT OF WORK TO BY DETERMINED BY THE RESIDENT ENGINEER.  
UTILITIES ARE SHOWN ON PLANS FOR APPROXIMATE LOCATION AND HAVE NOT BEEN VERIFIED,  
CONTRACTOR IS ADVISED TO CONTACT DIGSAFE PER GENERAL NOTE 5 ON SHEET 6 \*NTS

PROJECT NAME: HARTFORD-RANDOLPH	
PROJECT NUMBER: ER 014-7(21)	
FILE NAME:	PLOT DATE: 11-JUL-2013
PROJECT LEADER: CHRIS BUMP	DRAWN BY: ANDREW BERNIER
DESIGNED BY: ANDREW BERNIER	CHECKED BY: MICHELLE REDMOND
PLAN SHEETS	SHEET 8 OF 20