


D4-14-21  
ROYALTON

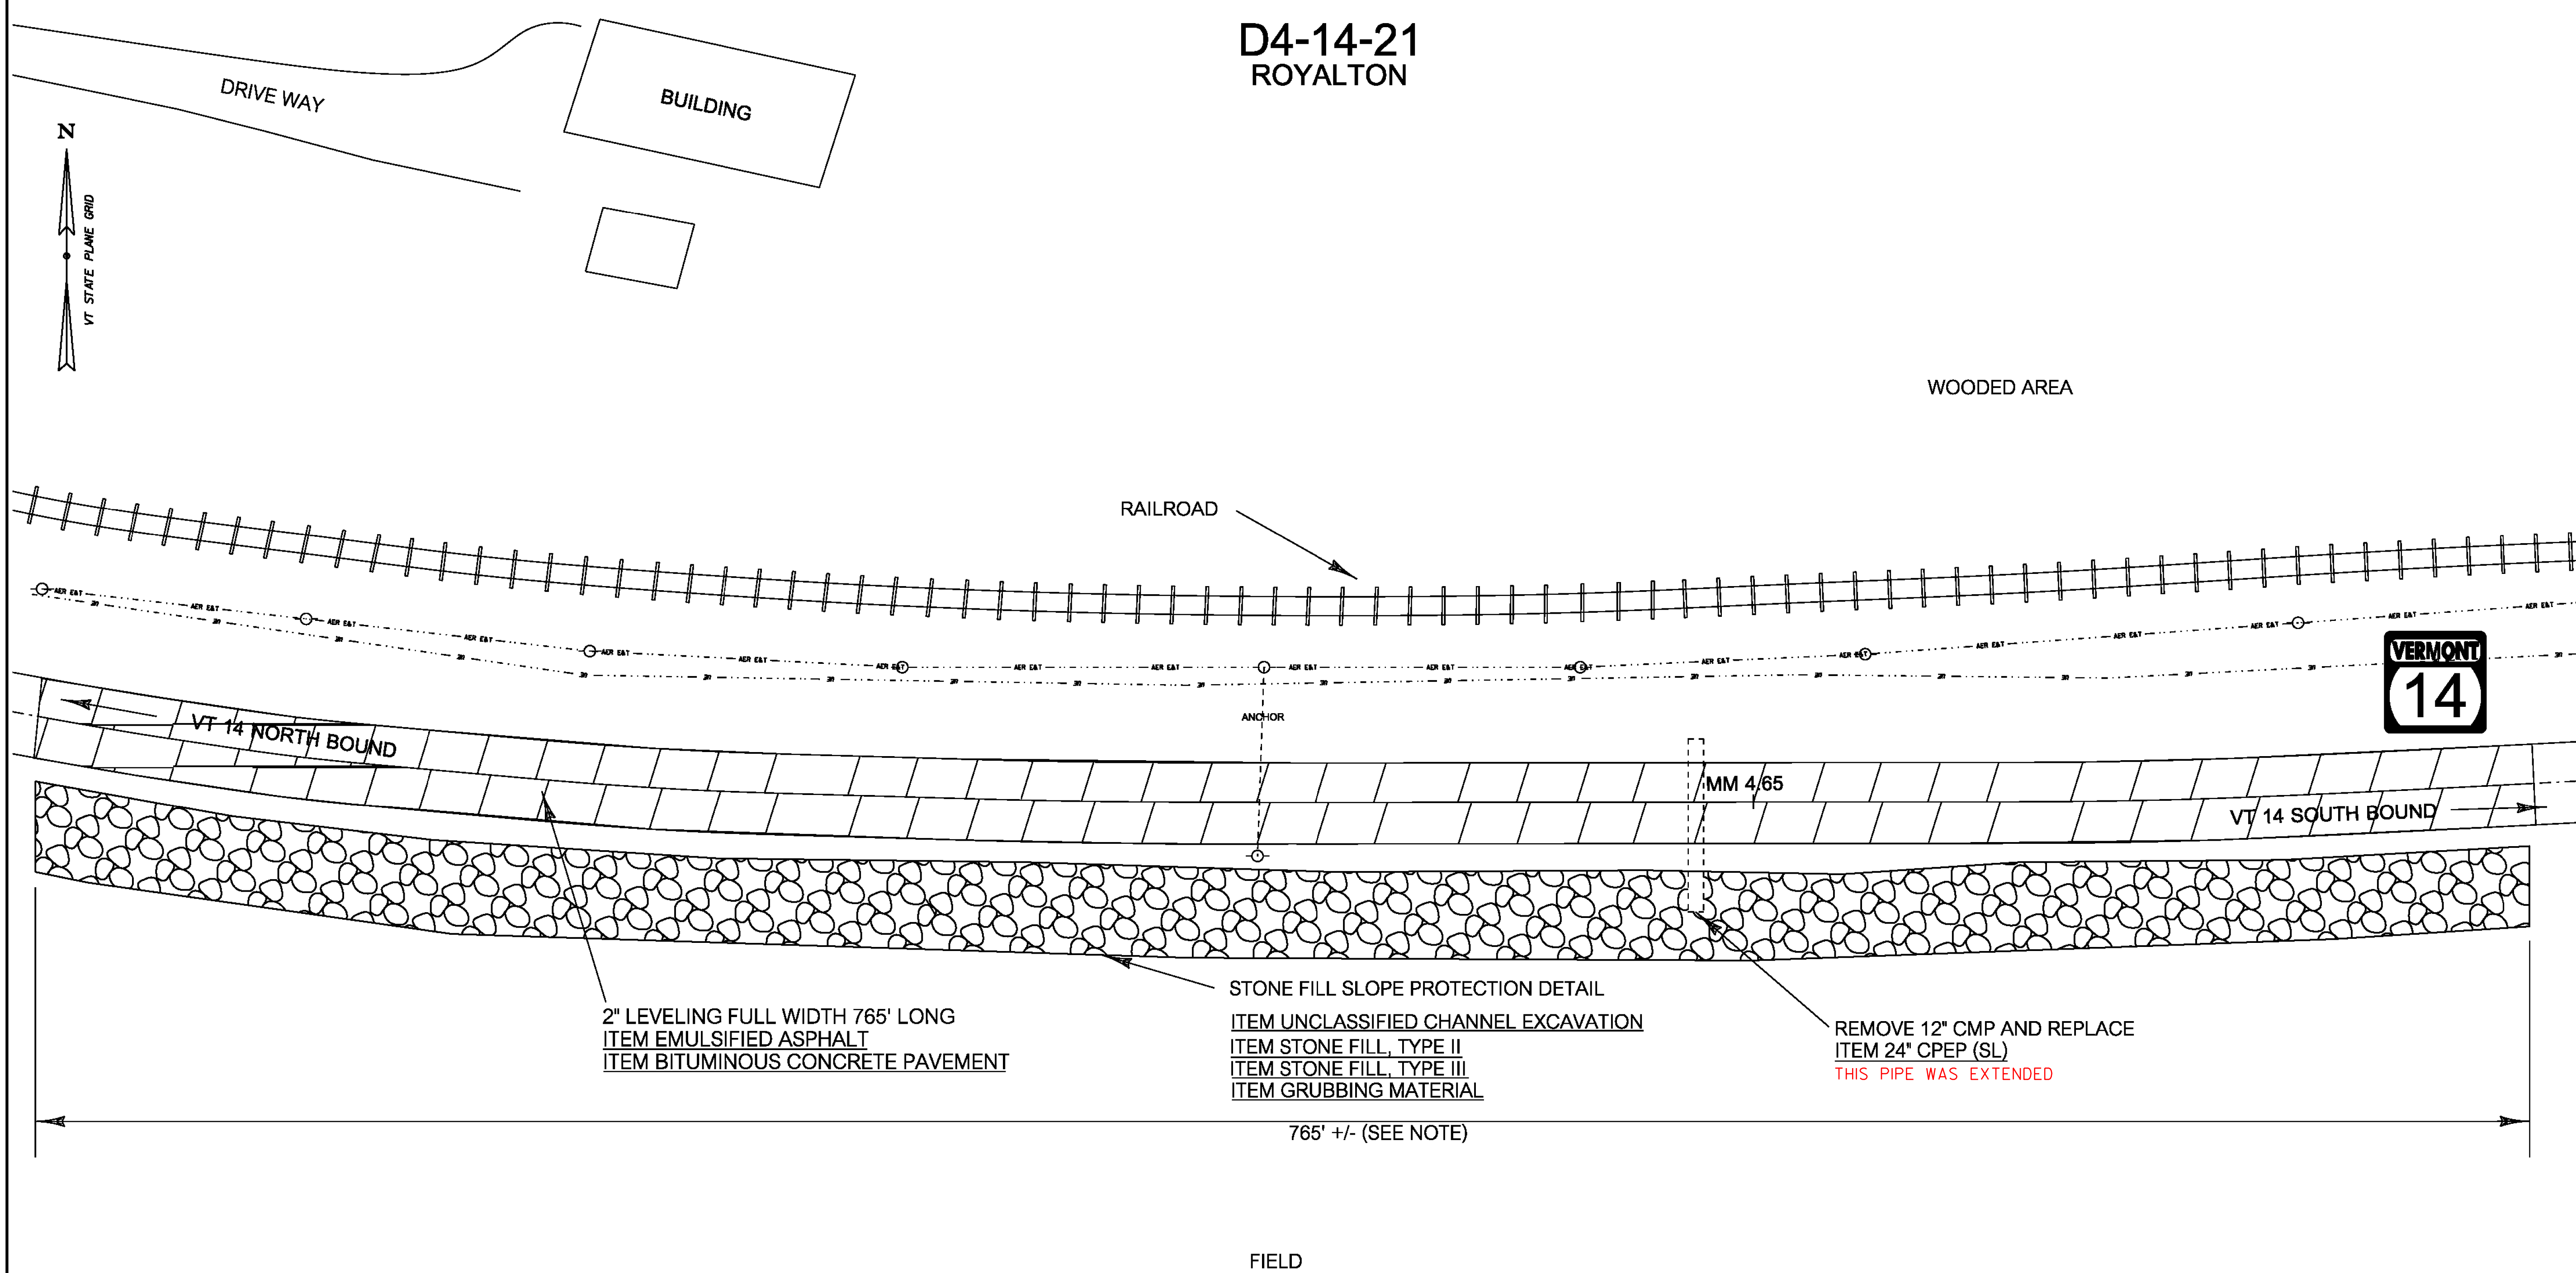

PROPERTY OWNERS:  
SUSAN L CAIN  
HARVEY & RUBY BALLOU  
RIGHT OF ENTRY

**NOTE:**

EXACT LIMIT OF WORK TO BY DETERMINED BY THE RESIDENT ENGINEER. UTILITIES ARE SHOWN ON PLANS FOR APPROXIMATE LOCATION AND HAVE NOT BEEN VERIFIED, CONTRACTOR IS ADVISED TO CONTACT DIGSAFE PER GENERAL NOTE 5 ON SHEET 6

**\*NTS**

PROJECT NAME: HARTFORD-RANDOLPH	
PROJECT NUMBER: ER 014-7(21)	
FILE NAME:	PLOT DATE: 11-JUL-2013
PROJECT LEADER: CHRIS BUMP	DRAWN BY: ANDREW BERNIER
DESIGNED BY: ANDREW BERNIER	CHECKED BY: MICHELLE REDMOND
PLAN SHEETS	SHEET 9 OF 20