


D4-14-20
ROYALTON

PROPERTY OWNERS:
MARGRET (PEG) ELMER
RIGHT OF ENTRY/ LIMITED RELEASE



THE EXISTING WALKING PATH SHALL BE RE-ESTABLISHED DURING THE PLACEMENT OF STONE FILL. THE STONE FILL SHALL BE CHINKED ELIMINATE VOIDS AND COVERED WITH A LAYER OF BANK RUN GRAVEL 6 FEET WIDE AND 1 FOOT DEEP. THIS WORK SHALL BE INCIDENTAL TO ITEM STONE FILL TYPE IV.

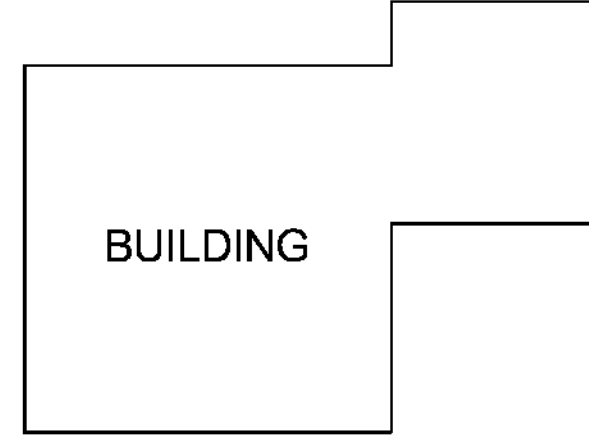

PROPERTY OWNERS:
CHARLES & KATHY WELCH
RIGHT OF ENTRY

WOODED AREA



MM 3.30

VT 14 SOUTH BOUND

VT 14 NORTH BOUND


STONE FILL SLOPE PROTECTION WITH STONE TOE WALL

- ITEM UNCLASSIFIED CHANNEL EXCAVATION
- ITEM STONE FILL, TYPE IV
- ITEM RIP RAP, HEAVY TYPE
- ITEM GRUBBING MATERIAL

LEDGE

560' +/- (SEE NOTE)

WHITE RIVER

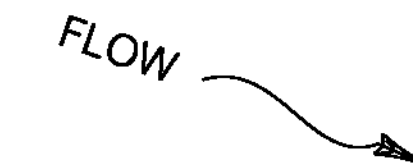

NOTE:

EXACT LIMIT OF WORK TO BY DETERMINED BY THE RESIDENT ENGINEER. UTILITIES ARE SHOWN ON PLANS FOR APPROXIMATE LOCATION AND HAVE NOT BEEN VERIFIED, CONTRACTOR IS ADVISED TO CONTACT DIGSAFE PER GENERAL NOTE 5 ON SHEET 6

*NTS

PROJECT NAME: HARTFORD-RANDOLPH	
PROJECT NUMBER: ER 014-7(21)	
FILE NAME:	PLOT DATE: 11-JUL-2013
PROJECT LEADER: CHRIS BUMP	DRAWN BY: ANDREW BERNIER
DESIGNED BY: ANDREW BERNIER	CHECKED BY: MICHELLE REDMOND
PLAN SHEETS	SHEET 10 OF 20