


D4-14-25
ROYALTON

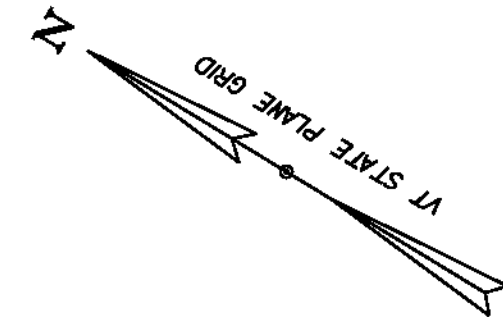


ITEM REMOVAL AND DISPOSAL OF GUARDRAIL
(END SECTION)
ATTACH TO EXISTING GUARDRAIL
ITEM STEEL BEAM GUARDRAIL, GALVANIZED

2" LEVELING SOUTHBOUND LANE
ITEM EMULSIFIED ASPHALT
ITEM BITUMINOUS CONCRETE PAVEMENT

STONE FILL SLOPE PROTECTION DETAIL
ITEM CLEARING AND GRUBBING
ITEM UNCLASSIFIED EXCAVATION
ITEM STONE FILL, TYPE II
ITEM STONE FILL, TYPE III
ITEM GRUBBING MATERIAL

PROPERTY OWNERS:
WARREN E. WILLIAMS
RIGHT OF ENTRY

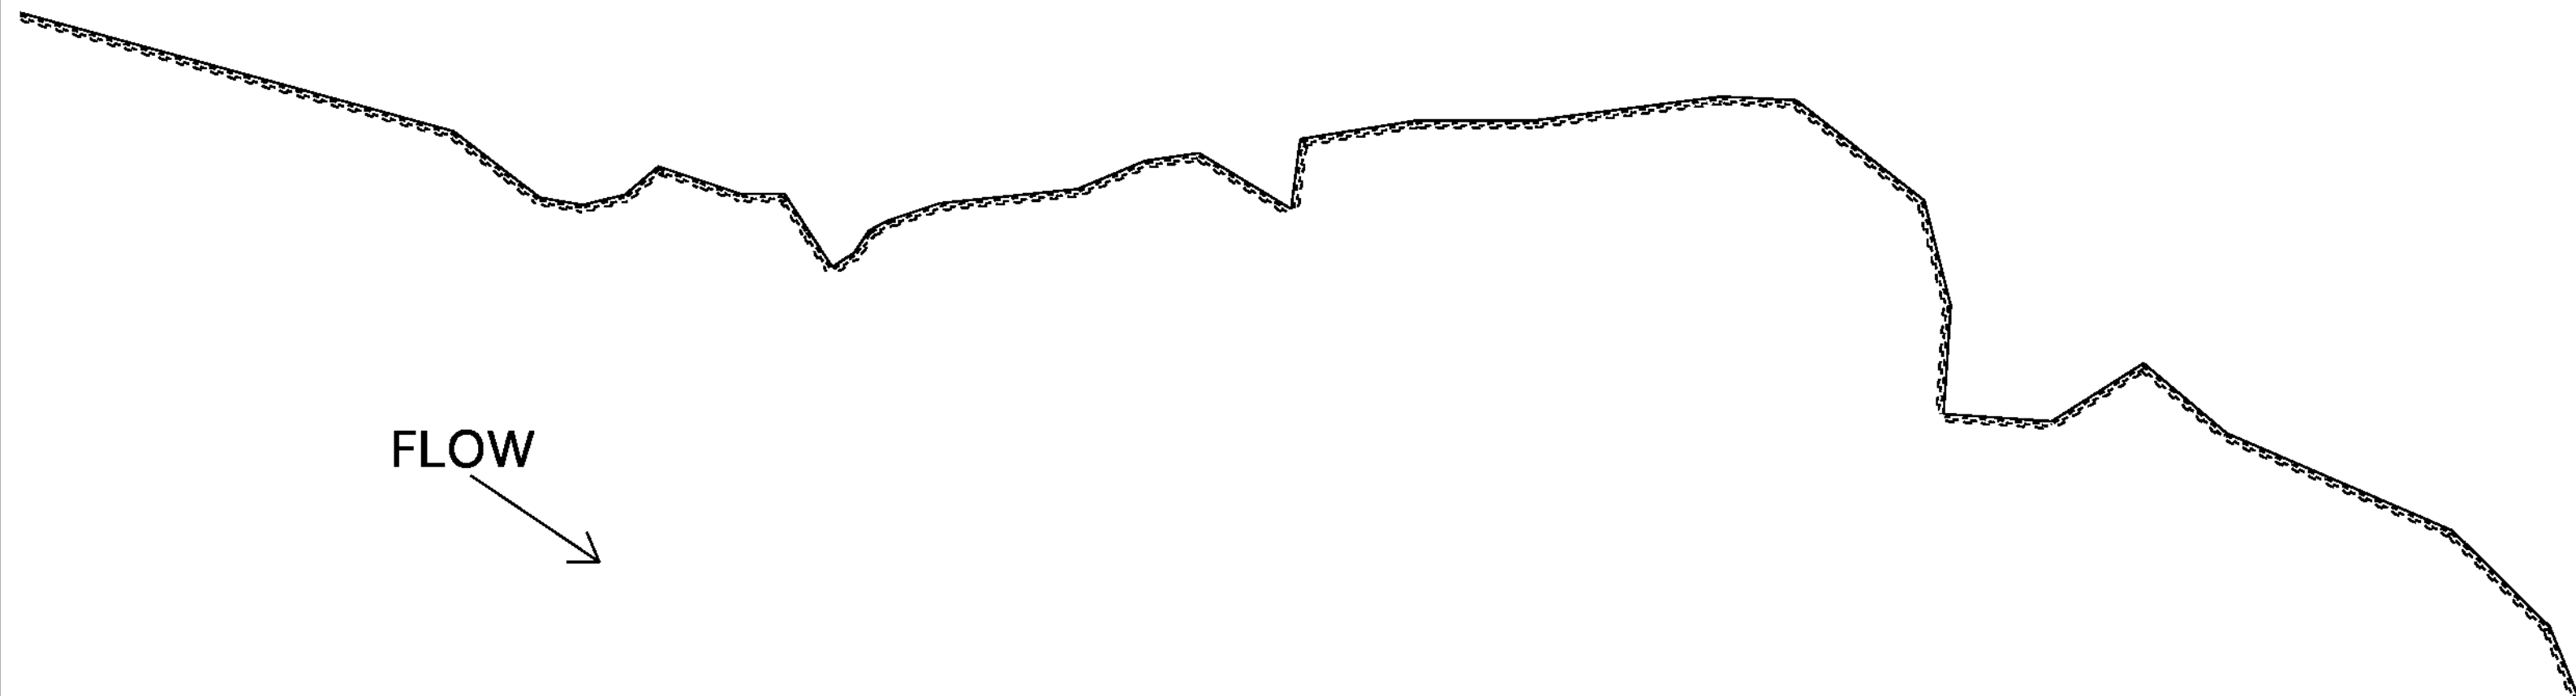

NOTE:

EXACT LIMIT OF WORK TO BY DETERMINED BY THE
RESIDENT ENGINEER.
UTILITIES ARE SHOWN ON PLANS FOR
APPROXIMATE LOCATION AND HAVE NOT BEEN
VERIFIED, CONTRACTOR IS ADVISED TO CONTACT
DIGSAFE PER GENERAL NOTE 5

***NTS**

PROJECT NAME:	HARTFORD-RANDOLPH	
PROJECT NUMBER:	ER 014-7(21)	
FILE NAME:	PROJECT LEADER: CHRIS BUMP	PLOT DATE: 11-JUL-2013
DESIGNED BY: ANDREW BERNIER	CHECKED BY: MICHELLE REDMOND	DRAWN BY: ANDREW BERNIER
PLAN SHEETS	SHEET 11	OF 20