


D4-14-27
ROYALTON

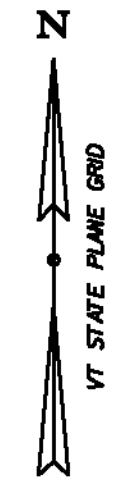

WHITE RIVER

350' +/- (SEE NOTE)
FLOW

MM 1.75

VT 14 NORTH BOUND

STONE FILL SLOPE PROTECTION DETAIL
ITEM UNCLASSIFIED CHANNEL EXCAVATION
ITEM STONE FILL, TYPE II
ITEM STONE FILL, TYPE IV
ITEM GRUBBING MATERIAL

WOODED AREA

REPLACE PAVEMENT ON SHOULDER
50' +/- BY 5' WIDE
ITEM BITUMINOUS CONCRETE PAVEMENT

MM 1.68

VT 14 SOUTH BOUND

NOTE:

EXACT LIMIT OF WORK TO BE DETERMINED BY THE RESIDENT ENGINEER.
UTILITIES ARE SHOWN ON PLANS FOR APPROXIMATE LOCATION AND HAVE NOT BEEN VERIFIED, CONTRACTOR IS ADVISED TO CONTACT DIGSAFE PER GENERAL NOTE 5 ON SHEET 6

***NTS**

PROJECT NAME:	HARTFORD-RANDOLPH
PROJECT NUMBER:	ER 014-7(21)
FILE NAME:	PLOT DATE: 11-JUL-2013
PROJECT LEADER: CHRIS BUMP	DRAWN BY: ANDREW BERNIER
DESIGNED BY: ANDREW BERNIER	CHECKED BY: MICHELLE REDMOND
PLAN SHEETS	SHEET 12 OF 20