
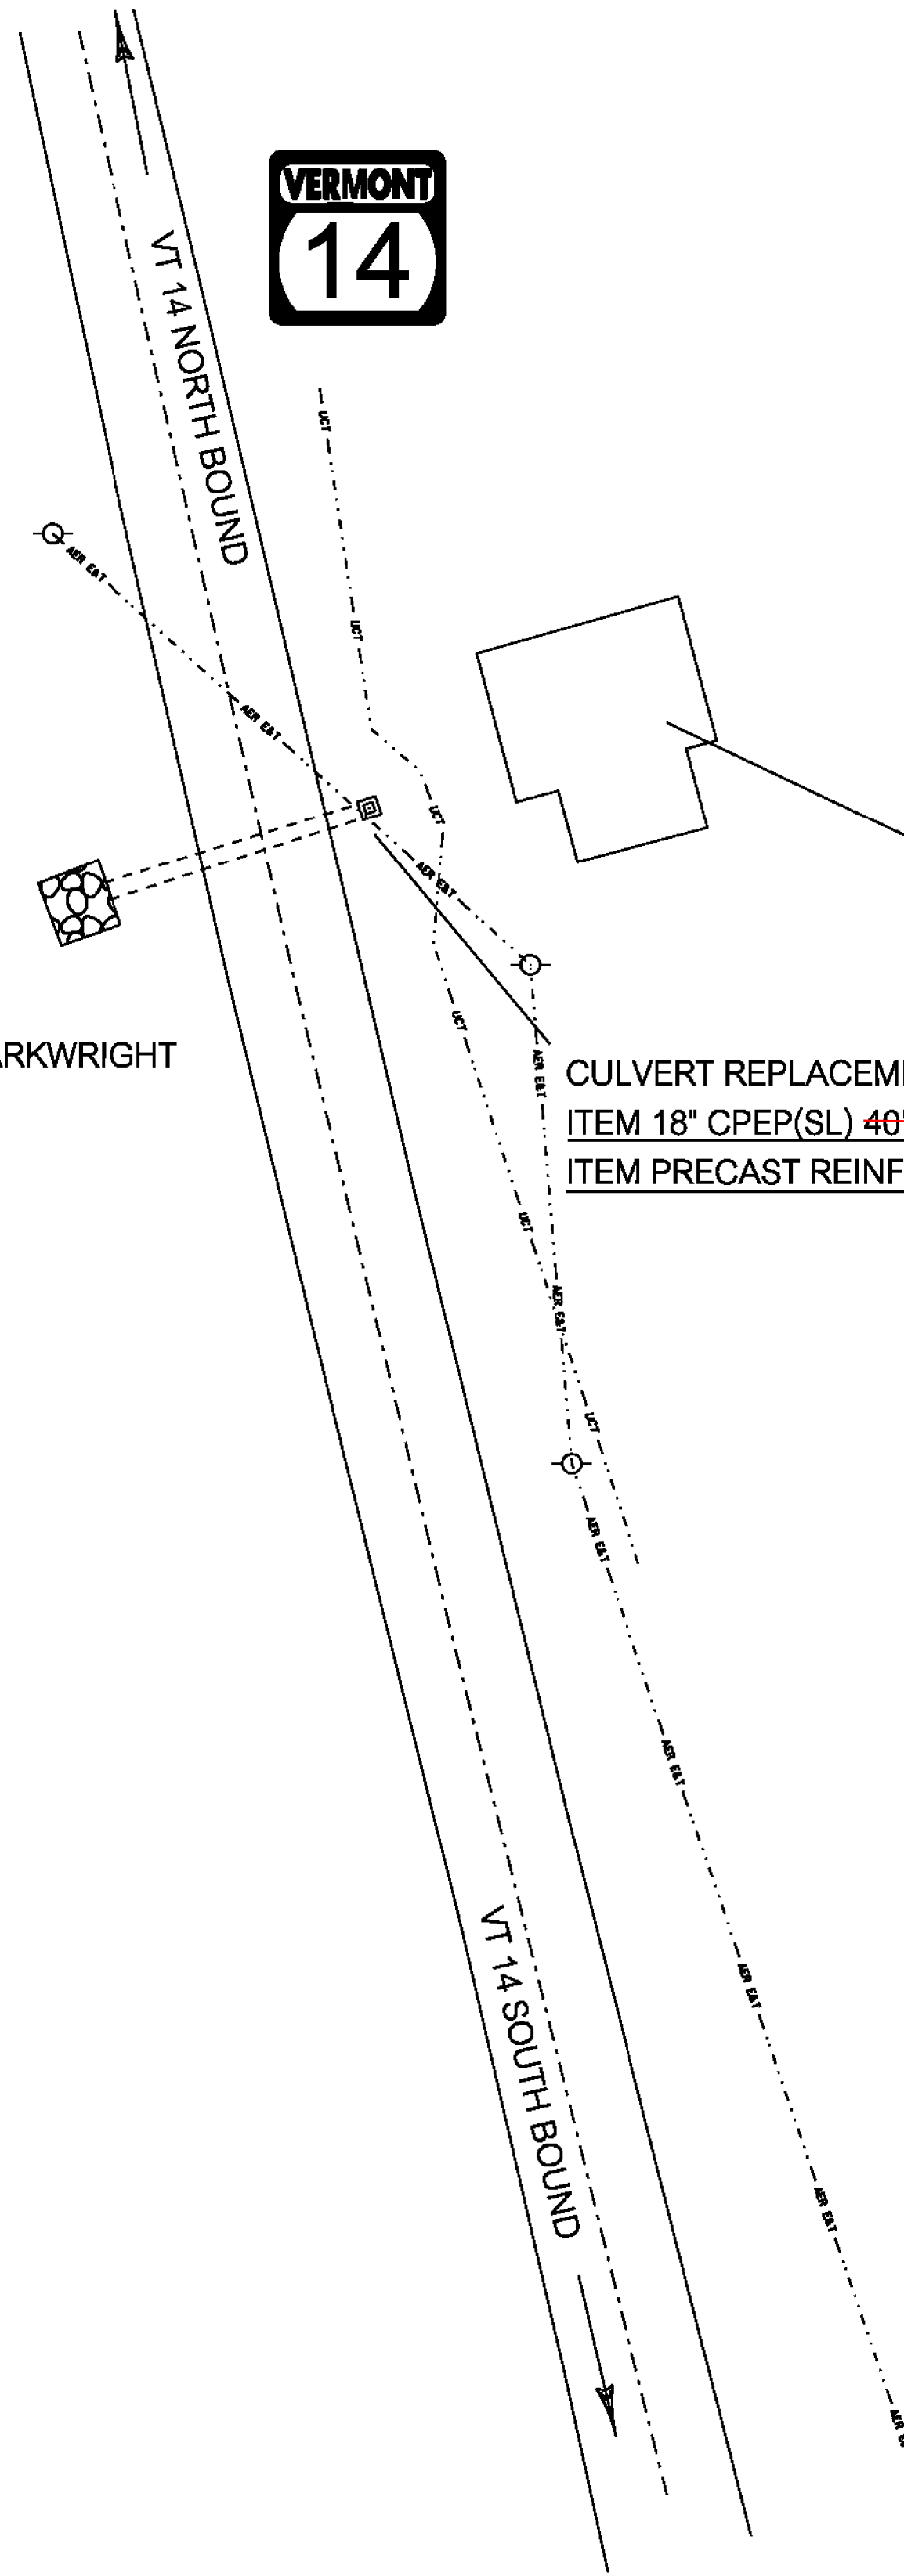


# D4-14-6 HARTFORD

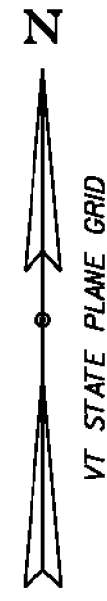

PROPERTY OWNER: CHERYL GILBERT (CHURCH)  
RIGHT OF ENTRY  
WEST HARTFORD CHURCH

PROPERTY OWNER: STEPHEN ARKWRIGHT  
RIGHT OF ENTRY

CULVERT REPLACEMENT @ MM 7.06 EXIST 18" REPLACE WITH  
ITEM 18" CPEP(SL) ~~40' LONG~~ 64' LONG DAYLIGHTED TO EDGE OF SLOPE  
ITEM PRECAST REINFORCED CONCRETE CATCH BASIN WITH CAST IRON GRATE

## NOTE:

EXACT LIMIT OF WORK TO BY DETERMINED BY THE  
RESIDENT ENGINEER.  
UTILITIES ARE SHOWN ON PLANS FOR APPROXIMATE  
LOCATION AND HAVE NOT BEEN VERIFIED.  
CONTRACTOR IS ADVISED TO CONTACT DIGSAFE PER  
GENERAL NOTE 5 ON SHEET 6 \*NTS

PROJECT NAME: HARTFORD-RANDOLPH	
PROJECT NUMBER: ER 014-7(21)	
FILE NAME:	PLOT DATE: 11-JUL-2013
PROJECT LEADER: CHRIS BUMP	DRAWN BY: ANDREW BERNIER
DESIGNED BY: ANDREW BERNIER	CHECKED BY: MICHELLE REDMOND
PLAN SHEETS	SHEET 18 OF 20