

DURABLE 4 INCH WHITE LINE, POLYUREA
 TEMPORARY 4 INCH WHITE LINE, PAINT
 MM 0.962 - MM 5.000 LT & RT (EDGE LINES)
 (WITH BREAKS OR RADII AT TOWN HIGHWAYS)
 MM 2.163 LT (TH II) SOLID LT & RT
 MM 2.790 LT (TH I2) SOLID LT & RT
 MM 2.806 LT (TH I2) SOLID LT & RT
 MM 2.806 RT (TH 3) SOLID LT & RT


DURABLE 4 INCH YELLOW LINE, POLYUREA
 TEMPORARY 4 INCH YELLOW LINE, PAINT
 MM 0.962 - MM 3.490 SOLID LT & RT
 MM 3.490 - MM 3.630 SOLID LT & DASHED RT
 MM 3.630 - MM 3.770 DASHED LT & SOLID RT
 MM 3.770 - MM 5.000 SOLID LT & RT
 (WITH CENTERLINE BREAKS AT TOWN HIGHWAYS)
 MM 2.163 LT (TH II) SOLID LT & RT
 MM 2.790 LT (TH I2) SOLID LT & RT
 MM 2.806 LT (TH I2) SOLID LT & RT
 MM 2.806 RT (TH 3) SOLID LT & RT

TEMPORARY 24" STOP BAR, PAINT
 MM 2.163 LT (TH II)
 MM 2.790 LT (TH I2)
 MM 2.806 LT (TH I2)
 MM 2.806 RT (TH 3)


DURABLE 24" STOP BAR (SEE OPTION ITEMS)
 MM 2.163 LT (TH II)
 MM 2.790 LT (TH I2)
 MM 2.806 LT (TH I2)
 MM 2.806 RT (TH 3)

TEMPORARY LETTER OR SYMBOL, PAINT
 MM 2.163 LT (TH II) STOP
 MM 2.790 LT (TH I2) STOP
 MM 2.806 LT (TH I2) STOP
 MM 2.806 RT (TH 3) STOP

DURABLE LETTER OR SYMBOL (SEE OPTION ITEMS)
 MM 2.163 LT (TH II) STOP
 MM 2.790 LT (TH I2) STOP
 MM 2.806 LT (TH I2) STOP
 MM 2.806 RT (TH 3) STOP

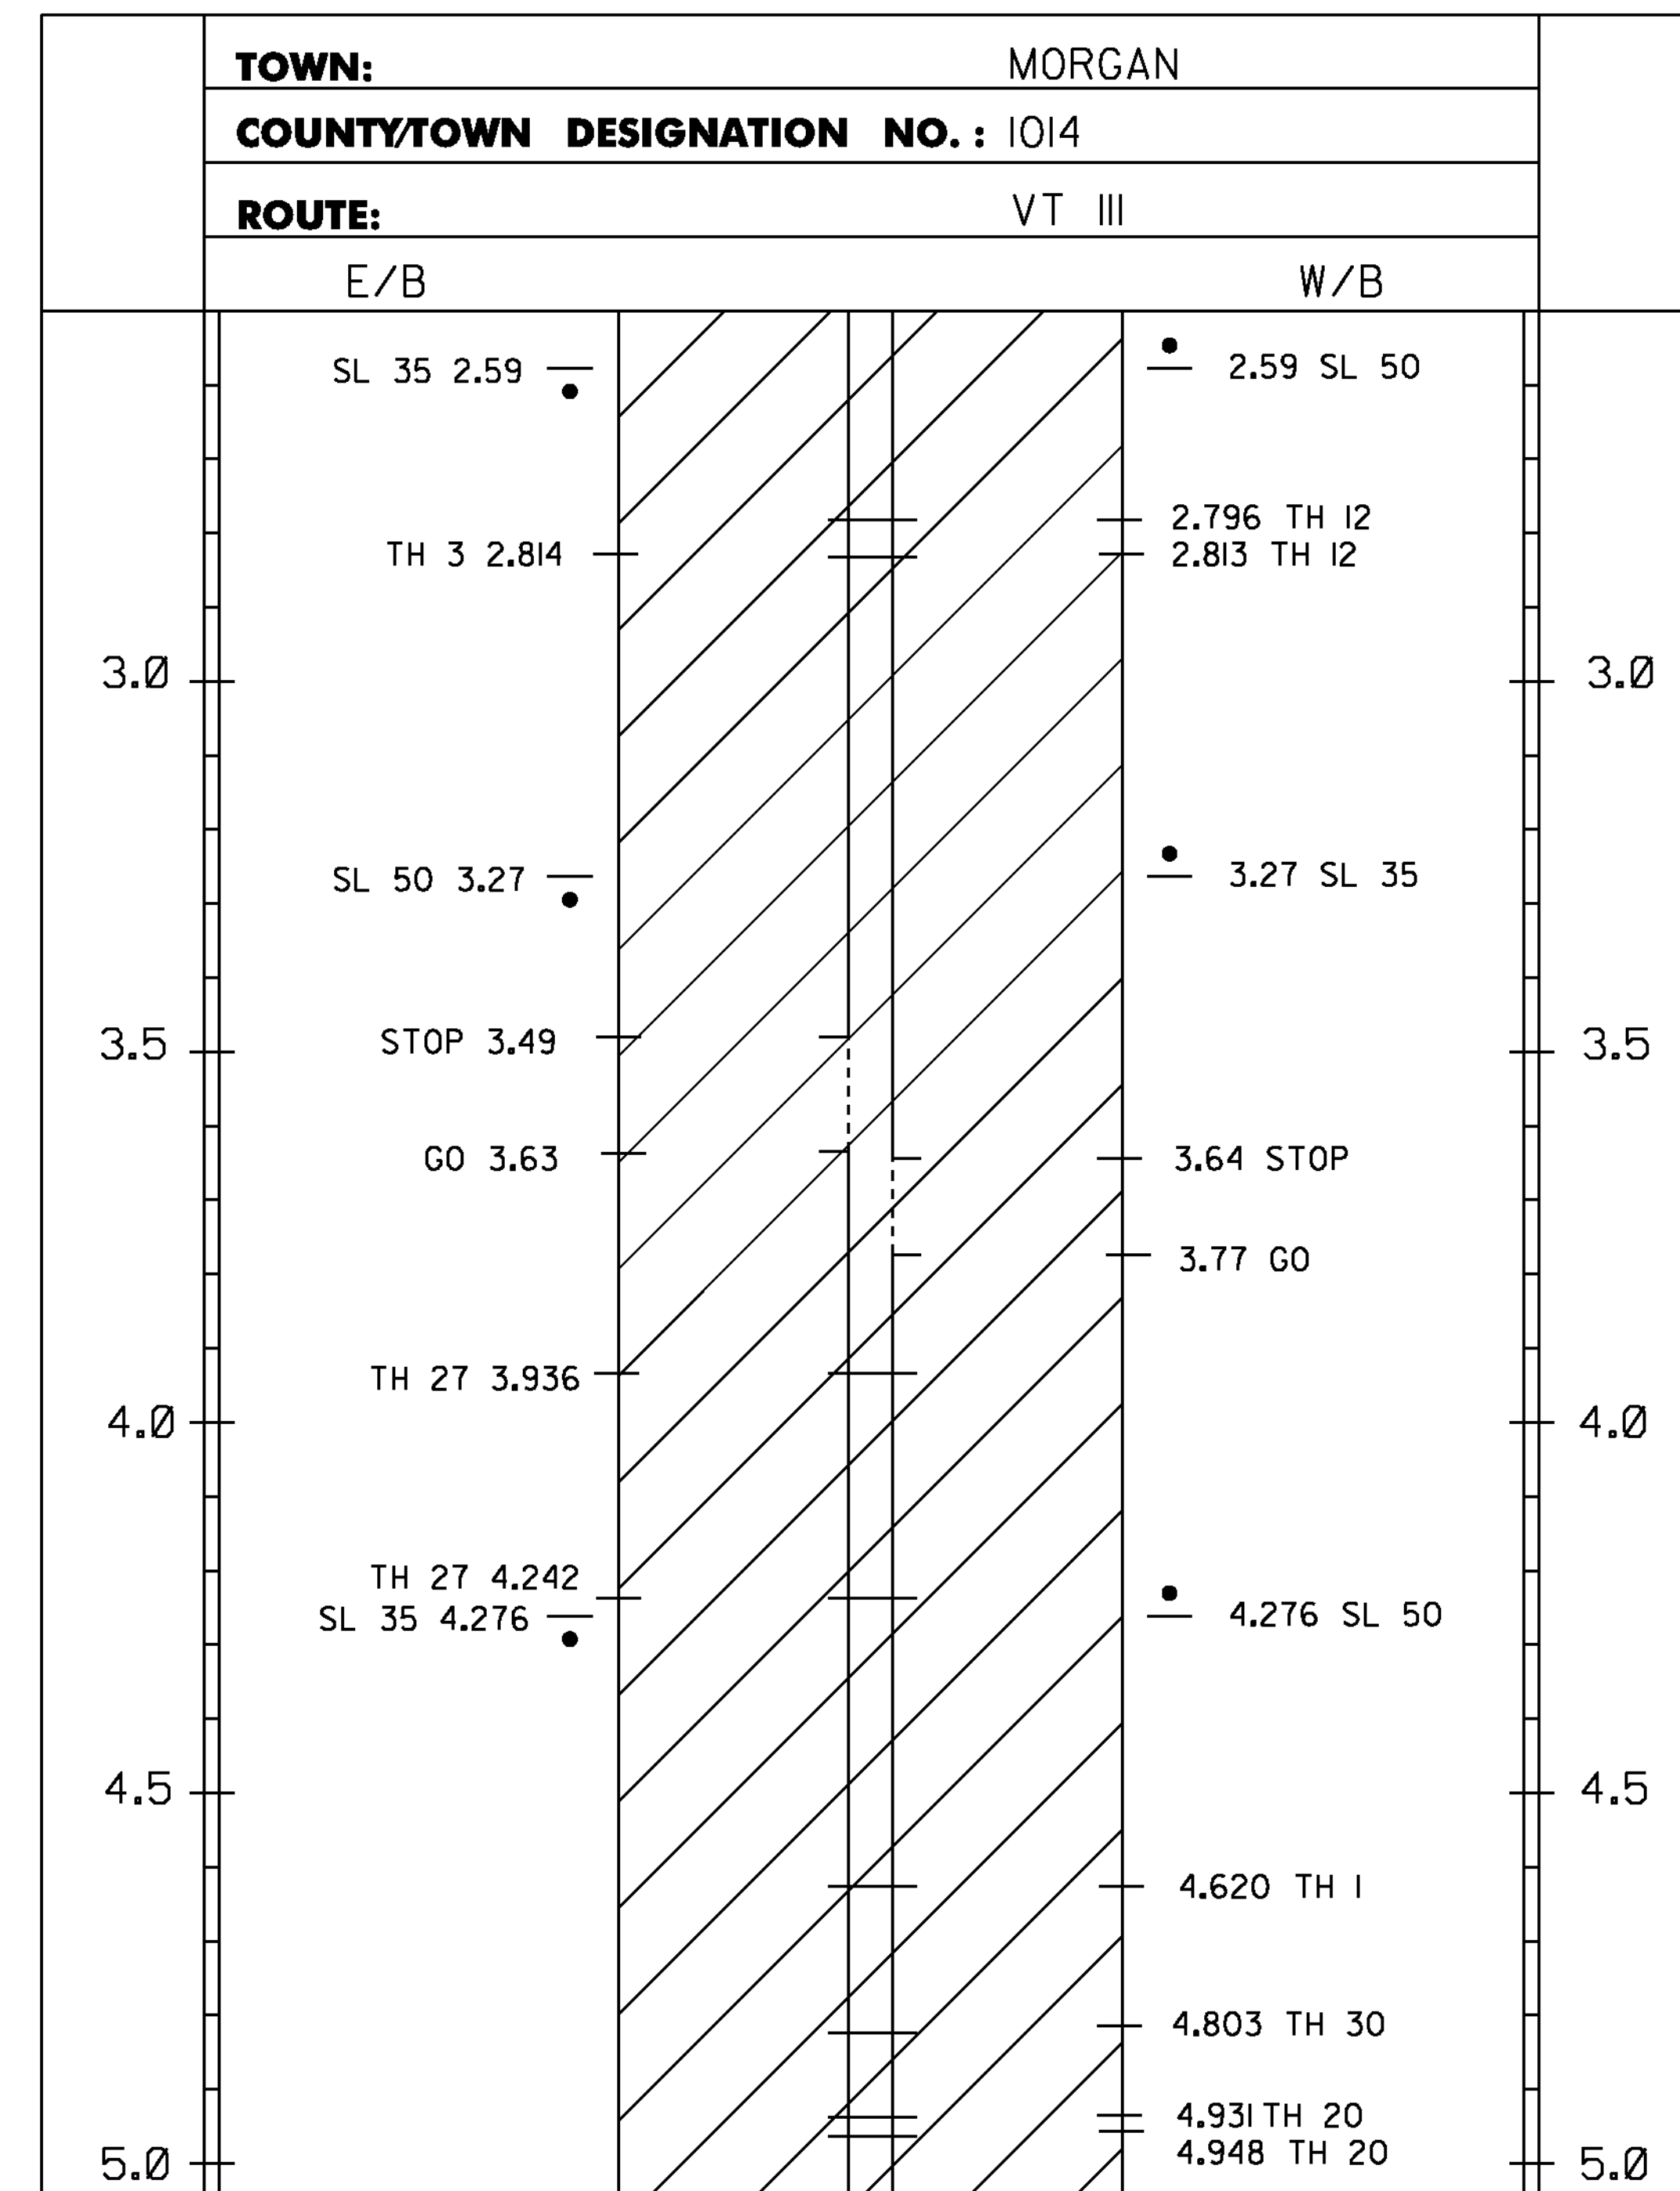

LEGEND
 TWBH-THROUGHWAY BEGINS HERE
 TWEH-THROUGHWAY ENDS HERE
 SHB-STATE HIGHWAY BEGINS
 SHE-STATE HIGHWAY ENDS
 SL-SPEED LIMIT
 C/4 TH- CLASS 4 TOWN HIGHWAY
 T/L-TOWN LINE

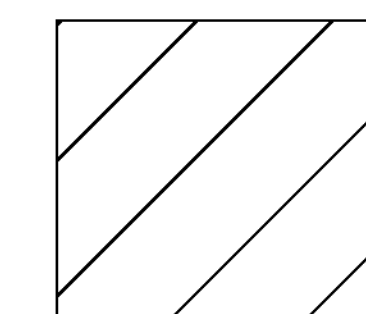

PROJECT AREA

NOTES:
 I. THIS SHEET TO BE USED FOR THE LAYOUT OF ALL CENTERLINE PAVEMENT MARKINGS.
 THE RESIDENT ENGINEER MAY CONTACT KEITH SWEET, PAVEMENT MARKING SUPERVISOR
 AT (802) 828-5573 FOR ASSISTANCE LAYING OUT THE CENTERLINE DURING CONSTRUCTION.

NOT TO SCALE

PROJECT NAME: MORGAN - BRIGHTON	
PROJECT NUMBER: STP SURF(4I)	
FILE NAME: pl3c552_Morgan-Brighton.dgn	PLOT DATE: 14-MAY-2014
PROJECT LEADER: J. HARRINGTON	DRAWN BY: N. PAPPAS
DESIGNED BY: N. PAPPAS	CHECKED BY: PAVT MGMT
PROJECT LAYOUT SHEET 1	SHEET 8 OF 16