

DURABLE 4 INCH WHITE LINE, POLYUREA
 TEMPORARY 4 INCH WHITE LINE, PAINT
 MM 5.000 - MM 10.000 LT & RT (EGDE LINES)
 (WITH BREAKS OR RADII AT TOWN HIGHWAYS)
 MM 4.611LT (TH 1) SOLID LT & RT
 MM 7.650 RT (TH 24) SOLID LT & RT
 MM 7.450 LT (TH 28) SOLID LT & RT


DURABLE 4 INCH YELLOW LINE, POLYUREA
 TEMPORARY 4 INCH YELLOW LINE, PAINT
 MM 5.000 - MM 6.485 SOLID LT & RT
 MM 6.485 - 6.560 MM SOLID LT & DASHED RT
 MM 6.560 - MM 6.630 DASHED RT
 MM 6.630 - MM 6.770 DASHED LT & SOLID RT
 MM 6.770 - MM 6.800 SOLID LT & RT
 MM 6.800 - MM 6.960 SOLID LT & DASHED RT
 MM 6.960 - MM 7.110 DASHED LT
 MM 7.110 - MM 7.260 DASHED LT & SOLID RT
 MM 7.260 - MM 7.280 DASHED LT & SOLID RT
 MM 7.280 - MM 7.430 SOLID LT & DASHED RT
 MM 7.430 - MM 7.551 DASHED RT
 MM 7.551 - MM 7.580 DASHED RT
 MM 7.580 - MM 7.650 DASHED LT & SOLID RT
 MM 7.650 - MM 10.000 SOLID LT & RT
 (WITH CENTERLINE BREAKS AT TOWN HIGHWAYS)
 MM 4.611LT (TH 1) SOLID LT & RT
 MM 7.650 RT (TH 24) SOLID LT & RT
 MM 7.450 LT (TH 28) SOLID LT & RT

TEMPORARY 24" STOP BAR, PAINT
 MM 5.000 - MM 10.000 LT & RT
 MM 4.611LT (TH 1)
 MM 7.650 RT (TH 24)
 MM 7.450 LT (TH 28)


DURABLE 24" STOP BAR (SEE OPTION ITEMS)
 MM 5.000 - MM 10.000 LT & RT
 MM 4.611LT (TH 1)
 MM 7.650 RT (TH 24)
 MM 7.450 LT (TH 28)

TEMPORARY LETTER OR SYMBOL, PAINT
 MM 5.000 - MM 10.000 LT & RT
 MM 4.611LT (TH 1) STOP
 MM 7.650 RT (TH 24) STOP
 MM 7.450 LT (TH 28) STOP

DURABLE LETTER OR SYMBOL (SEE OPTION ITEMS)
 MM 5.000 - MM 10.000 LT & RT
 MM 4.611LT (TH 1) STOP
 MM 7.650 RT (TH 24) STOP
 MM 7.450 LT (TH 28) STOP

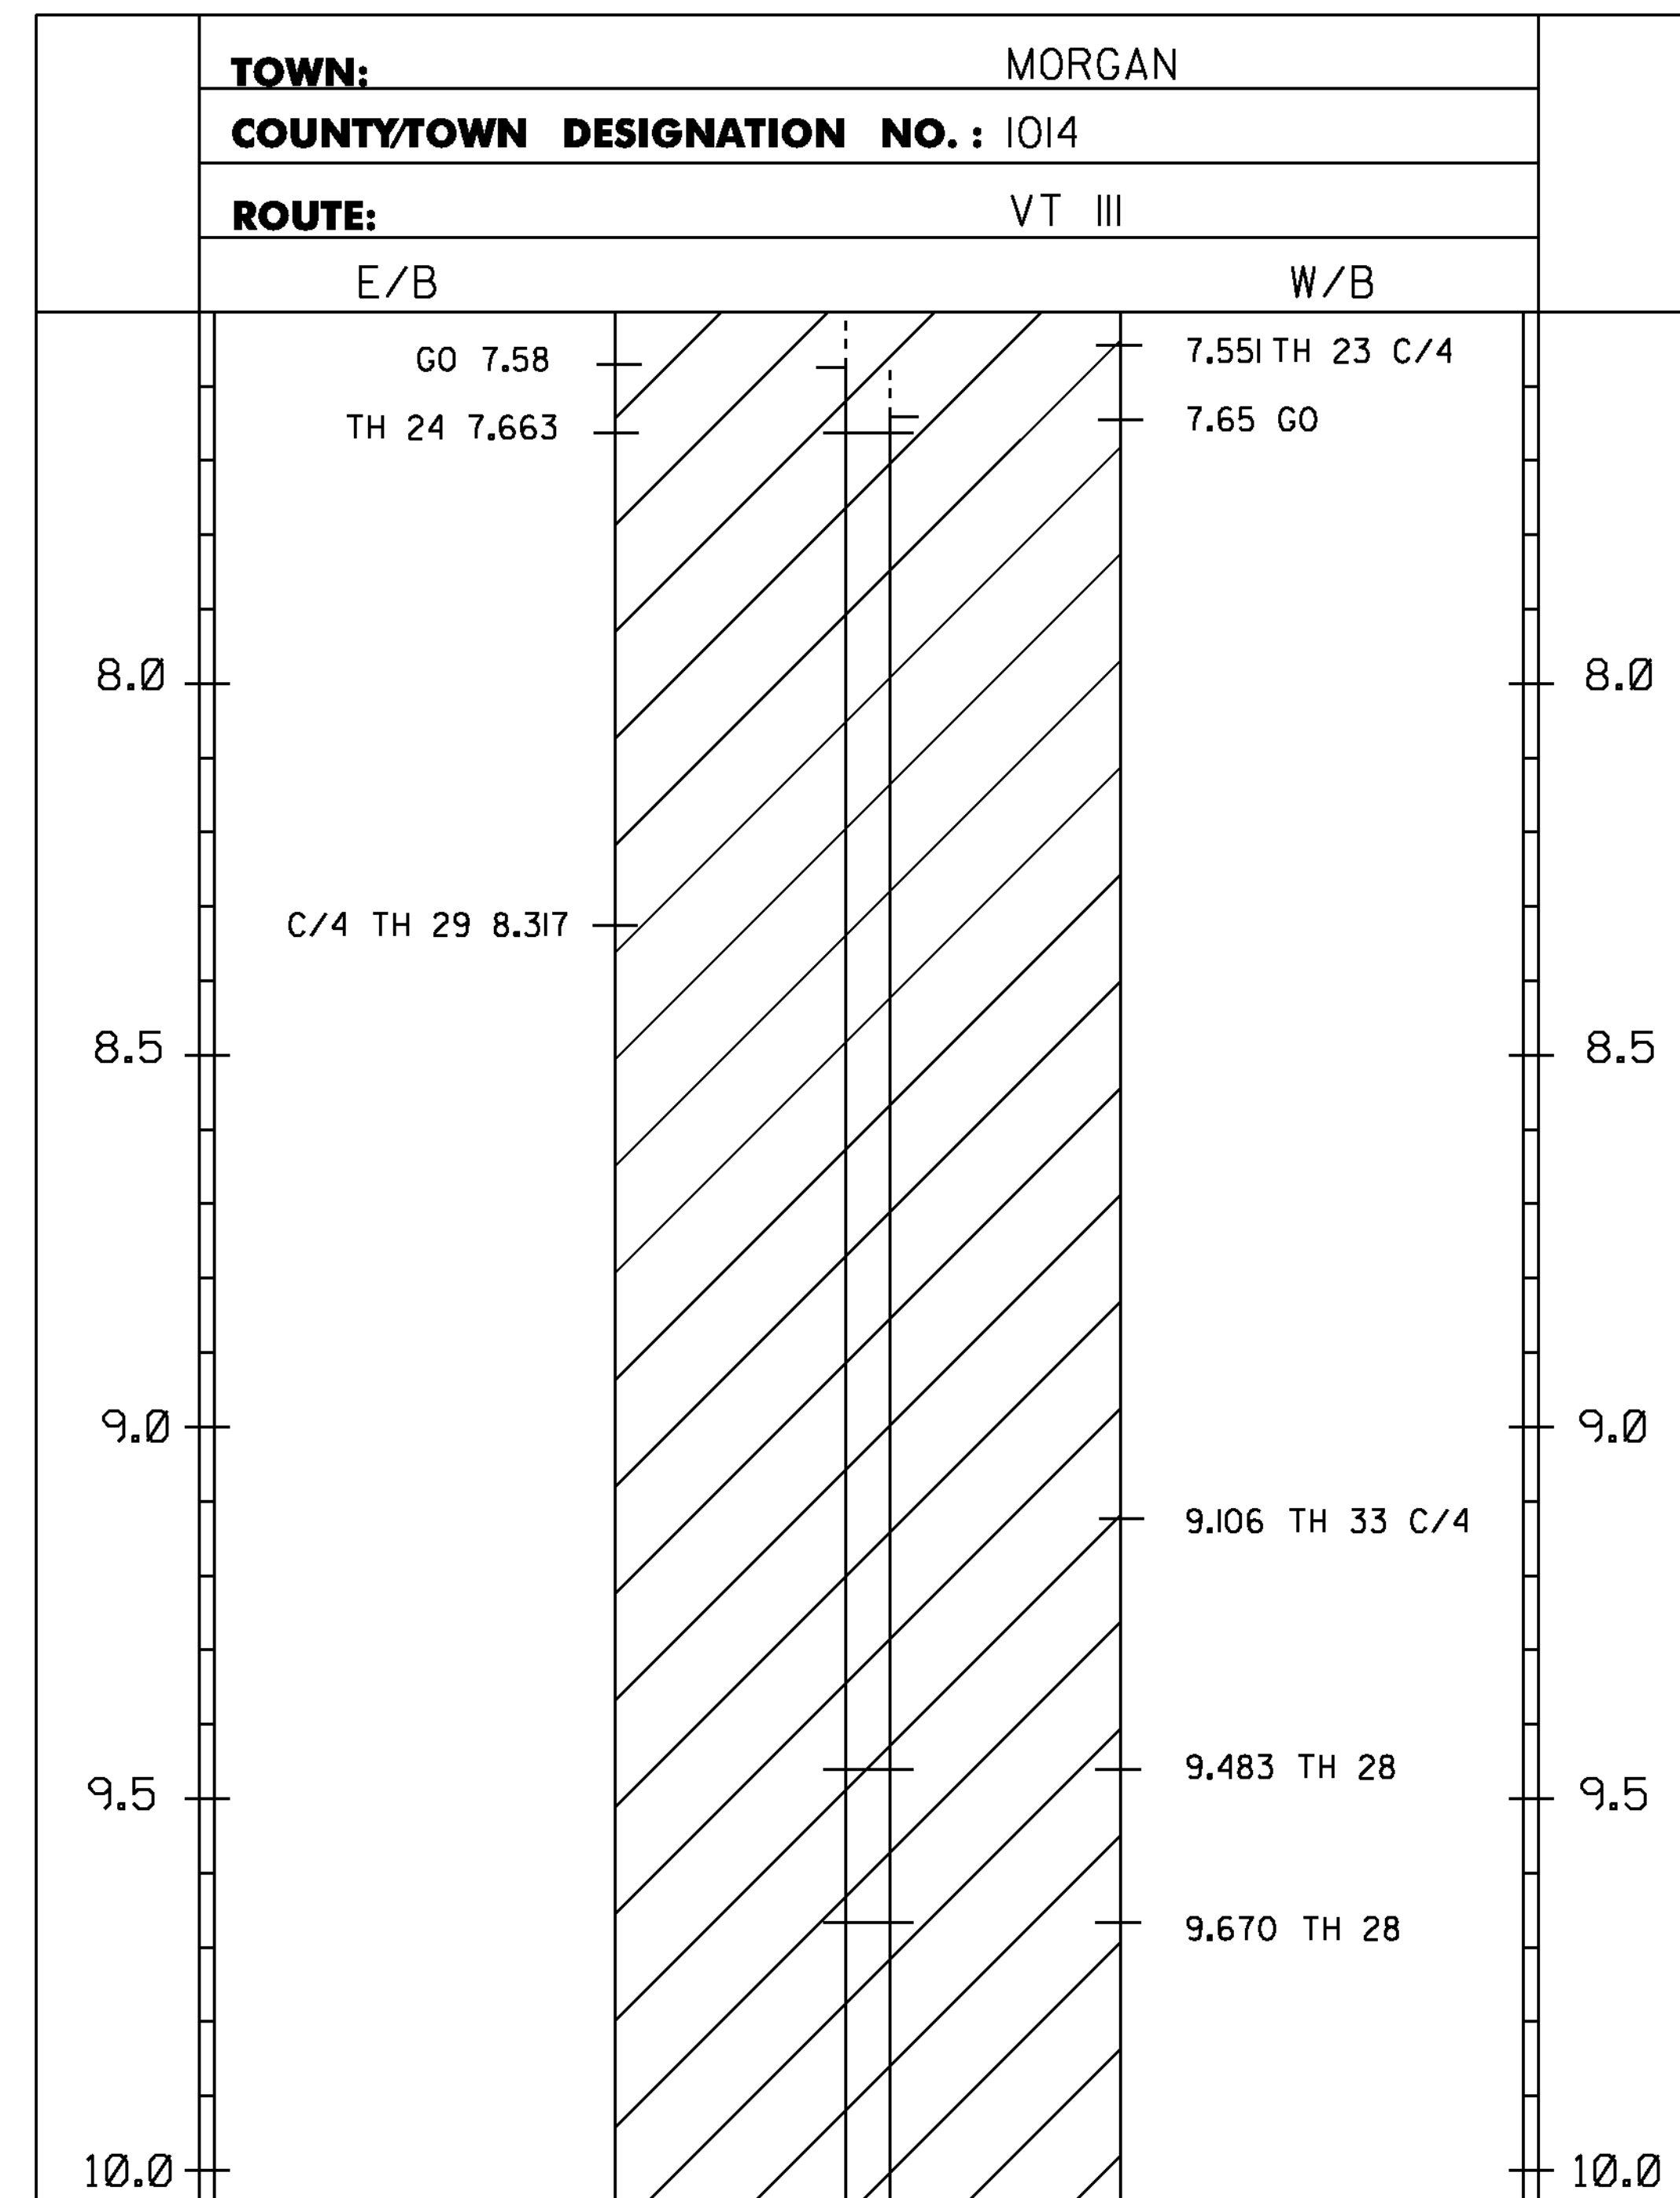

LEGEND
 TWBH-THROUGHWAY BEGINS HERE
 TWEH-THROUGHWAY ENDS HERE
 SHB-STATE HIGHWAY BEGINS
 SHE-STATE HIGHWAY ENDS
 SL-SPEED LIMIT
 C/4 TH- CLASS 4 TOWN HIGHWAY
 T/L-TOWN LINE

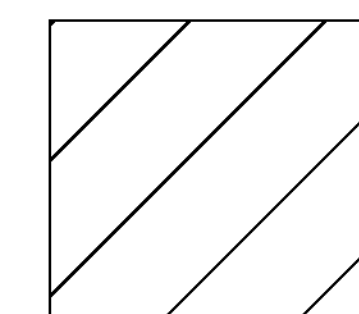

PROJECT AREA

NOTES:
 1. THIS SHEET TO BE USED FOR THE LAYOUT OF ALL CENTERLINE PAVEMENT MARKINGS.
 THE RESIDENT ENGINEER MAY CONTACT KEITH SWEET, PAVEMENT MARKING SUPERVISOR
 AT (802) 828-5573 FOR ASSISTANCE LAYING OUT THE CENTERLINE DURING CONSTRUCTION.

NOT TO SCALE

PROJECT NAME:	MORGAN - BRIGHTON
PROJECT NUMBER:	STP SURF(4I)
FILE NAME: pl3c552_Morgan-Brighton.dgn	PLOT DATE: 14-MAY-2014
PROJECT LEADER: J. HARRINGTON	DRAWN BY: N. PAPPAS
DESIGNED BY: N. PAPPAS	CHECKED BY: PAVT MGMT
PROJECT LAYOUT SHEET 2	SHEET 9 OF 16