

DURABLE 4 INCH WHITE LINE, POLYUREA
 TEMPORARY 4 INCH WHITE LINE, PAINT
 MM 10.000 - MM 0.137 LT & RT (EDGE LINES)
 (WITH BREAKS OR RADII AT TOWN HIGHWAYS)


DURABLE 4 INCH YELLOW LINE, POLYUREA
 TEMPORARY 4 INCH YELLOW LINE, PAINT
 MM 10.000 - MM 10.020 SOLID LT & RT
 MM 10.020 - MM 10.170 SOLID LT & DASHED RT
 MM 10.170 - MM 10.030 DASHED LT & SOLID RT
 MM 10.030 - MM 10.730 SOLID LT & RT
 MM 10.730 - MM 10.880 SOLID LT & DASHED RT
 MM 10.880 - MM 10.900 DASHED RT
 MM 10.900 - MM 11.030 DASHED LT & SOLID RT
 MM 11.030 - MM 0.137 SOLID LT & RT
 (WITH CENTERLINE BREAKS AT TOWN HIGHWAYS)

TEMPORARY 24 INCH STOP BAR, PAINT
 MM 0.133


DURABLE 24 INCH STOP BAR (SEE OPTION ITEMS)
 MM 0.133

TEMPORARY LETTER OR SYMBOL, PAINT
 MM 11.060 "S,T,O,P A,H,E,A,D" (9 EA)
 MM 0.133 "S,T,O,P" (4 EA)

DURABLE LETTER OR SYMBOL (SEE OPTIONS ITEMS)
 MM 11.060 "S,T,O,P A,H,E,A,D" (9 EA)
 MM 0.133 "S,T,O,P" (4 EA)

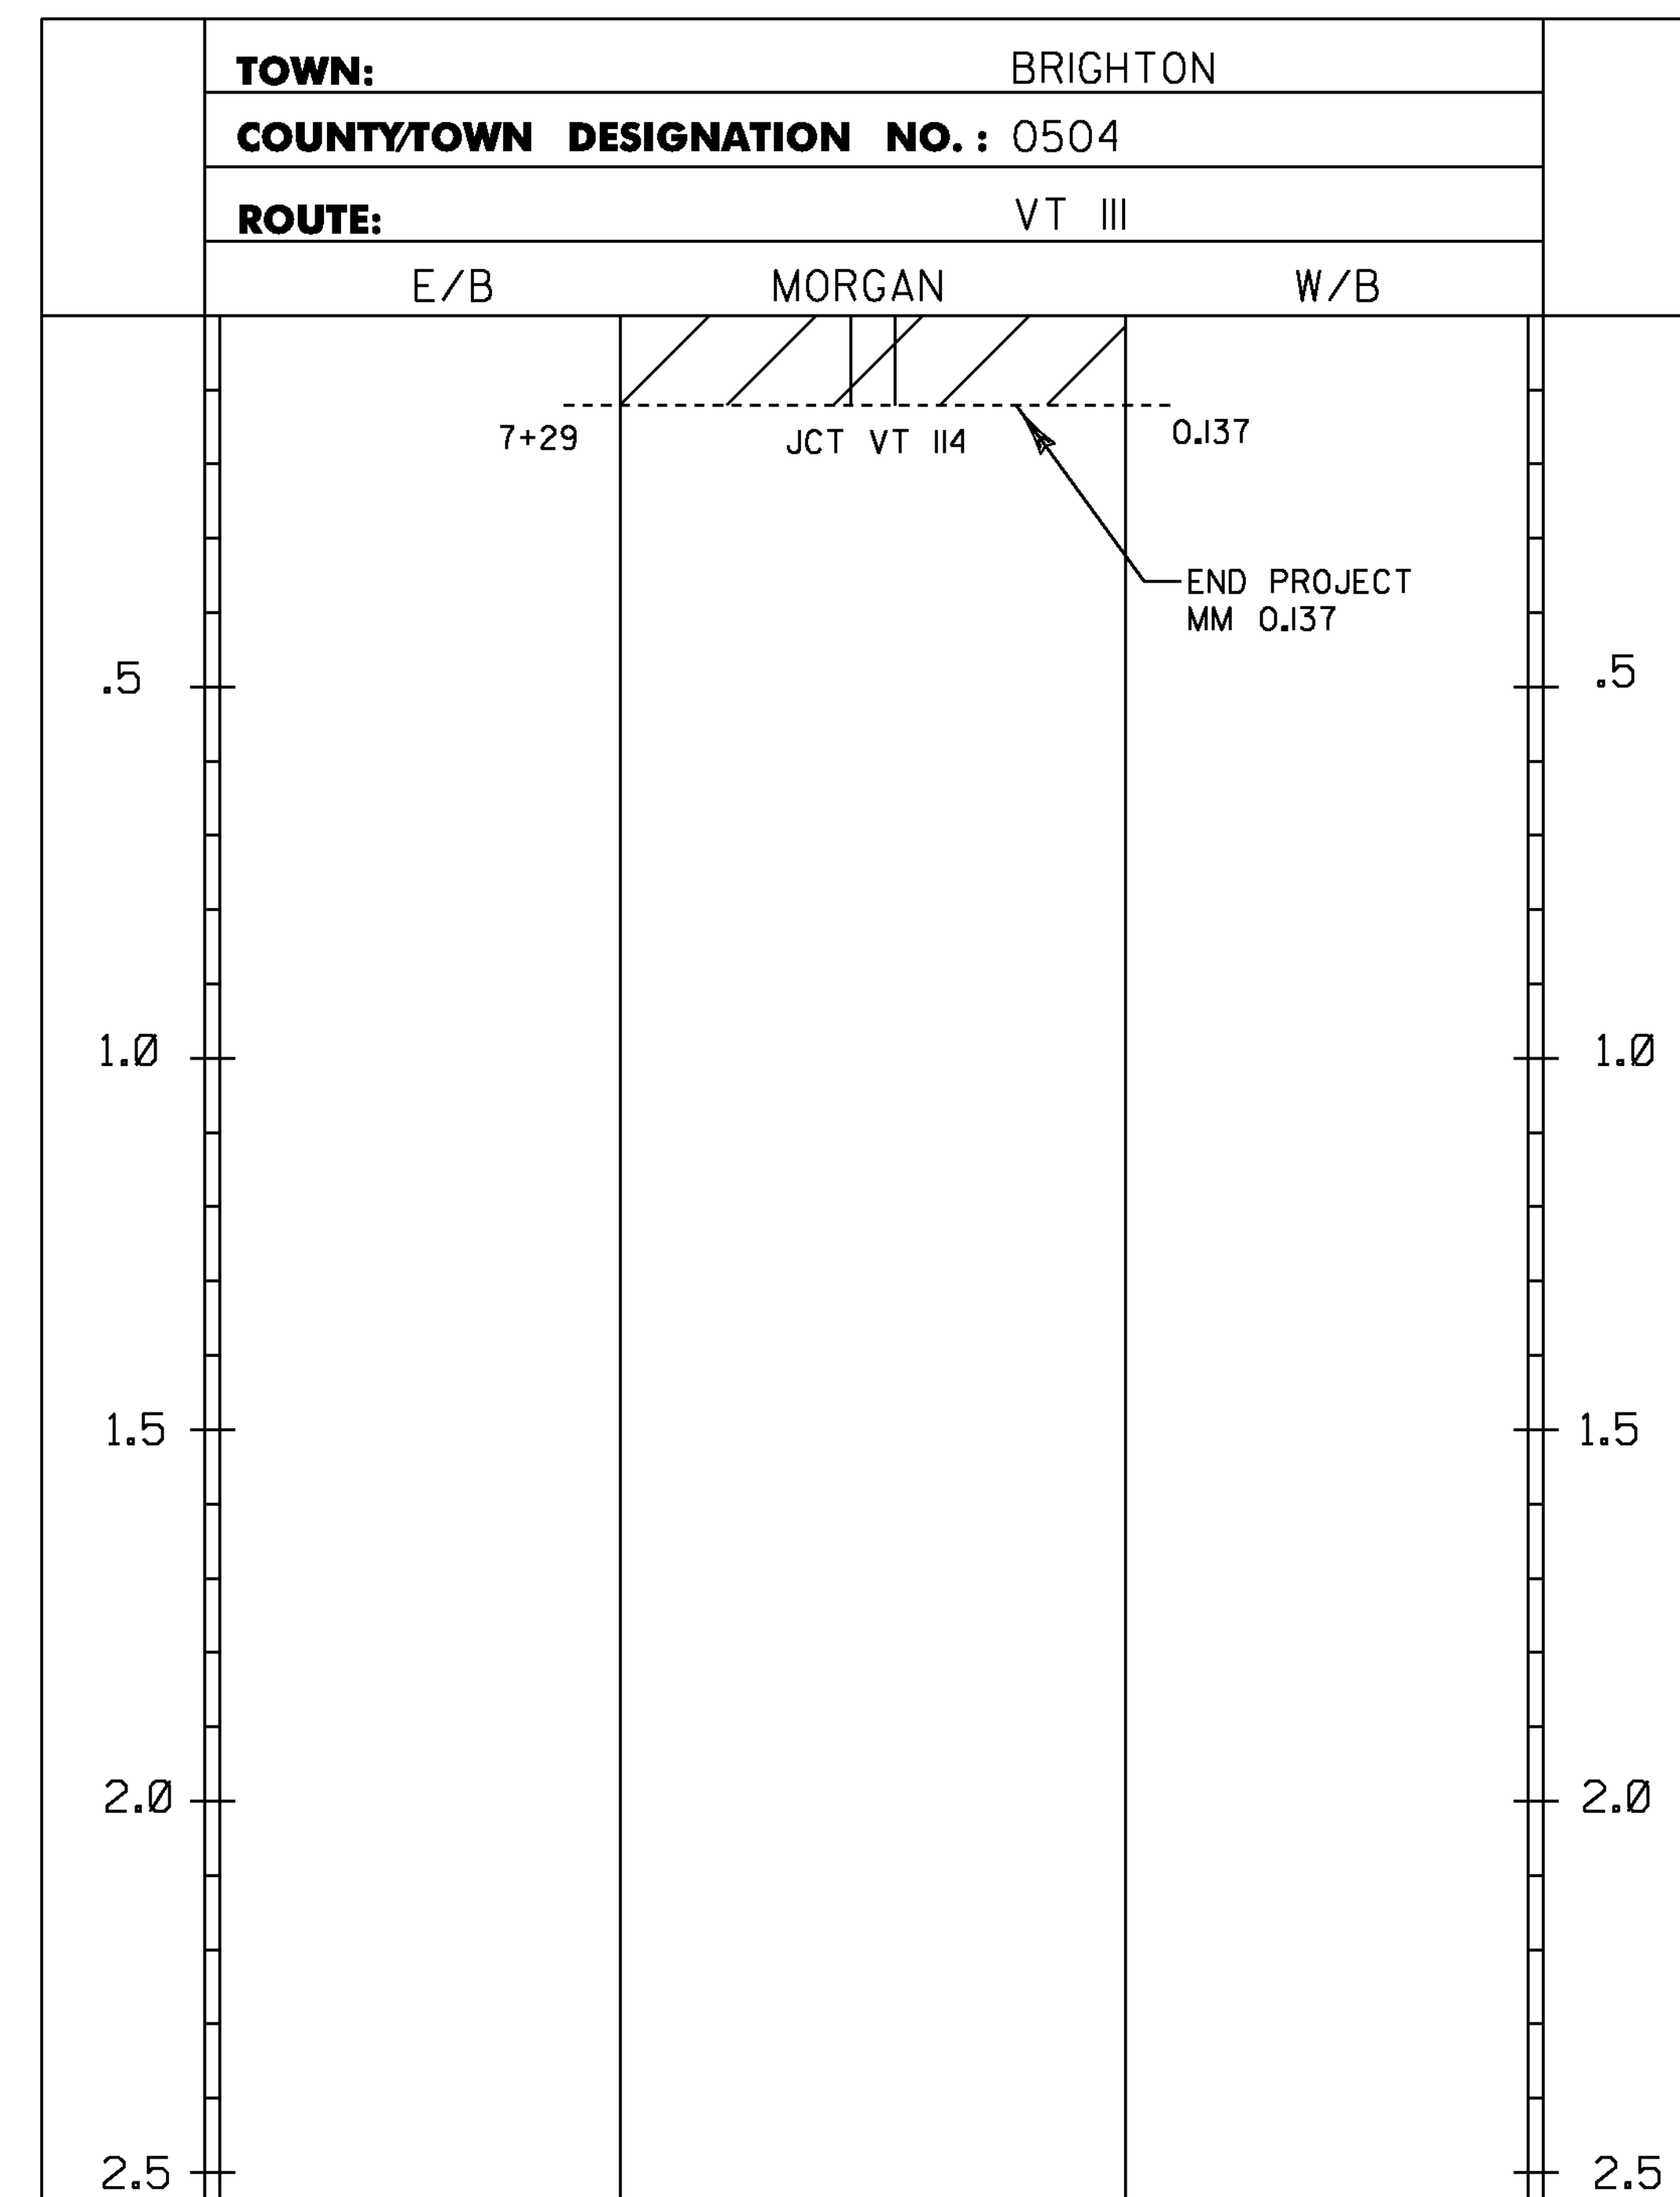

LEGEND
 TWBH-THROUGHWAY BEGINS HERE
 TWEH-THROUGHWAY ENDS HERE
 SHB-STATE HIGHWAY BEGINS
 SHE-STATE HIGHWAY ENDS
 SL-SPEED LIMIT
 C/4 TH- CLASS 4 TOWN HIGHWAY
 T/L-TOWN LINE

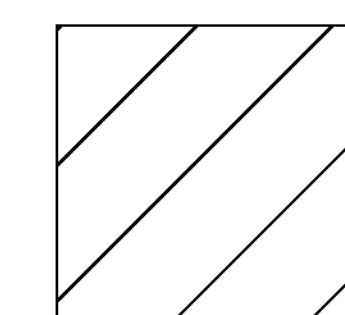

PROJECT AREA

NOTES:
 I. THIS SHEET TO BE USED FOR THE LAYOUT OF ALL CENTERLINE PAVEMENT MARKINGS.
 THE RESIDENT ENGINEER MAY CONTACT KEITH SWEET, PAVEMENT MARKING SUPERVISOR
 AT (802) 828-5573 FOR ASSISTANCE LAYING OUT THE CENTERLINE DURING CONSTRUCTION.

NOT TO SCALE

PROJECT NAME:	MORGAN - BRIGHTON
PROJECT NUMBER:	STP SURF(4I)
FILE NAME: pl3c552_Morgan-Brighton.dgn	PLOT DATE: 14-MAY-2014
PROJECT LEADER: J. HARRINGTON	DRAWN BY: N. PAPPAS
DESIGNED BY: N. PAPPAS	CHECKED BY: PAVT MGMT
PROJECT LAYOUT SHEET 3	SHEET 10 OF 16