

Record Plans

Contractor: Engineers Construction, Inc. - Williston, Vermont
 Resident Engineer: Josh Hulett
 Construction Began: July 20, 2016
 Construction Complete: October 25, 2016
 Record Plans By: Josh Hulett / Paul Beyor


I hereby certify that all construction required by this set of drawings has been accomplished as indicated herein.

BY: Josh Hulett Resident Engineer
 Josh Hulett

Date: MARCH 9, 2017

NOTE: Any further information concerning final quantities, amounts or other details relative to this project may be found at Central Files in the electronic archives.

STATE OF VERMONT AGENCY OF TRANSPORTATION


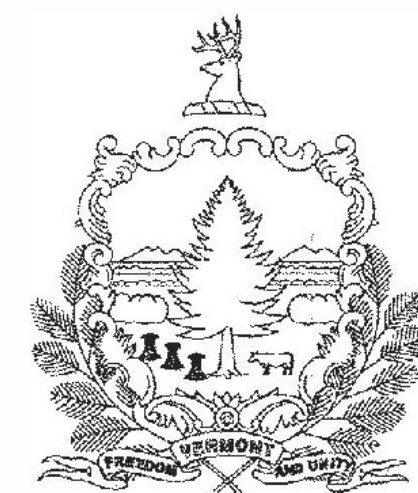


PROPOSED IMPROVEMENT TOWN OF FERRISBURGH COUNTY OF ADDISON US ROUTE 7 (PRINCIPAL ARTERIAL) (NHS)

BEGINNING AT A POINT ON US ROUTE 7 APPROXIMATELY 594 FT SOUTHERLY OF THE INTERSECTION OF LITTLE CHICAGO ROAD (TH-5) AND MIDDLEBROOK ROAD (TH-14) IN THE TOWN OF FERRISBURGH (MM 3.005) AND EXTENDING NORTHERLY A DISTANCE OF 1188.00 FT (0.225 MI).

WORK TO BE PERFORMED UNDER THIS PROJECT INCLUDES THE CONSTRUCTION OF A TRAFFIC SIGNAL SYSTEM, SIGNING AND OTHER HIGHWAY RELATED WORK.

LENGTH OF PROJECT = 1188.00 FT = 0.225 MI

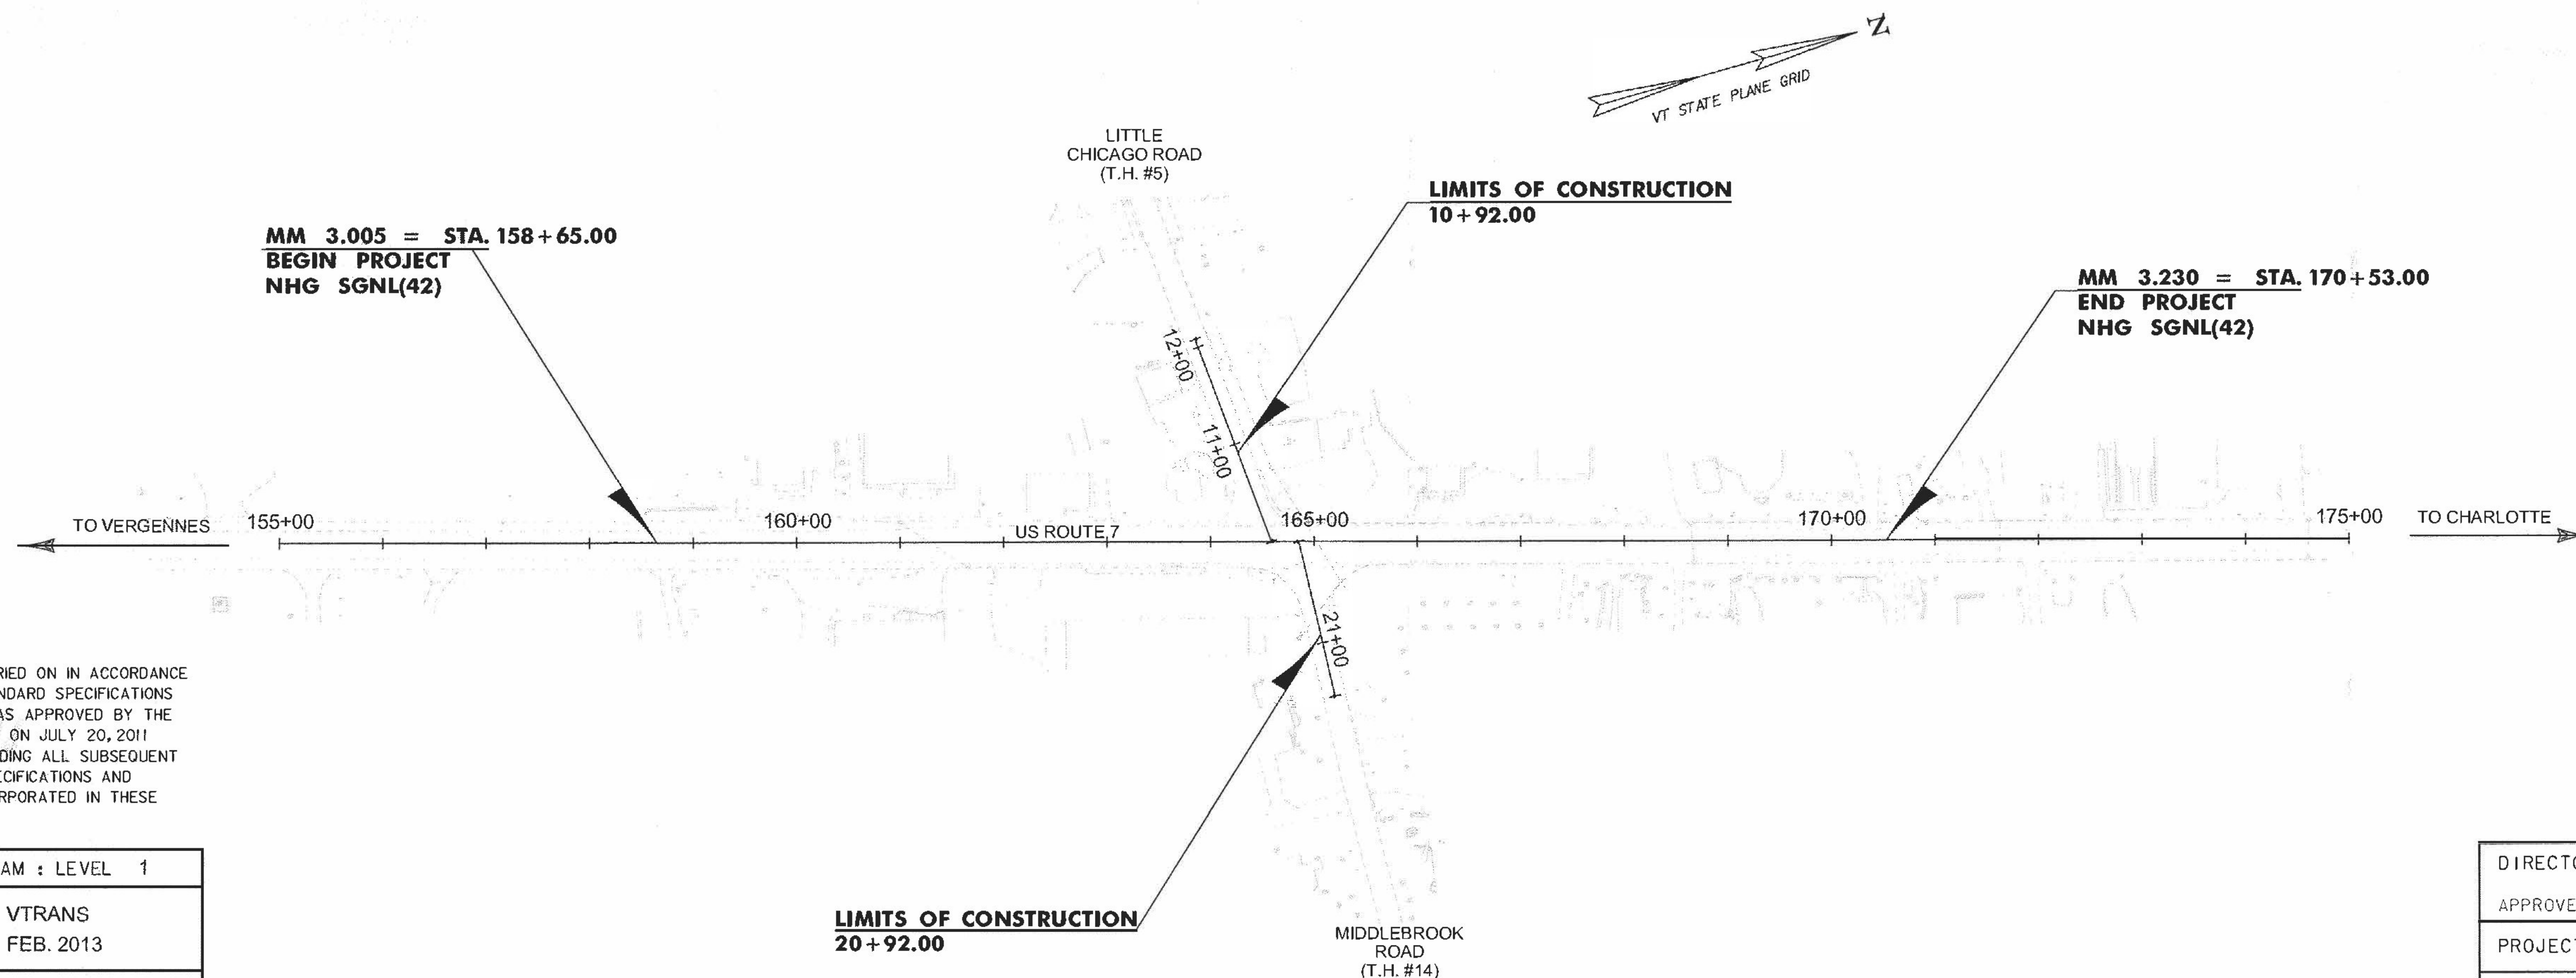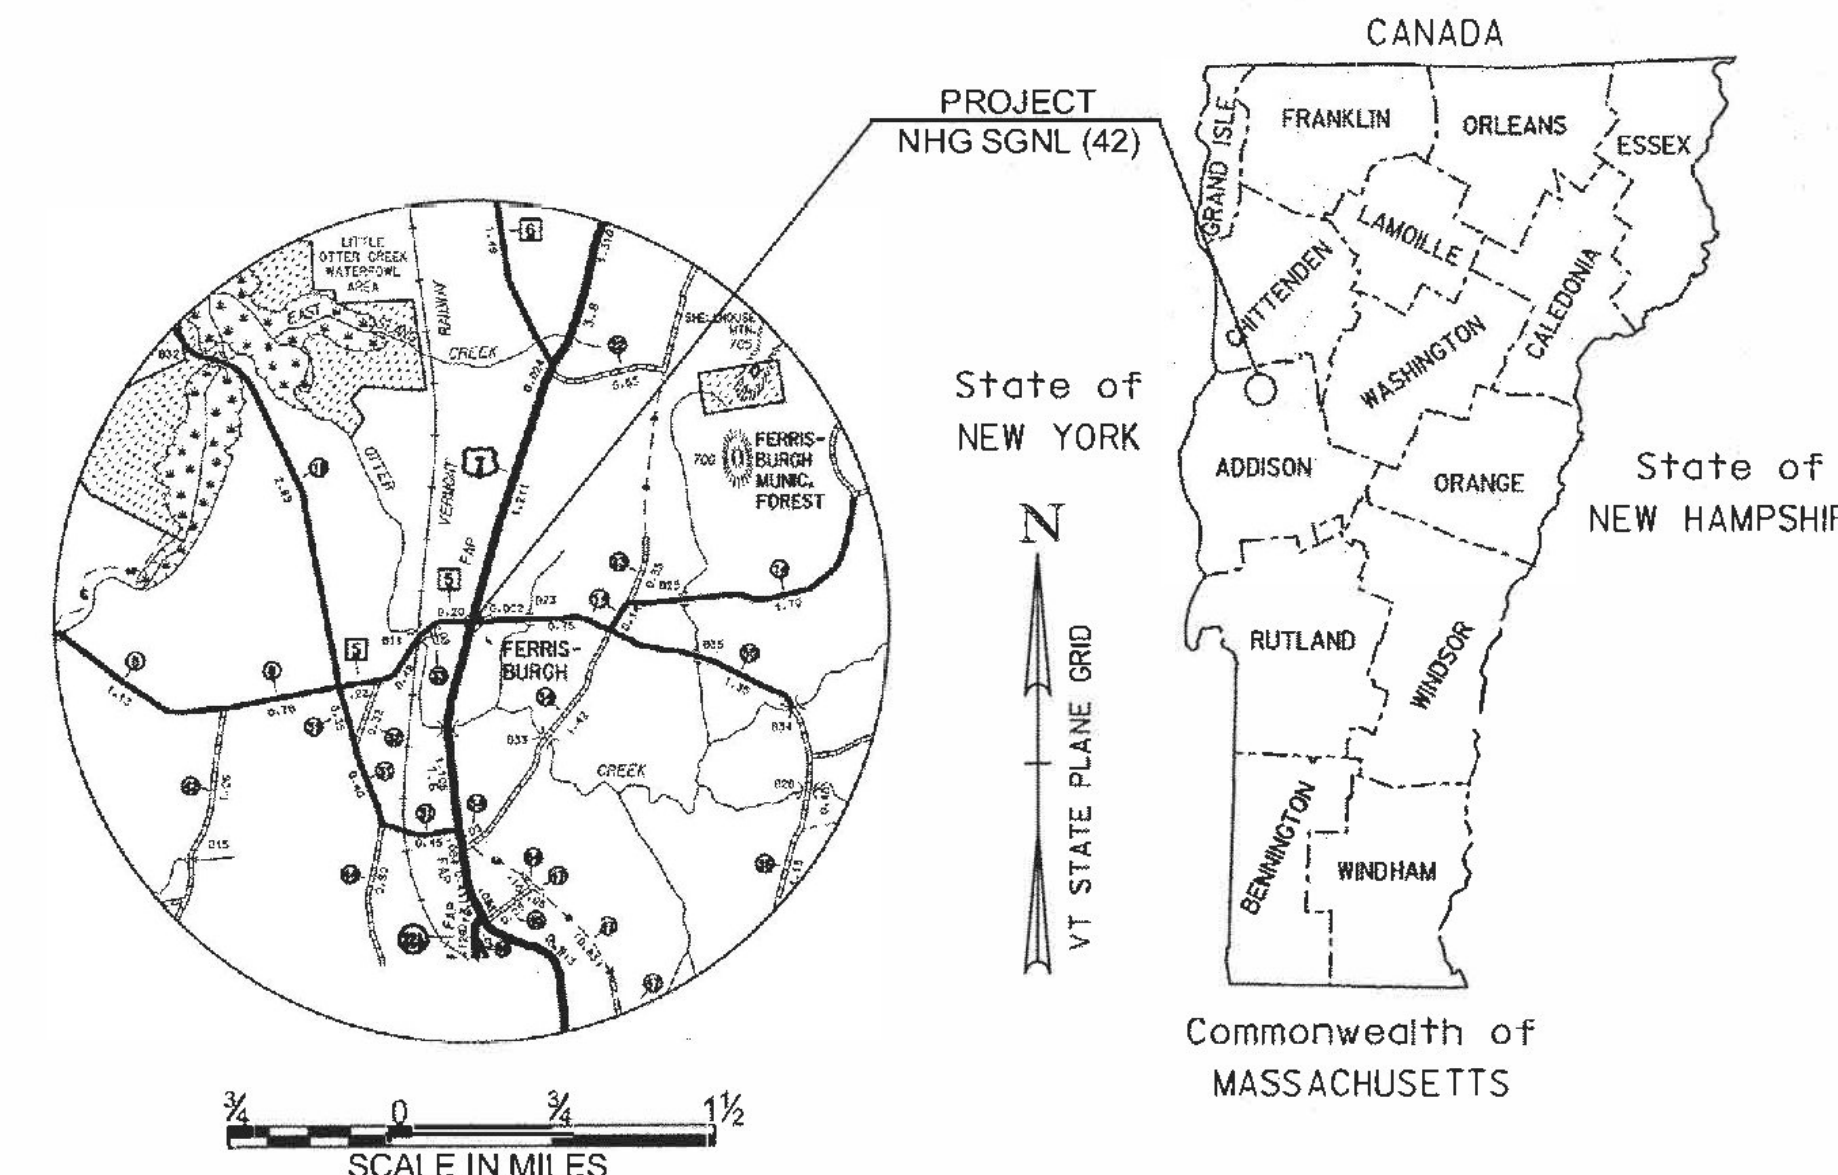

CONSTRUCTION IS TO BE CARRIED ON IN ACCORDANCE WITH THESE PLANS AND THE STANDARD SPECIFICATIONS FOR CONSTRUCTION DATED 2011, AS APPROVED BY THE FEDERAL HIGHWAY ADMINISTRATION ON JULY 20, 2011 FOR USE ON THIS PROJECT, INCLUDING ALL SUBSEQUENT REVISIONS AND SUCH REVISED SPECIFICATIONS AND SPECIAL PROVISIONS AS ARE INCORPORATED IN THESE PLANS.

QUALITY ASSURANCE PROGRAM : LEVEL 1	
SURVEYED BY :	VTRANS
SURVEYED DATE :	FEB. 2013
DATUM	
VERTICAL	NAVD88
HORIZONTAL	NAD83 (2007)

DIRECTOR OF PROJECT DELIVERY	
APPROVED: <u>[Signature]</u>	DATE: <u>3/2/2016</u>
PROJECT MANAGER : PATRICIA COBURN, P.E.	
PROJECT NAME : FERRISBURGH	
PROJECT NUMBER : NHG SGNL(42)	
SHEET 1 OF 22 SHEETS	

