



CAST - IN - PLACE CONCRETE CURB, TYPE B
SEE TABLE, THIS SHEET

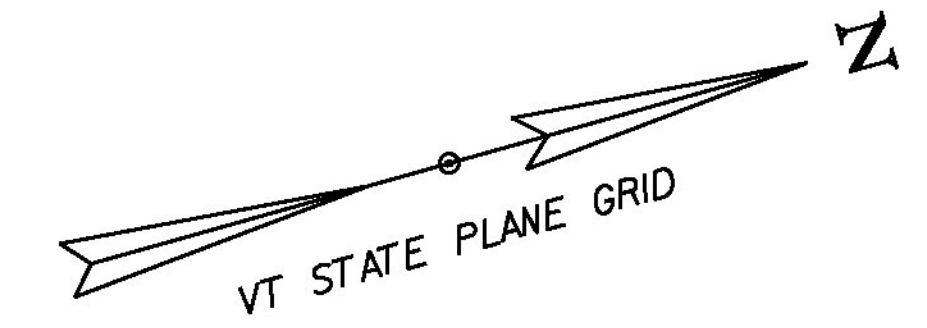

CURB ID	STATION		BEGIN LOCATION		END LOCATION		LENGTH (FT)	RADI CENTER POINT LOCATION			RADIUS (FT)
	BEGIN	END	NORTHING	EASTING	NORTHING	EASTING		NORTHING	EASTING	STATION	
1	161+99.29, 24.50 FT	162+05.29, 24.50 FT	622309.15	1444692.64	622314.93	1444694.26	6.0	-	-	-	-
2	162+05.29, 24.50 FT	162+16.29, 35.50 FT	622314.93	1444694.26	622322.55	1444707.82	17.32	622311.95	1444704.85	162+05.29, 35.50 FT	11
3	162+69.54, 31.00 FT	162+69.54, 24.50 FT	622375.03	1444717.86	622376.79	1444711.60	10.29	622375.91	1444714.73	162+69.54, 27.75 FT	3.25
4	162+69.54, 24.50 FT	162+96.29, 24.50 FT	622376.79	1444711.60	622402.55	1444718.82	26.75	-	-	-	-
5	162+96.29, 24.50 FT	162+96.29, 31.00 FT	622402.55	1444718.82	622400.79	1444725.08	10.29	622401.67	1444721.95	162+96.29, 27.75 FT	3.25
6	162+96.29, 31.00 FT	162+69.54, 31.00 FT	622400.79	1444725.08	622375.03	1444717.86	26.75	-	-	-	-
7	163+52.81, 31.03 FT	163+52.79, 24.50 FT	622455.21	1444740.36	622456.83	1444734.01	10.29	622456.07	1444737.20	163+52.79, 27.75 FT	3.25
8	163+52.65, 24.50 FT	164+01.00, 24.50 FT	622456.96	1444734.04	622503.38	1444747.06	48.21	-	-	-	-
9	164+01.00, 24.50 FT	164+36.29, 24.92 FT	622503.38	1444747.06	622537.25	1444757.02	35.29	-	-	-	-
10	164+36.29, 24.92 FT	164+69.69, 35.58 FT	622537.25	1444757.02	622566.52	1444776.29	35.41	622520.29	1444814.60	164+35.32, 85.47 FT	60
11	164+69.69, 35.58 FT	164+69.09, 39.18 FT	622566.52	1444776.29	622564.97	1444779.60	4.75	622564.96	1444777.58	164+68.53, 37.24 FT	2
12	164+69.09, 39.18 FT	164+47.24, 36.02 FT	622564.97	1444779.60	622544.79	1444770.66	22.20	622568.94	1444743.88	164+63.17, 3.75 FT	36
13	164+47.24, 36.02 FT	164+33.59, 32.50 FT	622544.79	1444770.66	622532.59	1444763.59	14.89	622521.09	1444797.07	164+31.55, 67.85 FT	35.5
14	164+33.59, 32.50 FT	163+99.83, 31.04 FT	622532.59	1444763.59	622500.48	1444753.06	33.80	-	-	-	-
15	163+99.83, 31.04 FT	163+52.79, 24.50 FT	622500.48	1444753.06	622456.83	1444734.01	46.86	-	-	-	-

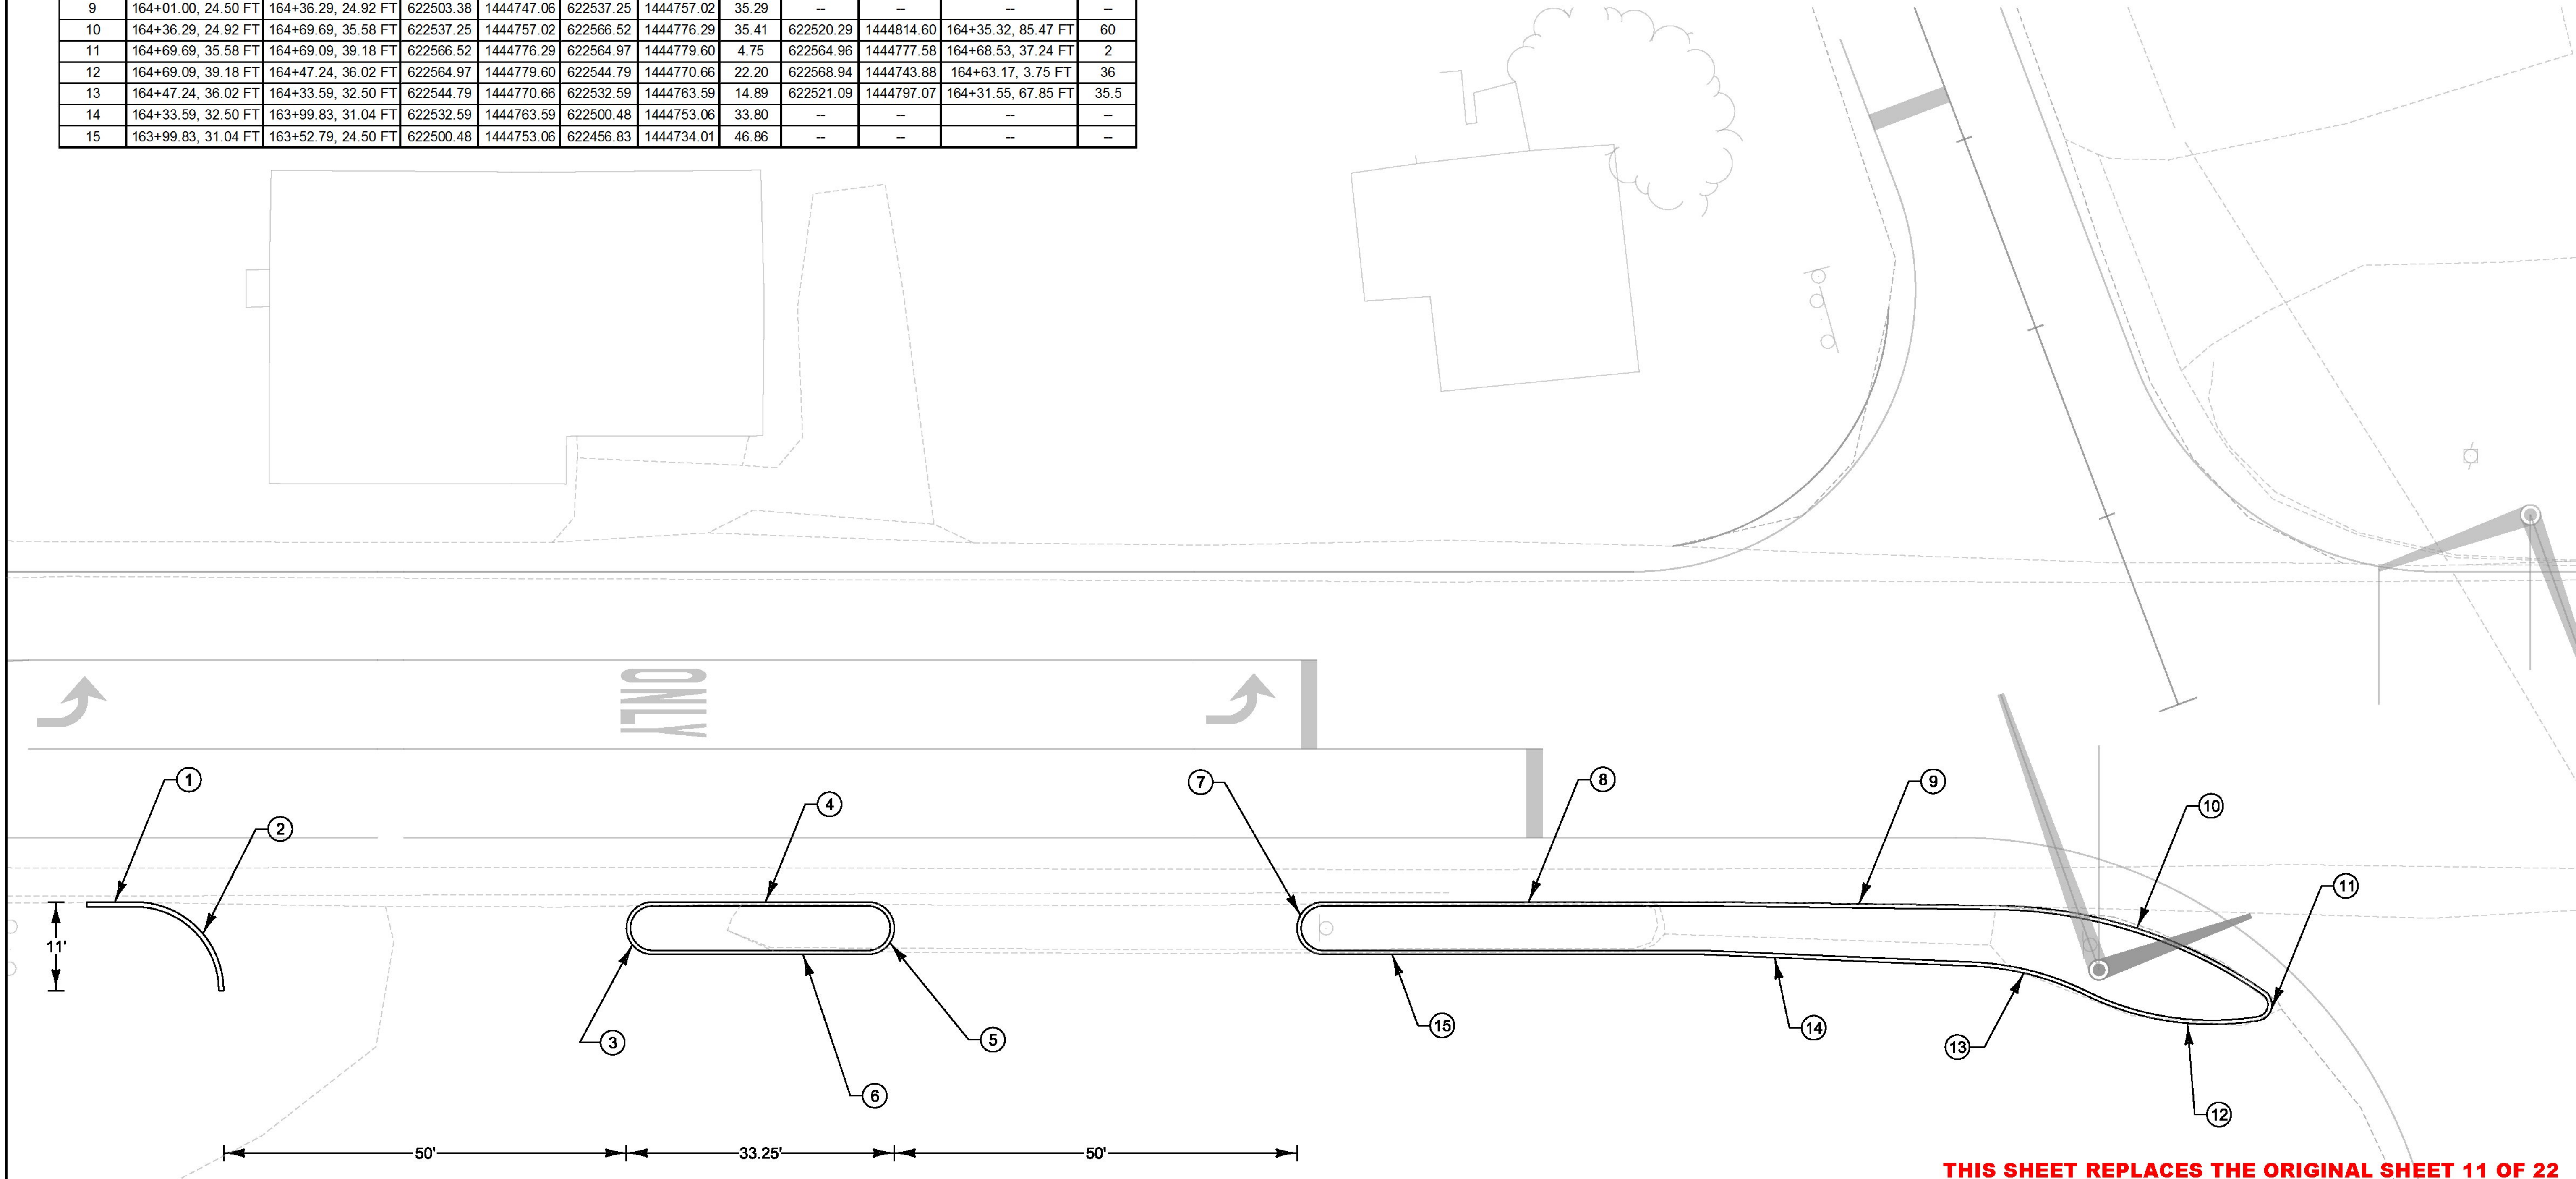

THIS SHEET REPLACES THE ORIGINAL SHEET 11 OF 22

PROJECT NAME: FERRISBURGH
PROJECT NUMBER: NHG SCNL(42)

FILE NAME: +13b016crb.dgn
PROJECT LEADER: I. DEGUTIS
DESIGNED BY: I. DEGUTIS
CURBING PLAN SHEET

PLOT DATE: 8/11/2016
DRAWN BY: K. RECORD
CHECKED BY: I. DEGUTIS
SHEET 11A OF 22

