

TEMPORARY 4 INCH WHITE LINE

- (A1) STA. 158+65.00, LT. - STA. 10+92.00, LT. (SOLID) (614')
- (A2) STA. 158+65.00, RT. - STA. 20+92.00, RT. (SOLID) (677')
- (A3) STA. 160+12.00, RT. - STA. 161+92.00, RT. (DOTTED) (60')
- (A4) STA. 161+92.00, RT. - STA. 163+80.00, RT. (SOLID) (188')
- (A5) STA. 20+92.00, LT. - STA. 170+53.00, RT. (SOLID) (592')
- (A6) STA. 10+92.00, RT. - STA. 170+53.00, LT. (SOLID) (719')
- (A7) STA. 165+59.00, LT. - STA. 167+26.00, LT. (SOLID) (167')
- (A8) STA. 167+26.00, LT. - STA. 169+06.00, LT. (DOTTED) (60')

TEMPORARY 4 INCH YELLOW LINE

- (B1) STA. 158+65.00, CL - STA. 161+92.00, LT. (DOUBLE) (327'x2)
- (B2) STA. 158+65.00, CL - STA. 161+92.00, LT. (DOUBLE) (327'x2)
- (B3) STA. 161+92.00, LT. - STA. 163+52.00, LT. (DOUBLE) (160'x2)
- (B4) STA. 10+80.00, CL - STA. 11+50.00, CL (DOUBLE) (80'x2)
- (B5) STA. 20+80.00, CL - STA. 20+92.00, CL (DOUBLE) (45'x2)
- (B6) STA. 165+79.00, RT. - STA. 167+26.00, RT. (DOUBLE) (147'x2)
- (B7) STA. 167+26.00, RT. - STA. 170+53.00, CL (DOUBLE) (327'x2)
- (B8) STA. 167+26.00, RT. - STA. 170+53.00, CL (DOUBLE) (327'x2)

TEMPORARY 8 INCH YELLOW LINE

- (C1) STA. 158+65.00 - STA. 161+92.00 (DIAGONALS) (180')
- (C2) STA. 167+26.00 - STA. 170+53.00 (DIAGONALS) (180')

TEMPORARY LETTER OR SYMBOL

- STA. 159+52.98, RT "SIGNAL AHEAD"
- STA. 159+69.43, RT " "
- STA. 161+97.49, CL " "
- STA. 162+70.95, CL " ONLY "
- STA. 163+40.79, CL " "
- STA. 165+87.52, CL " "
- STA. 166+52.03, CL " ONLY "
- STA. 167+10.27, CL " "
- STA. 169+30.71, LT " AHEAD SIGNAL "
- STA. 169+46.79, LT " AHEAD SIGNAL "

TEMPORARY 24 INCH STOP BAR


- STA 163+52.00, CL (11')
- STA 163+80.00, RT (11')
- STA 10+80.00, LT (10')
- STA 20+80.00, LT (10')
- STA 165+59.00, CL (11')
- STA 165+79.00, LT (11')

TRAFFIC SIGNS, TYPE A

SEE TRAFFIC SIGN SUMMARY SHEET

SQUARE TUBE SIGN POST AND ANCHOR
SEE TRAFFIC SIGN SUMMARY SHEET

REMOVING SIGNS
AS SHOWN - 10

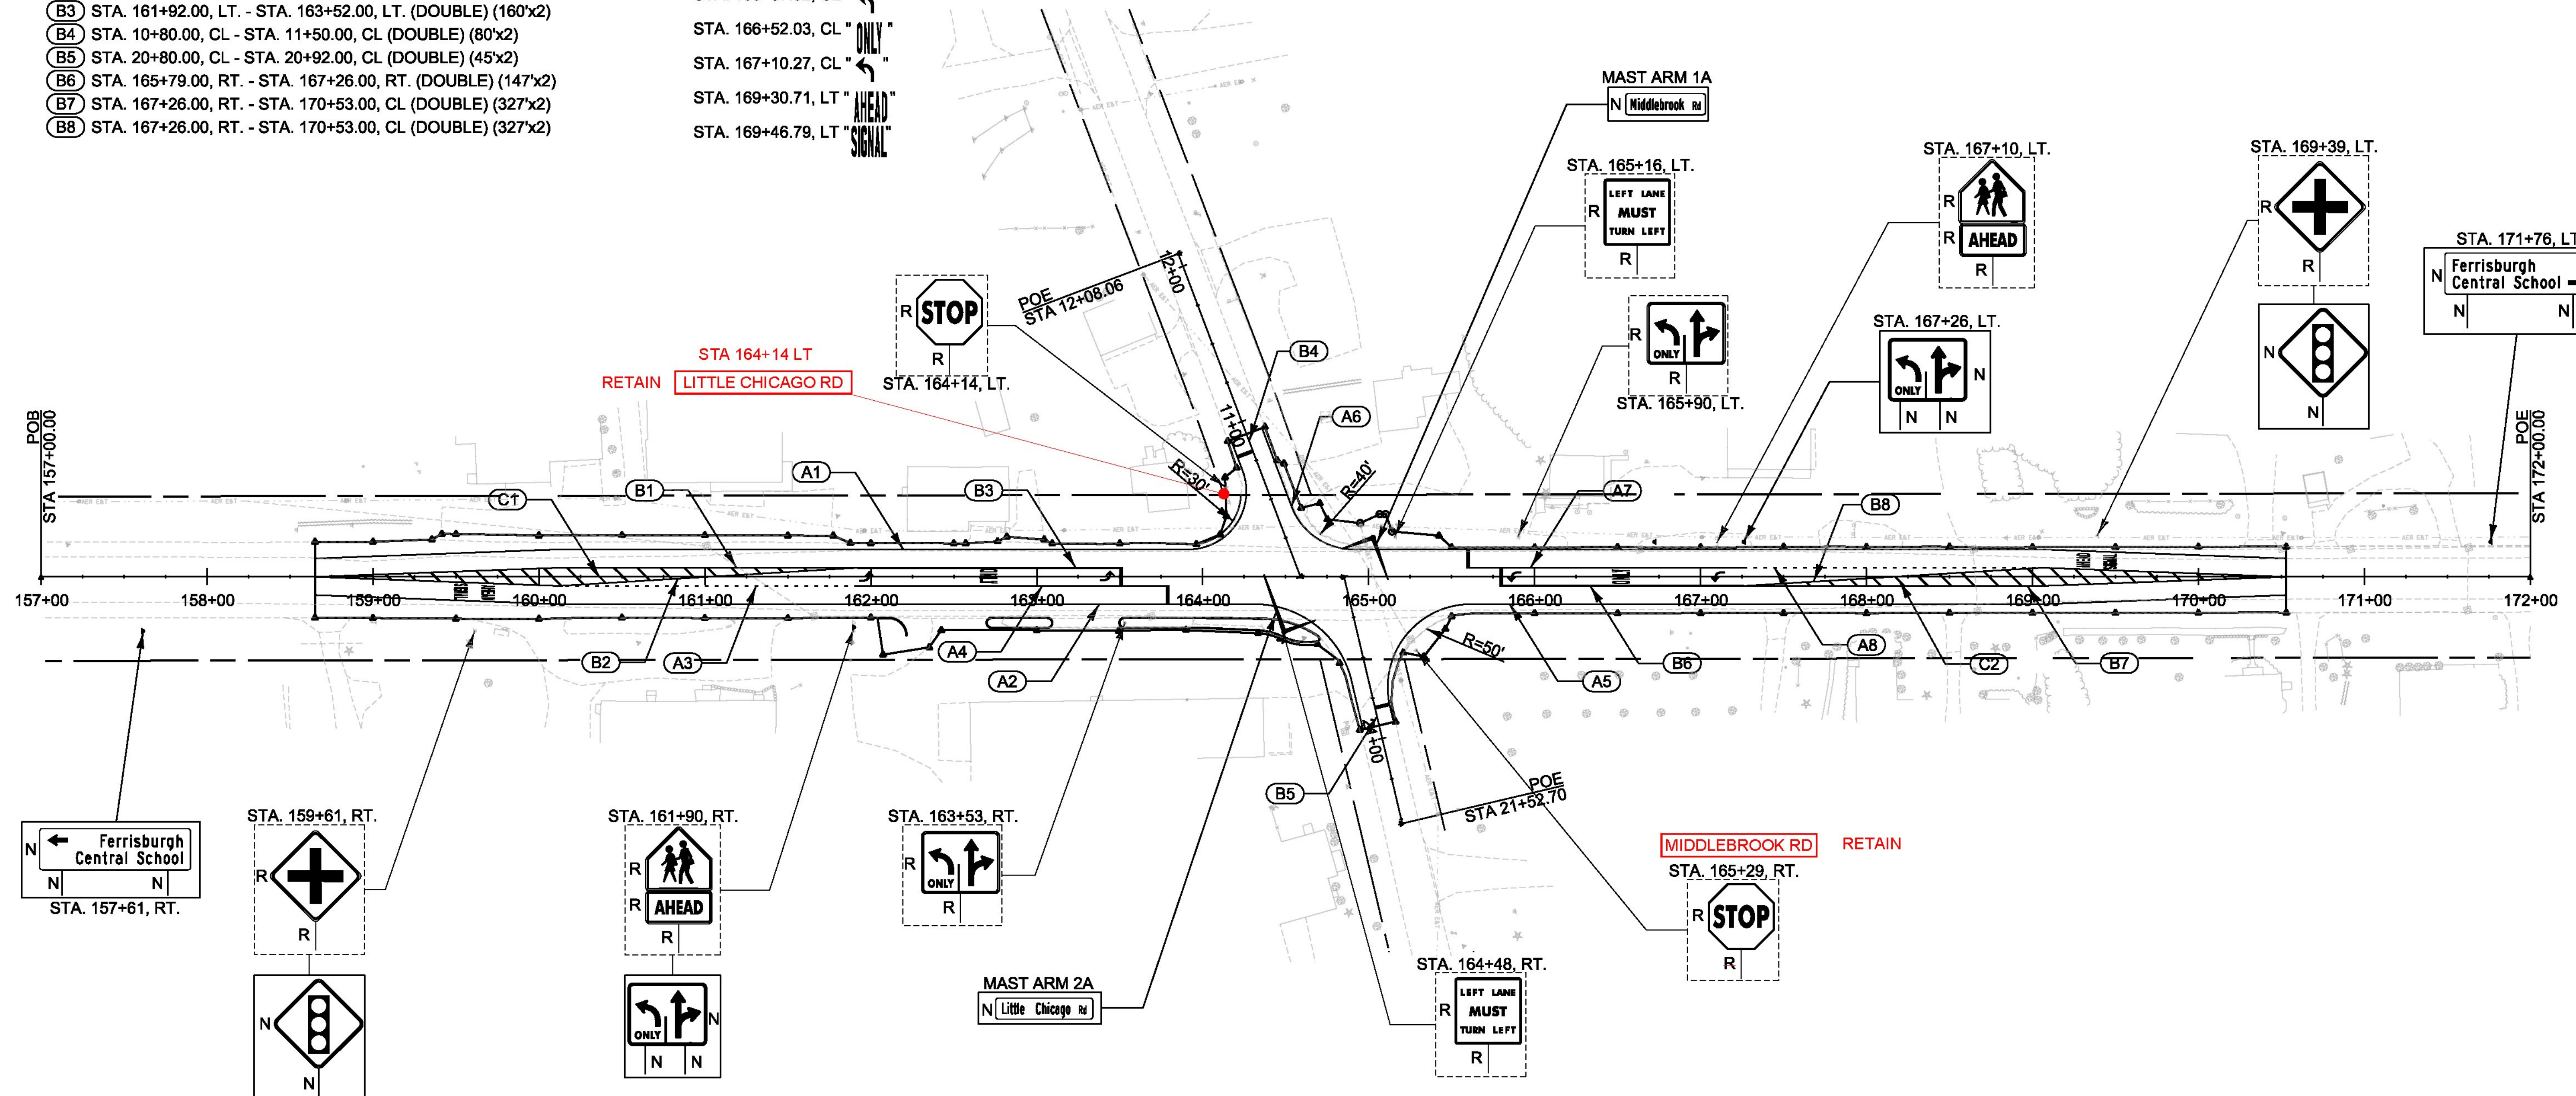

LEGEND
R REMOVE
N NEW

PROJECT NAME: FERRISBURGH	
PROJECT NUMBER: NHG SCNL(42)	
FILE NAME: +13b016nu1.dgn	PLOT DATE: 3/2/2016
PROJECT LEADER: I. DEGUTIS	DRAWN BY: I. DEGUTIS
DESIGNED BY: I. DEGUTIS	CHECKED BY: P. COBURN
TRAFFIC SIGNS SHEET	SHEET 12 OF 22

