



MAST ARM 1A  
US 7 LOOKING NORTH  
(SECTION SKEWED  
ALONG MAST ARM)

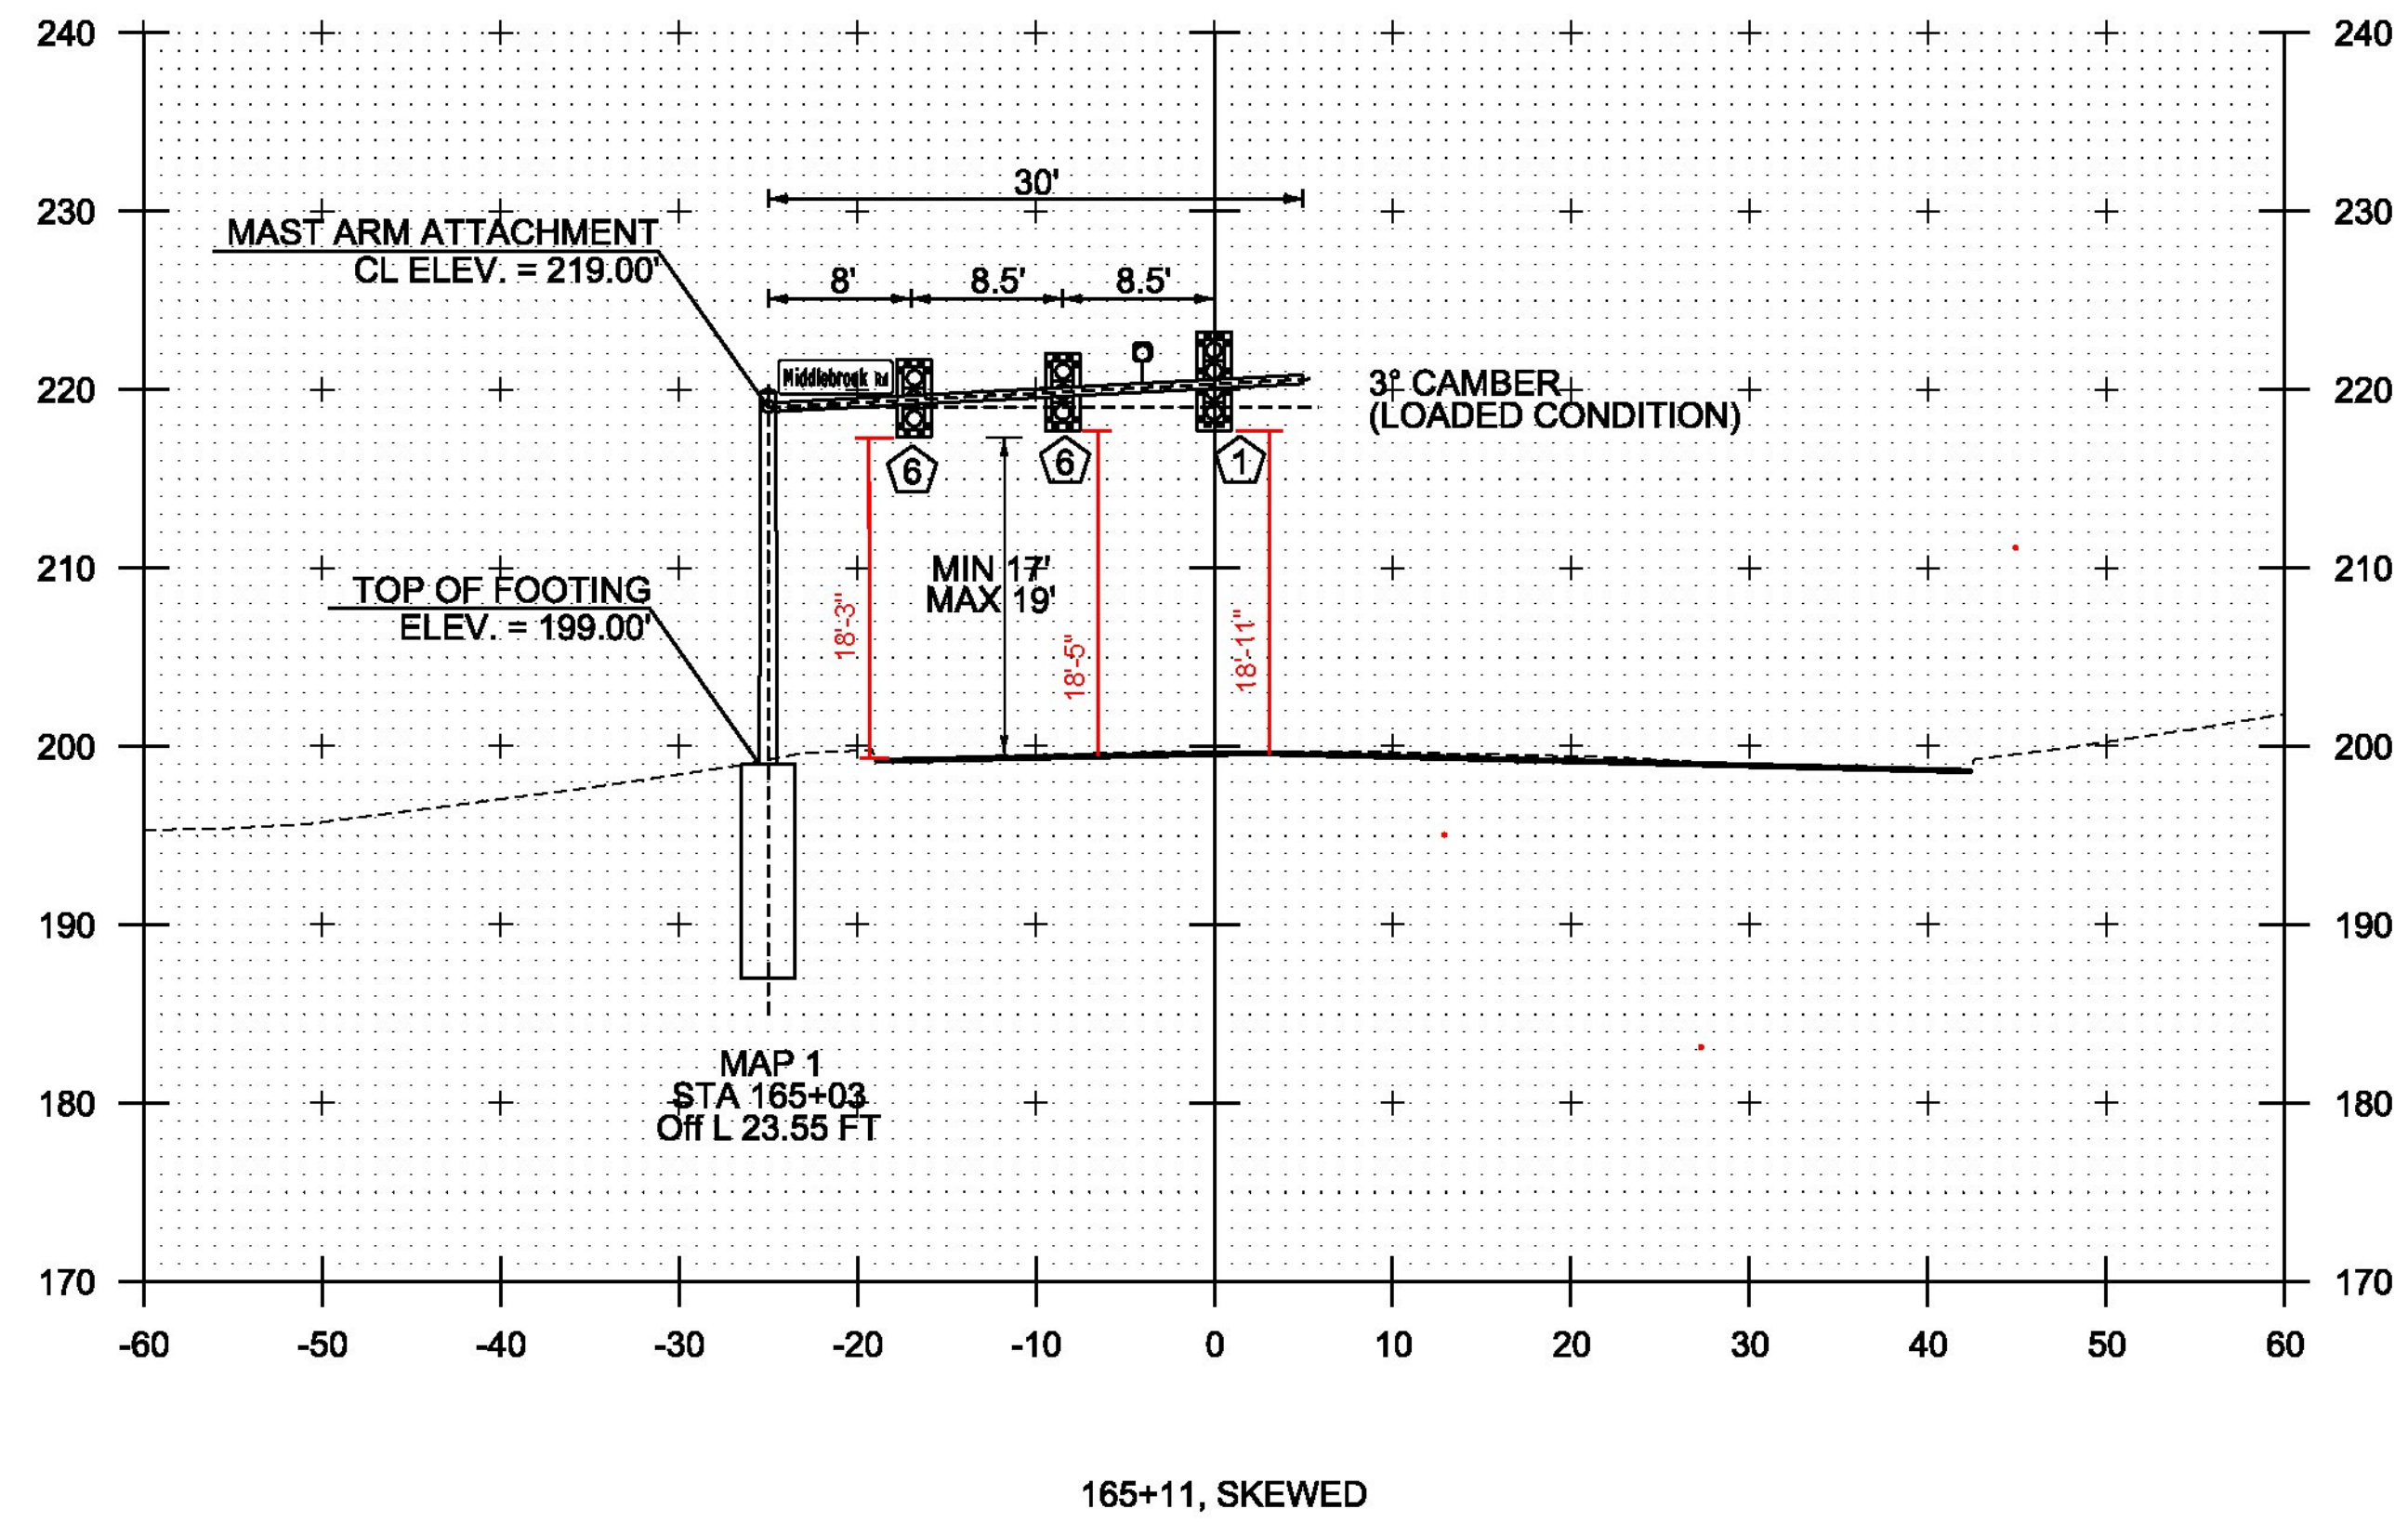

MAST ARM 1B  
TH #14 LOOKING WEST  
(SECTION SKEWED  
ALONG MAST ARM)

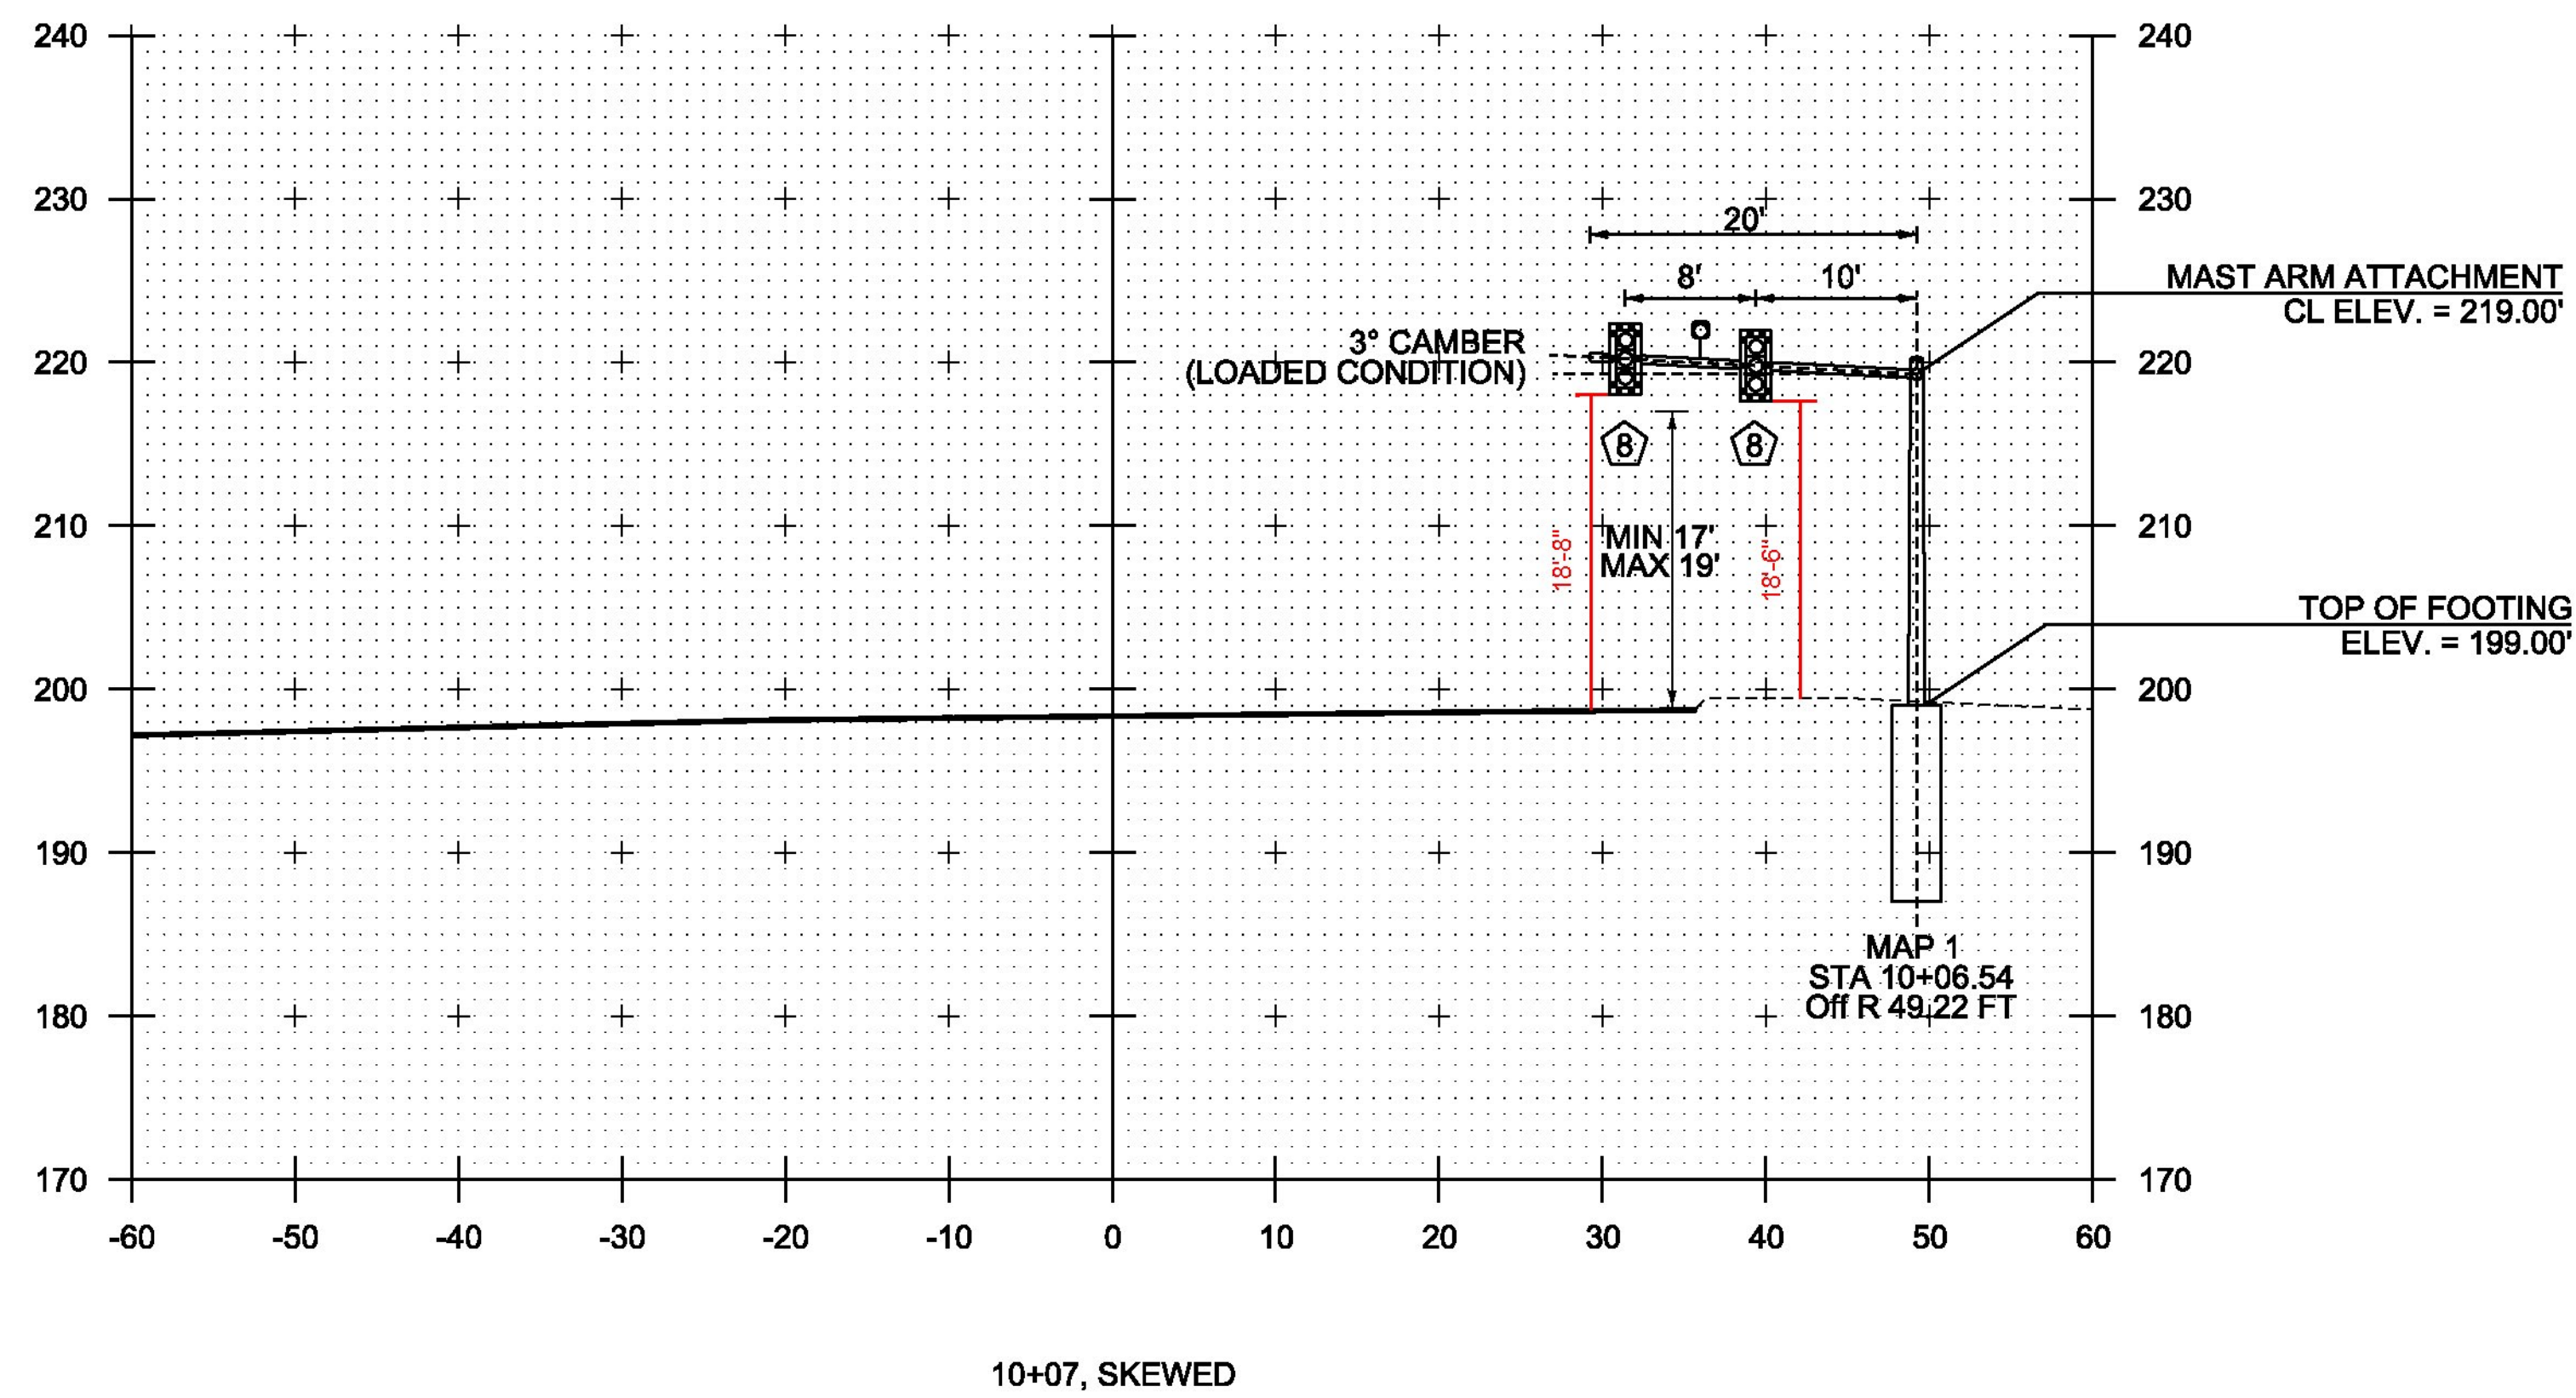

NOTES :

1. ALL MAST ARM FOUNDATIONS SHALL INCLUDE A 4" REVEAL. ELEVATIONS SHOWN IN CROSS-SECTIONS ARE APPROXIMATE FINAL GRADE ELEVATIONS FOR CONTRACTOR BIDDING PURPOSES ONLY. ACTUAL FOUNDATION ELEVATIONS SHALL BE DETERMINED BY THE CONTRACTOR PRIOR TO SUBMITTING WORKING DRAWINGS.
2. MAST ARM FOUNDATION SIZES ARE NOT TO SCALE. FOUNDATION DESIGNS SHALL BE DETERMINED BY THE CONTRACTOR IN ACCORDANCE WITH SOIL CONDITIONS AND ACTUAL MAST ARM LOADINGS TRANSMITTED TO THE TOP OF THE FOUNDATION.
3. REFER TO BORING LOG SHEET 1-2 FOR BORING INFORMATION. FOR ADDITIONAL INFORMATION, REFER TO THE GEOTECHNICAL REPORT IN THE CONTRACT DOCUMENTS.
4. SIGNAL HEADS SHALL BE MOUNTED ON THE VERTICAL CENTER OF THE MAST ARM.

PROJECT NAME: FERRISBURGH  
PROJECT NUMBER: NHG SCNL(42)

FILE NAME: +13b016frm.dgn PLOT DATE: 3/2/2016  
PROJECT LEADER: I. DEGUTIS DRAWN BY: K. RECORD  
DESIGNED BY: K. RECORD CHECKED BY: I. DEGUTIS  
MAST ARM CROSS SECTION SHEET 1 SHEET 18 OF 22