



MAST ARM 2A
US 7 LOOKING NORTH
(SECTION SKEWED
ALONG MAST ARM)

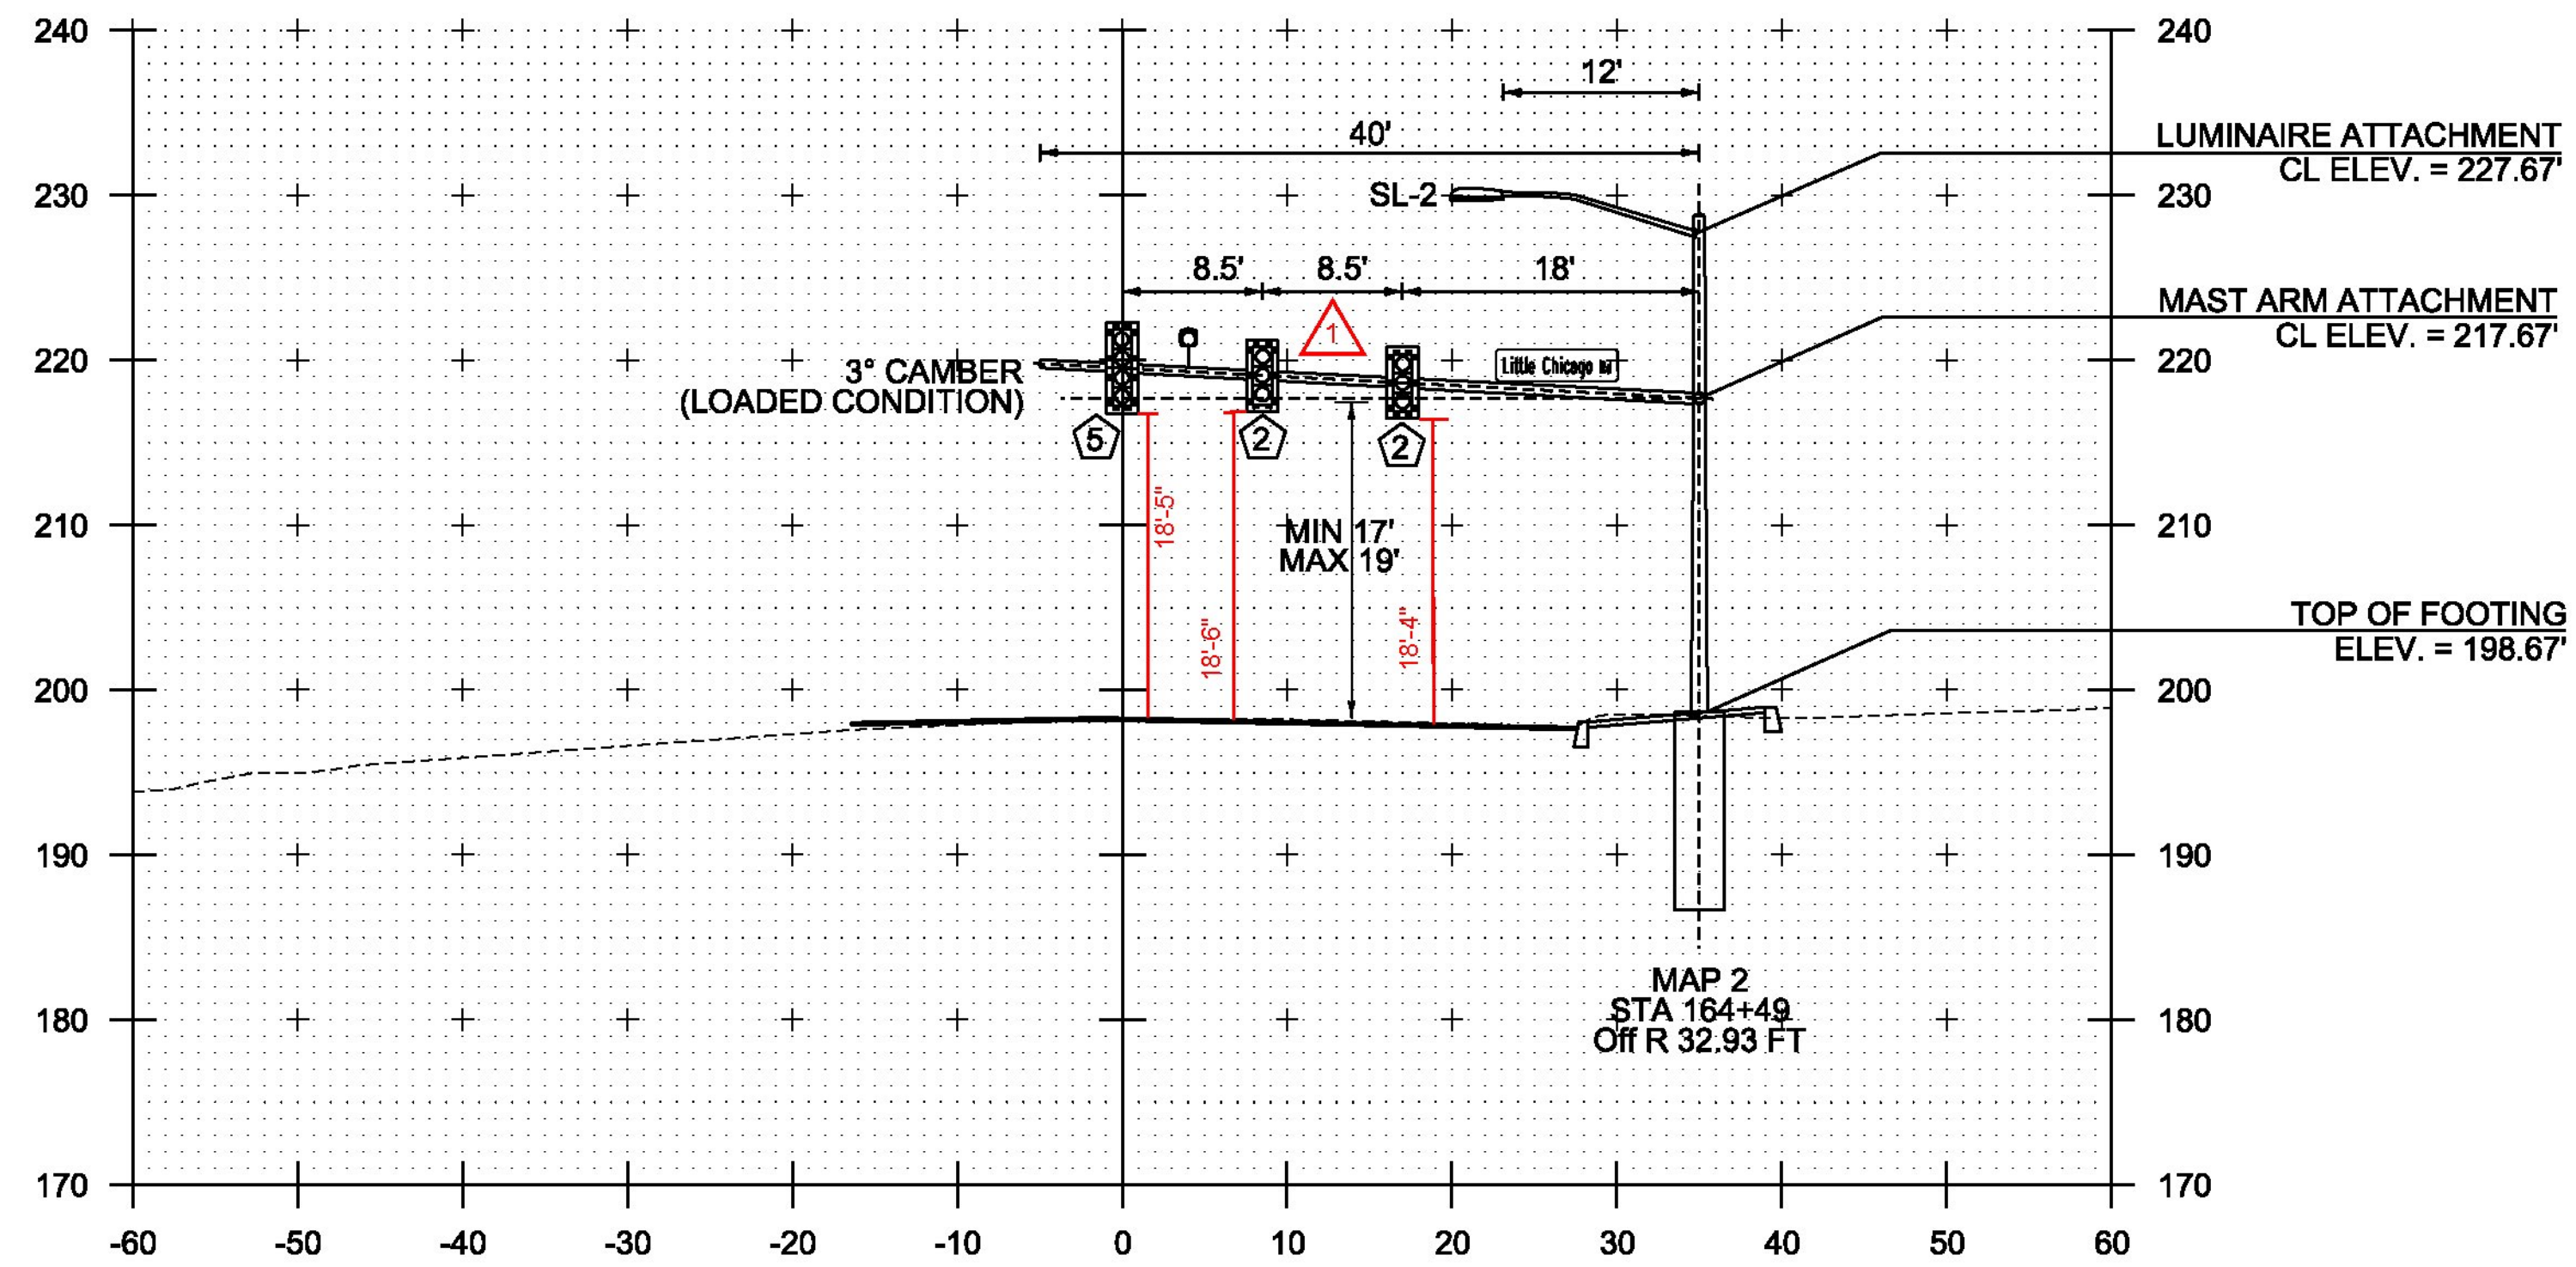

164+37, SKEWED

MAST ARM 2B
TH #5 LOOKING EAST
(SECTION SKEWED
ALONG MAST ARM)

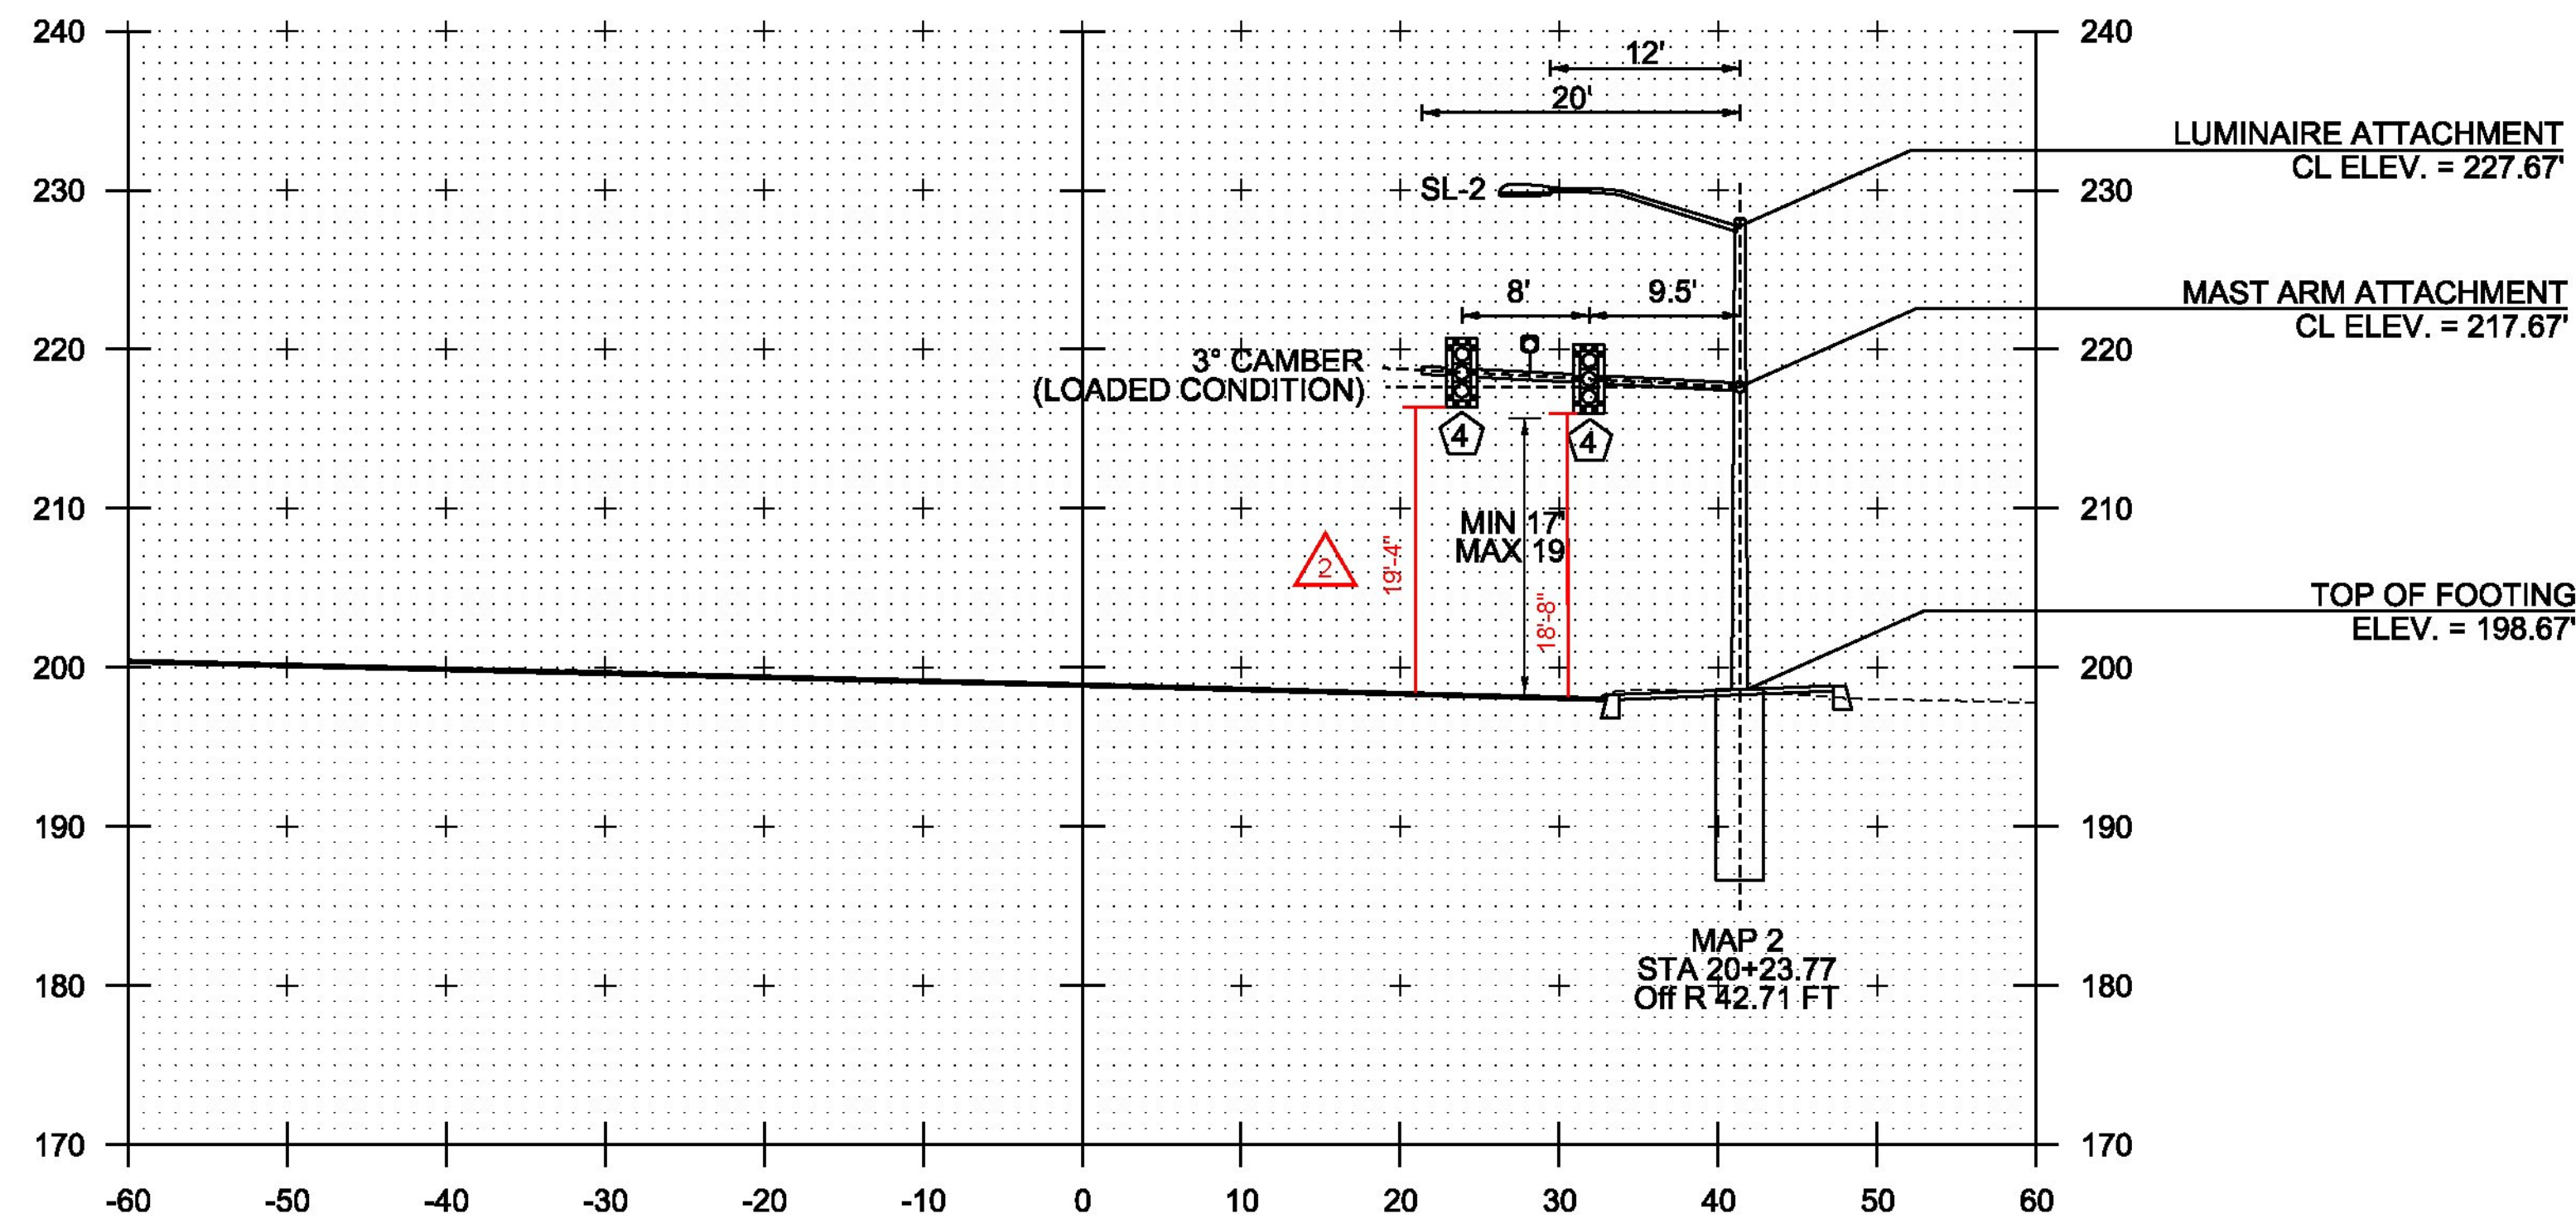

20+19, SKEWED

1 SIGNAL HEADS 1 & 2 ON MA 2A MOVED 3' TO THE EAST.
PER PM (IAN DEGUTIS) & RE

2 VERBALLY OK'D BY IAN DEGUTIS PRIOR TO INSPECTION ON 10/25/2016

NOTES :

1. ALL MAST ARM FOUNDATIONS SHALL INCLUDE A 4" REVEAL. ELEVATIONS SHOWN IN CROSS-SECTIONS ARE APPROXIMATE FINAL GRADE ELEVATIONS FOR CONTRACTOR BIDDING PURPOSES ONLY. ACTUAL FOUNDATION ELEVATIONS SHALL BE DETERMINED BY THE CONTRACTOR PRIOR TO SUBMITTING WORKING DRAWINGS.
2. MAST ARM FOUNDATION SIZES ARE NOT TO SCALE. FOUNDATION DESIGNS SHALL BE DETERMINED BY THE CONTRACTOR IN ACCORDANCE WITH SOIL CONDITIONS AND ACTUAL MAST ARM LOADINGS TRANSMITTED TO THE TOP OF THE FOUNDATION.
3. REFER TO BORING LOG SHEET 1-2 FOR BORING INFORMATION. FOR ADDITIONAL INFORMATION, REFER TO THE GEOTECHNICAL REPORT IN THE CONTRACT DOCUMENTS.
4. SIGNAL HEADS SHALL BE MOUNTED ON THE VERTICAL CENTER OF THE MAST ARM.

PROJECT NAME: FERRISBURGH
PROJECT NUMBER: NHG SCNL(42)

FILE NAME: +13b016frm.dgn PLOT DATE: 3/2/2016
PROJECT LEADER: I. DEGUTIS DRAWN BY: K. RECORD
DESIGNED BY: K. RECORD CHECKED BY: I. DEGUTIS
MAST ARM CROSS SECTION SHEET 2 SHEET 19 OF 22