


STATE OF VERMONT AGENCY OF TRANSPORTATION

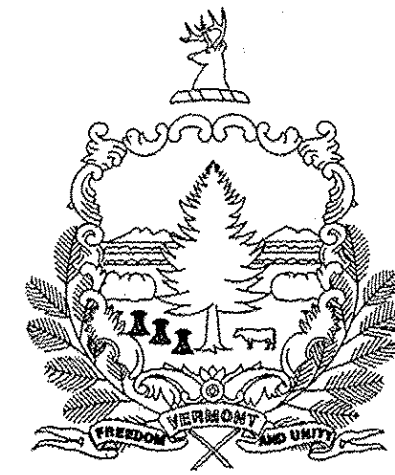

PROPOSED IMPROVEMENT TOWN OF MORETOWN COUNTY OF WASHINGTON US ROUTE 2 & VT ROUTE 100 MINOR ARTERIAL


PROJECT LOCATION: AT THE INTERSECTION OF US-2 AND VT-100 IN THE TOWN OF MORETOWN
PROJECT INFORMATION: THE PROJECT SHALL CONSIST OF THE INSTALLATION OF A TRAFFIC CONTROL SIGNAL SYSTEM AND RELATED IMPROVEMENTS INCLUDING SIGNING AND STRIPING AND A DRIVEWAY RELOCATION.

INDEX OF SHEETS

1	TITLE SHEET
2	CONVENTIONAL SYMBOLOLOGY LEGEND
3	QUANTITY SHEET
4	TIE SHEET
5	RIGHT OF WAY LAYOUT SHEET
6	RIGHT OF WAY DETAIL SHEET
7	TRAFFIC CONTROL PLAN SHEET
8	LAYOUT SHEET
9	DRIVE RELOCATION TYPICAL SECTIONS
10	TRAFFIC SIGNAL SHEET
11	TRAFFIC SIGN SUMMARY SHEET
12	TRAFFIC SIGNAL SYSTEM NOTES
13	STREET LIGHTING GENERAL NOTES

STANDARDS LIST

B-71	STANDARD FOR RESIDENTIAL AND COMMERCIAL DRIVES	7/8/2005
E-121	STANDARD SIGN PLACEMENT - CONVENTIONAL ROAD	8/8/1995
E-144	REGULATORY SIGN DETAILS	3/29/1999
E-171A	TRAFFIC CONTROL SIGNALS GENERAL NOTES & DETAILS	8/9/1995
E-171B	TRAFFIC CONTROL SIGNALS MISC. DETAILS	8/9/1995
E-175	POWER DROP STANCHIONS	6/8/2009
E-193	PAVEMENT MARKING DETAILS	8/18/1995
T-1	TRAFFIC CONTROL GENERAL NOTES	8/6/2012
T-10	CONVENTIONAL ROADS CONSTRUCTION APPROACH SIGNING	8/6/2012
T-30	CONSTRUCTION SIGN DETAILS	8/6/2012
T-45	SQUARE TUBE SIGN POST AND ANCHOR	1/2/2013

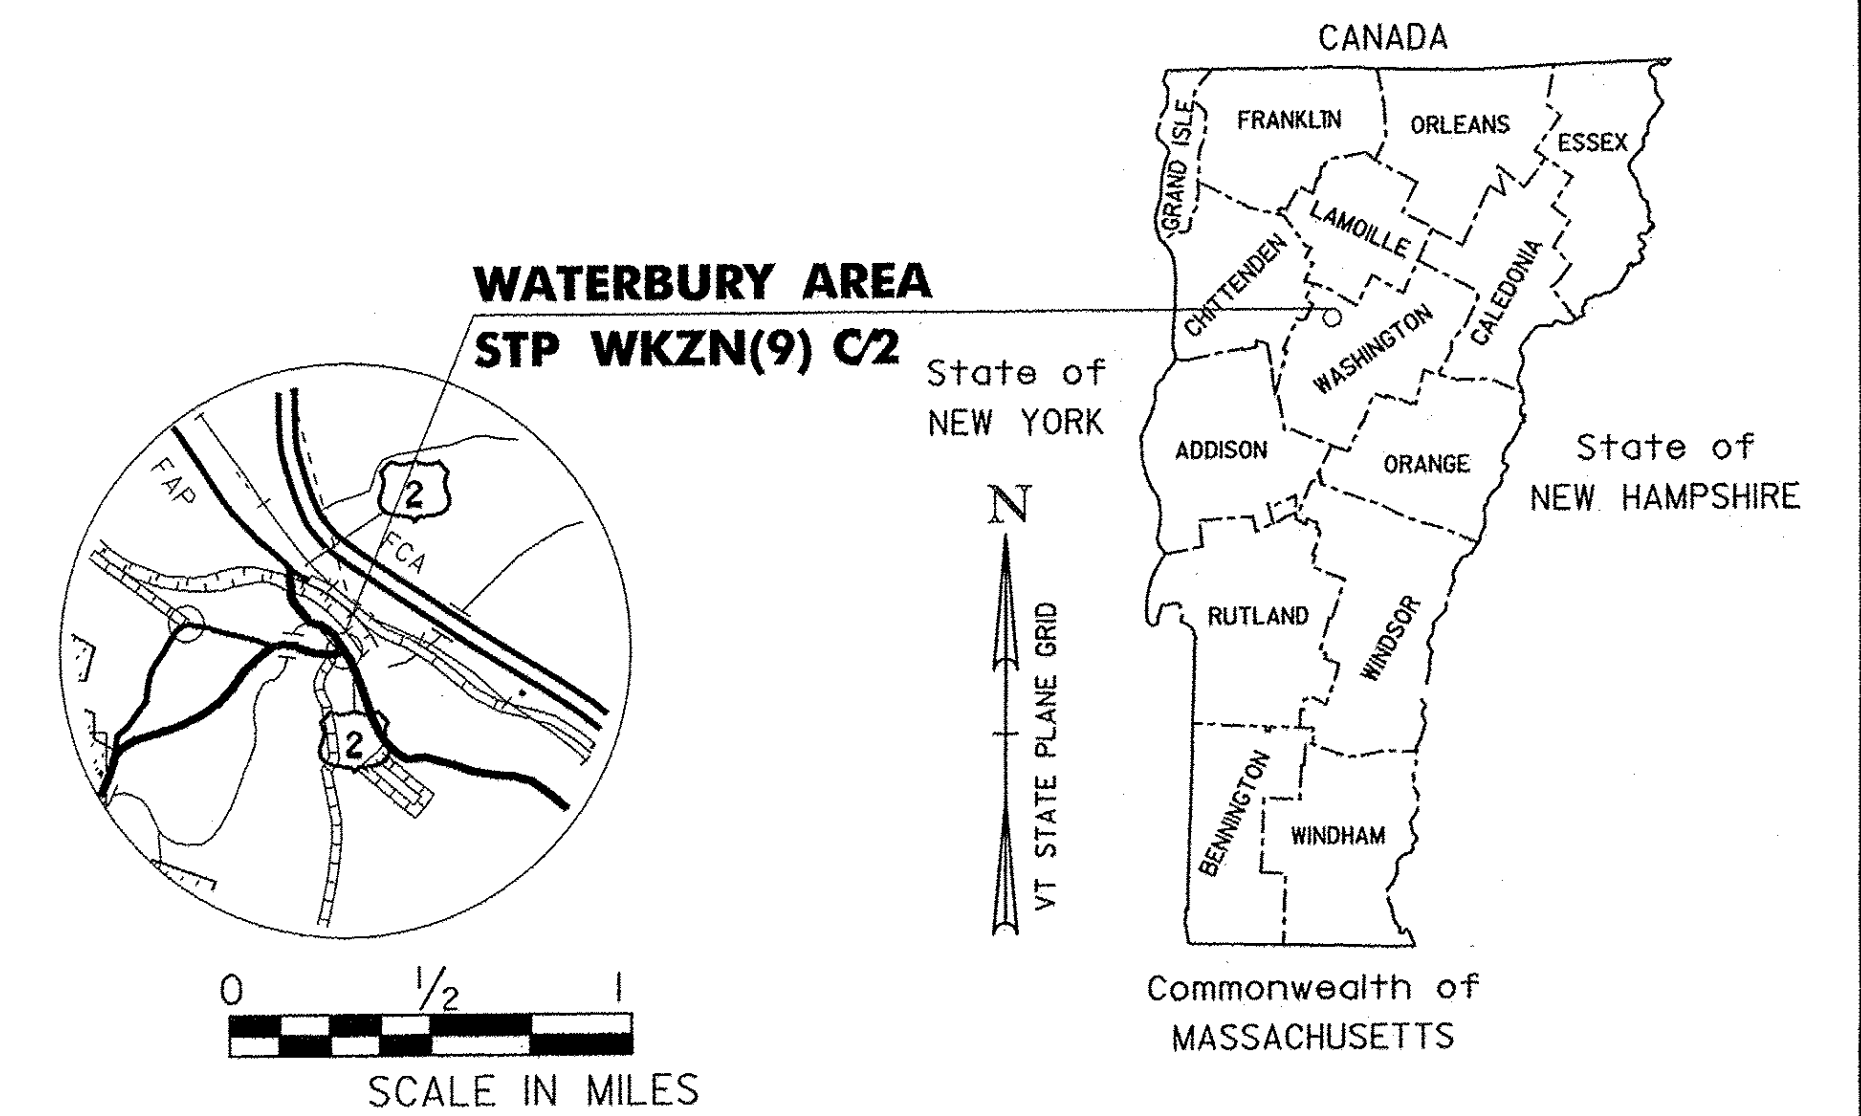


RECORD PLANS	
CONTRACTOR:	DON WESTON EXCAVATING, INC. - WILLISTON, VT
RESIDENT ENGINEER:	TOM MANCINI
CONSTRUCTION BEGAN:	MARCH 16, 2015
CONSTRUCTION COMPLETE:	MAY 6, 2015
RECORD PLANS BY:	TOM MANCINI & CRAIG PIERCE
I HEREBY CERTIFY THAT ALL THE CONSTRUCTION REQUIRED BY THIS SET OF DRAWINGS HAS BEEN ACCOMPLISHED AS INDICATED HEREIN.	
BY:	<i>Tom Mancini</i> RESIDENT ENGINEER
DATE:	4/8/16
NOTE: Any further information concerning final quantities, amounts or other details relative to this project may be found at Central Files in the electronic archives.	

TRAFFIC DATA: US-2 & VT-100										
APPROACH	AADT		DHV		% T		% D		ADTT	
	2014	2024	2014	2024	2014	2024	2014	2024	2014	2024
US-2 EAST	3,800	3,900	430	440	1.3	1.7	50	50	140	190
US-2 WEST	8,600	8,800	960	980	1.1	1.5	54	54	330	460
VT-100 SOUTH	5,800	5,900	660	670	1.0	1.3	56	56	240	330

CONSTRUCTION IS TO BE CARRIED ON IN ACCORDANCE WITH THESE PLANS AND THE STANDARD SPECIFICATIONS FOR CONSTRUCTION DATED 2011, AS APPROVED BY THE FEDERAL HIGHWAY ADMINISTRATION ON JULY 20, 2011 FOR USE ON THIS PROJECT, INCLUDING ALL SUBSEQUENT REVISIONS AND SUCH REVISED SPECIFICATIONS AND SPECIAL PROVISIONS AS ARE INCORPORATED IN THESE PLANS.

QUALITY ASSURANCE PROGRAM : LEVEL 3	
SURVEYED BY :	VTRANS
SURVEYED DATE :	2014
DATUM	
VERTICAL	NAVD 88
HORIZONTAL	NAD 83 (2011)

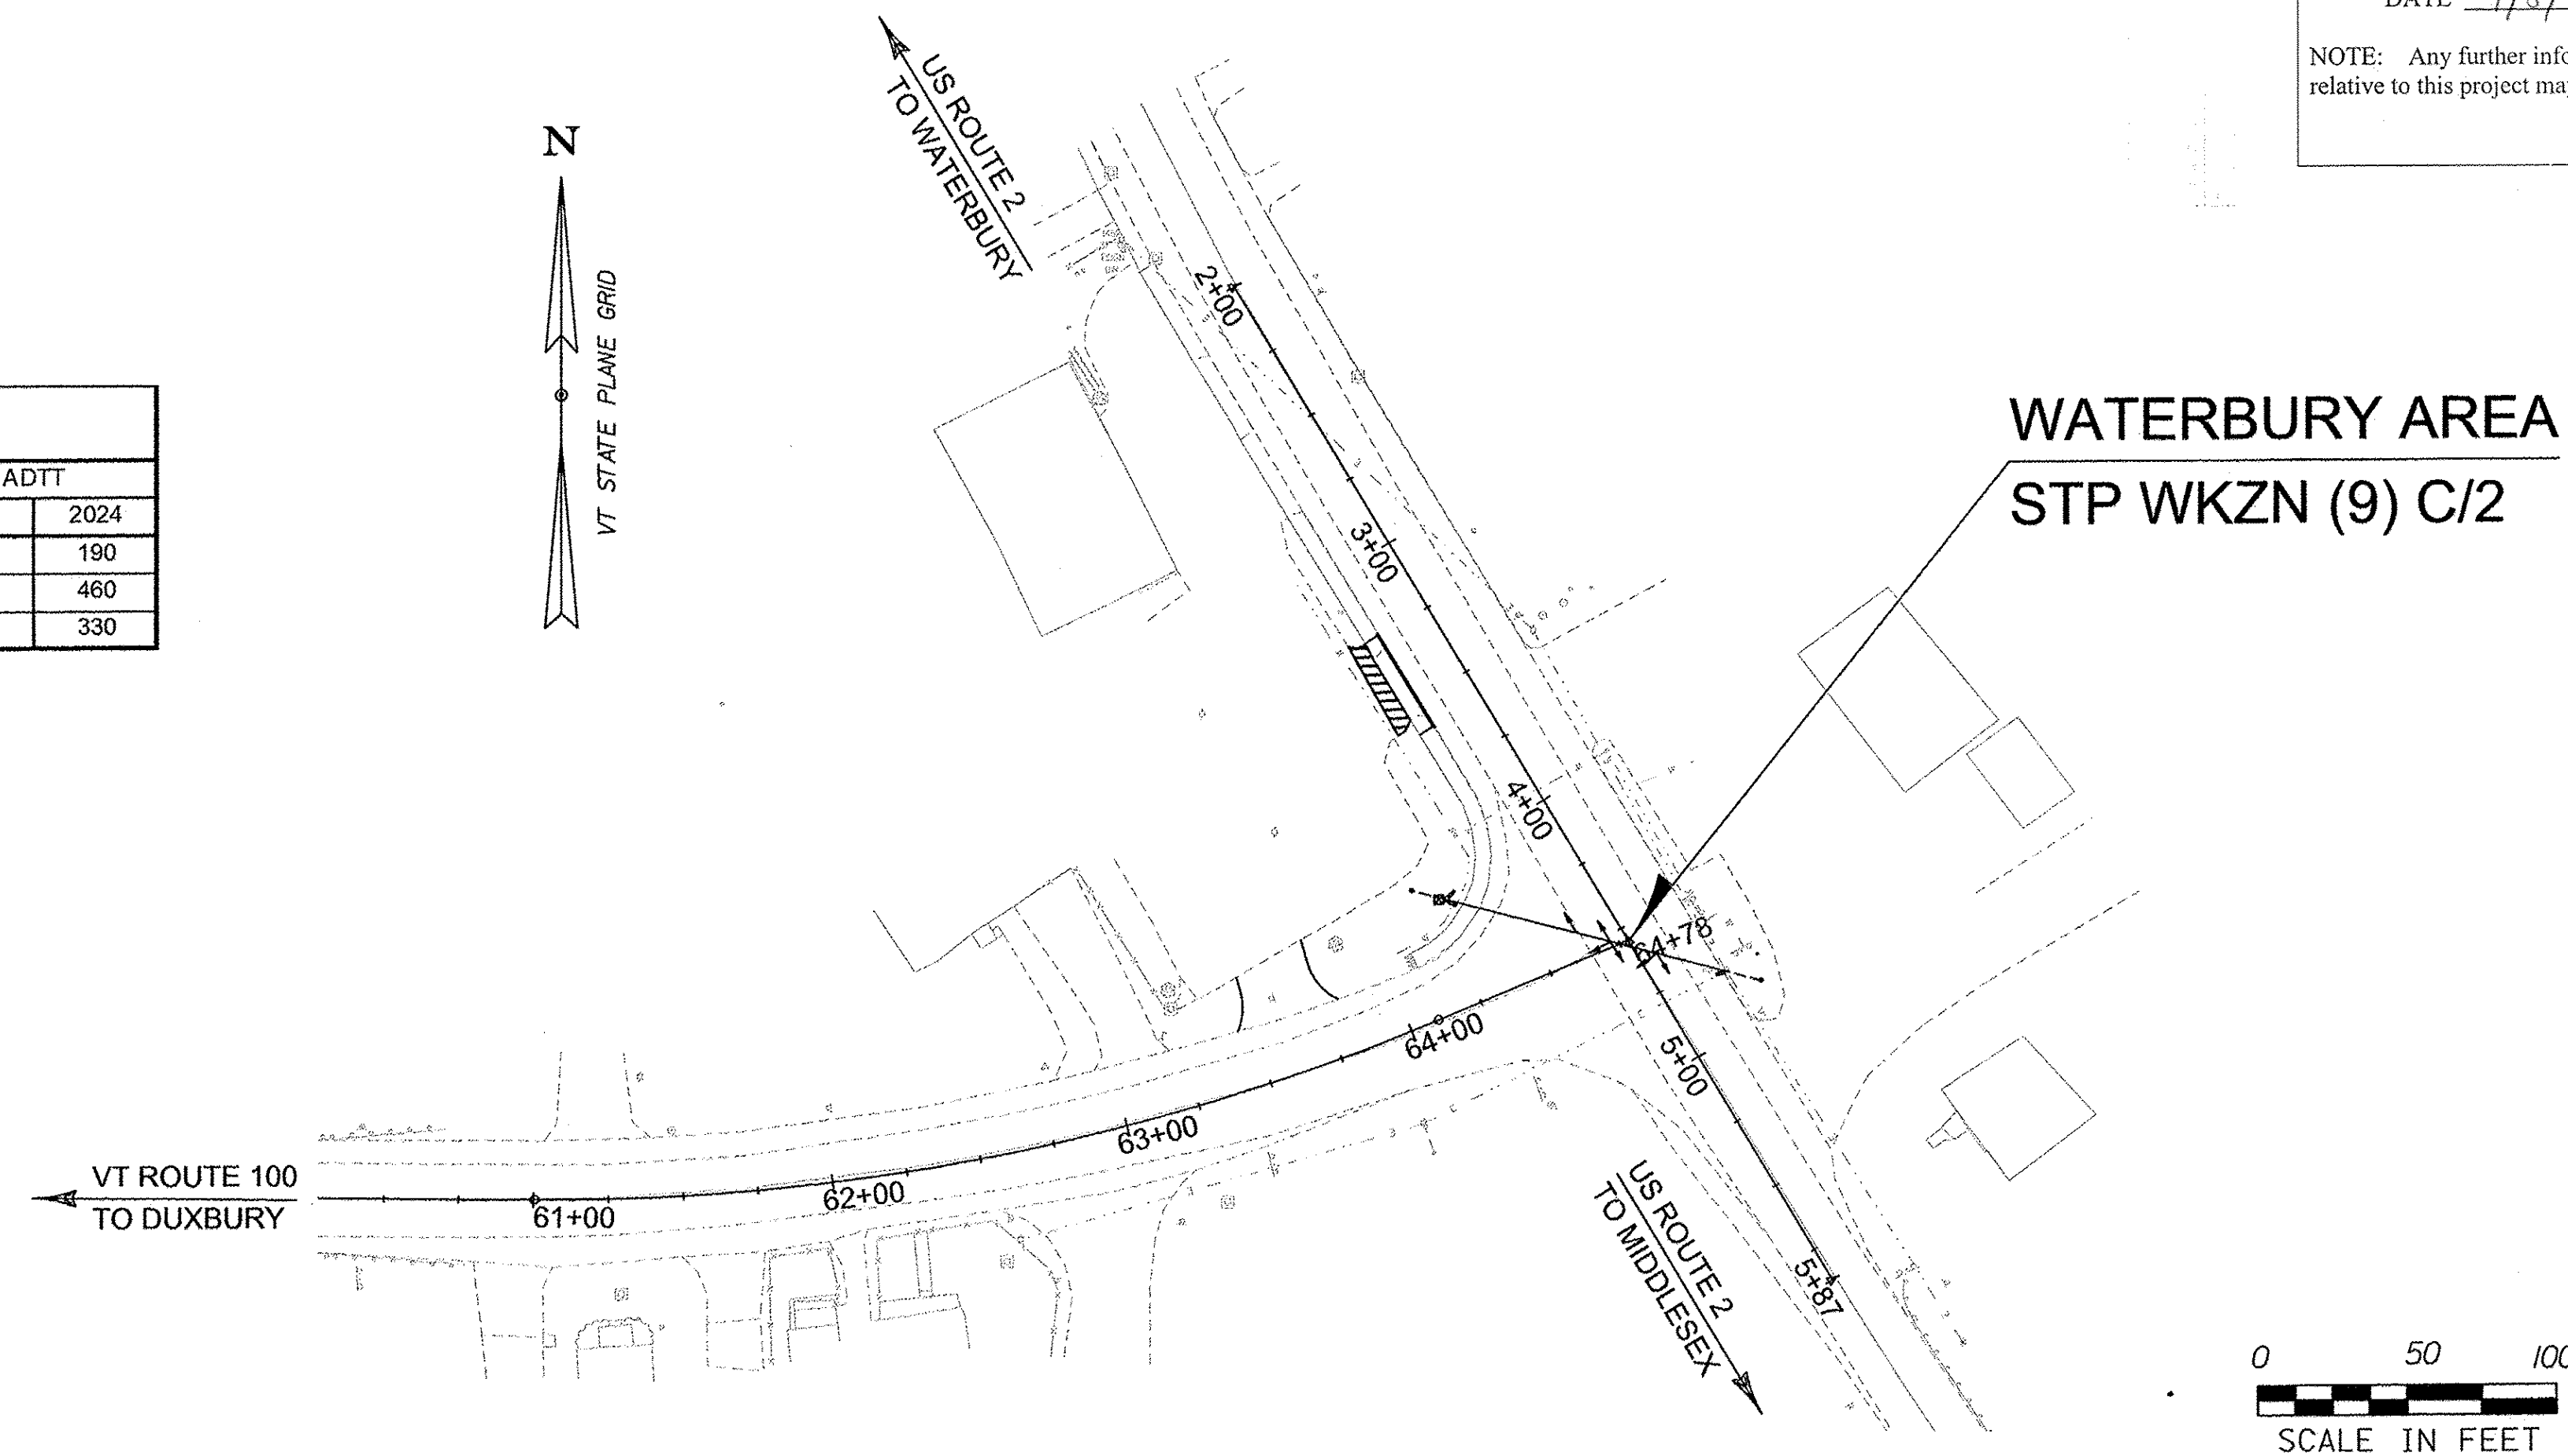

DIRECTOR OF PROJECT DELIVERY	
APPROVED:	<i>[Signature]</i> DATE 10/21/2014
PROJECT MANAGER : PATRICIA COBURN, PE	
PROJECT NAME :	WATERBURY AREA
PROJECT NUMBER :	STP WKZN (9) C/2
SHEET 1 OF 13 SHEETS	

GENERAL INFORMATION

SYMBOLGY LEGEND NOTE

THE SYMBOLGY ON THIS SHEET IS INTENDED TO COVER STANDARD CONVENTIONAL SYMBOLGY. THE SYMBOLGY IS USED FOR EXISTING & PROPOSED FEATURES WITH HEAVIER LINEWEIGHT, IN COMBINATION WITH PROJECT ANNOTATION, AS NOTED ON PROJECT PLAN SHEETS. THIS LEGEND SHEET COVERS THE BASICS. SYMBOLGY ON PLANS MAY VARY, PLAN ANNOTATIONS AND NOTES SHOULD BE USED TO CLARIFY AS NEEDED.

R.O.W. ABBREVIATIONS (CODES) & SYMBOLS

POINT	CODE	DESCRIPTION
	CH	CHANNEL EASEMENT
	CONST	CONSTRUCTION EASEMENT
	CUL	CULVERT EASEMENT
	D&C	DISCONNECT & CONNECT
	DIT	DITCH EASEMENT
	DR	DRAINAGE EASEMENT
	DRIVE	DRIVEWAY EASEMENT
	EC	EROSION CONTROL
	I&M	INSTALL & MAINTAIN EASEMENT
	LAND	LANDSCAPE EASEMENT
	R&RES	REMOVE & RESET
	R&REP	REMOVE & REPLACE
	SR	SLOPE RIGHT
	UE	UTILITY EASEMENT
	(P)	PERMANENT EASEMENT
	(T)	TEMPORARY EASEMENT
	■	BNDNS BOUND SET
	□	BNDNS BOUND TO BE SET
	●	IPNS IRON PIN SET
	⊙	IPNS IRON PIN TO BE SET
	⊗	CALC EXISTING ROW POINT
	○	PROW PROPOSED ROW POINT
	[LENGTH]	LENGTH CARRIED ON NEXT SHEET

COMMON TOPOGRAPHIC POINT SYMBOLS

POINT	CODE	DESCRIPTION
⊕	APL	BOUND APPARENT LOCATION
□	BM	BENCH MARK
□	BND	BOUND
□	CB	CATCH BASIN
⊕	COMB	COMBINATION POLE
□	DITHR	DROP INLET THROATED DNC
⊕	EL	ELECTRIC POWER POLE
⊙	FPOLE	FLAGPOLE
○	GASFIL	GAS FILLER
○	GP	GUIDE POST
×	GSO	GAS SHUT OFF
⊙	GUY	GUY POLE
⊙	GUYW	GUY WIRE
×	GV	GATE VALUE
⊙	H	TREE HARDWOOD
△	HCTRL	CONTROL HORIZONTAL
△	HVCTRL	CONTROL HORIZ. & VERTICAL
◇	HYD	HYDRANT
⊙	IP	IRON PIN
⊙	IPIPE	IRON PIPE
⊕	LI	LIGHT - STREET OR YARD
⊕	MB	MAILBOX
○	MH	MANHOLE (MH)
□	MM	MILE MARKER
⊙	PM	PARKING METER
□	PMK	PROJECT MARKER
⊙	POST	POST STONE/WOOD
⊕	RRSIG	RAILROAD SIGNAL
⊕	RRSL	RAILROAD SWITCH LEVER
⊕	S	TREE SOFTWOOD
⊕	SAT	SATELLITE DISH
⊕	SHRUB	SHRUB
⊕	SIGN	SIGN
⊕	STUMP	STUMP
⊕	TEL	TELEPHONE POLE
⊕	TIE	TIE
⊕	TSIGN	SIGN W/DOUBLE POST
⊕	VCTRL	CONTROL VERTICAL
⊕	WELL	WELL
×	WSO	WATER SHUT OFF

THESE ARE COMMON VAOT SURVEY POINT SYMBOLS FOR EXISTING FEATURES, ALSO USED FOR PROPOSED FEATURES WITH HEAVIER LINEWEIGHT, IN COMBINATION WITH PROPOSED ANNOTATION.

PROPOSED GEOMETRY CODES

CODE	DESCRIPTION
PC	POINT OF CURVATURE
PI	POINT OF INTERSECTION
CC	CENTER OF CURVE
PT	POINT OF TANGENCY
PCC	POINT OF COMPOUND CURVE
PRC	POINT OF REVERSE CURVE
POB	POINT OF BEGINNING
POE	POINT OF ENDING
STA	STATION PREFIX
AH	AHEAD STATION SUFFIX
BK	BACK STATION SUFFIX
D	CURVE DEGREE OF (100FT)
R	CURVE RADUIS OF
T	CURVE TANGENT LENGTH
L	CURVE LENGTH OF
E	CURVE EXTERNAL DISTANCE

UTILITY SYMBOLGY

UNDERGROUND UTILITIES	
— UT —	TELEPHONE
— UE —	ELECTRIC
— UC —	CABLE (TV)
— UEC —	ELECTRIC+CABLE
— UET —	ELECTRIC+TELEPHONE
— UCT —	CABLE+TELEPHONE
— UECT —	ELECTRIC+CABLE+TELEP.
— G —	GAS LINE
— W —	WATER LINE
— S —	SANITARY SEWER (SEPTIC)

ABOVE GROUND UTILITIES (AERIAL)	
— T —	TELEPHONE
— E —	ELECTRIC
— C —	CABLE (TV)
— EC —	ELECTRIC+CABLE
— ET —	ELECTRIC+TELEPHONE
— AER E&T —	ELECTRIC+TELEPHONE
— CT —	CABLE+TELEPHONE
— ECT —	ELECTRIC+CABLE+TELEP.
—	UTILITY POLE GUY WIRE

PROJECT CONSTRUCTION SYMBOLGY

PROJECT DESIGN & LAYOUT SYMBOLGY	
— CZ —	CLEAR ZONE
—	PLAN LAYOUT MATCHLINE

PROJECT CONSTRUCTION FEATURES

△	TOP OF CUT SLOPE
○	TOE OF FILL SLOPE
⊕	STONE FILL
⊕	BOTTOM OF DITCH L
---	CULVERT PROPOSED
---	STRUCTURE SUBSURFACE
PDF	PROJECT DEMARCATION FENCE
B F	BARRIER FENCE
XXXXXXXXXXXXXXXXXXXX	TREE PROTECTION ZONE (TPZ)
////	STRIPING LINE REMOVAL
~~~~	SHEET PILES

**CONVENTIONAL BOUNDARY SYMBOLGY**

BOUNDARY LINES	
— TOWN LINE —	TOWN BOUNDARY LINE
— COUNTY LINE —	COUNTY BOUNDARY LINE
— STATE LINE —	STATE BOUNDARY LINE
—	PROPOSED STATE L.A.R.O.W.
—	PROPOSED STATE R.O.W.
—	STATE ROW (LIMITED ACCESS)
—	STATE ROW
—	TOWN ROW
—	PERMANENT EASEMENT LINE (P)
—	TEMPORARY EASEMENT LINE (T)
+	SURVEY LINE
P	PROPERTY LINE (P/L)
SR	SLOPE RIGHTS
6f	6F PROPERTY BOUNDARY
4f	4F PROPERTY BOUNDARY
HAZ	HAZARDOUS WASTE

**EPSC LAYOUT PLAN SYMBOLGY**

EPSC MEASURES	
○	FILTER CURTAIN
—	SILT FENCE
—	SILT FENCE WOVEN WIRE
—	CHECK DAM
■	DISTURBED AREAS REQUIRING RE-VEGETATION
⊗	EROSION MATTING

**ENVIRONMENTAL RESOURCES**

—	WETLAND BOUNDARY
---	RIPARIAN BUFFER ZONE
---	WETLAND BUFFER ZONE
---	SOIL TYPE BOUNDARY
---	THREATENED & ENDANGERED SPECIES
HAZ	HAZARDOUS WASTE AREA
AG	AGRICULTURAL LAND
HABITAT	FISH & WILDLIFE HABITAT
FLOOD PLAN	FLOOD PLAN
OHW	ORDINARY HIGH WATER (OHW)
—	STORM WATER
---	USDA FOREST SERVICE LANDS
---	WILDLIFE HABITAT SUIT/CONN

**ARCHEOLOGICAL & HISTORIC**

— ARCH —	ARCHEOLOGICAL BOUNDARY
— HISTORIC DIST —	HISTORIC DISTRICT BOUNDARY
— HISTORIC —	HISTORIC AREA
(H)	HISTORIC STRUCTURE

**CONVENTIONAL TOPOGRAPHIC SYMBOLGY**

EXISTING FEATURES	
---	ROAD EDGE PAVEMENT
---	ROAD EDGE GRAVEL
---	DRIVEWAY EDGE
---	DITCH
---	FOUNDATION
×	FENCE (EXISTING)
□	FENCE WOOD POST
○	FENCE STEEL POST
---	GARDEN
○	ROAD GUARDRAIL
	RAILROAD TRACKS
---	CULVERT (EXISTING)
○	STONE WALL
---	WALL
---	WOOD LINE
---	BRUSH LINE
---	HEDGE
---	BODY OF WATER EDGE
---	LEDGE EXPOSED

PROJECT NAME: WATERBURY  
 PROJECT NUMBER: NHG SGNL(43)  
 FILE NAME: +13b018frm.dgn PLOT DATE: 12/31/2013  
 PROJECT LEADER: P. COBURN DRAWN BY: I. DEGUTIS  
 DESIGNED BY: I. DEGUTIS CHECKED BY: M. LACROIX  
 CONVENTIONAL SYMBOLGY LEGEND SHEET SHEET 2 OF 17



STATE OF VERMONT  
AGENCY OF TRANSPORTATION  
MATERIALS & RESEARCH SECTION  
SUBSURFACE INFORMATION

**BORING LOG**

**WATERBURY  
NHG SGNL(43)  
I-89 & VT-100 EXIT #10**

Boring No.: **B-101**  
Page No.: 1 of 1  
Pin No.: 13B018  
Checked By: LAR

Boring Crew: **GARROW, SALISBURY, DAIGNEAULT**  
Date Started: 3/25/13 Date Finished: 3/25/13  
VTSPG NAD83: N 672184.97 ft E 1575013.29 ft  
Station: 26+44 Offset: -3.00  
Ground Elevation: 499.84 ft

Casing Type: **WB** Sampler: **SS**  
I.D.: 4 in 1.5 in  
Hammer Wt: N.A. 140 lb.  
Hammer Fall: N.A. 30 in.  
Hammer/Rod Type: Auto/AWJ  
Rig: CME 55 TRACK C_r = 1.46

Groundwater Observations		
Date	Depth (ft)	Notes
		None Taken.

Depth (ft)	Strata (1)	CLASSIFICATION OF MATERIALS (Description)	Run (Dip deg.)	Core Rec. % (RQD %)	Drill Rate minutes/ft	Blows/6" (N Value)	Moisture Content %	Gravel %	Sand %	Fines %
		Asphalt Pavement, 0.0 ft - 1.2 ft								
		A-1-a, SaGr, gry, MTW, Rec. = 5.3 ft				13-22-25-R (47)	5.3	65.6	26.3	8.1
2.5		Field Note: NXDC, Cleaned out casing								
		A-1-b, SaGr, gry, MTW, Rec. = 1.2 ft, Soft & Pulverized Ledge Cut Fill				11-26-17-16 (43)	11.4	46.0	34.8	19.2
5.0		A-1-b, SiGrSa, gry, MTW, Rec. = 0.7 ft, Soft & Pulverized Ledge Cut Fill				10-R@5.0" (R)	12.3	39.9	40.0	20.1
		Field Note: NXDC, Cleaned out casing								
7.5		Field Note: BXMDC, Rec. = 0.3', Soft & Pulverized Ledge Cut Fill								
		Field Note: NXDC, Cleaned out casing								
12.5		A-1-b, SiSaGr, gry, MTW, Rec. = 0.6 ft, Soft & Pulverized Ledge Cut Fill				38-R@1.0" (R)	9.8	44.8	35.1	20.1
15.0		14.0 ft - 17.0 ft, Laminated dark-gray to black, Carbonaceous to highly graphitic Phyllite, and white quartz. Moderately hard, Unweathered, Fair rock, BXMDC, RMR = 50	1 (70)	80 (77)	5					
					5					
					5					
17.5		17.0 ft - 19.0 ft, Laminated dark-gray to black, Carbonaceous to highly graphitic Phyllite, and white quartz. Moderately hard, Unweathered, Fair rock, BXMDC, RMR = 46	2 (70)	100 (70)	4					
					4					
		Hole stopped @ 19.0 ft								

Notes: 1. Stratification lines represent approximate boundary between material types. Transition may be gradual.  
2. N Values have not been corrected for hammer energy. C is the hammer energy correction factor.  
3. Water level readings have been made at times and under conditions stated. Fluctuations may occur due to other factors than those present at the time measurements were made.

BORING LOG 2 WATERBURY NHG SGNL(43).GPJ VERMONT AOT.GDT 4/15/13



STATE OF VERMONT  
AGENCY OF TRANSPORTATION  
MATERIALS & RESEARCH SECTION  
SUBSURFACE INFORMATION

**BORING LOG**

**WATERBURY  
NHG SGNL(43)  
I-89 & VT-100 EXIT #10**

Boring No.: **B-102**  
Page No.: 1 of 1  
Pin No.: 13B018  
Checked By: LAR

Boring Crew: **DAIGNEAULT, GARROW, SALISBURY**  
Date Started: 3/26/13 Date Finished: 3/26/13  
VTSPG NAD83: N 672144.29 ft E 1575062.79 ft  
Station: 26+80 Offset: 50.00  
Ground Elevation: 497.66 ft

Casing Type: **WB** Sampler: **SS**  
I.D.: 4 in 1.5 in  
Hammer Wt: N.A. 140 lb.  
Hammer Fall: N.A. 30 in.  
Hammer/Rod Type: Auto/AWJ  
Rig: CME 55 TRACK C_r = 1.46

Groundwater Observations		
Date	Depth (ft)	Notes
03/27/13	6.8	See Remarks.

Depth (ft)	Strata (1)	CLASSIFICATION OF MATERIALS (Description)	Run (Dip deg.)	Core Rec. % (RQD %)	Drill Rate minutes/ft	Blows/6" (N Value)	Moisture Content %	Gravel %	Sand %	Fines %
		A-1-b, SiGrSa, Dk/brn, Moist, Rec. = 1.4 ft				WH-4-7-10 (11)	14.1	32.8	47.0	20.2
2.5		Visual Description: GrSa with Broken Rock, Dk/gry, Moist, Rec. = 0.3 ft Field Note: NXDC, Possible Ledge Cut Fill				R@3.5"	8.4			
5.0		4.0 ft - 7.5 ft, Laminated dark-gray to black, Carbonaceous to highly graphitic Phyllite, and white quartz. Moderately hard, Unweathered, Poor rock, BXMDC, Unknown Dip. RMR = 36	1 (?)	11 (0)	2					
					3					
					7					
7.5		7.5 ft - 9.5 ft, Laminated dark-gray to black, Carbonaceous to highly graphitic Phyllite, and white quartz. Moderately hard, Unweathered, Poor rock, BXMDC, Unknown Dip. RMR = 36	2 (?)	40 (0)	2					
					9					
10.0		9.5 ft - 11.1 ft, Laminated dark-gray to black, Carbonaceous to highly graphitic Phyllite, and white quartz. Moderately hard, Unweathered, Fair rock, BXMDC, Unknown Dip. RMR = 46	3 (?)	100 (63)	6					
					9					
12.5		11.1 ft - 14.0 ft, Laminated dark-gray to black, Carbonaceous to highly graphitic Phyllite, and white quartz. Moderately hard, Unweathered, Fair rock, BXMDC, RMR = 41	4 (45)	90 (31)	2					
					6					
15.0		14.0 ft - 16.6 ft, Laminated dark-gray to black, Carbonaceous to highly graphitic Phyllite, and white quartz. Moderately hard, Unweathered, Fair rock, BXMDC, RMR = 50	5 (45)	85 (82)	1					
					9					
		Hole stopped @ 16.6 ft								
17.5		Remarks: Hole collapsed at 6.8 ft.								

Notes: 1. Stratification lines represent approximate boundary between material types. Transition may be gradual.  
2. N Values have not been corrected for hammer energy. C is the hammer energy correction factor.  
3. Water level readings have been made at times and under conditions stated. Fluctuations may occur due to other factors than those present at the time measurements were made.

BORING LOG 2 WATERBURY NHG SGNL(43).GPJ VERMONT AOT.GDT 4/15/13

PROJECT NAME: WATERBURY  
PROJECT NUMBER: NHG SGNL(43)  
FILE NAME: +13b018geo.dgn PLOT DATE: 12/31/2013  
PROJECT LEADER: P. COBURN DRAWN BY: I. DEGUTIS  
DESIGNED BY: I. DEGUTIS CHECKED BY: M. LACROIX  
BORING DATA SHEET 1 SHEET 3 OF 17



STATE OF VERMONT  
AGENCY OF TRANSPORTATION  
MATERIALS & RESEARCH SECTION  
SUBSURFACE INFORMATION

**BORING LOG**

**WATERBURY  
NHG SGNL(43)  
I-89 & VT-100 EXIT #10**

Boring No.: **B-103**

Page No.: **1 of 1**

Pin No.: **13B018**

Checked By: **LAR**

Boring Crew: **DAIGNEAULT, GARROW, SALISBURY**  
Date Started: **3/27/13** Date Finished: **3/27/13**  
VTSPG NAD83: **N 672240.06 ft E 1575065.88 ft**  
Station: **27+10** Offset: **-41.00**  
Ground Elevation: **497.3 ft**

Casing Type: **WB** Sampler: **SS**  
I.D.: **4 in** **1.5 in**  
Hammer Wt: **N.A.** **140 lb.**  
Hammer Fall: **N.A.** **30 in.**  
Hammer/Rod Type: **Auto/AWJ**  
Rig: **CME 55 TRACK** **C_r = 1.46**

Groundwater Observations		
Date	Depth (ft)	Notes
03/27/13	3.1	Casing was pulled.

Depth (ft)	Strata (1)	CLASSIFICATION OF MATERIALS (Description)	Run (Dip deg.)	Core Rec. % (RQD %)	Drill Rate minutes/ft	Blows/6" (N Value)	Moisture Content %	Gravel %	Sand %	Fines %	Groundwater Observations	
											Date	Depth (ft)
0.0 - 2.5		A-1-b, SiGrSa, Dk/brn, Moist, Rec. = 0.8 ft				WH-1-2-1 (3)	16.1	33.2	44.6	22.2		
2.5 - 5.0		A-2-4, GrSiSa, Dk/brn, Moist, Rec. = 0.4 ft				3-10-R@6.0" (R)	15.1	27.6	42.9	29.5		
5.0 - 7.0		A-1-b, SaGr, gry, Moist, Rec. = 0.7 ft, Lab Note: Sample was mostly Broken & Pulverized Rock. Field Note: NXDC Field Note: NXDC, Possible Ledge Cut Fill					2.4	50.8	32.0	17.2		
7.0 - 9.0		7.0 ft - 9.0 ft, Laminated dark-gray to black, Carbonaceous to highly graphitic Phyllite, and white quartz. Moderately hard, Unweathered, Poor (70) rock, BXMDC, RMR = 36	1	85 (0)	6							Top of Bedrock @ 7.0 ft
9.0 - 14.0		9.0 ft - 14.0 ft, Laminated dark-gray to black, Carbonaceous to highly graphitic Phyllite, and white quartz. Moderately hard, Unweathered, Poor (70) rock, BXMDC, RMR = 36	2	38 (0)	6							
14.0 - 15.0		Hole stopped @ 14.0 ft										
15.0 - 17.5		Remarks: Hole collapsed at 5.4 ft.										

Notes: 1. Stratification lines represent approximate boundary between material types. Transition may be gradual.  
2. N Values have not been corrected for hammer energy. C_r is the hammer energy correction factor.  
3. Water level readings have been made at times and under conditions stated. Fluctuations may occur due to other factors than those present at the time measurements were made.

BORING LOG 2 WATERBURY NHG SGNL(43).GPI VERMONT AOT.GDT 4/15/13

PROJECT NAME: <b>WATERBURY</b>	PLOT DATE: <b>12/31/2013</b>
PROJECT NUMBER: <b>NHG SGNL(43)</b>	DRAWN BY: <b>I. DEGUTIS</b>
FILE NAME: <b>+13b018geo.dgn</b>	CHECKED BY: <b>M. LACROIX</b>
PROJECT LEADER: <b>P. COBURN</b>	SHEET <b>4</b> OF <b>17</b>
DESIGNED BY: <b>I. DEGUTIS</b>	
BORING DATA SHEET <b>2</b>	

# QUANTITY SHEET

SUMMARY OF ESTIMATED QUANTITIES										TOTALS		DESCRIPTIONS				DETAILED SUMMARY OF QUANTITIES			
								ROADWAY	EROSION CONTROL	FULL C.E. ITEMS	GRAND TOTAL	FINAL	UNIT	ITEMS	ITEM NUMBER	ROUND	QUANTITIES	UNIT	ITEMS
								1			1		CY	TRENCH EXCAVATION OF EARTH, EXPLORATORY (N.A.B.I.)	204.22	-			
								80			80		HR	UNIFORMED TRAFFIC OFFICERS	630.10	EST.			
								240			240		HR	FLAGGERS	630.15	EST.			
										1	1		LS	TESTING EQUIPMENT, CONCRETE	631.16	-			
								1			1		LS	MOBILIZATION/DEMOLITION	635.11	-			
								1			1		LS	TRAFFIC CONTROL	641.10	-			
								500			500		LF	DURABLE 4 INCH WHITE LINE, POLYUREA	646.404	19			
								110			110		LF	DURABLE 24 INCH STOP BAR, POLYUREA	646.484	2			
								39			39		EACH	DURABLE LETTER OR SYMBOL, POLYUREA	646.494	-			
								1150			1150		SF	REMOVAL OF EXISTING PAVEMENT MARKINGS	646.85	4			
									5		5		LB	SEED	651.15	EST.			
									0.3		0.3		TON	HAY MULCH	651.25	EST.			
									10		10		CY	TOPSOIL	651.35	EST.			
								14			14		SF	TRAFFIC SIGNS, TYPE A	675.20	-			
								75			75		LF	SQUARE TUBE SIGN POST AND ANCHOR	675.341	EST.			
								23			23		EACH	REMOVING SIGNS	675.50	-			
								20			20		EACH	ERECTING SALVAGED SIGNS	675.60	-			
								3			3		EACH	SETTING SALVAGED POSTS	675.61	-			
								1			1		EACH	TRAFFIC CONTROL SIGNAL SYSTEM, INTERSECTION (VT 100 @ I-89 EXIT 10 NB OFF-RAMP)	678.15	-			
								1			1		EACH	TRAFFIC CONTROL SIGNAL SYSTEM, INTERSECTION (VT 100 @ I-89 EXIT 10 SB OFF-RAMP)	678.15	-			
								1330			1330		LF	WRED CONDUIT (2")(PVC)(SCH. 80)	678.23	17			
								3			3		EACH	PULL BOX, STANDARD	678.25	-			
								1			1		EACH	JUNCTION BOX	678.26	-			
								2			2		EACH	BRACKET ARM	679.47	-			
								2			2		EACH	SPECIAL PROVISION (LUMINAIRE, LED)	900.620	-			
								1			1		EACH	SPECIAL PROVISION (REMOVE EXISTING LIGHT POLE)	900.620	-			
								4			4		EACH	SPECIAL PROVISION (SOIL BEARING SLIP BASE)(2 1/2")	900.620	-			
								75			75		LF	SPECIAL PROVISION (HORIZONTAL DIRECTIONAL DRILLING)(12" CASING PIPE)	900.640	-			
								1			1		LS	SPECIAL PROVISION (RETIMING OF SIGNAL CORRIDOR)	900.645	-			

PROJECT NAME: WATERBURY  
 PROJECT NUMBER: NHG SGNL(43)  
 FILE NAME: t13b018frm.dgn  
 PROJECT LEADER: P. COBURN  
 DESIGNED BY: I. DEGUTIS  
 QUANTITY SHEET  
 PLOT DATE: 12/31/2013  
 DRAWN BY: I. DEGUTIS  
 CHECKED BY: M. LACROIX  
 SHEET 5 OF 17

ALIGNMENT: VT ROUTE 100				
ELEMENT	POINT	STATION	NORTHING	EASTING
LINEAR	POB	24+00.00	672113.2110	1574780.0622
CURVE #1	PC	30+60.06	672299.5521	1575413.2742
	PI	33+55.70	672383.0147	1576596.8913
	PT	36+27.45	672628.5168	1575861.6135
LINEAR	POE	37+43.32	672724.7379	1575926.1740

CURVE #1 DATA:	
RADIUS:	818'
Δ:	39° 44' 30.83"
Dc:	7' 00" 15.75" LT.
LENGTH:	567.39'
TANGENT:	295.64'
EXTERNAL:	51.79'

ALIGNMENT: I-89 NB OFF RAMP (RAMP B)				
ELEMENT	POINT	STATION	NORTHING	EASTING
LINEAR	POB	111+00.0	671793.0777	1575207.3563
LINEAR	POE	115+28.02	672207.2760	1575101.4406

TRAFFIC SIGN, TYPE A  
SEE TRAFFIC SIGN SUMMARY SHEET  
SQUARE TUBE SIGN POST AND ANCHOR  
SEE TRAFFIC SIGN SUMMARY SHEET


SPECIAL PROVISION (SOIL BEARING SLIP BASE)(2½")  
STA. 30+26 LT (2 EA.)  
STA. 31+70 LT (2 EA.)

REMOVING SIGNS  
23 EA. - AS SHOWN


ERECTING SALVAGED SIGNS  
20 EA. - AS SHOWN

SETTING SALVAGED POSTS  
3 EA. - AS SHOWN


R: STA. 29+10 LT  
S: STA. 30+26 LT

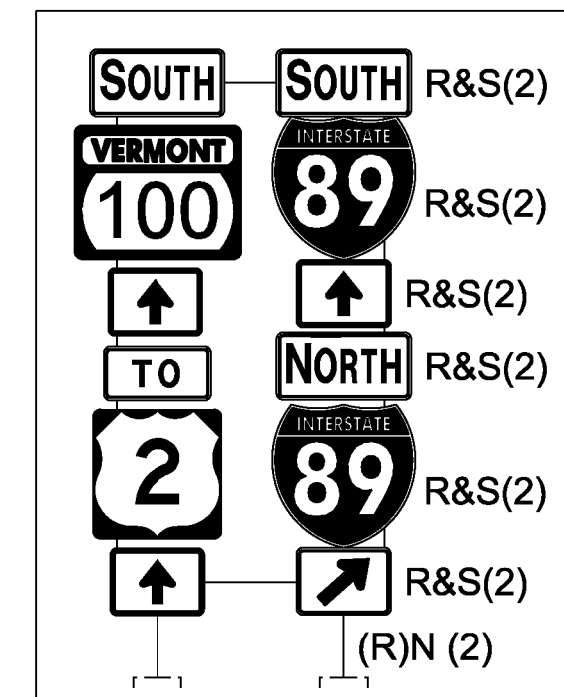



R: STA. 30+37 LT  
S: STA. 31+70 LT

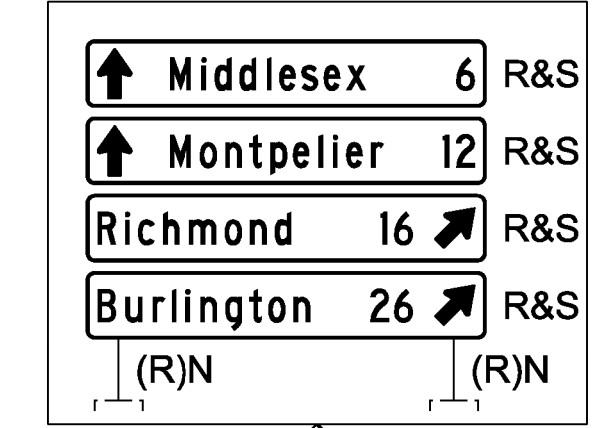


R: STA. 31+40 LT  
S: STA. 32+82 LT

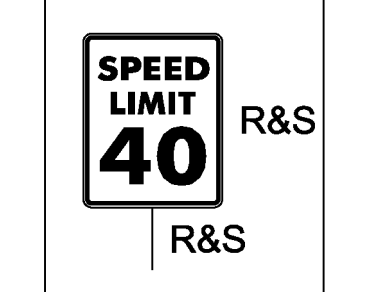


R: STA. 33+46 LT  
S: STA. 33+90 LT STA 34+04 LT

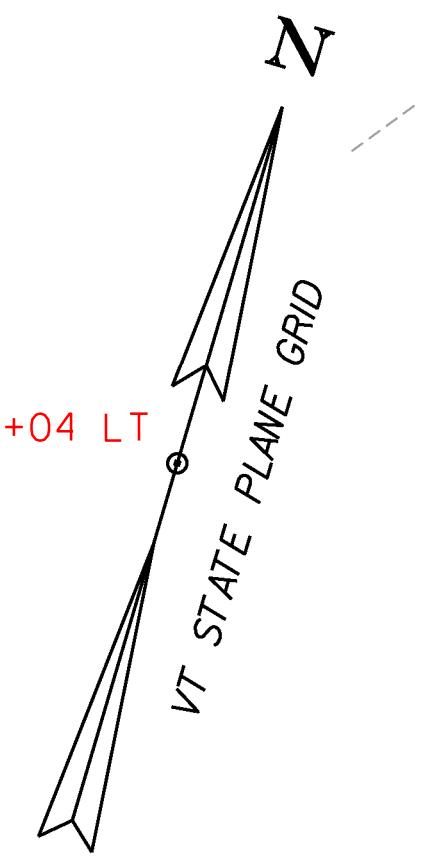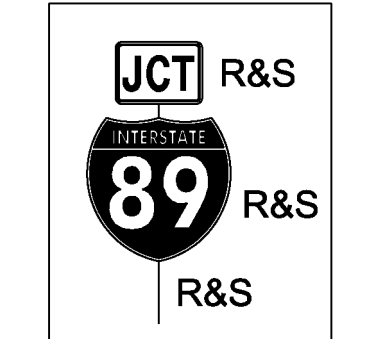



RET: STA 27+48 LT

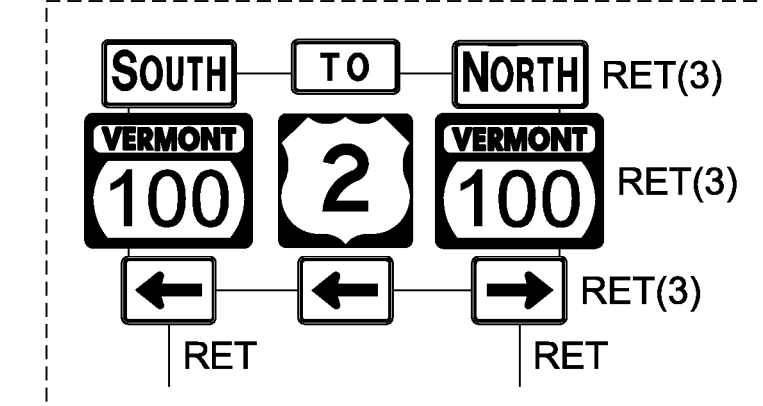

N: STA 27+55 LT

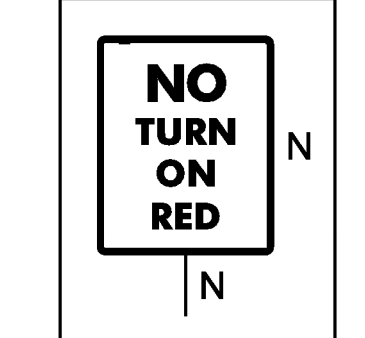

R: STA. 27+91 LT  
S: STA. 28+99 LT

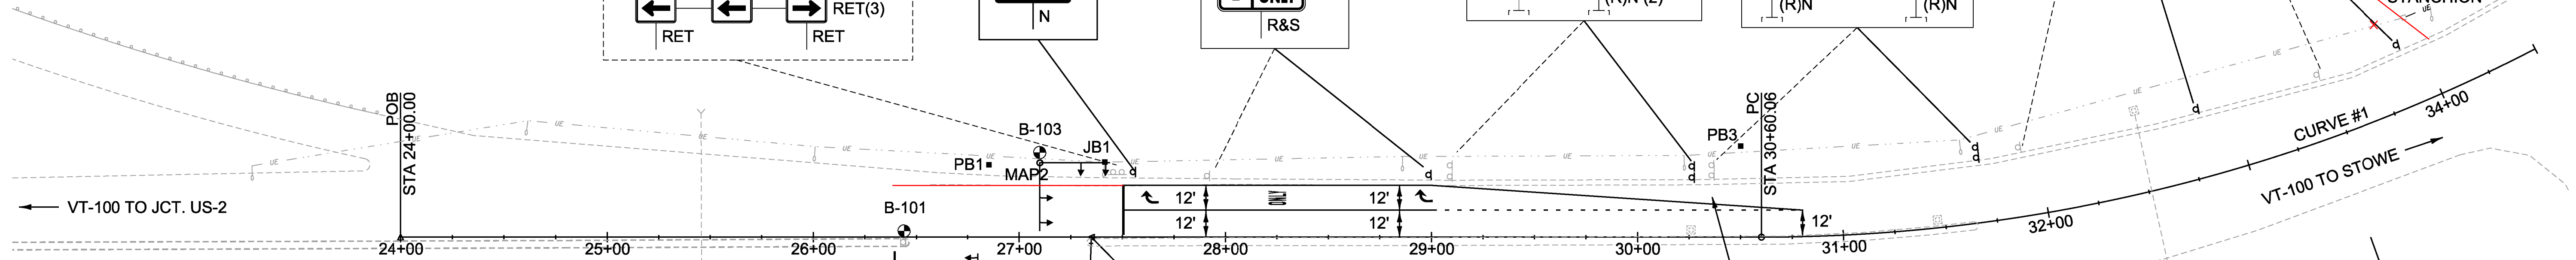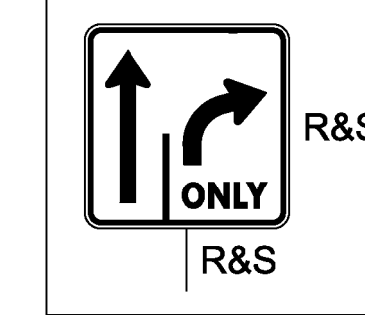

**REMOVAL OF EXISTING PAVEMENT MARKINGS**

- STA. 26+36 LT (r)
- STA. 26+92 LT (ONLY)
- STA. 27+36 LT (r)
- STA. 27+75 - 30+00 LT (SHOULDER MARKINGS) STA. 26+36 - 30+11 LT
- STA. 103+28 (STOP AHEAD)
- STA. 112+85 LT & RT (ONLY) (2)
- STA. 113+00 LT & RT (r) (r)
- STA. 113+88 LT (r)
- STA. 114+00 LT & RT (ONLY) (2)
- STA. 114+15 LT & RT (r) (r)
- STA. 114+80 LT & RT (ONLY) (2)
- STA. 114+84 LT & RT (r) (r)
- STA. 114+88 LT & RT (STOP) (2)
- STA. 32+25 RT (SIGNAL AHEAD)

**DURABLE 4 INCH WHITE LINE, POLYUREA**

- STA. 27+50 - 29+00 LT. (SOLID)
- STA. 27+50 - 30+80 LT. (SOLID) STA. 26+38 - 30+80 LT
- STA. 29+00 - 30+80 LT. (DOTTED)

**DURABLE 24 INCH STOP BAR, POLYUREA**


- STA. 26+40 RT (12')
- STA. 27+50 LT (24')
- STA. 114+90 LT & RT (72')

**DURABLE LETTER OR SYMBOL, POLYUREA**

- STA. 27+54 LT (r)
- STA. 28+25 LT (ONLY)
- STA. 28+96 LT (r)
- STA. 103+28 (SIGNAL AHEAD)
- STA. 112+82 LT & RT (r) (r)
- STA. 113+32 LT & RT (ONLY) (2)
- STA. 113+82 LT & RT (r) (r)
- STA. 114+32 LT & RT (ONLY) (2)
- STA. 114+82 LT & RT (r) (r)


RETAIN EXISTING SHOULDER MARKINGS  
OUTSIDE NEW RIGHT TURN LANE LIMITS

R: STA 114+87 LT & RT

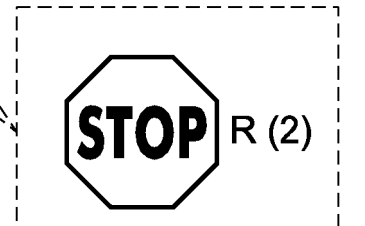


REMOVE STOP SIGN  
RETAIN DO NOT ENTER SIGN ASSEMBLY

R: STA 103+28 RT

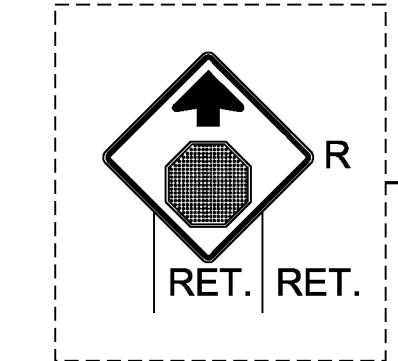


N: STA 103+28 RT

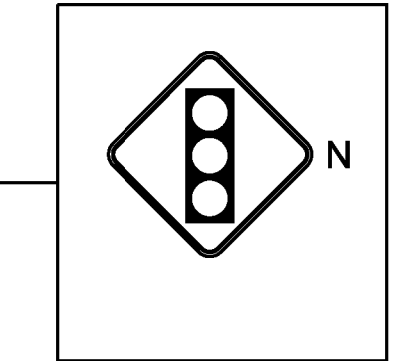

**NOTES:**

- CALL DIG SAFE PRIOR TO PERFORMING ANY EXCAVATION WORK. 1-888-DIG-SAFE
- ALL EXISTING PAVEMENT MARKINGS AND SIGNS TO REMAIN UNLESS OTHERWISE NOTED.
- UNDERGROUND ELECTRIC LINE LOCATIONS AS SHOWN ARE APPROXIMATE. CONTACT THE VTRANS TRAFFIC SHOP FOR MORE INFORMATION REGARDING EXISTING CONDITIONS.

**SIGN LEGEND**  
R: REMOVE  
S: SALVAGE  
N: NEW  
RET: RETAIN

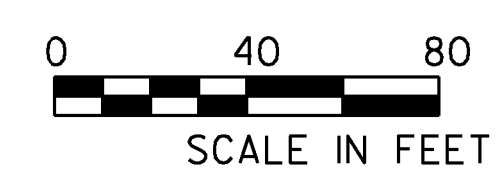

PROJECT NAME:	WATERBURY	FILE NAME:	t13b018nu1.dgn	PLOT DATE:	12/31/2013
PROJECT NUMBER:	NHG SGNL(43)	PROJECT LEADER:	P. COBURN	DRAWN BY:	I. DEGUTIS
		DESIGNED BY:	I. DEGUTIS	CHECKED BY:	M. LaCROIX
		LAYOUT SHEET		SHEET	6 OF 17




**LIST OF MAJOR EQUIPMENT**

EQUIPMENT ITEM 678.15 (MS-636: VT 100 & I-89 EXIT 10 SB OFF-RAMP)	QUANTITY
ECONOLITE ASC/3-2100 TRAFFIC SIGNAL CONTROLLER (NEMA TS2) AND POWER SUPPLY	1
DIRECTIONAL WIRELESS INTERCONNECT ANTENNA	1
WIRELESS INTERCONNECT PROCESSOR CARD	1

**NOTES:**

1. ALL MAST ARMS, SIGNAL HEADS, VIDEO DETECTION CAMERAS AND OTHER POLE-MOUNTED EQUIPMENT TO REMAIN IN PLACE AND SHALL BE MADE TO FUNCTION PROPERLY WITH THE NEW CONTROLLER.
2. VIDEO PROCESSOR CARDS AND ALL OTHER NECESSARY EQUIPMENT TO REMAIN IN THE CABINET AND SHALL BE MADE TO FUNCTION WITH THE NEW CONTROLLER.
3. ALL CONNECTORS, WIRING, AND OTHER INCIDENTAL MATERIALS AND LABOR REQUIRED TO MAKE THE CONTROLLER FUNCTION WITH THE EXISTING CABINET AND SIGNAL EQUIPMENT SHALL BE INCIDENTAL TO ITEM 678.15 (MS-636: VT 100 & I-89 EXIT 10 SB OFF-RAMP)
4. CONTROLLER AND ALL OTHER SALVAGEABLE EQUIPMENT NOT TO BE REUSED TO REMAIN THE PROPERTY OF THE STATE. SEE SPECIAL PROVISIONS FOR ADDITIONAL INFORMATION AND REQUIREMENTS. CONTACT STEVE GUYETTE, OF VTRANS DISTRICT 5: 802-655-1580
5. SEE CORRIDOR COORDINATION SHEET FOR CONTROLLER TIMING DATA.


**REMOVAL OF EXISTING PAVEMENT MARKINGS  
RAMP "G" - (STOP)**

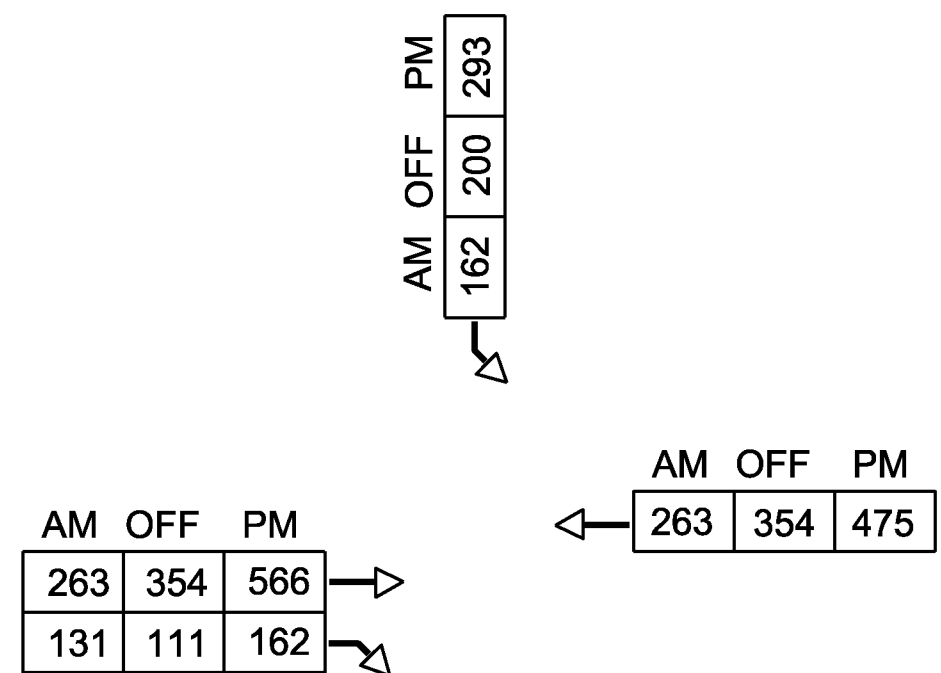



**VT ROUTE 100 &  
I-89 SB EXIT 10 OFF RAMP  
2014 DESIGN HOURLY VOLUMES**

EXISTING	NEW	LEGEND
		UTILITY POLE
		LUMINAIRE
		LIGHT OR WOOD POLE
		STRAIN POLE
		CONTROLLER CABINET
		PULLBOX/JUNCTION BOX
		SIGNAL HEAD
		CONDUIT
		VIDEO DETECTION CAMERA
		VIDEO DETECTION ZONE
		STANCHION
		PREEMPTION STROBE
		OPTICAL PREEMPTION DETECTOR

**PHASING DIAGRAM**

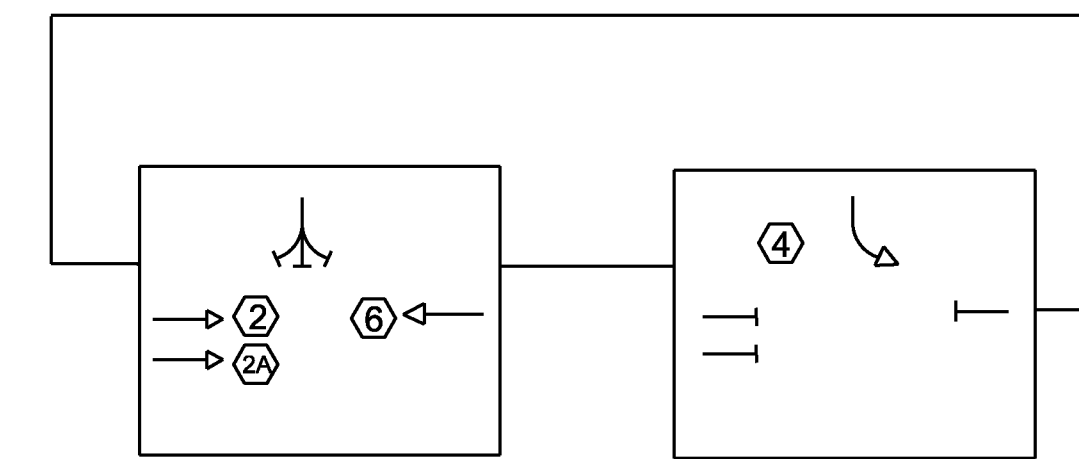

SEE CORRIDOR COORDINATION SHEET  
FOR CONTROLLER TIMING DATA

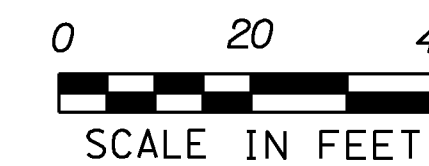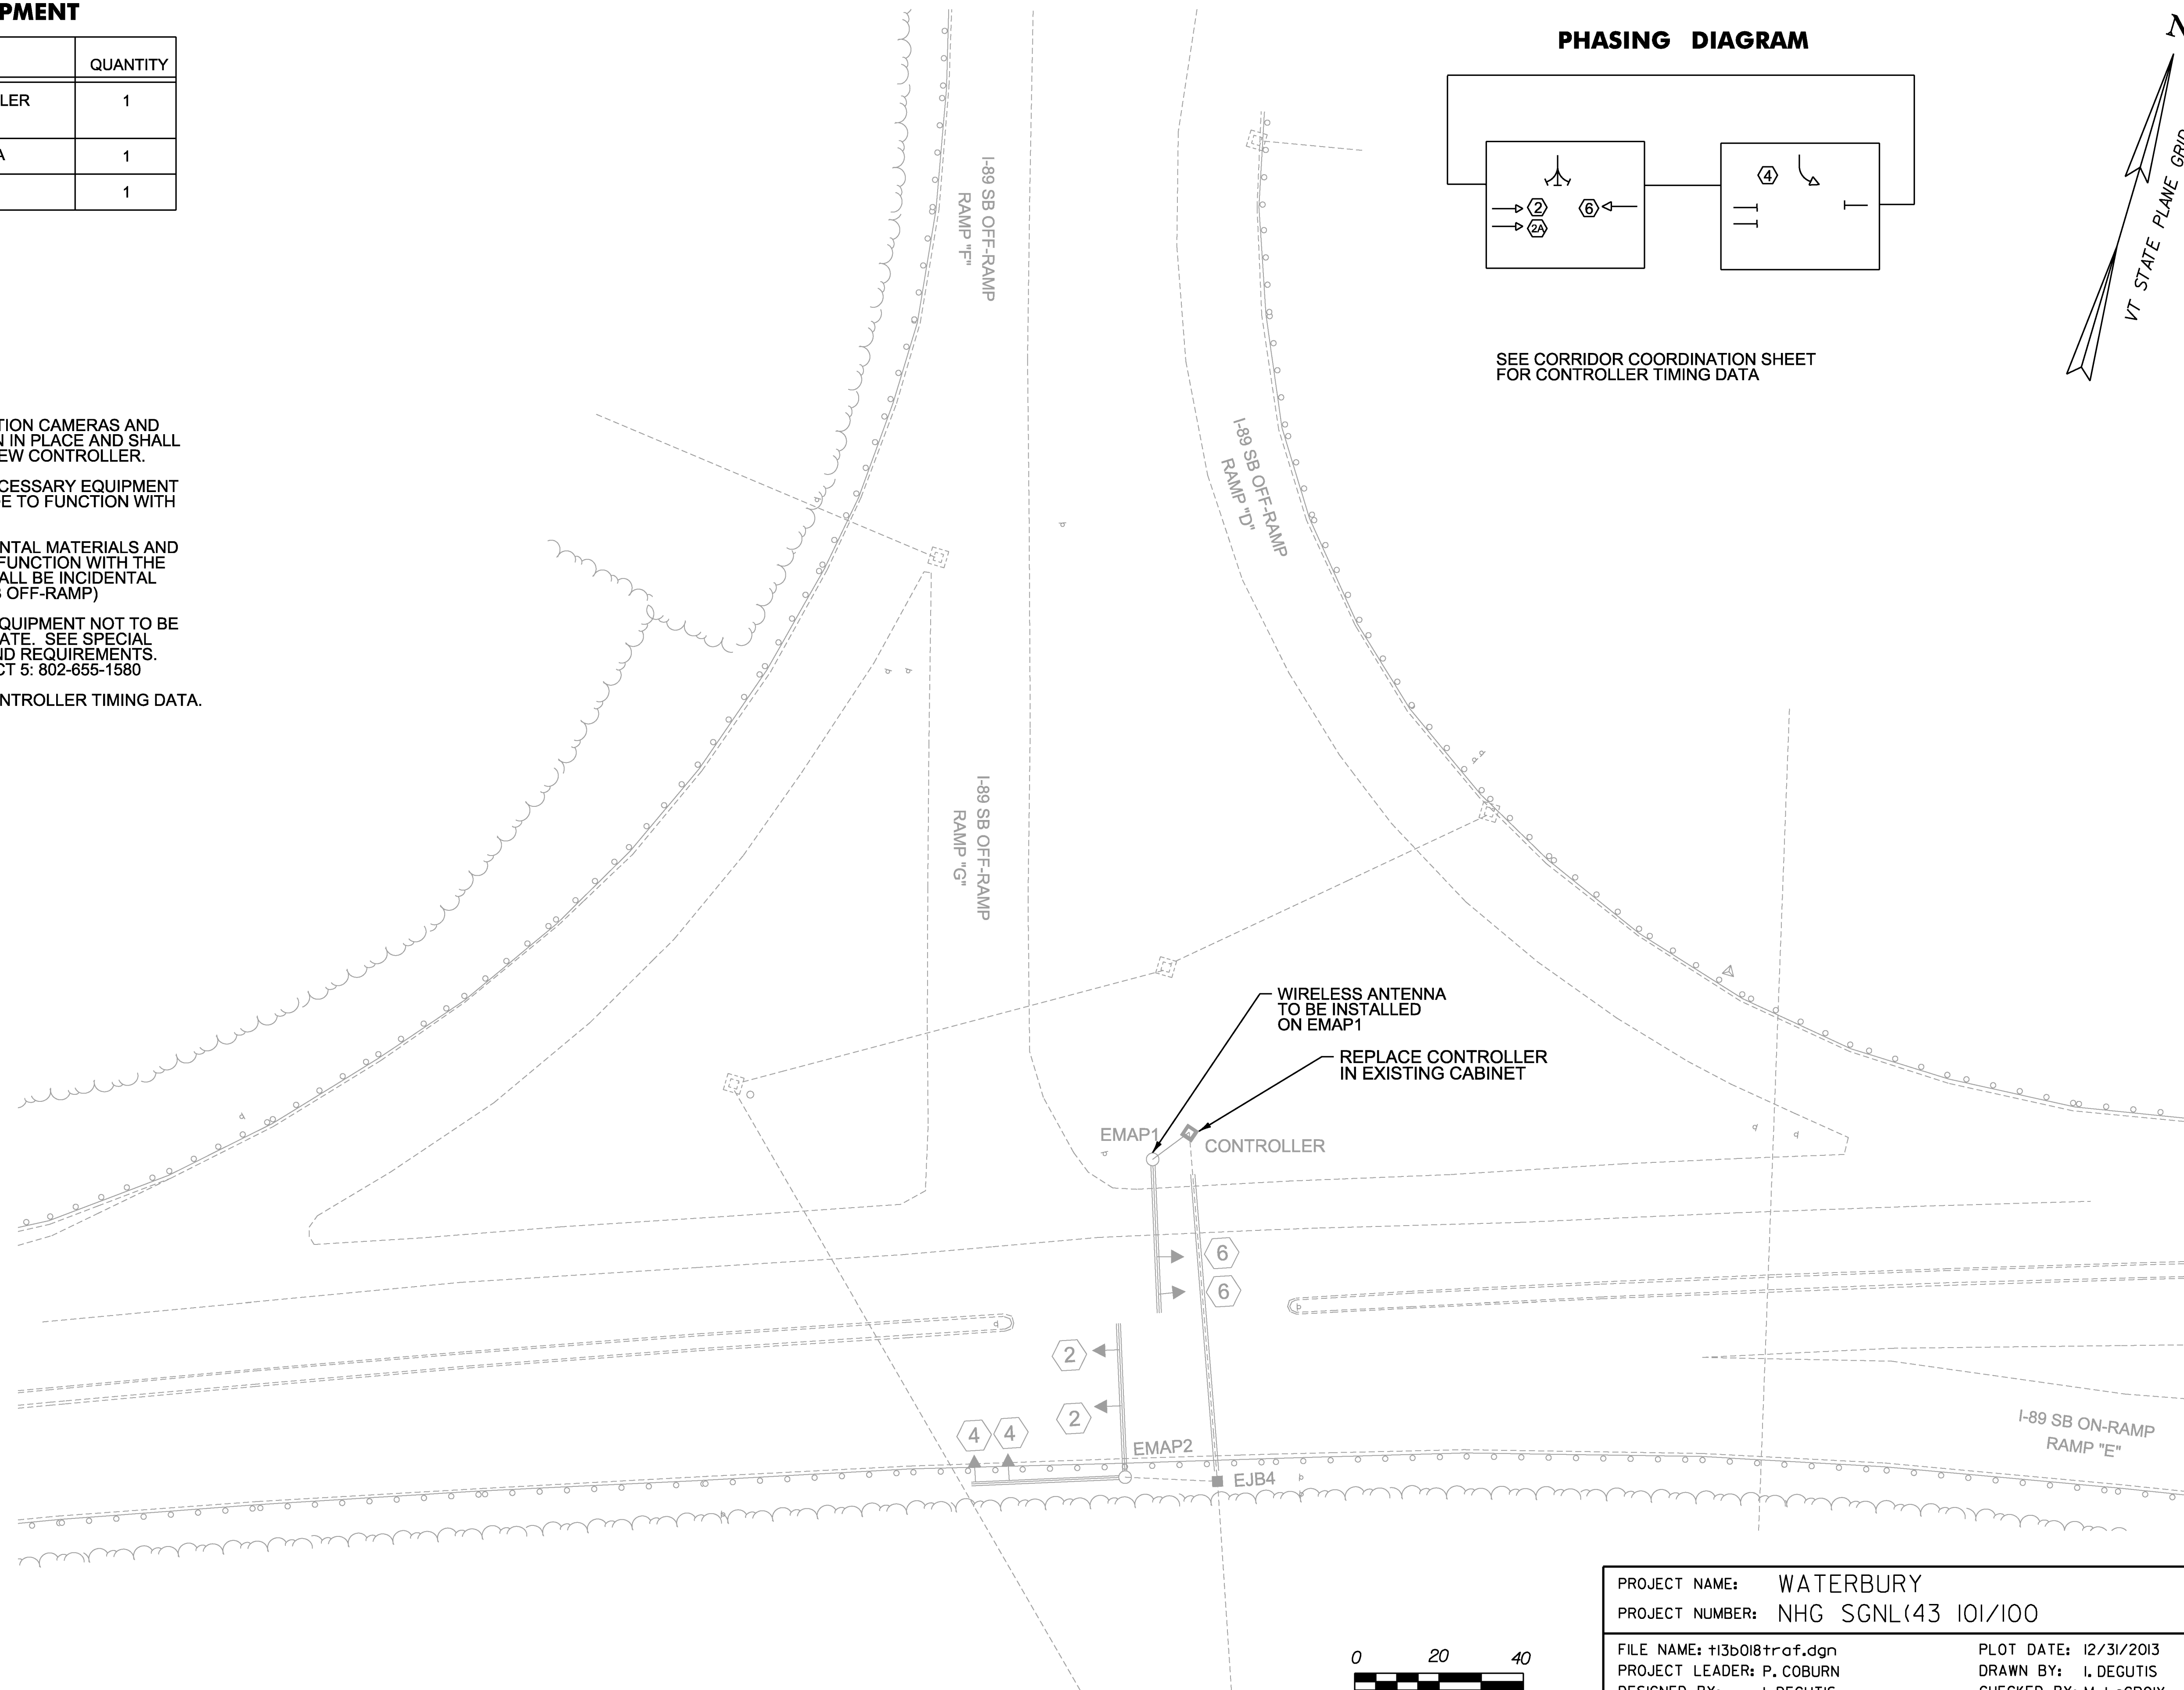

PROJECT NAME: WATERBURY  
PROJECT NUMBER: NHG SGNL(43 101/100)

FILE NAME: t13b018trcf.dgn  
PROJECT LEADER: P. COBURN  
DESIGNED BY: I. DEGUTIS  
TRAFFIC SIGNAL LAYOUT SHEET SB RAMP

PLOT DATE: 12/31/2013  
DRAWN BY: I. DEGUTIS  
CHECKED BY: M. LACROIX  
SHEET 8 OF 17

TRAFFIC CONTROL SIGNAL SYSTEM, INTERSECTION  
(MS 637: VT 100 & I-89 NB OFF-RAMP)

MAST ARM POLE  
STA 26+80, 50' RT  
STA 27+10, 36' LT

CABINET/CONTROLLER  
STA 26+86, 56' RT STA 26+88, 57' RT

POWER STANCHION  
STA 34+04, 43' LT STA 34+01, 43' LT

PULL BOX STANDARD  
STA 26+85, 35' LT STA 26+86 LT, 35' LT  
STA 26+85, 39' RT STA 26+64 RT, 46' RT  
STA 30+50, 44' LT STA 30+47 LT, 44' LT

JUNCTION BOX  
STA 27+41, 36' LT

BRACKET ARM  
STA 26+80 - 16' (SL1)  
STA 27+10 - 12' (SL2)

SPECIAL PROVISION (LUMINAIRE, LED)  
STA 26+80 (MAP1)  
STA 27+10 (MAP2)


SPECIAL PROVISION (REMOVE EXISTING LIGHT POLE)  
STA 27+41, 36' LT

SPECIAL PROVISION (HORIZONTAL DIRECTIONAL DRILLING) (12" CASING PIPE)  
STA 26+85 LT - STA 26+85 RT STA 26+86 LT - 26+64 RT

LIST OF MAJOR EQUIPMENT

EQUIPMENT ITEM 678.15 (MS-637: VT 100 & I-89 EXIT 10 NB OFF-RAMP)	QUANTITY	ADDITIONAL EQUIPMENT	QUANTITY
POWER METER ON STANCHION	1	ELTECH TIMESYNC I-GPS	4
FOUR-BAY BREAKER PANEL ON STANCHION	1		
ECONOLITE ASC/3-2100 TRAFFIC SIGNAL CONTROLLER (NEMA TS2)	1		
NEMA "P44" BASE MOUNTED CONTROLLER CABINET WITH 15-INCH EXTENDED BASE ON A CONCRETE FOUNDATION, PAINTED FLAT BLACK WITH ANCILLARY CONTROL EQUIPMENT	1		
FLAT BLACK PAINTED STEEL MAST ARM SIGNAL POLE WITH 42 FOOT MAST ARM (MAP1)	1		
FLAT BLACK PAINTED STEEL MAST ARM SIGNAL POLE WITH 34 FOOT MAST ARM AND 31 FOOT MAST ARM (MAP2)	1		
ONE WAY, 3-SECTION, 12-INCH POLYCARBONATE MAST ARM MOUNTED LED TRAFFIC SIGNAL HEAD WITH TUNNEL VISORS AND 5" LOUVERED BACKPLATES WITH ALL PIECES PAINTED FLAT BLACK	6		
ASTRO-BRACKETS	6		
BI-DIRECTIONAL WIRELESS INTERCONNECT ANTENNA	1		
WIRELESS INTERCONNECT PROCESSOR CARD	1		
CAMERA EXTENSION BRACKET	3		
CAMERA ASSEMBLY	3		
VIDEO DETECTION PROCESSOR CARD	3		


EXISTING	NEW	LEGEND
		UTILITY POLE
		LUMINAIRE
		LIGHT OR WOOD POLE
		STRAIN POLE
		CONTROLLER CABINET
		PULLBOX/JUNCTION BOX
		SIGNAL HEAD
		CONDUIT
		VIDEO DETECTION CAMERA
		VIDEO DETECTION ZONE
		STANCHION
		PREEMPTION STROBE
		OPTICAL PREEMPTION DETECTOR

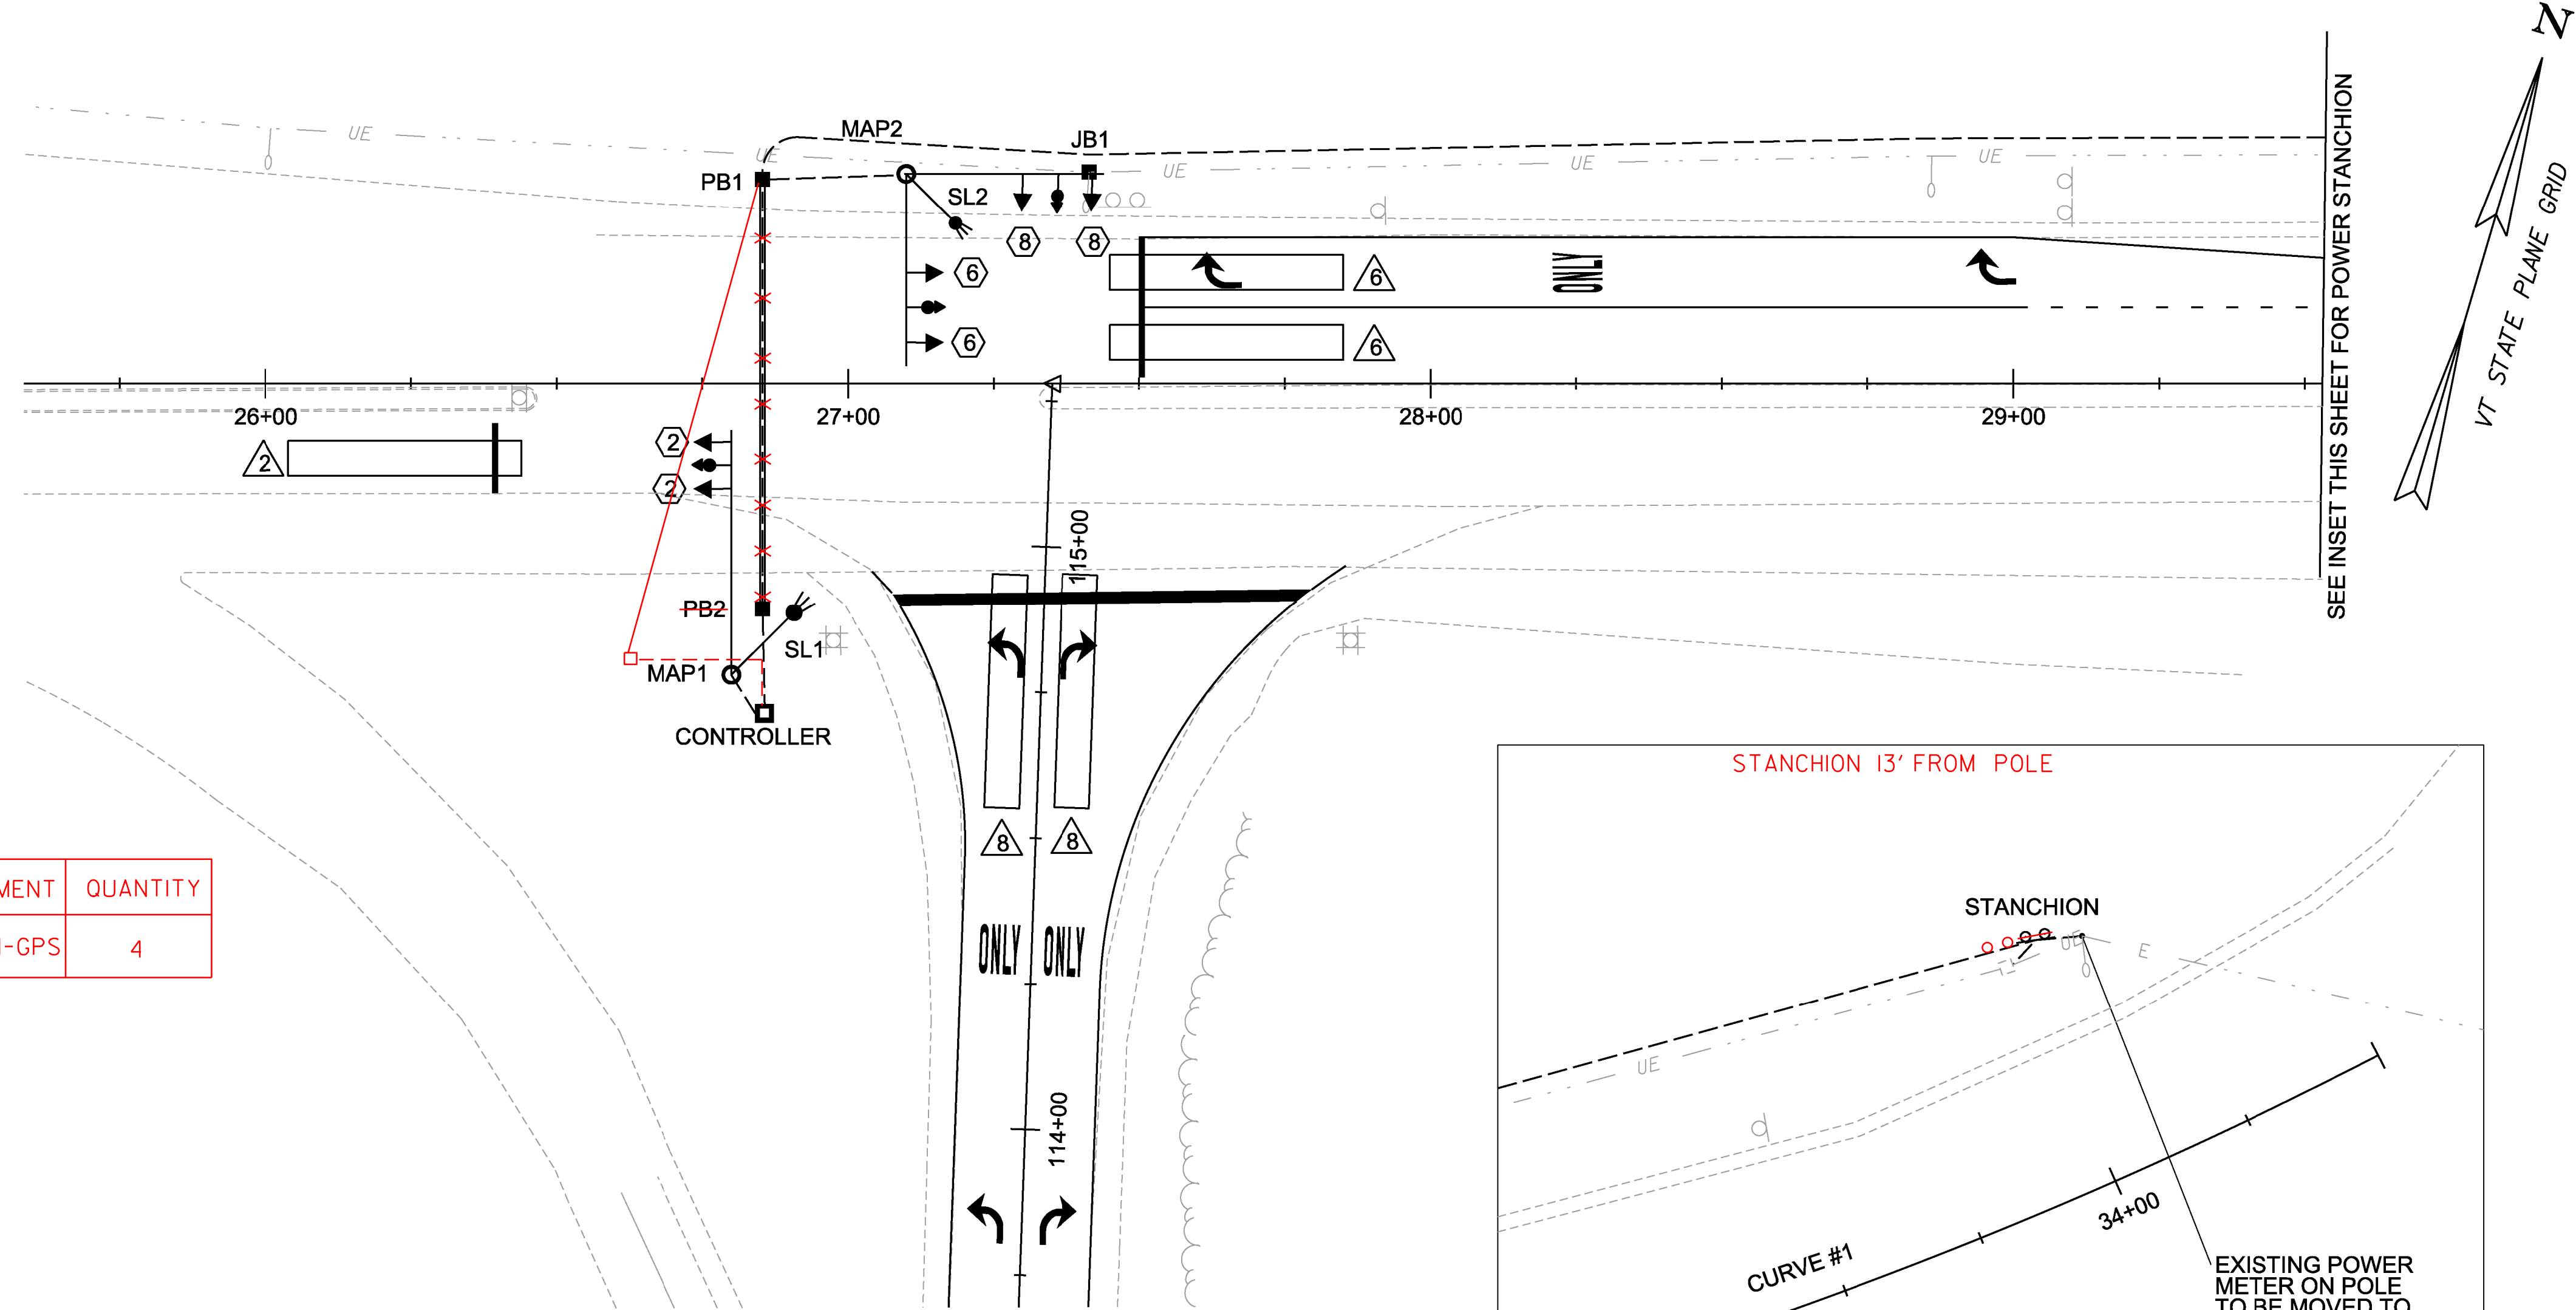

SEE CORRIDOR COORDINATION SHEET FOR CONTROLLER TIMING DATA



678.23 - WIRED CONDUIT	CONDUIT SIZE		DESCRIPTION
	2"	4"	
POWER TO STANCHION	22'		*POWER
STANCHION TO EPB1	16'		**POWER
STANCHION TO PB3	345'		POWER
PB3 TO PB1	376'		POWER
PB1 TO PB2	80'		POWER
PB2 TO CONTROLLER	24'		POWER
CONTROLLER TO MAP1	15'		SIGNAL/LIGHTING
CONTROLLER TO MAP1	15'		VIDEO
CONTROLLER TO MAP1	15'		FUTURE USE
CONTROLLER TO PB2	24'		SIGNAL/LIGHTING
CONTROLLER TO PB2	24'		VIDEO
CONTROLLER TO PB2	24'		FUTURE USE
PB2 TO PB1	80'		SIGNAL/LIGHTING
PB2 TO PB1	80'		VIDEO
PB2 TO PB1	80'		FUTURE USE
PB1 TO MAP2	31'		SIGNAL/LIGHTING
PB1 TO MAP2	31'		VIDEO
PB1 TO MAP2	31'		FUTURE USE
SUBTOTALS	1313'		
ROUNDING	17'		
TOTALS	1330'	1475.75'	

* CONDUIT QUANTITY INCLUDES PVC RUN ON UTILITY POLE #1  
** FOR EXISTING STREET LIGHTING

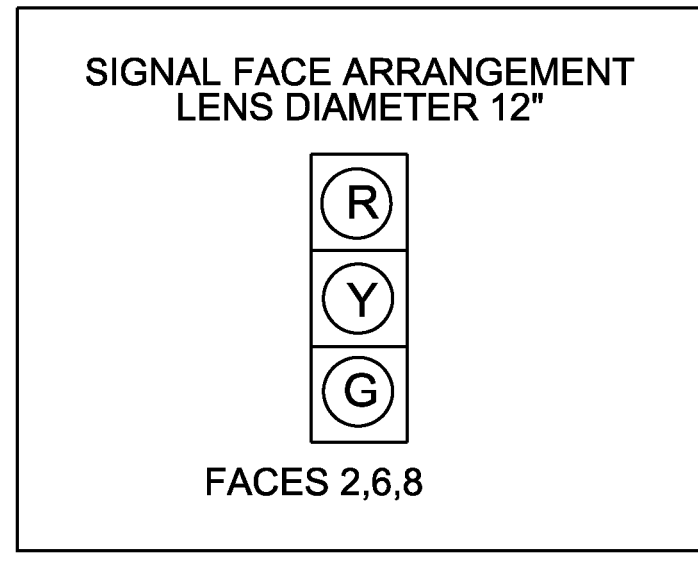

ALL HEADS TO BE LED'S

PHASING DIAGRAM

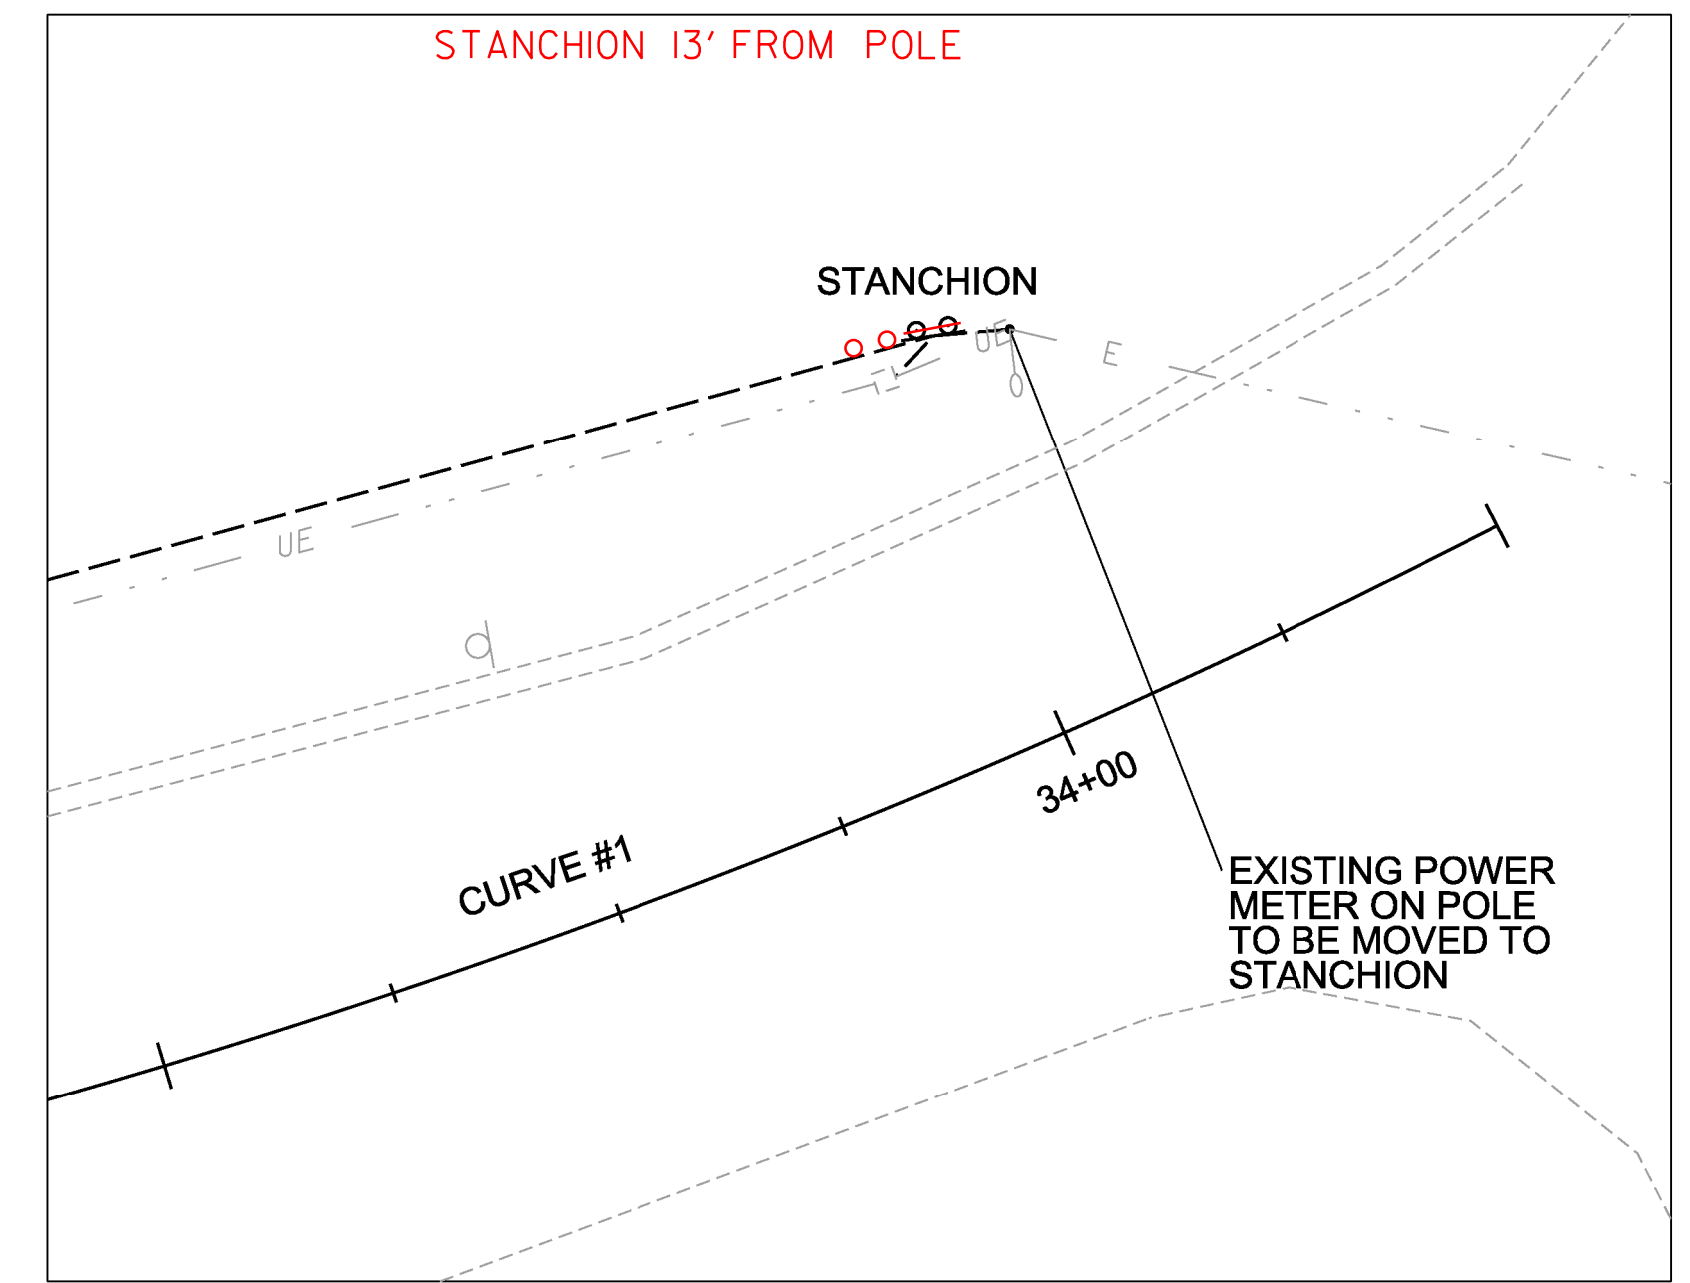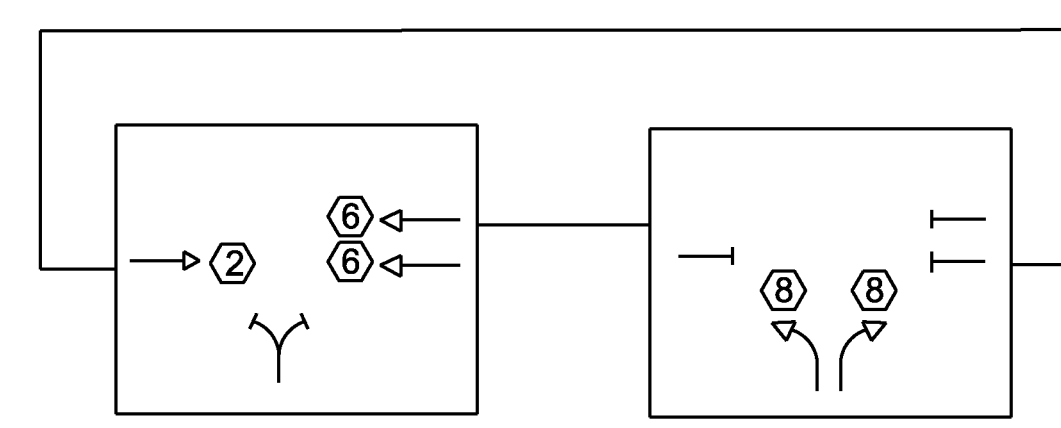

INSET: POWER DROP DETAILS AT BLUSH HILL ROAD INTERSECTION

AM	OFF	PM	AM	OFF	PM
495	601	697	202	212	253
			525	495	606

VT ROUTE 100 & I-89 NB EXIT 10 OFF RAMP  
2013 DESIGN HOURLY VOLUMES

PROJECT NAME: WATERBURY	PLOT DATE: 12/31/2013
PROJECT NUMBER: NHG SGNL(43 101/100)	DRAWN BY: I. DEGUTIS
FILE NAME: t13b018+raf.dgn	CHECKED BY: M. LACROIX
PROJECT LEADER: P. COBURN	TRAFFIC SIGNAL LAYOUT SHEET NB RAMP
DESIGNED BY: I. DEGUTIS	SHEET 9 OF 17

# TRAFFIC SIGNAL NOTES

## A. NEW SIGNAL EQUIPMENT

1. ALL SIGNAL HEADS SHALL BE 12" POLYCARBONATE. THE SIGNAL HEADS SHALL HAVE FLAT BLACK HOUSINGS AND VISORS.
2. ALL SIGNAL HEADS SHALL HAVE BLACK LOUVERED BACK PLATES.
3. THE TRAFFIC SIGNAL CONTROLLER AND RELATED EQUIPMENT SHALL BE AN ECONOLITE ASC/3-2100 (NEMA TS2) IN A NEMA P44 TRAFFIC CONTROL CABINET WITH 15" BASE EXTENSION INSTALLED AT THE LOCATION SHOWN ON PLANS. THE CONCRETE BASE FOR THE CONTROLLER CABINET SHALL HAVE A 18" X 12" OPENING FOR TRAFFIC SIGNAL CONDUIT LOCATED IN THE CENTER. THE OPENING SHALL BE FILLED WITH STONE AND UNUSED CONDUIT PLUGGED WITH STEEL WOOL BEFORE PLUG SEAL IS INSTALLED. TRAFFIC CONTROL CABINET SHALL BE ORIENTED SO THAT THE DOOR DOES NOT FACE THE ROADWAY.
4. ALL SIGNAL HEADS SHALL HAVE RED, YELLOW AND GREEN LED SIGNALS WITH A VISIBLE BEAM SPREAD OF 80 DEGREES OFF AXIS.
5. ALL SIGNAL EQUIPMENT SHALL BE PAINTED FLAT BLACK IN ACCORDANCE WITH THE SPECIAL PROVISIONS.
6. ALL SIGNAL EQUIPMENT AND MAST ARM SIGNS SHALL HAVE SAFETY CABLES.
7. A BYPASS SWITCH WILL BE REQUIRED ON THE METER SOCKET TO ALLOW FOR MAINTENANCE ON THE METER.
8. A DISCONNECT BREAKER FOR EACH CIRCUIT SHALL BE INSTALLED IN A RAINPROOF (NEMA 3R), LOCKED CABINET ON A STANCHION NEXT TO OR BELOW THE METER SOCKET. A SECONDARY DISCONNECT SHALL BE INSTALLED ON THE CONTROLLER CABINET FOR MAINTENANCE PURPOSES.

## B. SIGNAL OPERATION

1. SWITCH-OVER TO NEW SIGNAL SYSTEM SHALL NOT BE DONE DURING PEAK TRAFFIC PERIODS. UNIFORMED TRAFFIC OFFICERS SHALL CONTROL TRAFFIC DURING SWITCH-OVER.
2. ALL SIGNALS SHALL DWELL ON THE VT 100 THRU MOVEMENT.
3. THE VT 100 THRU PHASE SHALL BE USED FOR THE START-UP PHASE FOLLOWING FLASHING OPERATION.
4. SIGNAL TIMING SHOWN ON THE PLANS MAY REQUIRE FINE-TUNING IN THE FIELD BASED ON TRAFFIC OBSERVATION AND/OR ADDITIONAL FIELD STUDIES. ADJUSTMENTS REQUESTED BY THE ENGINEER SHALL BE MADE WITHIN A 48 HOUR PERIOD AND PAYMENT SHALL BE INCIDENTAL TO ITEM 678.15. SIGNAL TIMING CHANGES INVOLVING THE EXISTING COORDINATED TRAFFIC SIGNALS SHALL BE MADE IN COLLABORATION WITH THE TRAFFIC DESIGN SECTION COORDINATED THROUGH THE ENGINEER.

## C. PULLBOXES AND JUNCTION BOXES

1. PULLBOXES AND JUNCTION BOXES ARE DETAILED ON STANDARD E-173. MINIMUM JUNCTION BOX SIZE SHALL BE 18" x 12" x 12", OR LARGER AS REQUIRED BY THE ELECTRICAL CODE.
2. THE LOGO ON PULLBOXES AND JUNCTION BOXES SHALL BE "TRAFFIC SIGNAL" EXCEPT THE LOGO ON THE THE JUNCTION BOX AT STA 27+41 SHALL BE "STREET LIGHTING".
3. ALL PULLBOXES / JUNCTION BOXES SHALL BE INSTALLED IN ACCORDANCE WITH SECTION 678.

## D. TRAFFIC SIGNAL CONDUIT

1. ALL TRAFFIC SIGNAL WIRED CONDUIT SHALL BE 2-INCH SCHEDULE 80 PVC.
2. WHEN CONDUIT IS PLACED BELOW THE ROADWAY OR ACROSS SIDE ROADS, IT SHALL BE PLACED IN A STEEL SLEEVE, SIZE AS SHOWN ON THE PLANS.
3. TRAFFIC SIGNAL WIRED CONDUIT SHALL ENTER THE CONTROLLER CABINET THROUGH THE OPENING IN THE CONCRETE BASE, CONDUIT SHALL NOT BE CAST IN CONCRETE.
4. ALL TRAFFIC SIGNAL CONDUIT WORK SHALL BE PERFORMED IN ACCORDANCE WITH SECTION 678.

## E. VIDEO DETECTION CAMERAS


1. VIDEO VEHICLE DETECTORS SHALL BE PLACED SO THAT OCCLUSION IS MINIMIZED AND PHASING IS NOT AFFECTED.
2. VIDEO VEHICLE DETECTION AREAS SHALL EXTEND 5 FT PAST THE STOP BAR.
3. VIDEO VEHICLE DETECTION SYSTEM SHALL BE ECONOLITE AUTOSCOPE ENCORE OR ITERIS VERSICAM OR TRAFICON VIP SERIES.
4. VIDEO VEHICLE DETECTORS SHALL BE WIRED WITHOUT ANY SPLICES FROM THE CAMERA TO THE CONTROLLER.

## F. MAST ARM FOUNDATIONS

1. SEE THE CONTRACT DOCUMENTS FOR THE GEOTECHNICAL ANALYSIS.


## G. GENERAL

1. TRAFFIC SIGNAL HEADS SHALL BE SECURELY COVERED UNTIL THEY ARE FULLY OPERATIONAL.
2. THE CONTRACTOR SHALL ACQUIRE ALL THE NECESSARY PERMITS AND MAKE ALL NECESSARY ARRANGEMENTS WITH THE UTILITY COMPANY TO PROVIDE A PERMANENT POWER SUPPLY TO THE TRAFFIC SIGNAL EQUIPMENT, IF APPLICABLE. THE ROUTING OF POWER TO THE INTERSECTION SHALL BE SUCH THAT THE STATE HAS FULL RESPONSIBILITY FROM THE TRANSFORMER THROUGH THE SIGNAL. NO INTERVENING OWNERSHIP/ RESPONSIBILITY SHALL BE ALLOWED.
3. ALL ELECTRICAL WORK INCLUDING WIRING SHALL BE DONE BY A LICENSED ELECTRICIAN AND OVERSEEN BY A MASTER ELECTRICIAN.

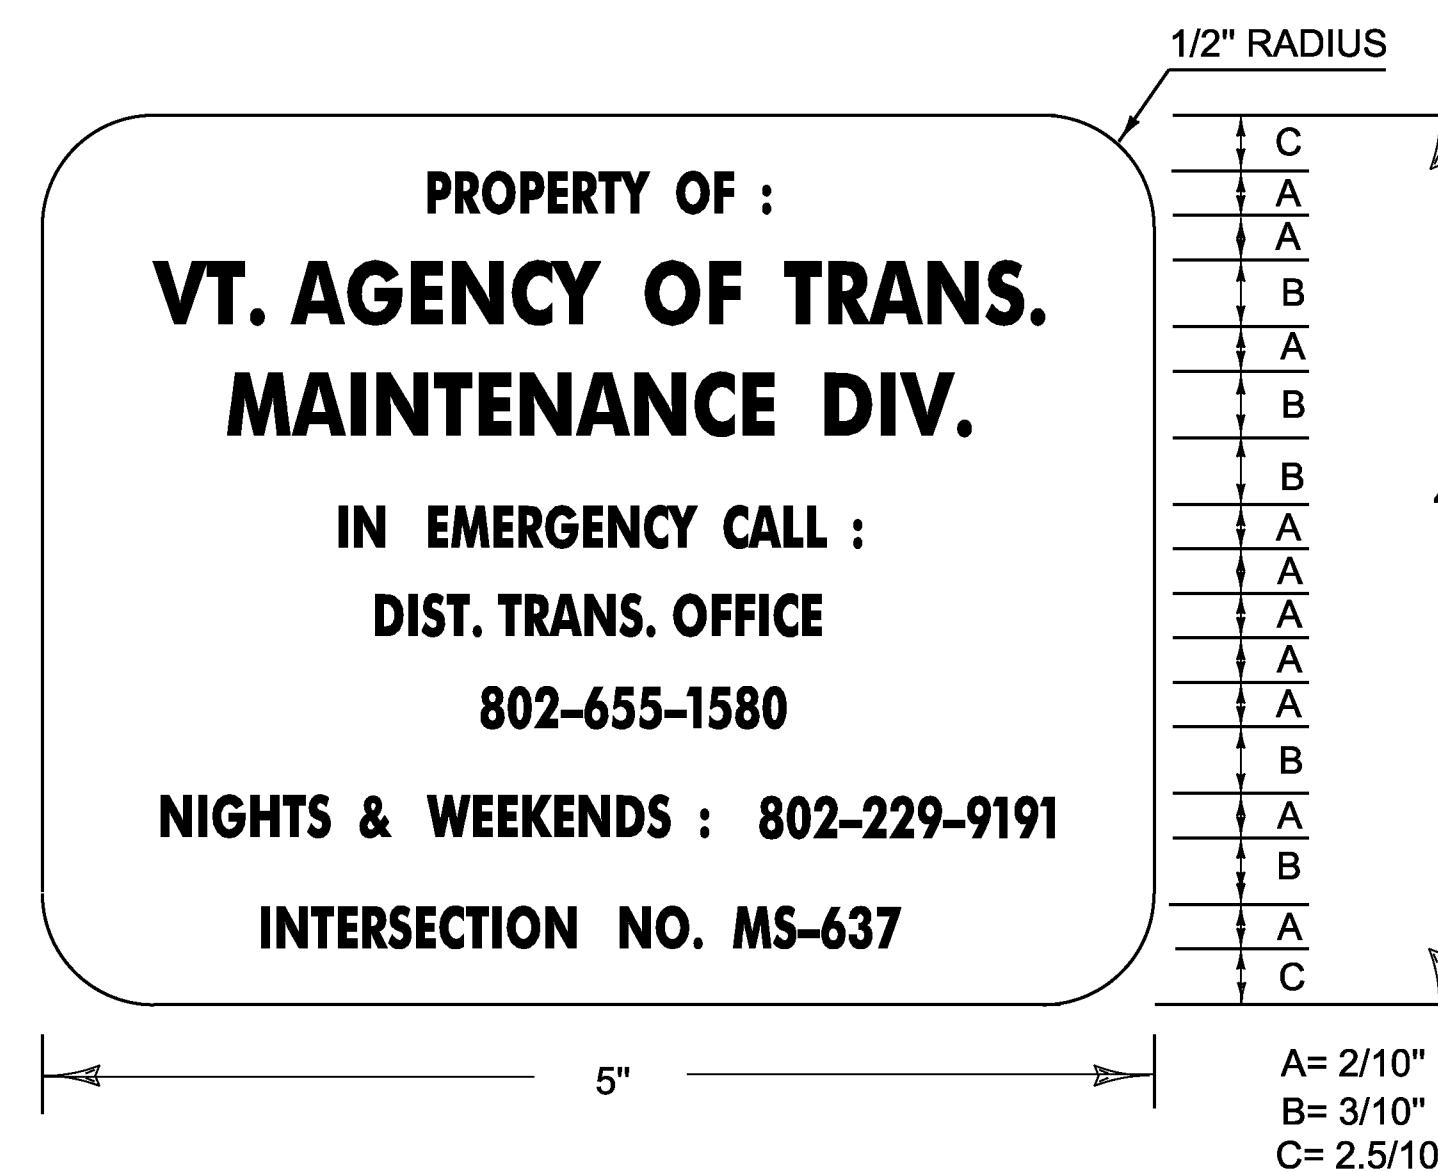

### CONTROLLER PLAQUE DETAIL

NOT TO SCALE

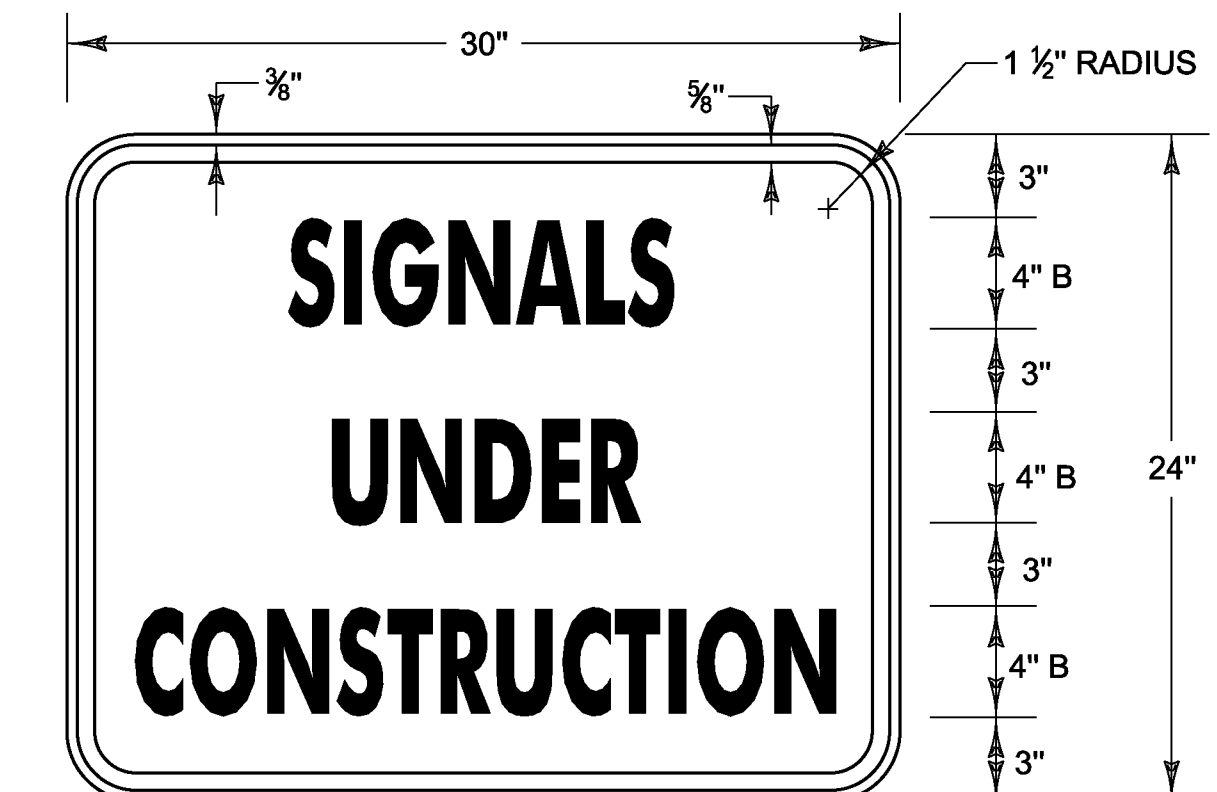

MATERIALS: SEE STD. E-144  
COLORS: TEXT & BORDER - BLACK  
BACKGROUND - ORANGE (RETROREFLECTIVE SHEETING)

### CONSTRUCTION SIGN DETAIL

NOT TO SCALE  
TO BE INSTALLED ON ROAD WORK AHEAD SIGN POSTS.

LEGEND: - BLACK (NON-REFL.) - STAMPED PRIOR TO PAINTING  
BACKGROUND: NATURAL ALUMINUM OR BRASS SURFACE

## NOTES:

- 1.) THE PLAQUE SHALL BE MOUNTED ON ALL TRAFFIC SIGNAL CONTROLLER CABINETS. IT SHALL BE FASTENED TO THE CONTROLLER CABINET IN SUCH A MANNER AS TO BE NOT EASILY REMOVED, SUCH AS WELDED, RIVETED OR BOLTED WITH VANDAL PROOF BOLTS.
- 2.) THE LETTERS SHALL BE PUNCHED OR STAMPED, SUCH STAMPING SHALL PENETRATE AT LEAST 1/2 THE BASE MATERIAL THICKNESS.
- 3.) THE BASE MATERIAL FOR THE PLAQUE SHALL BE BRASS OR ALUMINUM WITH A MINIMUM THICKNESS OF 0.100 INCHES.

PROJECT NAME: WATERBURY  
PROJECT NUMBER: NHG SGNL(43)

FILE NAME: t13b018traf.dgn  
PROJECT LEADER: P. COBURN  
DESIGNED BY: I. DEGUTIS  
TRAFFIC SIGNAL PROJECT NOTES 1

PLOT DATE: 12/31/2013  
DRAWN BY: I. DEGUTIS  
CHECKED BY: M. LACROIX  
SHEET 10 OF 17

# TRAFFIC SIGNAL GENERAL NOTES

1. ALL MATERIALS AND CONSTRUCTION SHALL CONFORM TO THE STATE OF VERMONT, AGENCY OF TRANSPORTATION'S STANDARD SPECIFICATIONS FOR CONSTRUCTION, DATED 2011, AND ITS LATEST REVISIONS.

2. OVERHEAD SIGN/SIGNAL SUPPORTS SHALL CONFORM TO AASHTO'S PUBLICATION ENTITLED "STANDARD SPECIFICATIONS FOR STRUCTURAL SUPPORTS FOR HIGHWAY SIGNS, LUMINAIRES, AND TRAFFIC SIGNALS", DATED 2009 AND ITS LATEST REVISION.

3. THE DESIGN CALCULATIONS SHALL TAKE INTO ACCOUNT THE FOLLOWING CRITERIA:

**STRUCTURE CRITERIA**

DESIGN LIFE: 50 YEARS  
WIND LOAD - 90 MPH, UNLESS SPECIAL SITE CONDITIONS DICTATE  
ICE LOAD PER AASHTO'S PUBLICATION ENTITLED "STANDARD SPECIFICATIONS FOR STRUCTURAL SUPPORTS FOR HIGHWAY SIGNS, LUMINAIRES, AND TRAFFIC SIGNALS", DATED 2009 AND ITS LATEST REVISIONS

**FATIGUE CRITERIA**

FATIGUE CATEGORY:  
1 FOR MAST ARM SIGN STRUCTURES, 2 FOR SIGNAL MAST ARMS  
VORTEX SHEDDING: INCLUDE  
NATURAL WIND GUSTS: INCLUDE  
TRUCK INDUCED WIND GUSTS: INCLUDE FOR ROADWAYS WHERE SPEED LIMIT IS 40 MPH OR GREATER.  
GALLOPING: DO NOT INCLUDE IN DESIGN CALCULATIONS

**FOUNDATION CRITERIA**

CONCRETE: CONCRETE, HIGH PERFORMANCE CLASS B, STATE OF VERMONT, AGENCY OF TRANSPORTATION'S "STANDARD SPECIFICATIONS FOR CONSTRUCTION", DATED 2011, SECTION 501.  
REINFORCING STEEL: STATE OF VERMONT, AGENCY OF TRANSPORTATION'S "STANDARD SPECIFICATIONS FOR CONSTRUCTION", DATED 2011, SUBSECTION 713.01.  
ALLOWABLE BEARING CAPACITY: TO BE DETERMINED BY THE CONTRACTOR IN ACCORDANCE WITH MREI 10-01  
INTERNAL SOIL FRICTION ANGLE,  $\phi$ : TO BE DETERMINED BY THE CONTRACTOR IN ACCORDANCE WITH MREI 10-01

4. ANCHOR BOLTS

FOUR STAINLESS STEEL ANCHOR BOLTS WITH TWO HEXAGON NUTS, ONE WASHER AND ONE LOCK WASHER PER BOLT SHALL BE FURNISHED WITH EACH POLE. ANCHOR BOLT PLATES, WHEN USED, SHALL ALSO BE STAINLESS STEEL. SEE SUBSECTION 714.09.

5. FLANGE BOLTS

ALL FLANGE BOLTS AND HEX NUTS SHALL BE HIGH STRENGTH STEEL AND SHALL CONFORM TO ASTM A325. THE FLANGE BOLTS SHALL BE CAPABLE OF RESISTING 133% OF THE FULL DESIGN STRESS OF THE TUBE AT ITS YIELD STRENGTH STRESS.

6. HORIZONTAL AND VERTICAL MEMBERS

STEEL TUBES SHALL BE FORMED AND WELDED WITH ONE CONTINUOUS LONGITUDINAL WELD ONLY. AFTER FORMING AND WELDING THEY SHALL BE COLD ROLLED TO ENSURE UNIFORMITY OF SIZE AND SMOOTHNESS OF WELD. THERE SHALL BE NO TRANSVERSE WELDING EXCEPT AT THE FLANGE CONNECTIONS AND POLE BASE PLATES, WHERE THE TUBES SHALL TELESCOPE THE FLANGES AND PLATES AND BE CONTINUOUSLY WELDED BOTH SIDES, INSIDE AND OUT TO WITHSTAND THE FULL TRANSFER OF THE BENDING STRENGTH TO THE BOLTS. OPTIONALLY, THE MEMBERS MAY BE A SERIES OF TWO OR THREE DIFFERENT DIAMETER PIPES WELDED TOGETHER. STEEL TUBES SHALL BE CONSTRUCTED FROM MATERIALS CONFORMING TO STATE OF VERMONT, AGENCY OF TRANSPORTATION'S "STANDARD SPECIFICATIONS FOR CONSTRUCTION", DATED 2011, SUBSECTION 752.02.

7. GALVANIZING

ALL STEEL COMPONENTS, EXCEPT CONCRETE REINFORCING AND STAINLESS STEEL HARDWARE, ARE TO BE HOT DIPPED GALVANIZED AFTER FABRICATION. THE ASSEMBLIES SHALL BE DESIGNED AND FABRICATED TO PERMIT GALVANIZING ON ALL INTERIOR AND EXTERIOR SURFACES AND SHALL BE FREE OF POCKETS AND OTHER STRUCTURAL OBSTRUCTIONS THAT WILL NOT PERMIT PROPER DEPOSITION OF ZINC COATING. GALVANIZING SHALL BE IN ACCORDANCE WITH SUBSECTION 752.02.

8. WELDING

A. WELDING SHALL BE PERFORMED PER SUBSECTION 506.10.

B. ALL WELDS SHALL BE AT LEAST AS STRONG AS THE MATERIAL(S) BEING WELDED.

9. FOUNDATIONS

A. FOUNDATIONS SHALL BE DESIGNED IN ACCORDANCE WITH THE STATE OF VERMONT, AGENCY OF TRANSPORTATION'S MATERIALS AND RESEARCH ENGINEERING INSTRUCTION - GEOTECHNICAL DESIGN PROCEDURES FOR MAST ARM AND OVERHEAD SIGN SUPPORT FOUNDATIONS (MREI 10-10), DATED MARCH 9, 2010. A COPY OF WHICH CAN BE FOUND ON THE AGENCY'S WEBSITE: WWW.AOT.STATE.VT.US

B. FOUNDATIONS SHALL BE CONSTRUCTED IN ACCORDANCE WITH THE FOLLOWING NOTES:

1. SPREAD FOOTINGS SHALL HAVE A MINIMUM EMBEDMENT OF FIVE FEET OR SHALL BEAR DIRECTLY ON LEDGE. THE EMBEDMENT SHALL BE MEASURED FROM THE GROUND SURFACE ELEVATION TO THE BOTTOM OF THE FOOTING ELEVATION.

2. EXCEPT FOR THE UPPERMOST 2 FT OF SOIL, THE DRILLED SHAFT FOUNDATION SHALL BE POURED AGAINST UNDISTURBED MATERIAL; THE TOP 2 FT OF SOIL SHALL BE NEGLECTED FOR DESIGN PURPOSES. A DISPOSABLE CIRCULAR CONCRETE FORM, IF USED, SHALL NOT BE PLACED DEEPER THAN 2FT, IN ORDER NOT TO REDUCE THE FRICTION BETWEEN THE SOIL AND THE CONCRETE.

3. AS AN ALTERNATIVE TO THE DRILLED HOLES, FOOTINGS MAY BE POURED IN EXCAVATED HOLES USING THE PROPER FORMS, WHICH MUST BE REMOVED. THE EXCAVATED HOLES SHALL BE AT LEAST TWO FEET CLEAR OF THE FOUNDATION SIDES AND ONE FOOT DEEPER THAN THE FOUNDATION. CARE SHOULD BE TAKEN TO AVOID EXCAVATING AROUND THE TOP OF THE FOUNDATION. THE BACKFILL MATERIAL SHALL BE COMPACTED AS DESCRIBED IN SUBSECTION 204.08. DESIGN LIMITS AS FOR AUGERED FOOTINGS APPLY.

4. BACKFILL MATERIAL PLACED ADJACENT TO THE FOUNDATION SHALL MEET THE REQUIREMENTS FOR GRANULAR BACKFILL FOR STRUCTURES, SUBSECTION 704.08. BACKFILL MATERIAL SHALL BE COMPACTED AS DESCRIBED IN SUBSECTION 204.08.

5. CONCRETE FOR THE FOUNDATION SHALL CONFORM TO THE REQUIREMENTS OF SECTION 501, HPC STRUCTURAL CONCRETE, CLASS B. IF DRILLED SHAFT FOUNDATIONS ARE REQUIRED, THE CONCRETE SPECIFICATIONS MAY NEED TO BE ADJUSTED FOR CONSTRUCTABILITY ISSUES. HOWEVER, IF REQUIRED, THE CONTRACTOR SHALL SUBMIT ANY CHANGES TO THE CONCRETE SPECIFICATION FOR REVIEW BY THE VTRANS PROJECT MANAGER.

6. STEEL PILES SHALL MEET THE REQUIREMENTS SECTION 505.

7. WHEN THE DESIGN DEPTH OF A FOUNDATION CANNOT BE OBTAINED DUE TO UNFORESEEN FIELD CONDITIONS, THE CONTRACTOR SHALL NOTIFY THE ENGINEER FOR THE MANUFACTURER TO OBTAIN A REVISED FOUNDATION DESIGN. SUCH A REVISION SHALL BE SUBMITTED TO THE ENGINEER FOR REVIEW BY THE AGENCY PROJECT MANAGER AND MAY REQUIRE UP TO A 4 WEEK REVIEW PERIOD BY VTRANS.

C. SIGNALS/SIGNS SHALL BE INSTALLED AND LEVELED AND POLES SHALL BE PLUMB PRIOR TO PLACING GROUT UNDER POLE BASE. GROUT MATERIAL SHALL BE NON-SHRINKING MORTAR CONFORMING TO SUBSECTION 707.03, MORTAR TYPE IV.

10. EACH OVERHEAD TRAFFIC SIGNAL/SIGN SUPPORT SHALL BE GROUNDED. THE GROUND SHALL CONSIST OF:

A. AN INTERNAL GROUND LUG OPPOSITE THE HAND HOLE.

B. A #6 AWG (MIN.) SOFT DRAWN COPPER GROUNDING ELECTRODE CONDUCTOR.

C. A 5/8 IN. X 8 FT (MIN) COPPER CLAD GROUNDING ELECTRODE. THE RESISTANCE TO GROUND SHALL BE 25 OHMS OR LESS. ADDITIONAL GROUNDING ELECTRODES MAY BE REQUIRED (MINIMUM SPACING SHALL BE 6 FT). WHEN A POWER SERVICE, METER AND DISCONNECT ARE ATTACHED TO A POLE, THERE SHALL BE A CONTINUOUS GROUNDING ELECTRODE CONDUCTOR FROM THE METER AND DISCONNECT WHICH MAY RUN INTERNAL TO THE UPRIGHT, THROUGH THE 1/2 IN. FLEXIBLE TUBING IN THE CONCRETE BASE TO THE REQUIRED GROUNDING ELECTRODE(S). THE GROUNDING ELECTRODE CONDUCTOR FROM THE POLE GROUNDING LUG, CONTROLLER CABINET AND/OR LUMINAIRE MAY ATTACH TO THIS CONTINUOUS GROUNDING ELECTRODE CONDUCTOR FROM THE SERVICE METER AND DISCONNECT. THE CONTRACTOR SHALL PERFORM A RESISTANCE TO GROUND TEST ON THE CONTINUOUS GROUNDING ELECTRODE CONDUCTOR FROM THE SERVICE METER AND DISCONNECT, AND PROVIDE A WRITTEN STATEMENT TO THE AREA ELECTRICAL INSPECTOR THAT THE GROUNDING ELECTRODE CONDUCTOR IS CONTINUOUS FROM THE SERVICE METER AND DISCONNECT AND THE RESISTANCE TO GROUND IS 25 OHMS OR LESS.

11. HORIZONTAL MEMBERS SHALL BE CAMBERED AND THE VERTICAL POLES BACK RAKED (WHERE APPLICABLE) TO THE ANTICIPATED DEAD LOAD DEFLECTION PLUS THE CAMBER, IF ANY, SPECIFIED ON THE PLANS.

12. AN EQUIVALENT ALTERNATE DESIGN MAY BE SUBSTITUTED FOR THE DETAILS AND MATERIALS SHOWN.

13. THE DETAILS OF DESIGN FOR THE STRUCTURE AND FOUNDATION ARE TO BE SUPPLIED BY THE CONTRACTOR AND/OR BY THE MANUFACTURER. THE STRUCTURE SHALL BE DESIGNED TO RESIST THE MAXIMUM LOADING AS OUTLINED IN THE AASHTO STANDARD SPECIFICATIONS (SEE NOTE 2). ALL DESIGN CALCULATIONS FOR THE STRUCTURE AND THE FOUNDATION SHALL BE CHECKED AND STAMPED BY A LICENSED PROFESSIONAL ENGINEER REGISTERED IN THE STATE OF VERMONT PRIOR TO SUBMITTAL OF THE FABRICATION DRAWINGS TO THE VERMONT AGENCY OF TRANSPORTATION.

14. THE CONTRACTOR SHALL SUBMIT THE DESIGN CALCULATIONS, IN A DIGITAL FORMAT TO THE VERMONT AGENCY OF TRANSPORTATION, PROJECT MANAGER, SHOWING THE FOLLOWING INFORMATION FOR EACH OF THE VERTICAL AND HORIZONTAL COMPONENTS OF THE STRUCTURE AND FOUNDATION:

A. THE DESIGN AXIAL AND SHEAR FORCES AND BENDING AND TORSIONAL MOMENTS ACTING AT THE TOP OF THE FOUNDATION.

B. THE DESIGN AXIAL, BENDING AND SHEAR STRESSES AND THE COMBINED STRESS RATIO.

C. VIBRATION AND FATIGUE CALCULATIONS AS SET FORTH IN SECTION 11 OF THE AASHTO PUBLICATION REFERENCED IN NOTE 2.

D. THE ALLOWABLE AXIAL, BENDING, AND SHEAR STRESSES.

E. ITEMS A, B, D SHALL BE SHOWN FOR EACH OF THE GROUP LOADINGS (I, II, III) AND FOR THE BASIC WIND LOAD APPLIED TO THE TWO CASES OUTLINED IN THE AASHTO STANDARD SPECIFICATIONS (SEE NOTE 2) SECTION 1.2.5(D)(4).

F. FAILURE TO SUPPLY THE PROPER DESIGN INFORMATION SHALL BE CAUSE FOR REJECTION OF THE STRUCTURE.

G. A MINIMUM OF FOUR (4) WEEKS SHALL BE REQUIRED FOR REVIEW BY THE VERMONT AGENCY OF TRANSPORTATION.

H. EVERY MEMBER AND CONNECTION IN AN OVERHEAD TRAFFIC SIGNAL SUPPORT SHALL BE DESIGNED TO PROVIDE ADDITIONAL RESIDUAL CAPACITY FOR FUTURE MODIFICATION EQUIVALENT TO A 5-SECTION TRAFFIC SIGNAL HEAD WITH A 5 INCH LOUVERED BACKPLATE LOCATED ON THE OUTERMOST EXTENT OF THE MAST ARM.

15. FABRICATION DRAWINGS IN A DIGITAL FORMAT SHALL BE SUBMITTED TO THE STATE OF VERMONT, AGENCY OF TRANSPORTATION, PROJECT MANAGER FOR APPROVAL PRIOR TO FABRICATION. THE FABRICATION DRAWINGS SHALL INCLUDE THE FOLLOWING INFORMATION:

A. DETAILED DRAWING OF EACH COMPONENT OF THE STRUCTURE.

B. MATERIAL SPECIFICATION FOR EACH COMPONENT OF THE STRUCTURE, EITHER BY COMPLETE SPECIFICATION OR REFERENCE TO APPLICABLE ASTM STANDARDS.

C. NOTATION OF PROJECT NAME, PROJECT NUMBER, ROUTE NUMBER, AND STRUCTURE STATIONING (TO BE INCLUDED ON EACH SHEET).

D. DETAILS FOR LOCATION OF SIGNS/SIGNALS AND ATTACHMENT HARDWARE FOR THE SUPPORT STRUCTURE.

E. ALL ELEVATIONS AND DIMENSIONS NECESSARY TO PROVIDE A COMPLETE SET OF RECORD PLANS.

F. DEAD LOAD DEFLECTION AND CAMBER INFORMATION.

G. WELDING DETAILS AND PROCEDURES ARE REQUIRED FOR ALL WELDS. PROCEDURES SHALL BE SUBMITTED FOR APPROVAL WITH REFERENCE TO EACH WELD IDENTIFIED ON THE FABRICATION DRAWINGS. (SEE SUBSECTION 506.10).


16. THE TRAFFIC SIGNALS SHALL BE MOUNTED TO THE ARM OR POLE USING A FIXED MOUNT SYSTEM UNLESS OTHERWISE NOTED ON THE CROSS SECTION SHEET. FOR SIGNALS MOUNTED ON A MAST ARM THE MAST ARM AND MOUNTING POINT SHALL BE IN THE MIDDLE OF THE SIGNAL HEAD.

17. BASE PLATES SHALL BE STAMPED WITH THE VERTICAL POLE DIAMETER, HEIGHT, YIELD STRENGTH, GAUGE AND THE HORIZONTAL MEMBER DIAMETER, LENGTH, YIELD STRENGTH, AND GAUGE. ALTERNATELY, THE INFORMATION MAY BE STAMPED ON A METAL TAG RIVETED TO THE POLE NEAR THE HAND HOLE.

18. SEE STANDARD E-171A FOR ADDITIONAL NOTES. SEE SHEETS 3-4 FOR BORING INFORMATION.

PROJECT NAME: WATERBURY  
PROJECT NUMBER: NHG SGNL(43)

FILE NAME: t13b018traf.dgn PLOT DATE: 12/31/2013  
PROJECT LEADER: P. COBURN DRAWN BY: I. DEGUTIS  
DESIGNED BY: I. DEGUTIS CHECKED BY: M. LACROIX  
TRAFFIC SIGNAL PROJECT NOTES 2 SHEET 11 OF 17

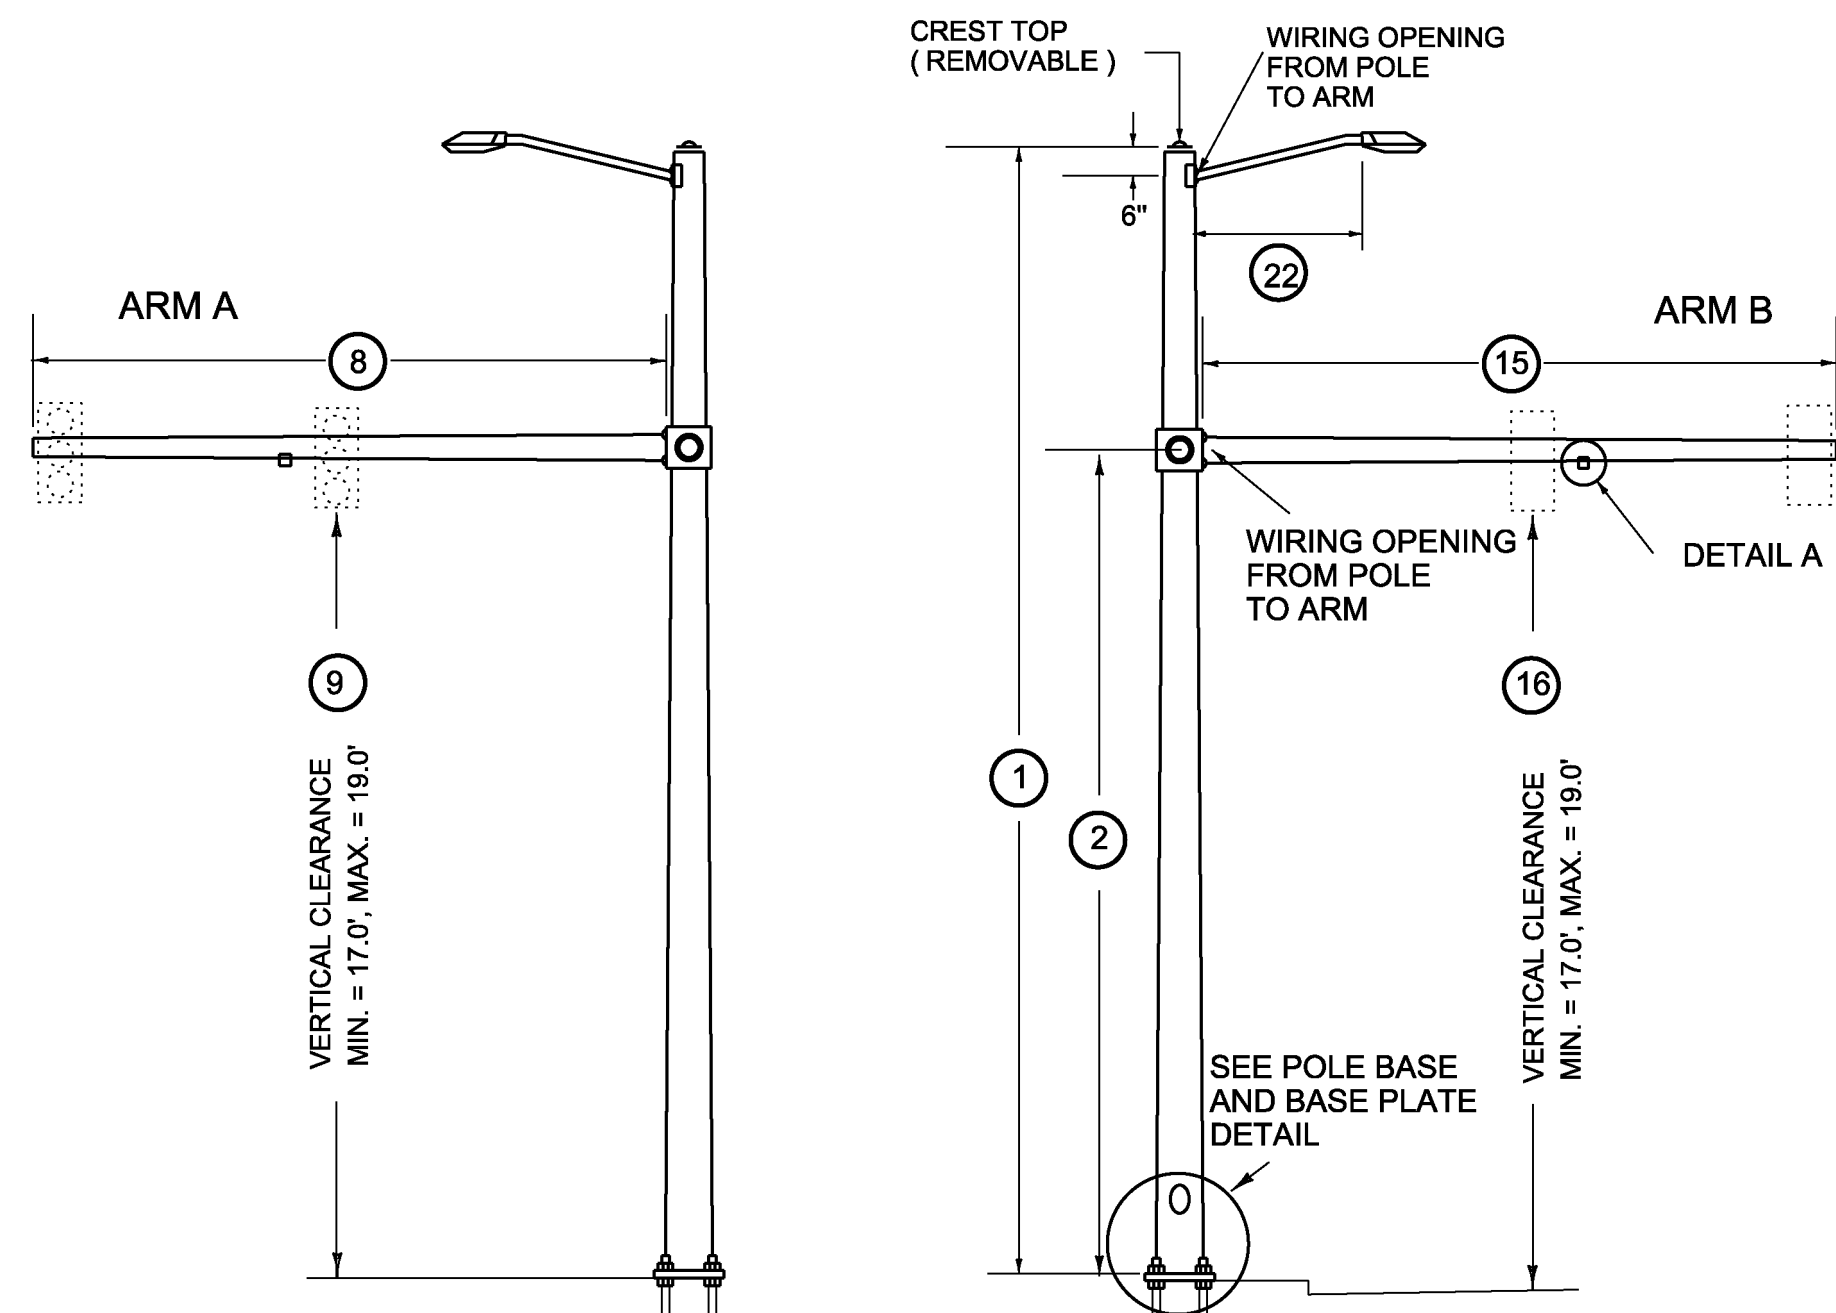


MAP1 & MAP2


- POLE BASE DIAMETER (3)
- POLE GAUGE (4)
- POLE TAPER RATE (5)

- ARM B DIAMETER (10)
- ARM B GAUGE (11)
- ARM B TAPER RATE (12)


- ARM A DIAMETER (17)
- ARM A GAUGE (18)
- ARM A TAPER RATE (19)

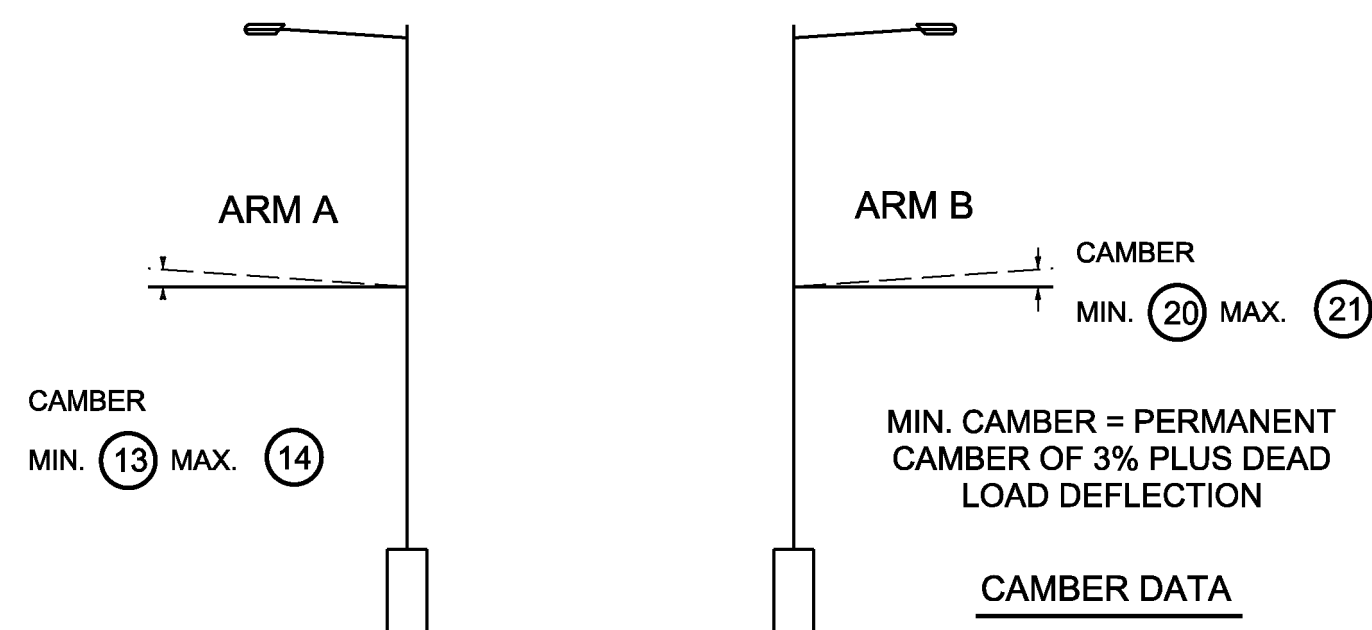


CAMBER DATA

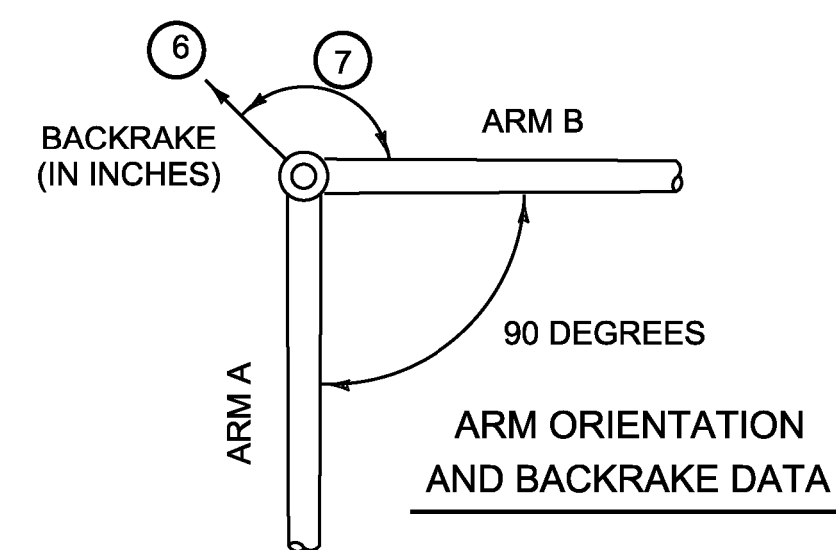

ARM ORIENTATION AND BACKRAKE DATA

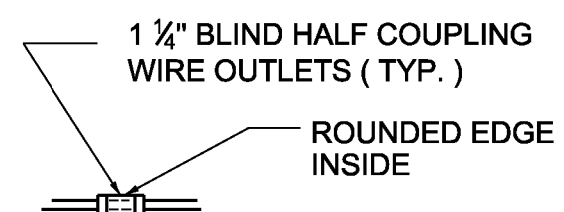


DETAIL A

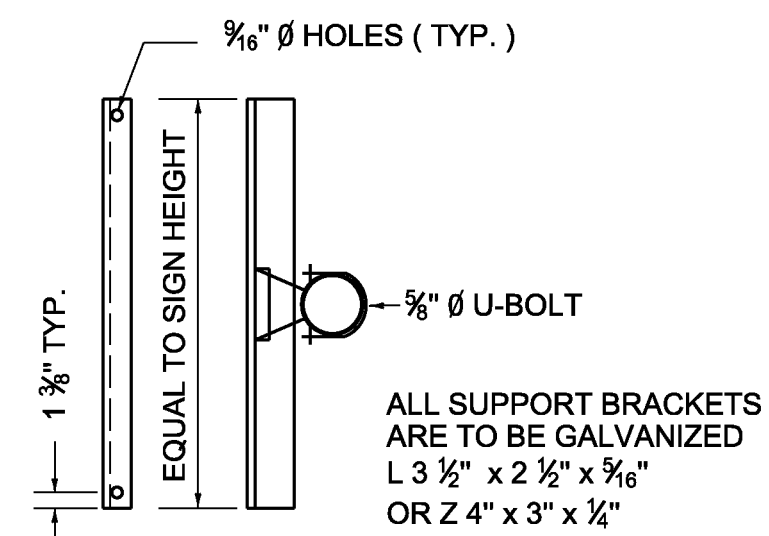


SIGN ON SINGLE MAST ARM

SIGN BRACKET DETAILS

ANCHOR BOLT DETAIL		
SIZE	L (IN)	T (IN)
1 - 1/4" X 48"	42	8
1 - 1/2" X 60"	54	9
1 - 3/4" X 90"	84	9
2" X 96"	96	9

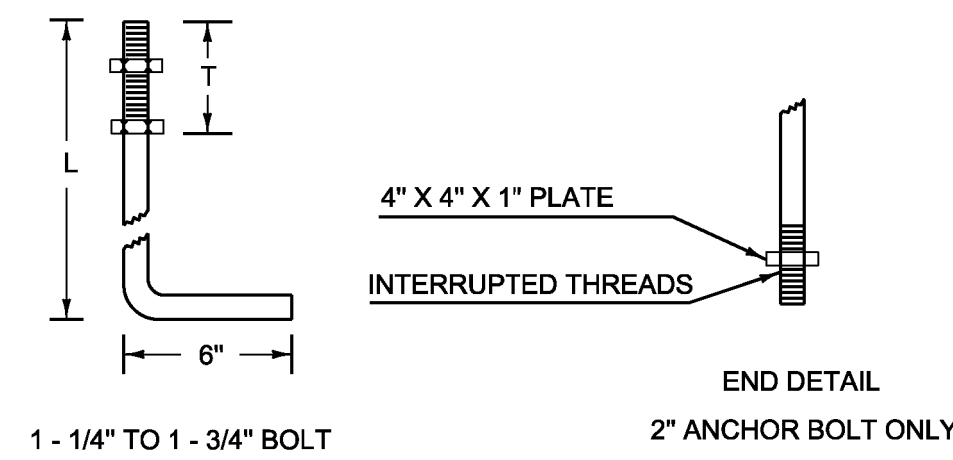


ANCHOR BOLT DETAIL

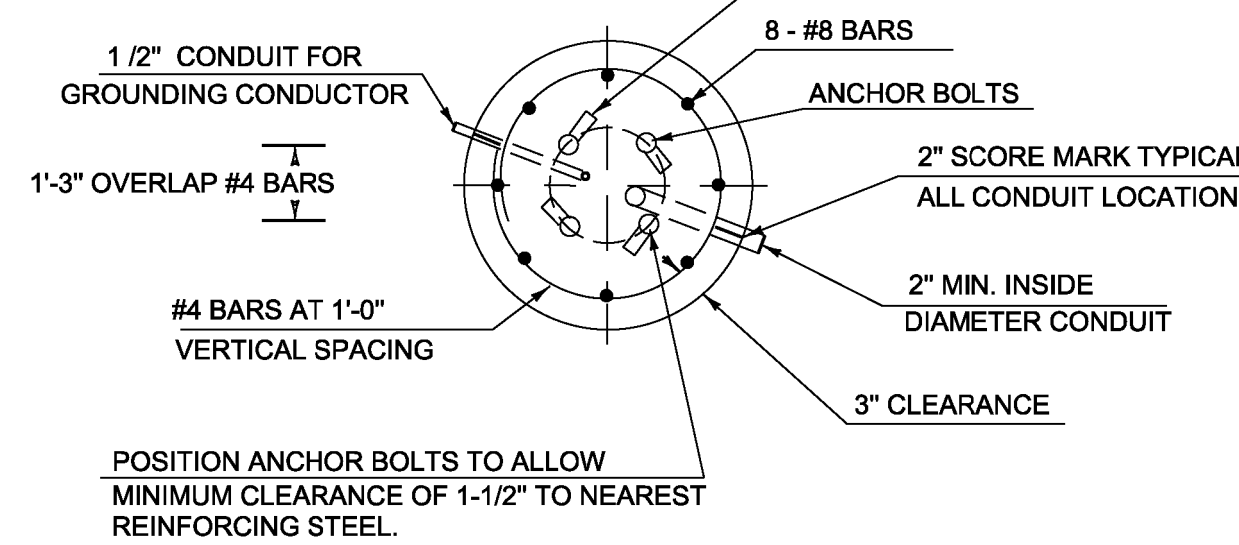

SECTION


CANTILEVER FOOTING DETAIL

(DRILLED SHAFT)

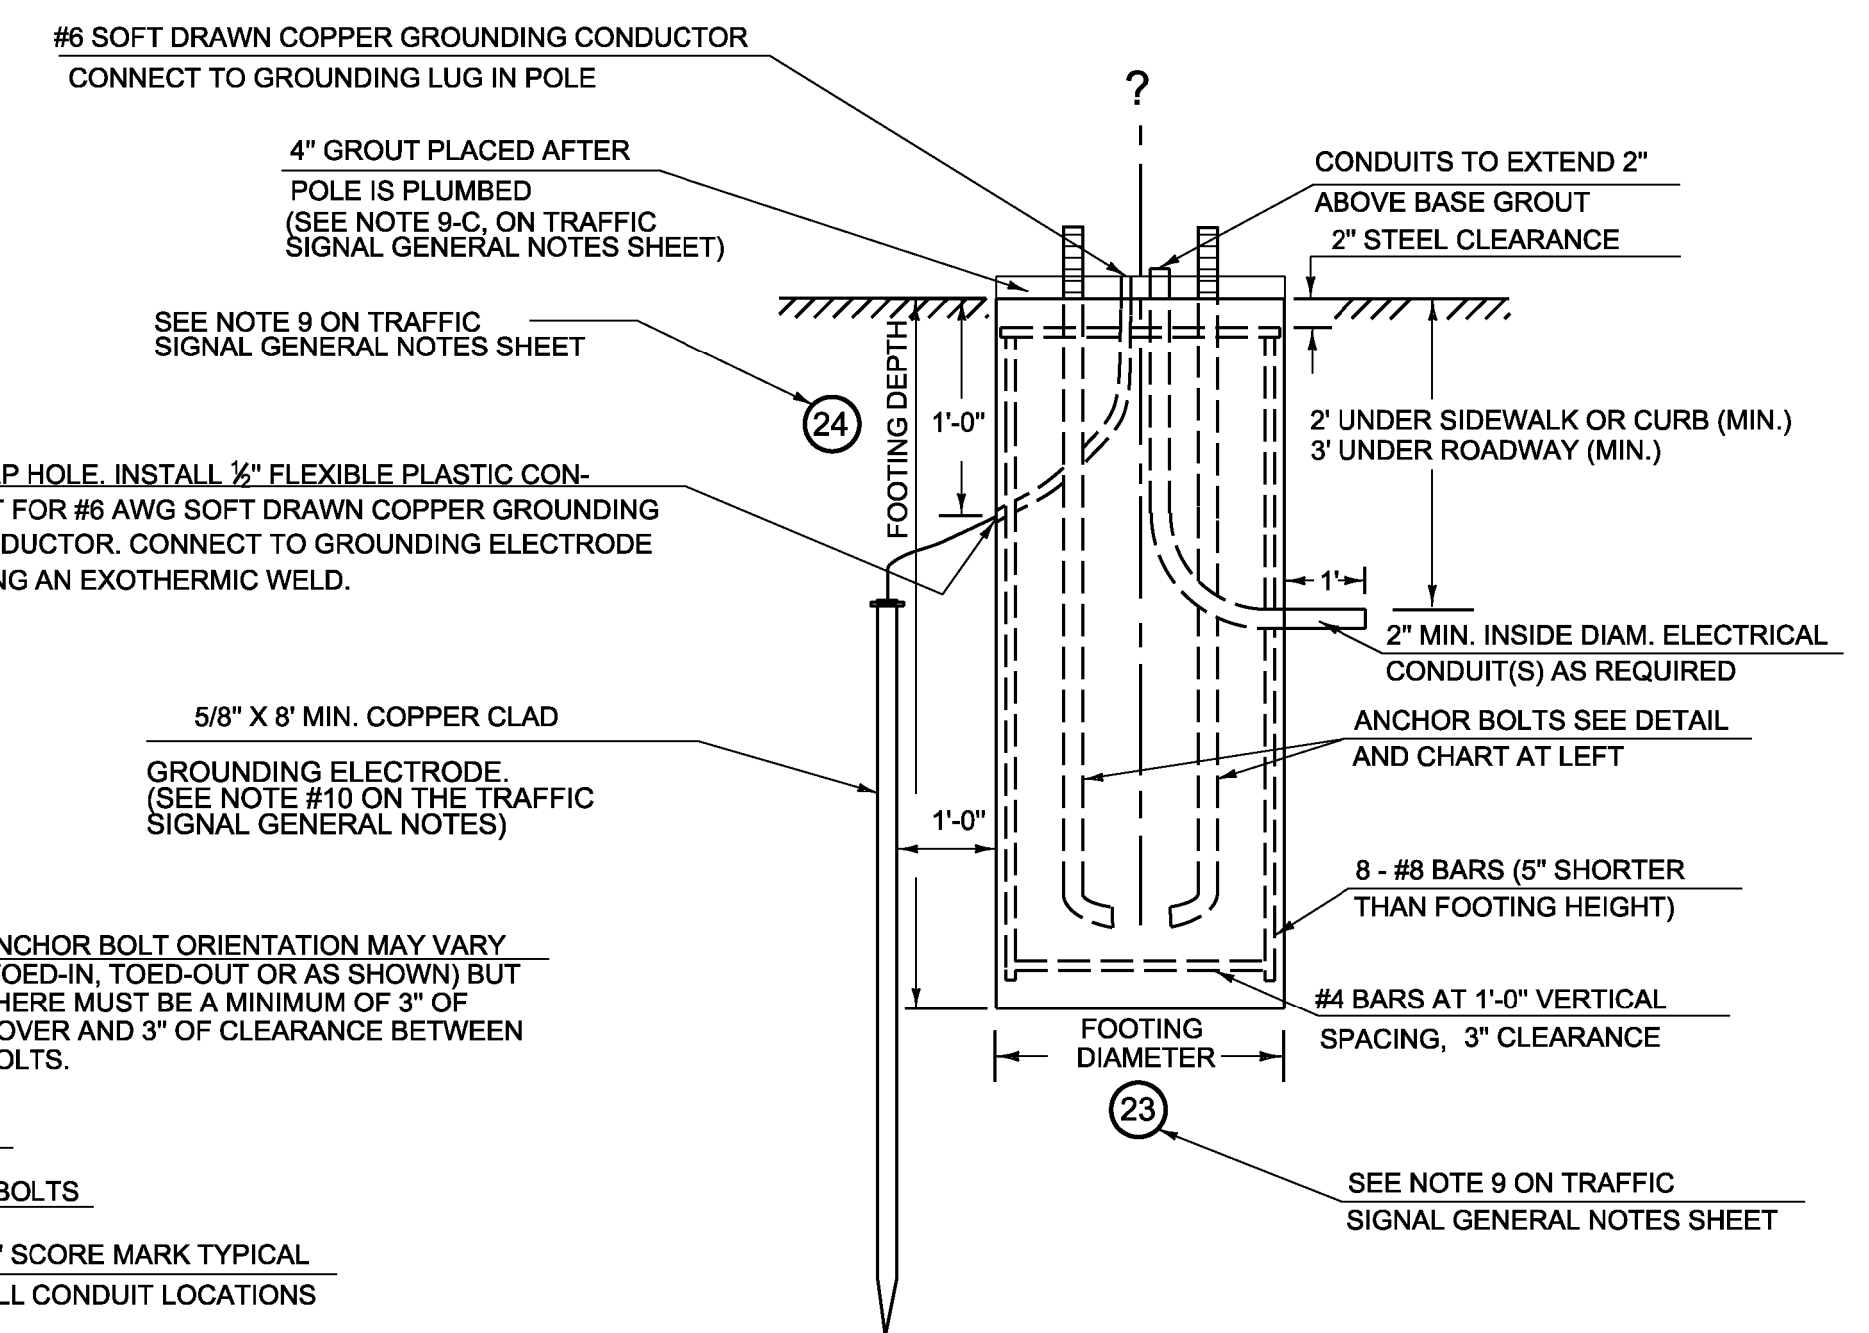


ELEVATION

N.T.S. (TYP.)

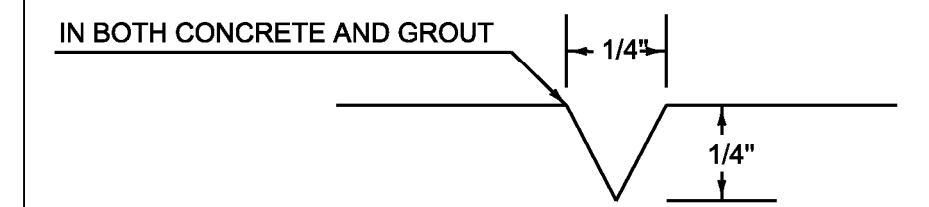


2" SCORE MARK DETAIL

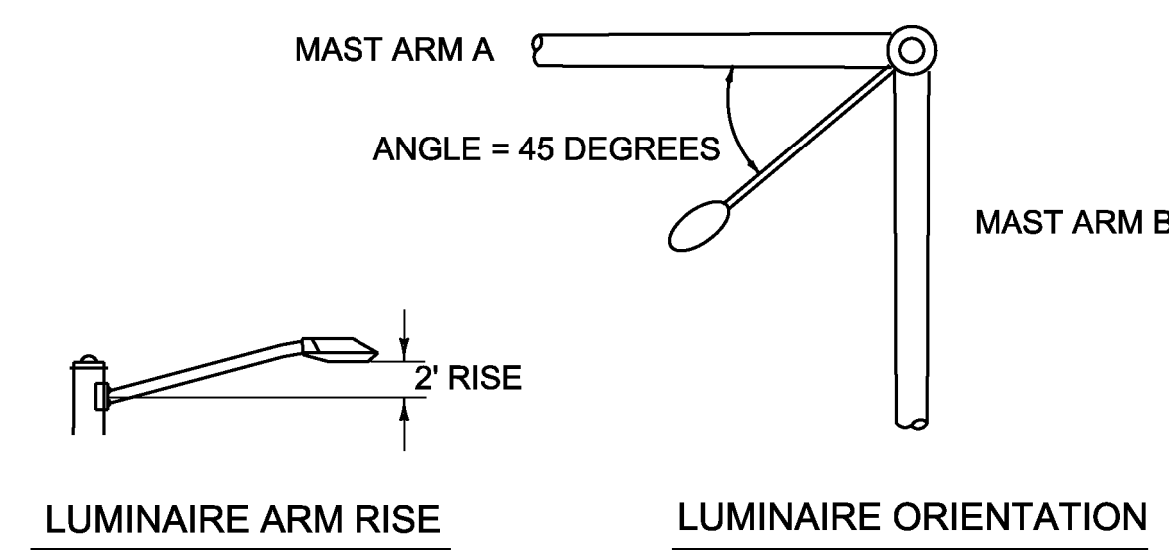

LUMINAIRE ARM RISE

LUMINAIRE ORIENTATION

GROUND WIRES SHALL BE CONNECTED TO THE GROUNDING LUG INSIDE THE HANDHOLE ACCESS.

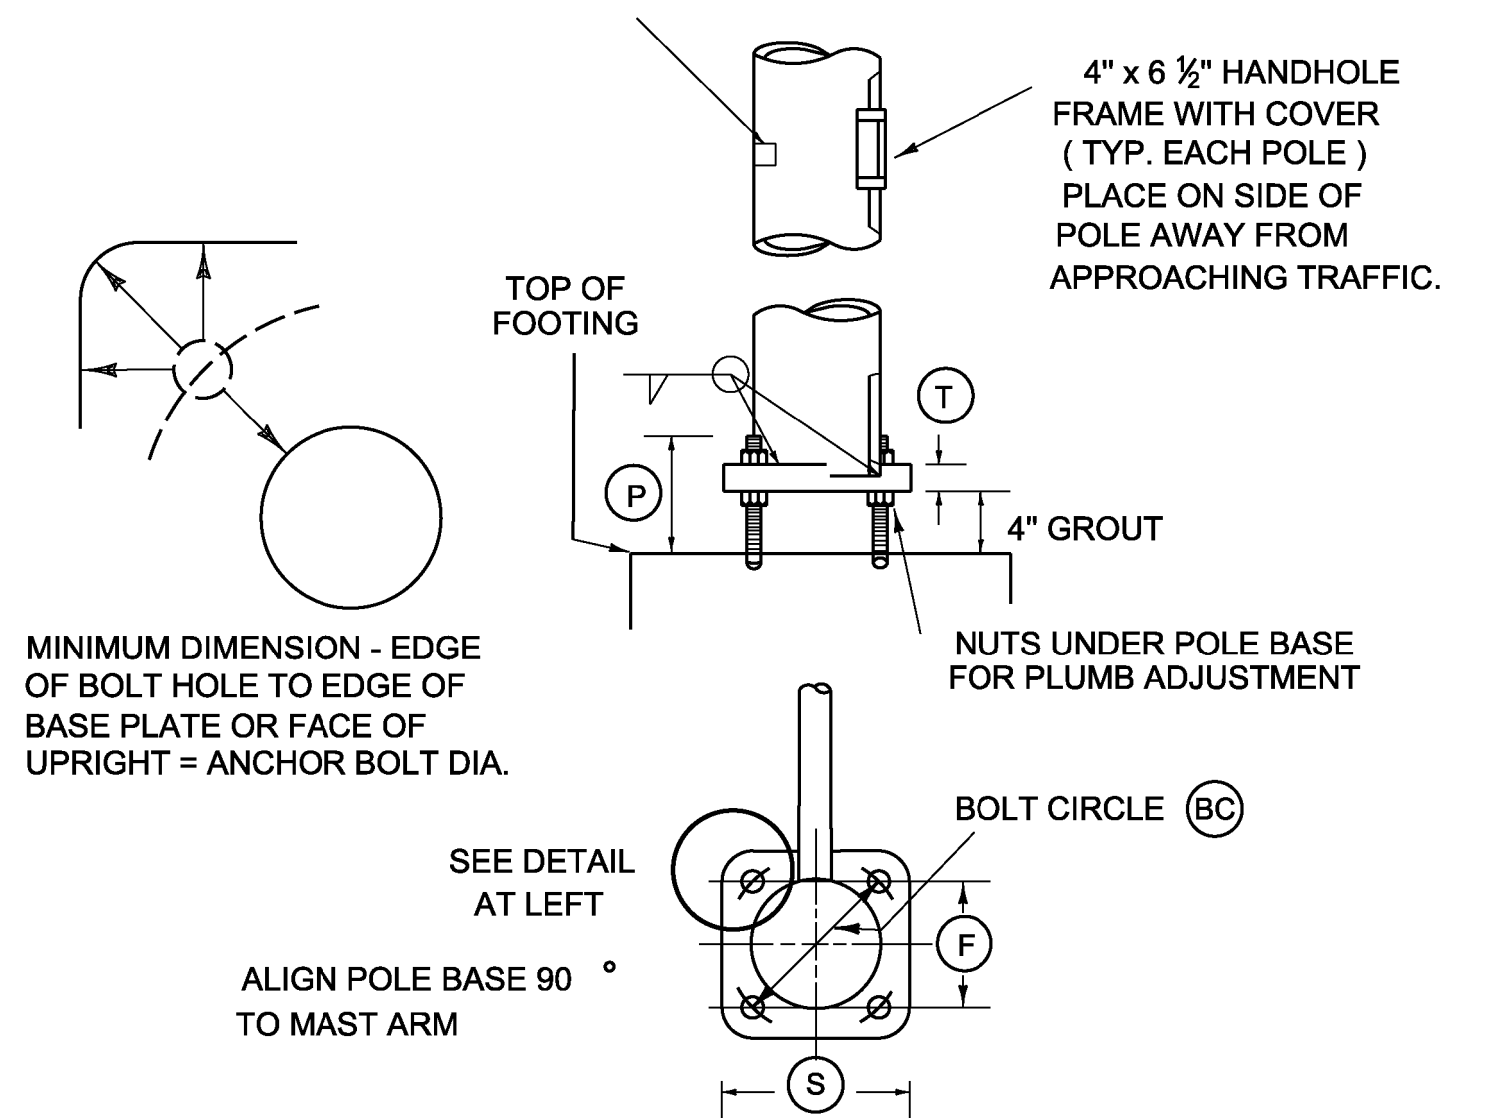

POLE BASE AND BASE PLATE DETAIL

POLE	POLE DATA							ARM DATA														FOOTING DATA		BASE PLATE / BOLT DATA						
	(1)	(2)	(3)	(4)	(5)	(6)	(7)	(8)	(9)	(10)	(11)	(12)	(13)	(14)	(15)	(16)	(17)	(18)	(19)	(20)	(21)	(22)	(23)	(24)	(BC)	(F)	(S)	(T)	(P)	ANCHOR BOLT SIZE
MAP1	30	20.5	1.083'	0.09925'	.14'			42	17'8"													16	9'6" x 9'6"	2'6"						
MAP2	30	20.5	1.083'	0.09925'	.14'			31	17'4"						34	18'						12	13' x 8'	3'6"						

NOTE: DETAILS NTS

# DOUBLE MAST ARM CANTILEVER FOOTING DETAIL SHEET

PROJECT NAME: WATERBURY  
PROJECT NUMBER: NHG SGNL(43)

FILE NAME: t13b018tr.af.dgn  
PROJECT LEADER: P. COBURN  
DESIGNED BY: I. DEGUTIS  
MAST ARM CANTILEVER FOOTING DETAILS

PLOT DATE: 12/31/2013  
DRAWN BY: I. DEGUTIS  
CHECKED BY: M. LaCROIX  
SHEET 12 OF 17

**CONTROLLER TIMING CHART**

VT ROUTE 100 & I-89 EXIT #10 NB OFF-RAMP										
PHASE	1	2	3	RAMP	4	5	VT100	6	7	8
TRAFFIC MOVEMENT	->			↓			<-			
MINIMUM GREEN	5			5			5			
MAXIMUM 1 GREEN	54			36			54			
MAXIMUM 2 GREEN	43			33			43			
MAXIMUM 3 GREEN	52			32			52			
YELLOW CLEARANCE	4.8			4.4			4.8			
ALL RED CLEARANCE	1.7			2.0			1.7			
VEH. EXTENSION	2			2			2			
RECALL MODE	SOFT				SOFT					

**CONTROLLER TIMING CHART**

VT ROUTE 100 & I-89 EXIT #10 NB OFF-RAMP										
PHASE	1	2	3	4	5	6	VT100	7	8	RAMP
TRAFFIC MOVEMENT	->						<-			↑
MINIMUM GREEN	5						5			5
MAXIMUM 1 GREEN	67						67			23
MAXIMUM 2 GREEN	54						54			22
MAXIMUM 3 GREEN	62						62			22
YELLOW CLEARANCE	4.4						4.4			4.4
ALL RED CLEARANCE	2.1						2.1			1.5
VEH. EXTENSION	2						2			2
RECALL MODE	SOFT				SOFT					-

**CONTROLLER TIMING CHART**

VT ROUTE 100 & BLUSH HILL RD/STOWE ST (TH #2)										
PHASE	1	2	3	SS	4	5	6	7	8	BH
TRAFFIC MOVEMENT	↖	<-		↑	↙		→			↓
MINIMUM GREEN	5	5		5	5	5	5			5
MAXIMUM 1 GREEN	6	64		13	6	64	13			13
MAXIMUM 2 GREEN	6	53		10	6	53	10			10
MAXIMUM 3 GREEN	6	59		12	6	59	12			12
YELLOW CLEARANCE	4.1	4.1		4.1	4.1	4.1	4.1			4.1
ALL RED CLEARANCE	2.0	2.0		2.9	2.0	2.0	2.9			2.0
VEH. EXTENSION	2	2		2	2	2	2			2
RECALL MODE	- SOFT				- SOFT					-

**CONTROLLER TIMING CHART**

VT ROUTE 100 & SHAW'S									
PHASE	1	2	3	4	5	6	7	8	SH
TRAFFIC MOVEMENT	↙	->					<-		↑
MINIMUM GREEN	5	5					5		5
MAXIMUM 1 GREEN	7	59					72		19
MAXIMUM 2 GREEN	6	47					59		18
MAXIMUM 3 GREEN	5	57					59		17
YELLOW CLEARANCE	4.1	4.1					4.1		3.3
ALL RED CLEARANCE	2.0	2.0					2.0		2.0
VEH. EXTENSION	2	2					2		2
RECALL MODE	- SOFT				SOFT				-

**COORDINATION TIMING CHART - SPLITS**

VT ROUTE 100 & I-89 EXIT #10 NB OFF-RAMP												
COS	LENGTH	O/S	SEC %	1	2	3	RAMP	4	5	6	7	8
1-1-1	102	1	1%			60		42		60		
2-1-1	88	77	88%			49		39		49		
3-1-1	96	22	23%			58		38		58		

**Coordination Program Steps:**

Step	Prog.	Step Begins	Pattern	Override
1	1	0000	FLASH	YES
2	1	0600	0	NO
3	1	0700	1	NO
4	1	0900	0	NO
5	1	1400	3	NO
6	1	1900	0	NO
7	1	2200	FLASH	YES

**COORDINATION TIMING CHART - SPLITS**

VT ROUTE 100 & I-89 EXIT #10 NB OFF-RAMP												
COS	LENGTH	O/S	SEC %	1	2	3	4	5	6	7	8	
1-1-1	102	1	1%			73				73		29
2-1-1	88	72	82%			60				60		28
3-1-1	96	7	7%			68				68		28

**Coordination Program Steps:**

Step	Prog.	Step Begins	Pattern	Override
1	1	0000	FLASH	YES
2	1	0600	0	NO
3	1	0700	1	NO
4	1	0900	0	NO
5	1	1400	3	NO
6	1	1900	0	NO
7	1	2200	FLASH	YES

**COORDINATION TIMING CHART - SPLITS**

VT ROUTE 100 & BLUSH HILL RD/STOWE ST (TH #2)														
COS	LENGTH	O/S	SEC %	1	2	3	4	5	6	7	8			
1-1-1	102	80	78%			12		70		20		12	70	20
2-1-1	88	80	91%			12		59		17		12	59	17
3-1-1	96	79	82%			12		65		19		12	65	19

**Coordination Program Steps:**

Step	Prog.	Step Begins	Pattern	Override
1	1	0000	0	NO
2	1	0600	0	NO
3	1	0700	1	NO
4	1	0900	0	NO
5	1	1400	3	NO
6	1	1900	0	NO
7	1	2200	0	NO

**COORDINATION TIMING CHART - SPLITS**

VT ROUTE 100 & SHAW'S												
COS	LENGTH	O/S	SEC %	1	2	3	4	5	6	7	8	
1-1-1	102	0	0%			13		65			78	24
2-1-1	88	0	0%			12		53			65	23
3-1-1	96	0	0%			11		63			74	22

**Coordination Program Steps:**

Step	Prog.	Step Begins	Pattern	Override
1	1	0000	FLASH	YES
2	1	0600	0	NO
3	1	0700	1	NO
4	1	0900	0	NO
5	1	1400	3	NO
6	1	1900	0	NO
7	1	2200	FLASH	YES


**I-89 SB OFF-RAMP**

**Action Plan**


Action Plan	Pattern	MAX
1	1	MAX 1
2	2	MAX 2
3	3	MAX 3
4	FREE	FREE
5	FLASH	FLASH

**Action Plan**

Action Plan	Pattern	MAX
1	1	MAX 1
2	2	MAX 2
3	3	MAX 3
4	FREE	FREE
5	FLASH	FLASH

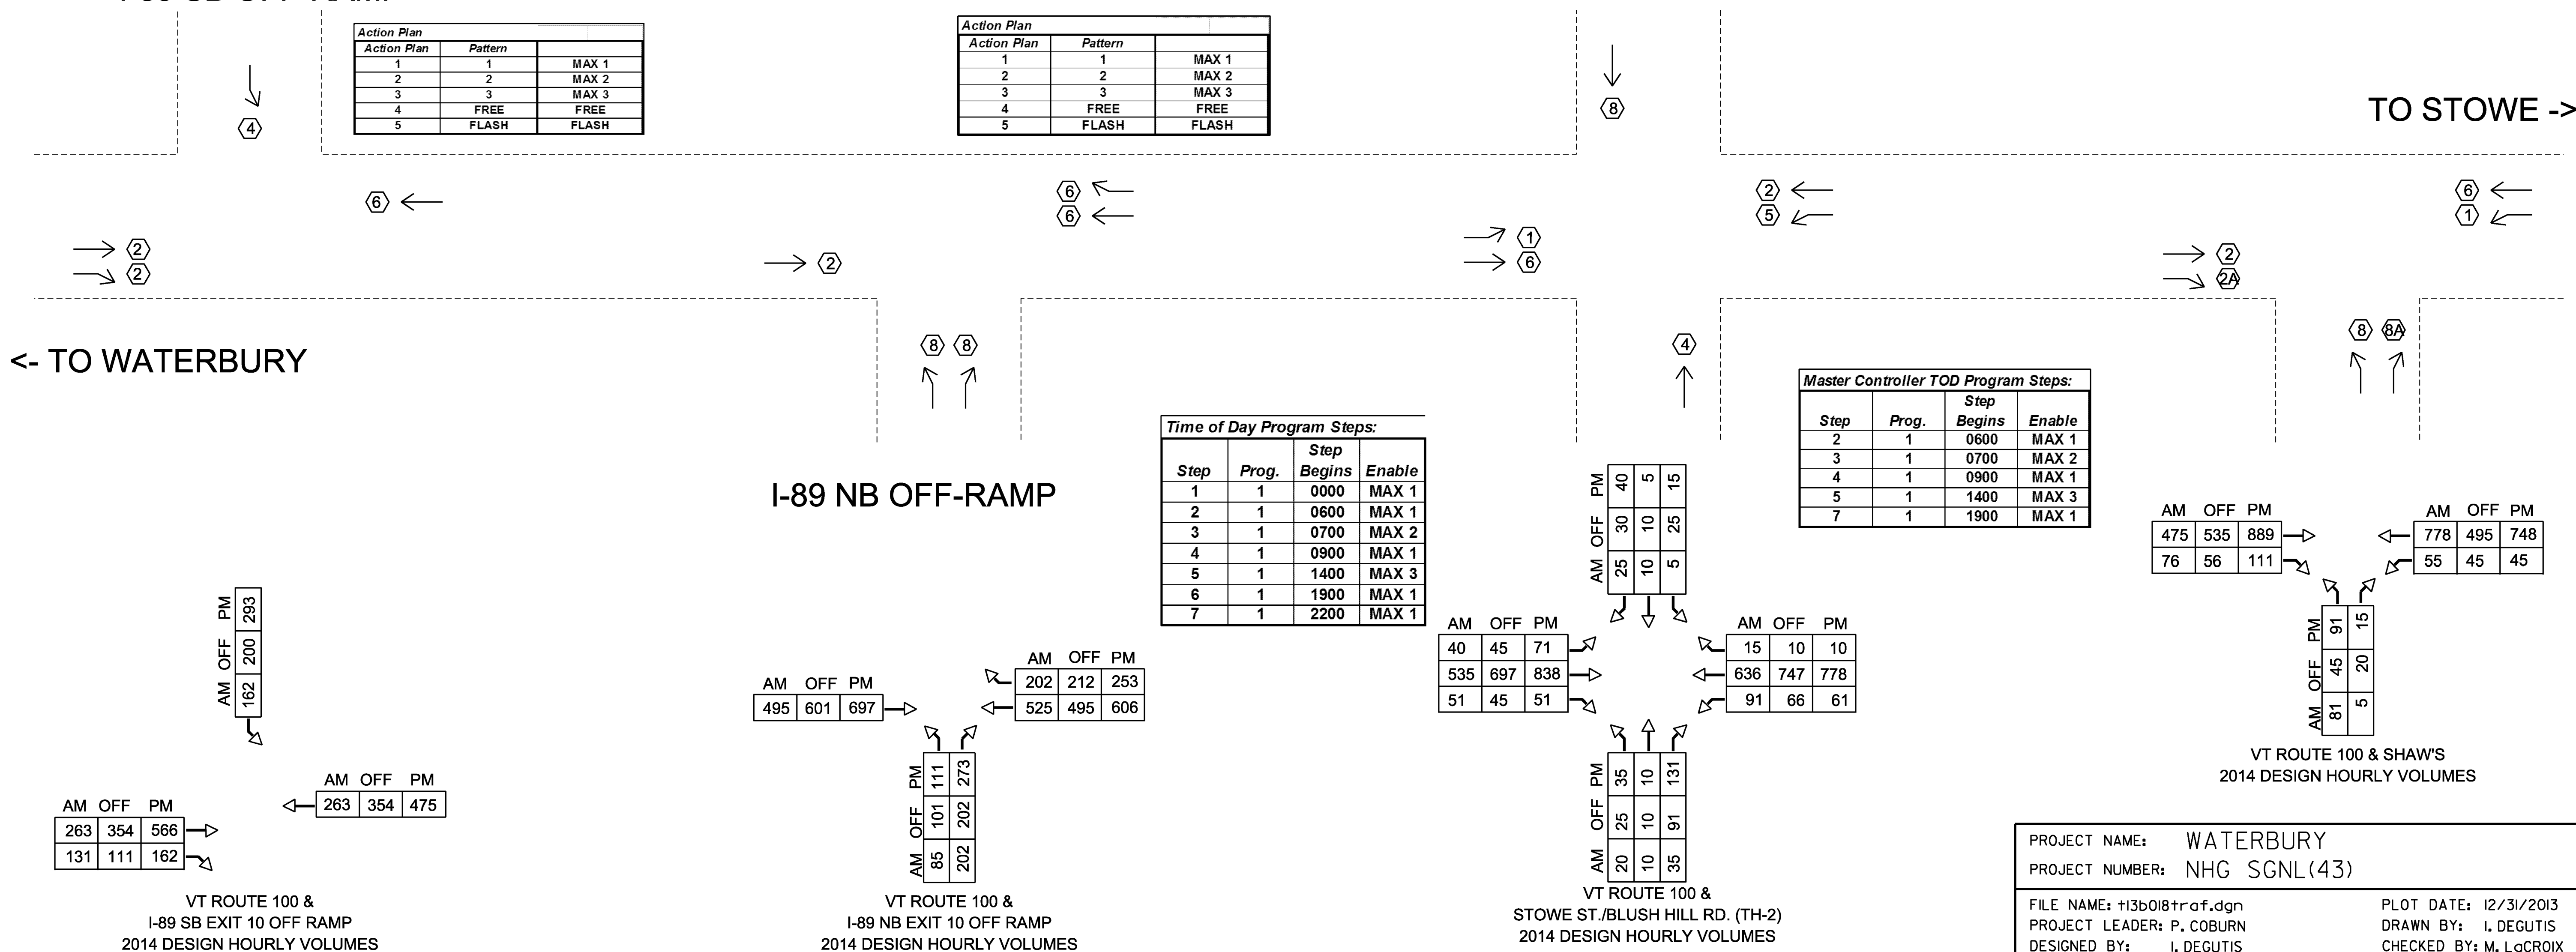

NOT TO SCALE

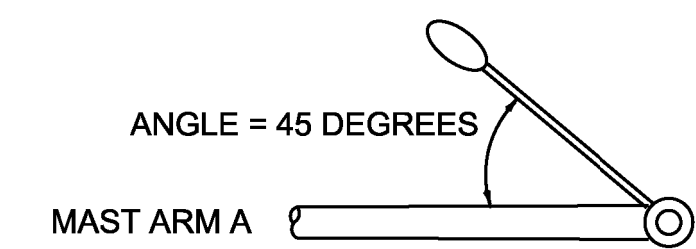


LUMINAIRE ORIENTATION


NOTES :

1. ALL MAST ARM FOOTINGS SHALL INCLUDE A 4" REVEAL. ELEVATIONS SHOWN IN CROSS-SECTIONS ARE APPROXIMATE FINAL GRADE ELEVATIONS FOR CONTRACTOR BIDDING PURPOSES ONLY. ACTUAL FOOTING ELEVATIONS SHALL BE DETERMINED BY THE CONTRACTOR PRIOR TO SUBMITTING WORKING DRAWINGS.
2. MAST ARM FOOTING SIZES ARE NOT TO SCALE. FOOTING DESIGNS SHALL BE DETERMINED BY THE CONTRACTOR IN ACCORDANCE WITH SOIL CONDITIONS AND ACTUAL MAST ARM LOADINGS TRANSMITTED TO THE TOP OF THE FOOTINGS.
3. PLEASE REFER TO SHEET 3-4 FOR BORING INFORMATION. FOR ADDITIONAL INFORMATION PLEASE REFER TO THE GEOTECHNICAL REPORT IN THE CONTRACT DOCUMENTS.
4. SIGNAL HEADS SHALL BE MOUNTED ON THE VERTICAL CENTER OF THE MAST ARM.

MAST ARM POLE #1  
ARM A  
LOOKING NORTH-EAST ON  
VT 100 NORTH

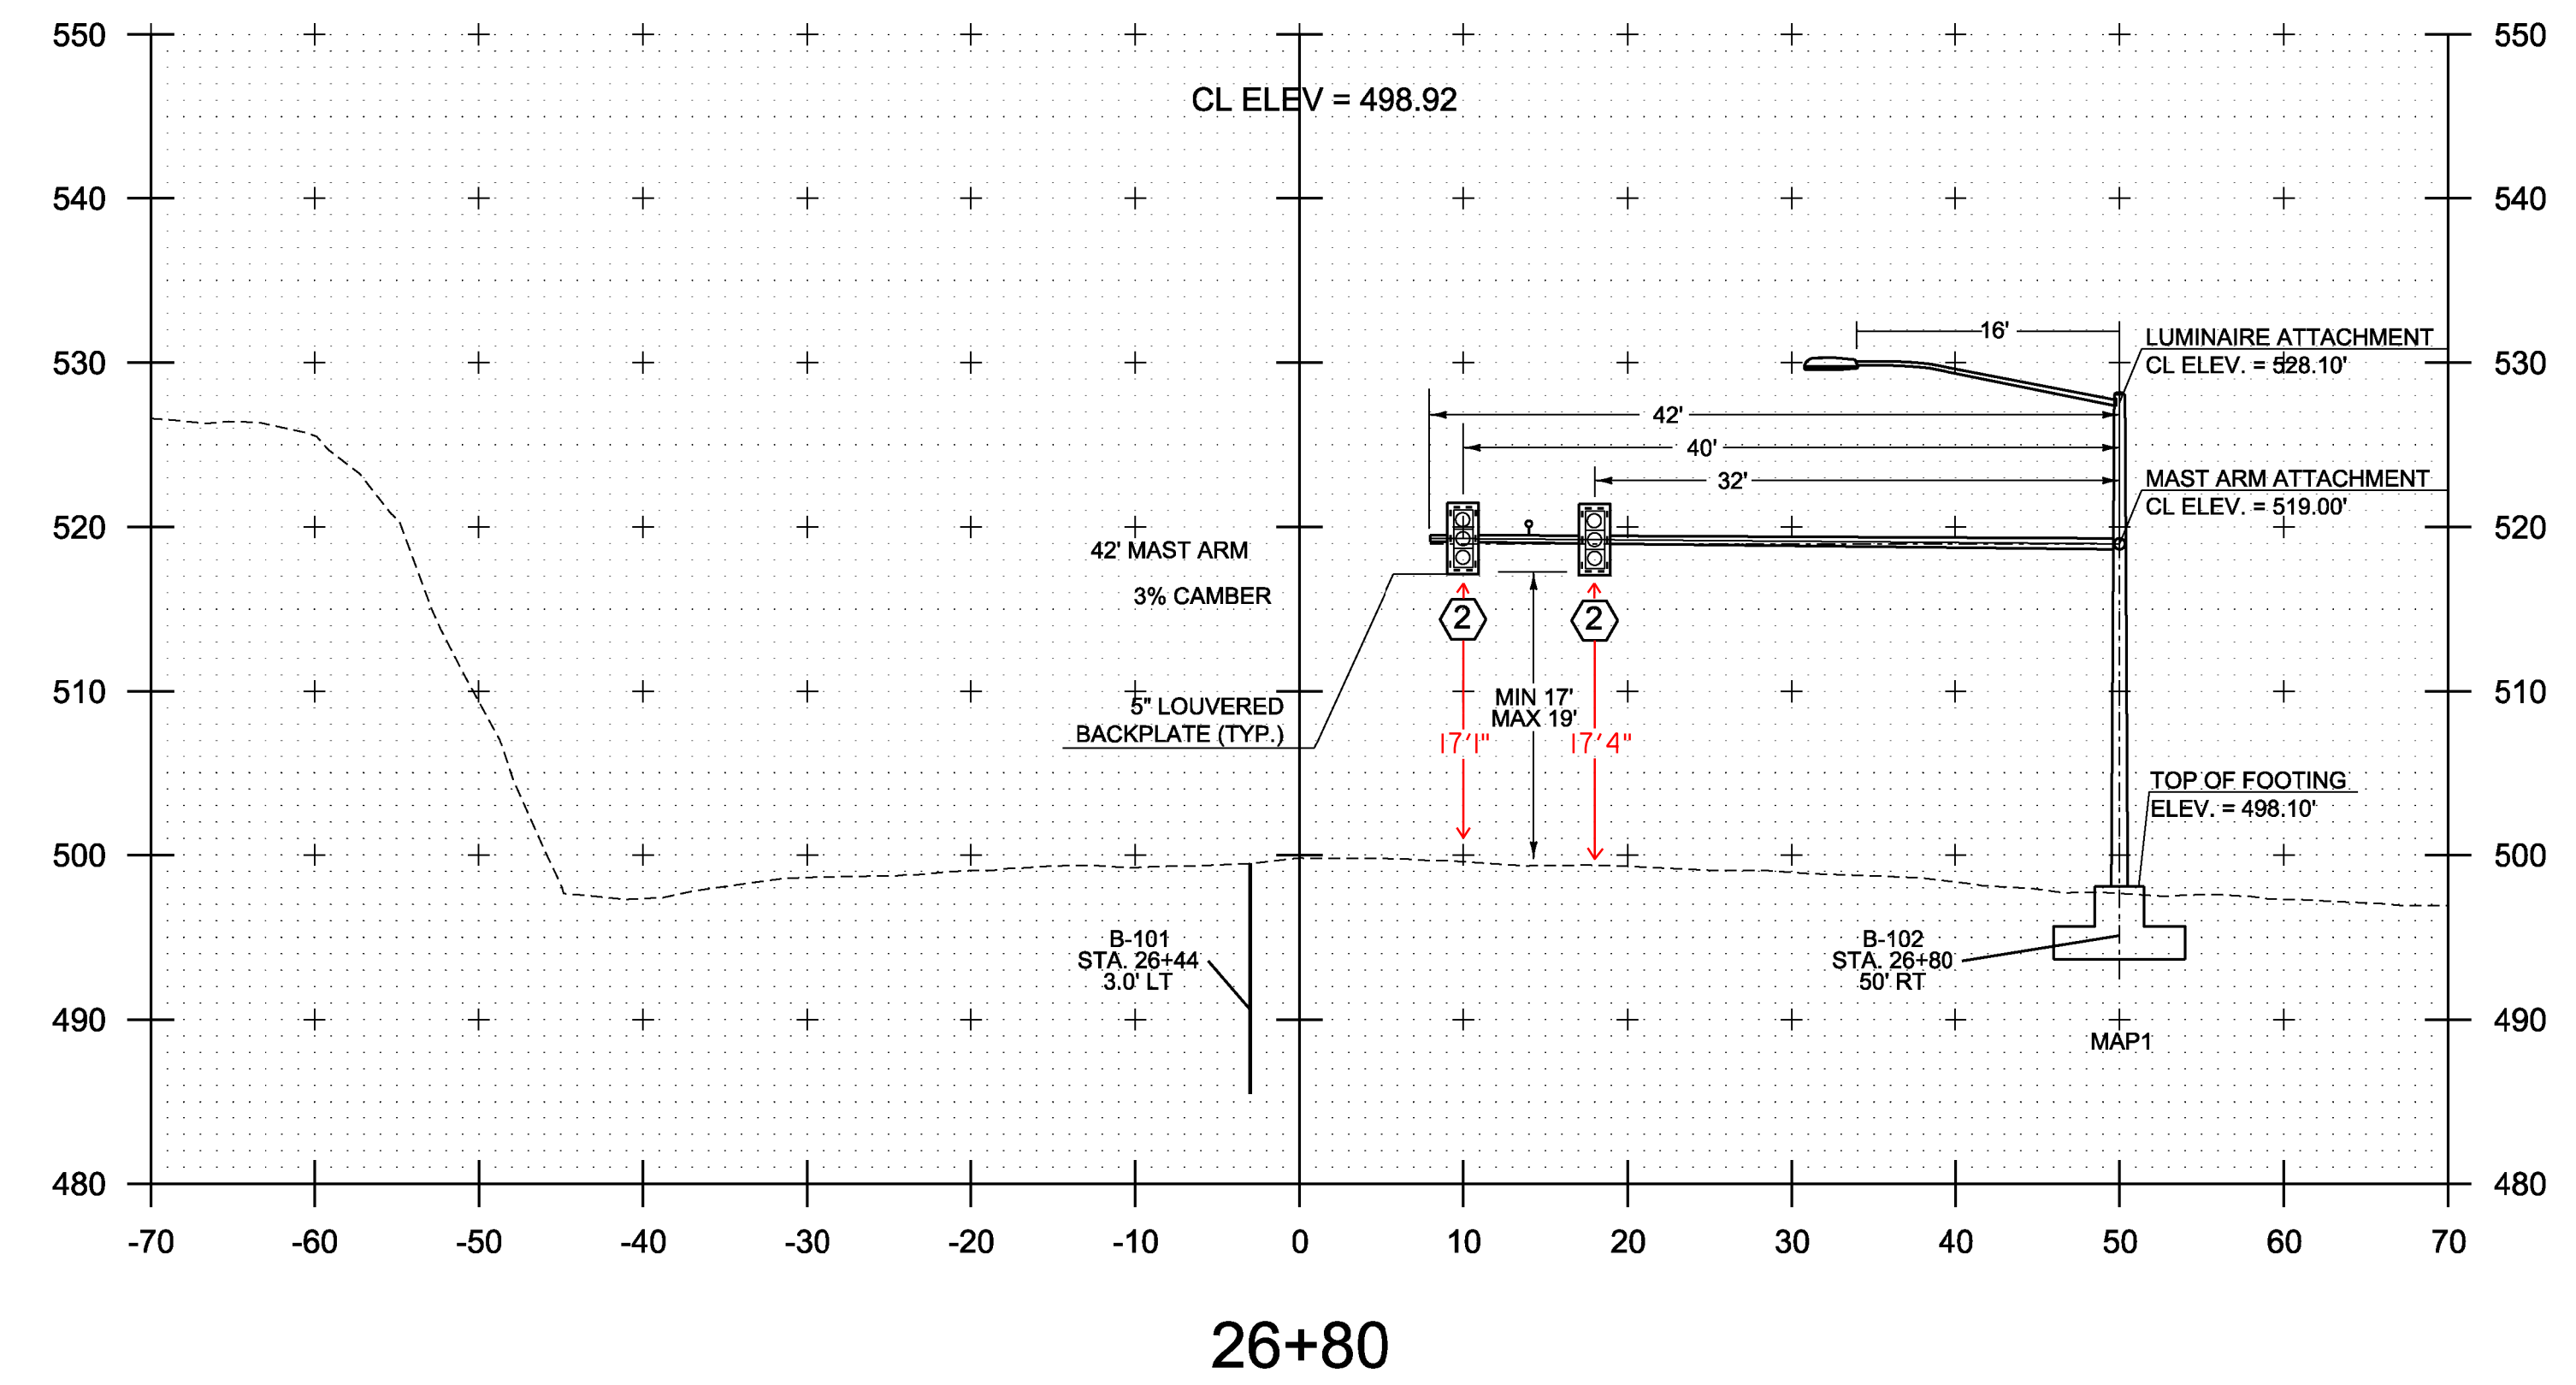


NEW	LEGEND
?	VIDEO DETECTION CAMERA
⚡	PREEMPTION STROBE
⬇	OPTICAL PREEMPTION DETECTOR

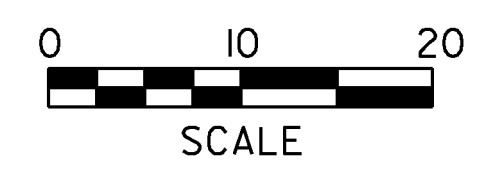


PROJECT NAME:	WATERBURY
PROJECT NUMBER:	NHG SGNL(43)
FILE NAME:	t13b018tr0f.dgn
PROJECT LEADER:	P. COBURN
DESIGNED BY:	I. DEGUTIS
MAST ARM CROSS SECTION SHEET 1	
PLOT DATE:	12/31/2013
DRAWN BY:	I. DEGUTIS
CHECKED BY:	M. LACROIX
SHEET 14	OF 17

MAST ARM POLE #2  
ARM B  
LOOKING NORTH-WEST ON  
I-89 NB EXIT 10 OFF-RAMP

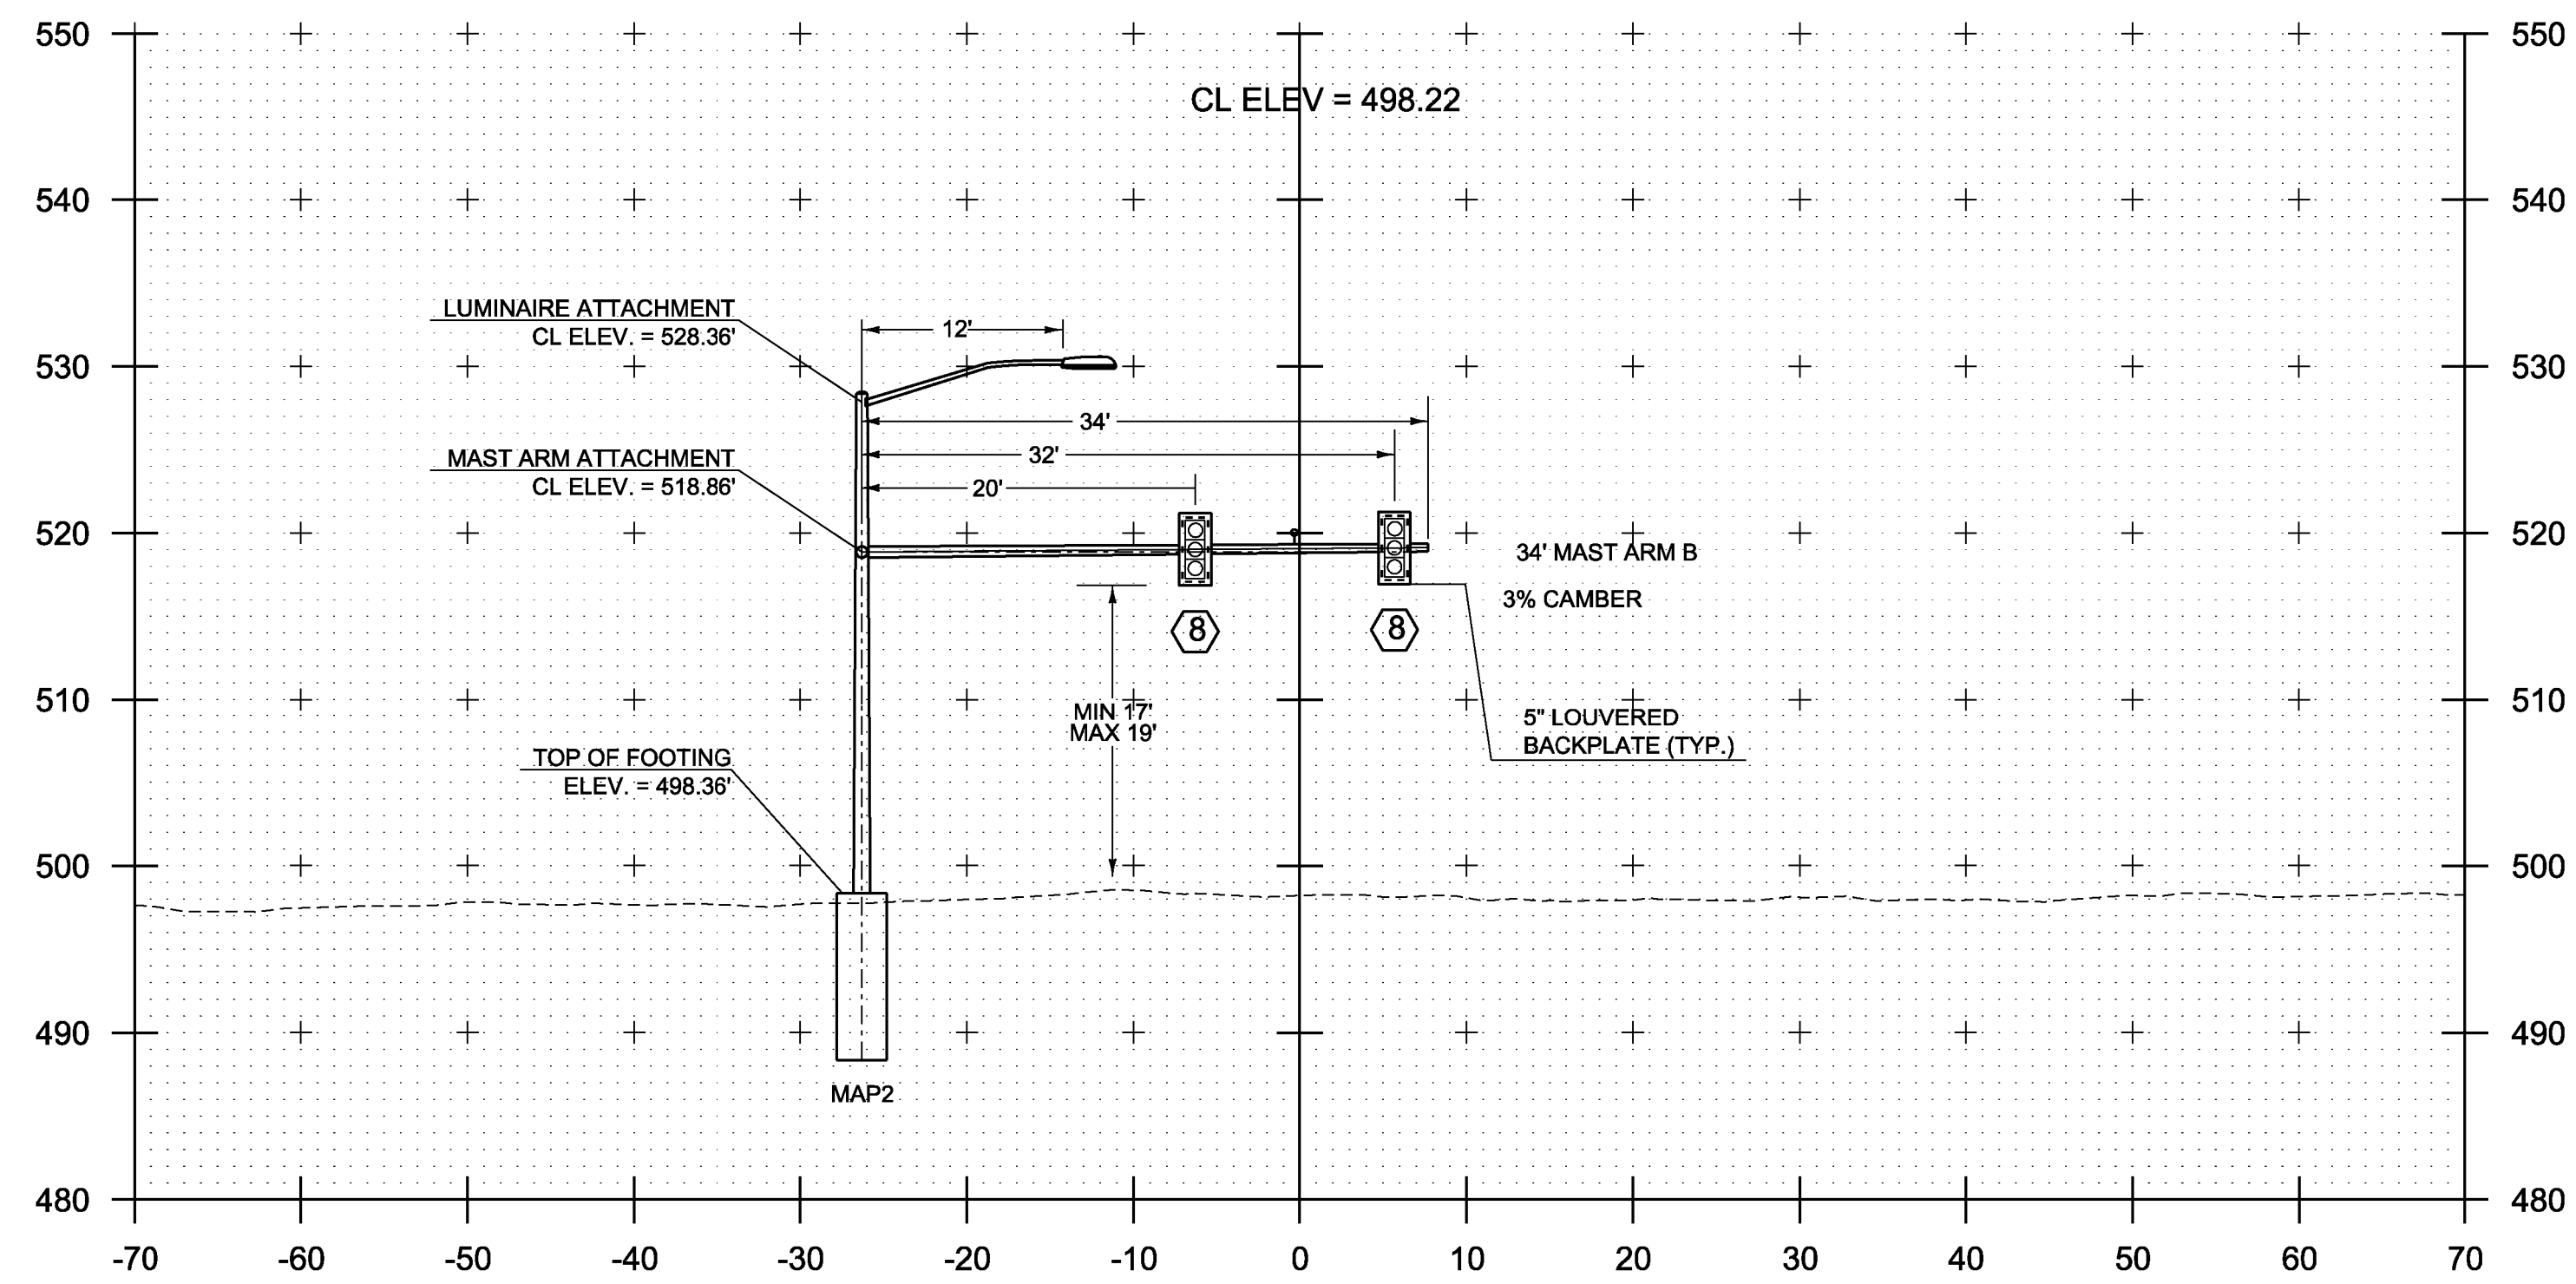


115+64

MAST ARM POLE #2  
ARM A  
LOOKING SOUTH-WEST ON  
VT 100 SOUTH

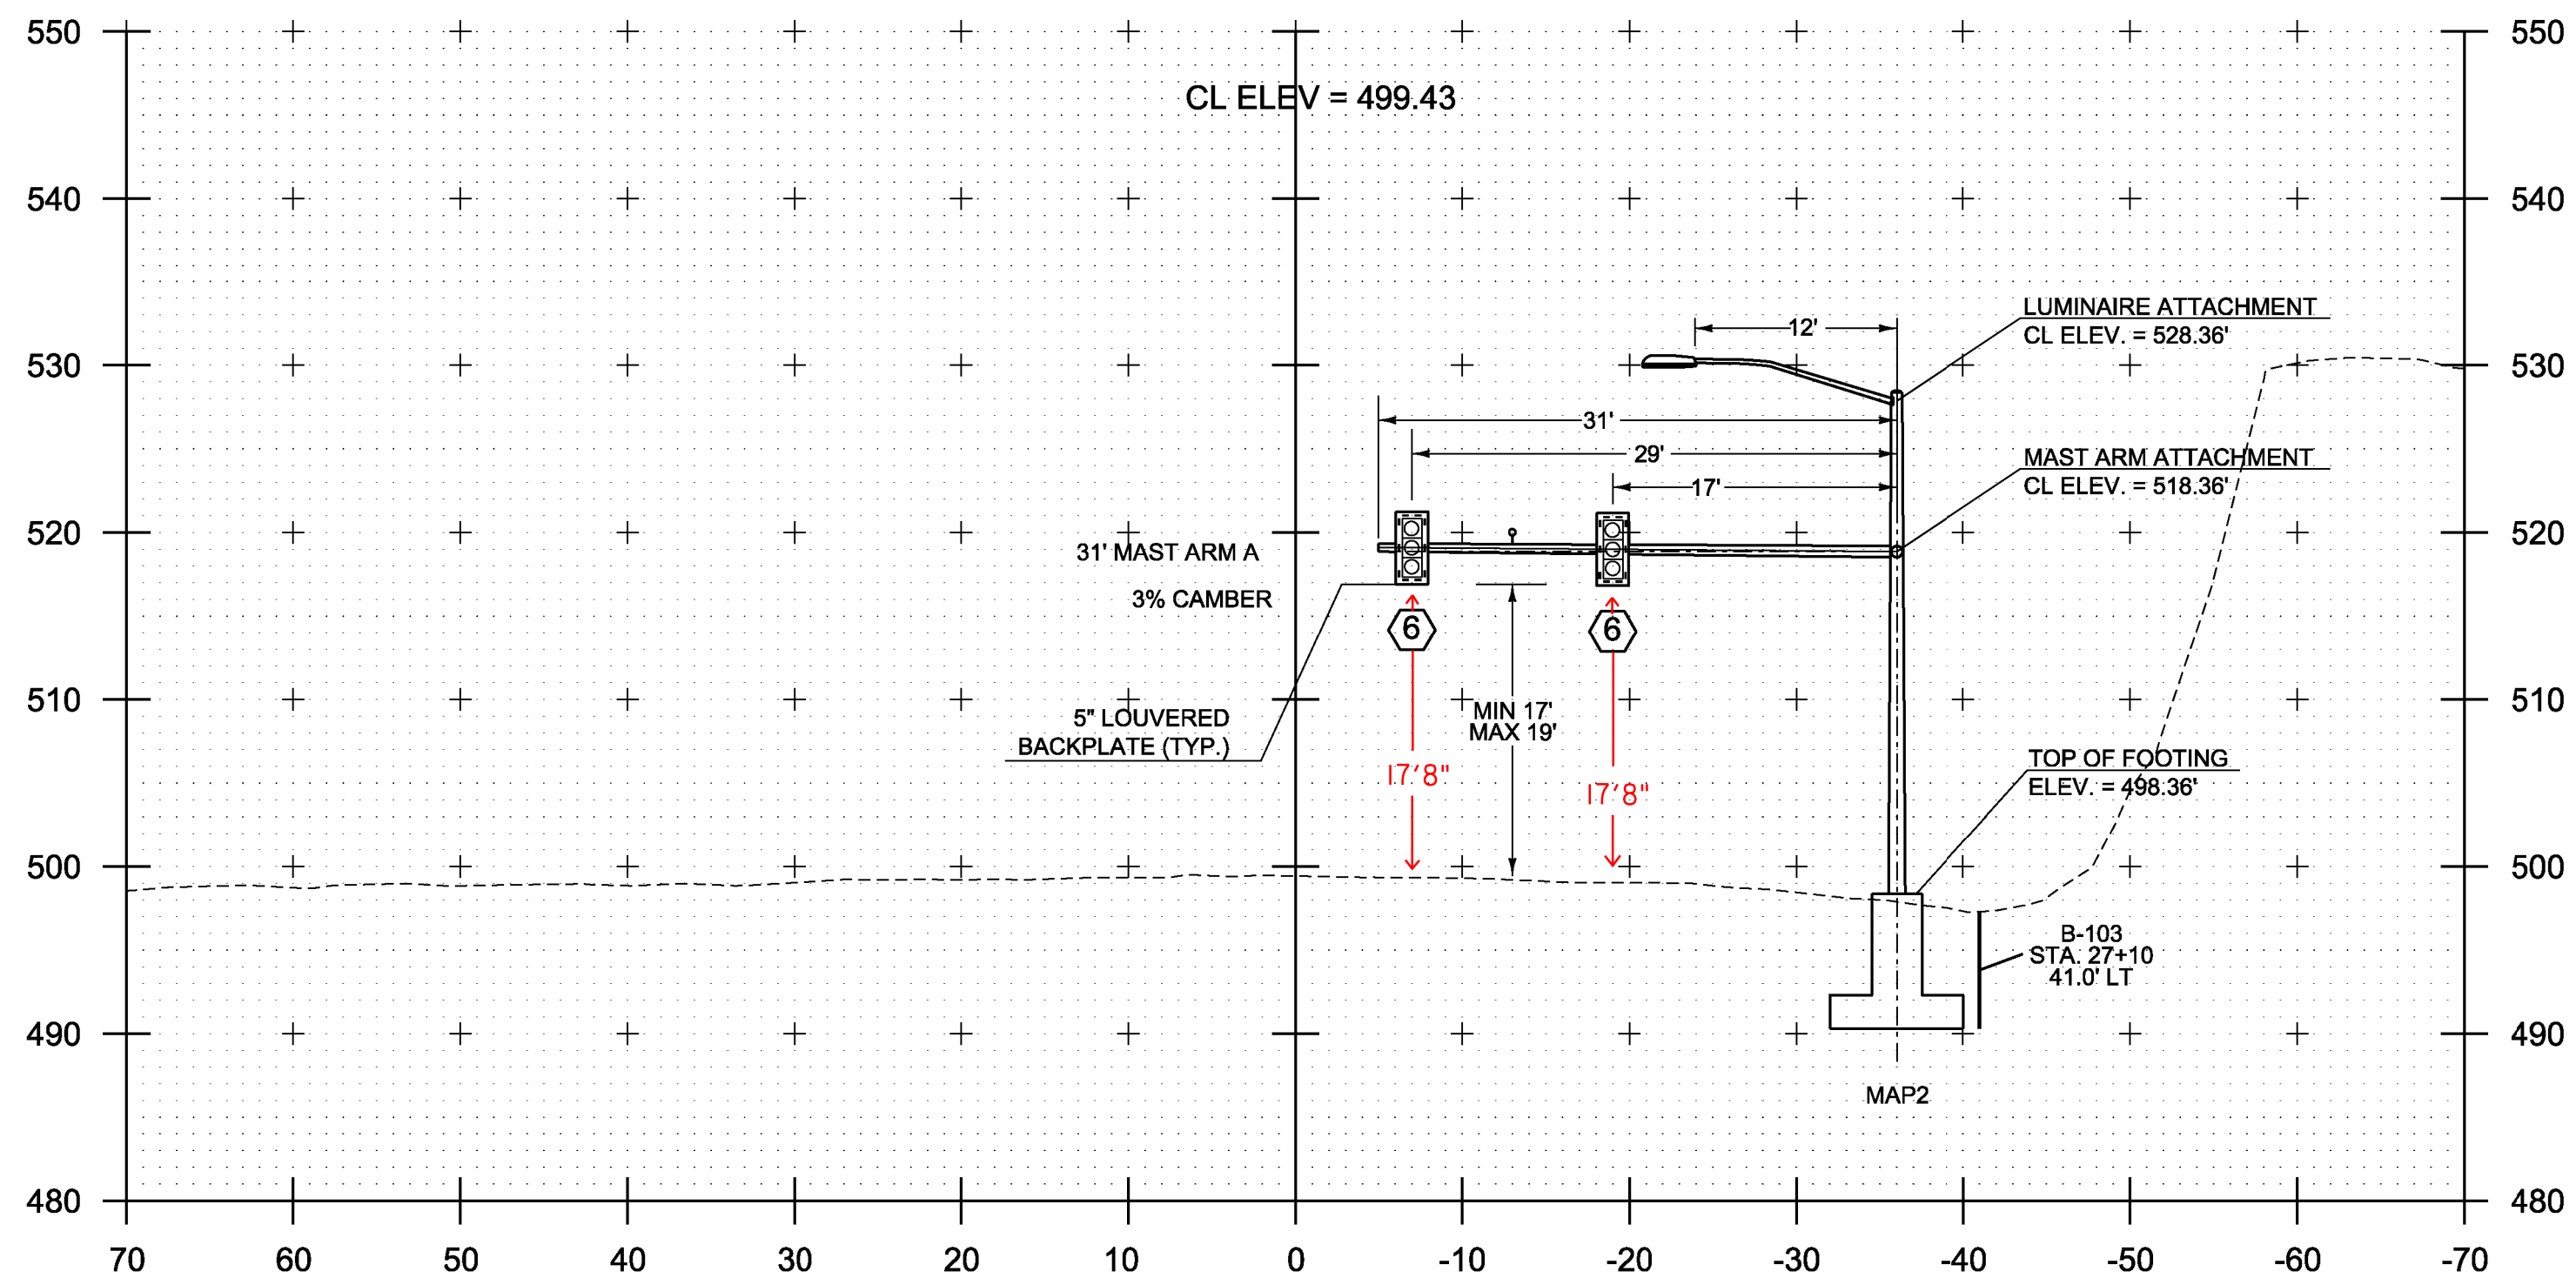


27+10

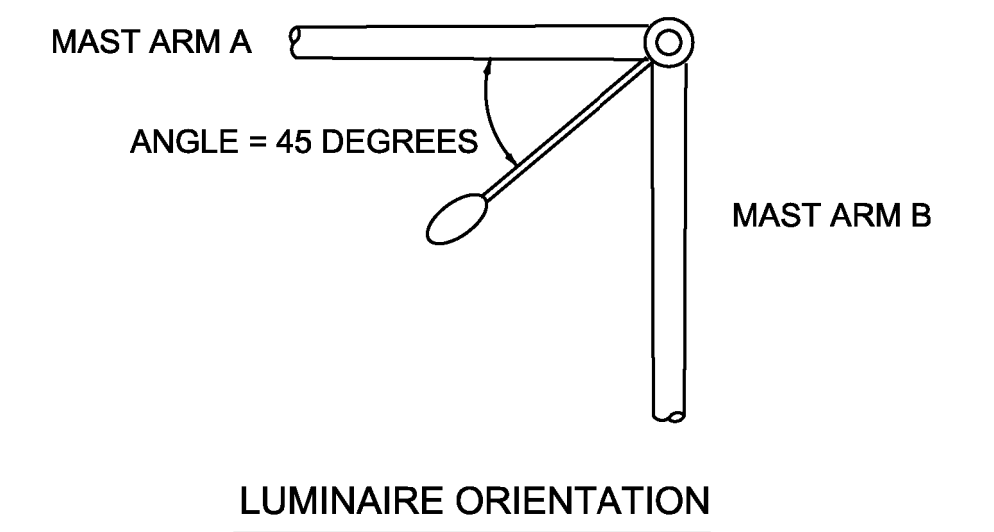

NOTES :

1. ALL MAST ARM FOOTINGS SHALL INCLUDE A 4" REVEAL. ELEVATIONS SHOWN IN CROSS-SECTIONS ARE APPROXIMATE FINAL GRADE ELEVATIONS FOR CONTRACTOR BIDDING PURPOSES ONLY. ACTUAL FOOTING ELEVATIONS SHALL BE DETERMINED BY THE CONTRACTOR PRIOR TO SUBMITTING WORKING DRAWINGS.
2. MAST ARM FOOTING SIZES ARE NOT TO SCALE. FOOTING DESIGNS SHALL BE DETERMINED BY THE CONTRACTOR IN ACCORDANCE WITH SOIL CONDITIONS AND ACTUAL MAST ARM LOADINGS TRANSMITTED TO THE TOP OF THE FOOTINGS.
3. PLEASE REFER TO SHEET 3-4 FOR BORING INFORMATION. FOR ADDITIONAL INFORMATION PLEASE REFER TO THE GEOTECHNICAL REPORT IN THE CONTRACT DOCUMENTS.
4. SIGNAL HEADS SHALL BE MOUNTED ON THE VERTICAL CENTER OF THE MAST ARM.

NEW	LEGEND
?	VIDEO DETECTION CAMERA
⚡	PREEMPTION STROBE
⬇	OPTICAL PREEMPTION DETECTOR

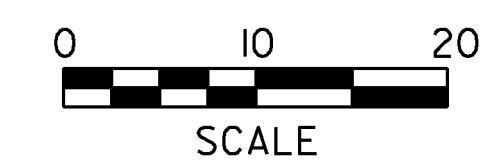

PROJECT NAME:	WATERBURY
PROJECT NUMBER:	NHG SGNL(43)
FILE NAME:	t13b018tr.dgn
PROJECT LEADER:	P. COBURN
DESIGNED BY:	I. DEGUTIS
MAST ARM CROSS SECTION SHEET 2	
PLOT DATE:	12/31/2013
DRAWN BY:	I. DEGUTIS
CHECKED BY:	M. LaCROIX
SHEET 15	OF 17

# STREET LIGHTING GENERAL NOTES

## CONCRETE BASES

WHEN CONCRETE BASES ARE INSTALLED IN SLOPING GROUND, THE GREATEST EXPOSED HEIGHT TO KEEP ALL OF THE TOP ABOVE GROUND MUST BE DOUBLED AND THEN ADDED TO THE MINIMUM DEPTH FOR THE TOTAL BASE DEPTH.

CARE SHOULD BE TAKEN WHERE CONCRETE BASES, DRAINAGE STRUCTURES OR UTILITIES ARE CLOSE TOGETHER.

THE OFFSET FOR CONCRETE BASES (FACE OF CURB OR EDGE OF PAVEMENT TO CENTER OF CONCRETE BASE) SHALL BE A MINIMUM OF 2'-6" OR AS OTHERWISE NOTED ON THE PLANS.

## POLES, ANCHOR BASES AND ARM

ALL NEW STREET LIGHT POLES, POLE BASES AND LUMINAIRE ARMS SHOULD BE ALUMINUM, PAINTED FLAT BLACK TO MATCH THE TRAFFIC SIGNAL EQUIPMENT.

ALL STREET LIGHT POLES SHALL HAVE A FRANGIBLE OR BREAKAWAY DEVICE (TRANSFORMER BASE, UNLESS NOTED ON THE PLANS).

UTILIZE APPROVED DUAL-RATED PARALLEL TAP CONNECTOR WITH INSULATING COVER TO TAPS AT POLE BASES.

## LUMINAIRES

LUMINAIRES SHALL BE L.E.D. TYPE.

POLE-MOUNTED LUMINAIRES SHALL BE ONE OF THE FOLLOWING:

- BETA LEDWAY IP SERIES
- HOLOPHANE LEDgends SERIES
- LRL LED #SAT-96M SERIES

ALL POLE-MOUNTD LUMINAIRES SHALL BE SAME, A MIX OF FIXTURES WILL NOT BE ALLOWED.

NO LUMINAIRE SUBSTITUTIONS SHALL BE ALLOWED.

ALL LUMINAIRE HOUSINGS SHALL BE PAINTED FLAT BLACK.

## CONDUIT SLEEVE

THE SLEEVE SHALL EXTEND TO WITHIN TWO FEET OF THE SIDE OF A CONCRETE BASE OR PULLBOX. WHERE NO CONCRETE BASE OR PULLBOX IS PRESENT, THE SLEEVE SHALL EXTEND FOUR FEET BEYOND THE OUTSIDE EDGE OF SHOULDER OR FACE OF CURB. BACKFILLING AROUND A SLEEVE SHALL BE IN ACCORDANCE WITH THE MANUFACTURER'S SPECIFICATIONS. THE SLEEVE SHALL BE SCHEDULE 80.

## WIRE

ALL WIRING BETWEEN THE METER AND/OR POWER SOURCE AND THE FIRST POLE AND/OR PULLBOX AND BETWEEN POLES AND/OR PULLBOXES SHALL BE COPPER AND SIZE AS SPECIFIED ON THE PLANS. ALL WIRE SHALL HAVE TYPE XHHW INSULATION OR EQUIVALENT.

CIRCUIT CONDUCTORS SHALL BE CLEARLY IDENTIFIED BY CORROSION RESISTANT TAGS INDICATING CIRCUIT NUMBER AND PANEL SOURCES AT EVERY POLE BASE AND HANDHOLE.

## GROUNDING

ALL CONDUIT MUST INCLUDE A GROUNDING CONDUCTOR. RIGID STEEL CONDUIT SHALL BE PROPERLY CONNECTED AT THE JOINTS SO AS TO BE WATERTIGHT AND MAINTAIN ELECTRICAL CONTINUITY AND HAVE GROUNDING BUSHINGS SO AS TO ACT AS A GROUNDING CONDUCTOR. ALUMINUM WIRE SHALL NOT BE USED FOR GROUND WIRE.

THE GROUNDING CONDUCTOR SHALL BE CONTINUOUS.

## PULLBOXES, HANDHOLES AND JUNCTION BOXES

POLYMER CONCRETE AND REINFORCED FIBERGLASS U.L. LISTED PULLBOXES, HANDHOLES SHALL BE INSTALLED WITH HEAVY DUTY COVERS.

ALL CONNECTIONS IN HANDHOLES SHALL BE MADE WITH INSULATED WATERPROOF MECHANICAL SCREW-TYPE CONNECTOR SUITABLE FOR DIRECT BURIAL. NO BARE OR COMPRESSION TYPE CONNECTORS MAY BE USED.

## GENERAL

THE LOAD ON EACH BRANCH OF A THREE WIRE CIRCUIT SHALL BE AS BALANCED AS POSSIBLE. LOAD TO NEUTRAL.


THE LAST CONCRETE POLE BASE AT THE END OF EACH CIRCUIT AND SOME PULLBOXES SHALL HAVE A CONDUIT SWEEP WITH CAP INSTALLED FOR FUTURE USE.

THE CONTRACTOR SHALL ACQUIRE ALL NECESSARY PERMITS AND MAKE ALL NECESSARY ARRANGEMENTS WITH THE UTILITY COMPANY TO PROVIDE A PERMANENT POWER SUPPLY TO THE STREET LIGHTING SYSTEM. IF APPLICABLE, THE ROUTING OF POWER TO THE SYSTEM SHALL BE SUCH THAT THE AGENCY OF TRANSPORTATION HAS FULL RESPONSIBILITY FROM THE TRANSFORMER THROUGH THE LIGHTING SYSTEM. NO INTERVENING OWNERSHIP OR RESPONSIBILITY SHALL BE ALLOWED.

ALL CONNECTING HARDWARE (NUTS, BOLTS, ETC.) SHALL BE STAINLESS STEEL.

MATERIALS AND EQUIPMENT SHALL BE LISTED BY UNDERWRITERS' LABORATORIES AND SHALL BE INSTALLED IN ACCORDANCE WITH SUCH LISTINGS.

ALL MATERIALS AND INSTALLATION SHALL BE IN ACCORDANCE WITH THE LATEST EDITION OF THE NATIONAL ELECTRICAL CODE, AND ALL CODES, REGULATIONS AND REQUIREMENTS OF ALL MUNICIPAL, STATE, FEDERAL AND OTHER PUBLIC OR PRIVATE AUTHORITIES WHICH HAVE JURISDICTION. IN EACH CASE, CODES ARE MINIMUM REQUIREMENTS.

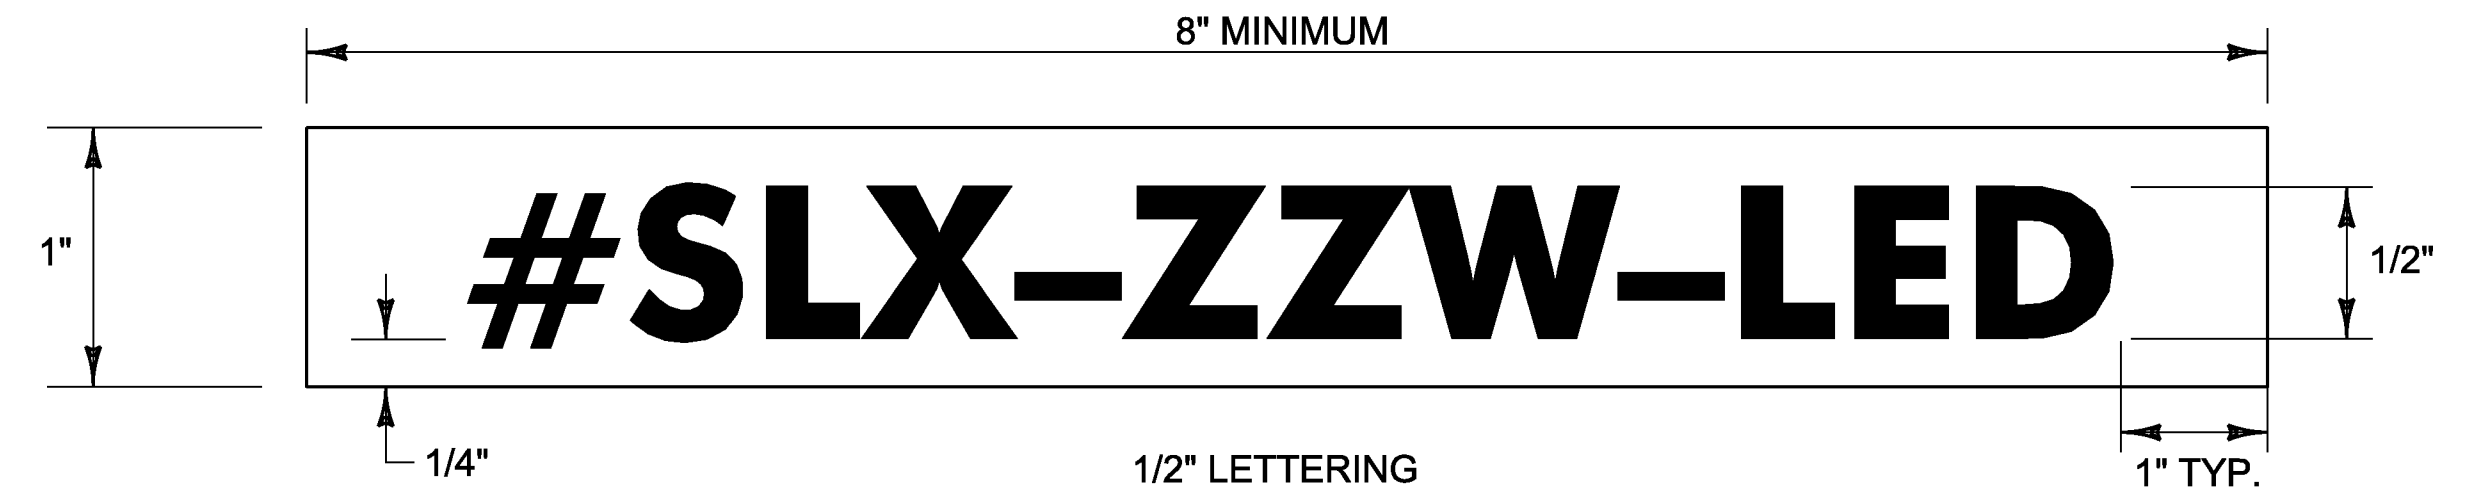

LEGEND: BLACK OR WHITE (NON-REFLECTIVE) - STAMPED PRIOR TO PRINTING/PAINTING. BACKGROUND: NATURAL ALUMINUM OR FLAT BLACK SURFACE, THE SAME AS POLE FINISH.

## NOTES:

1. THE TAG SHALL BE MOUNTED ON ALL STREET LIGHT POLES IN SUCH A MANNER AS NOT TO BE EASILY REMOVED, SUCH AS WELDED, RIVETED, OR BOLTED WITH VANDAL PROOF BOLTS.
2. THE LETTERS SHALL BE PUNCHED, STAMPED, ENGRAVED, OR PHOTO-ETCHED. PUNCHING, STAMPING OR ENGRAVING SHALL PENETRATE AT LEAST 1/2 THE BASE MATERIAL THICKNESS.
3. THE BASE MATERIAL FOR THE TAG SHALL BE ALUMINUM WITH A MINIMUM THICKNESS OF 0.10 INCHES.
4. THE TAG SHALL BE ATTACHED TO THE POLE ABOVE THE HANDHOLE, 6 INCHES MAXIMUM, IF THE POLE HAS A TRANSFORMER BASE, ATTACH TAG TO COVER.
5. FIXTURE TAG CHARACTER "X" SHALL BE THE DESIGNATED SL NUMBER AS SHOWN ON THE LIGHTING PLANS.
6. FIXTURE TAG CHARACTER "ZZ" SHALL BE THE WATTAGE OF THE LUMINAIRE

## DETAIL FOR TAGS ATTACHED TO STREET LIGHT POLES


NOT TO SCALE

PROJECT NAME: WATERBURY  
PROJECT NUMBER: NHG SGNL(43)

FILE NAME: t13b018trcf.dgn PLOT DATE: 12/31/2013  
PROJECT LEADER: P. COBURN DRAWN BY: I. DEGUTIS  
DESIGNED BY: I. DEGUTIS CHECKED BY: M. LACROIX  
STREET LIGHTING GENERAL NOTES SHEET SHEET 16 OF 17

**TRAFFIC CONTROL NOTES:**

1. NO CONSTRUCTION SIGNS SHALL BE INSTALLED AS TO INTERFERE OR OBSTRUCT THE VIEW OF EXISTING SIGNS, TRAFFIC CONTROL DEVICES AND STOPPING SIGHT DISTANCES.
2. ALL TRAFFIC CONTROL DEVICES SHALL BE IN COMPLIANCE WITH VAOT "STANDARD DRAWINGS" AND THE LATEST EDITION OF THE MUTCD.
3. A SAMPLE LAYOUT OF BARRELS AND PORTABLE SIGNS IS SHOWN FOR EQUIPMENT AND WORKERS ON THE SHOULDER. THE CONTRACTOR IS RESPONSIBLE FOR ENSURING THE TRAFFIC CONTROL PACKAGE IS COMPLIANT WITH ALL STANDARDS AND REQUIREMENTS AND APPLICABLE TO THE WORK BEING PERFORMED.
4. ADDITIONAL TRAFFIC CONTROL WARNING DEVICES MAY BE REQUIRED AND SHALL BE INSTALLED AS DIRECTED BY THE ENGINEER, PER THE STANDARDS AND MUTCD. PAYMENT SHALL BE MADE UNDER 641.10.

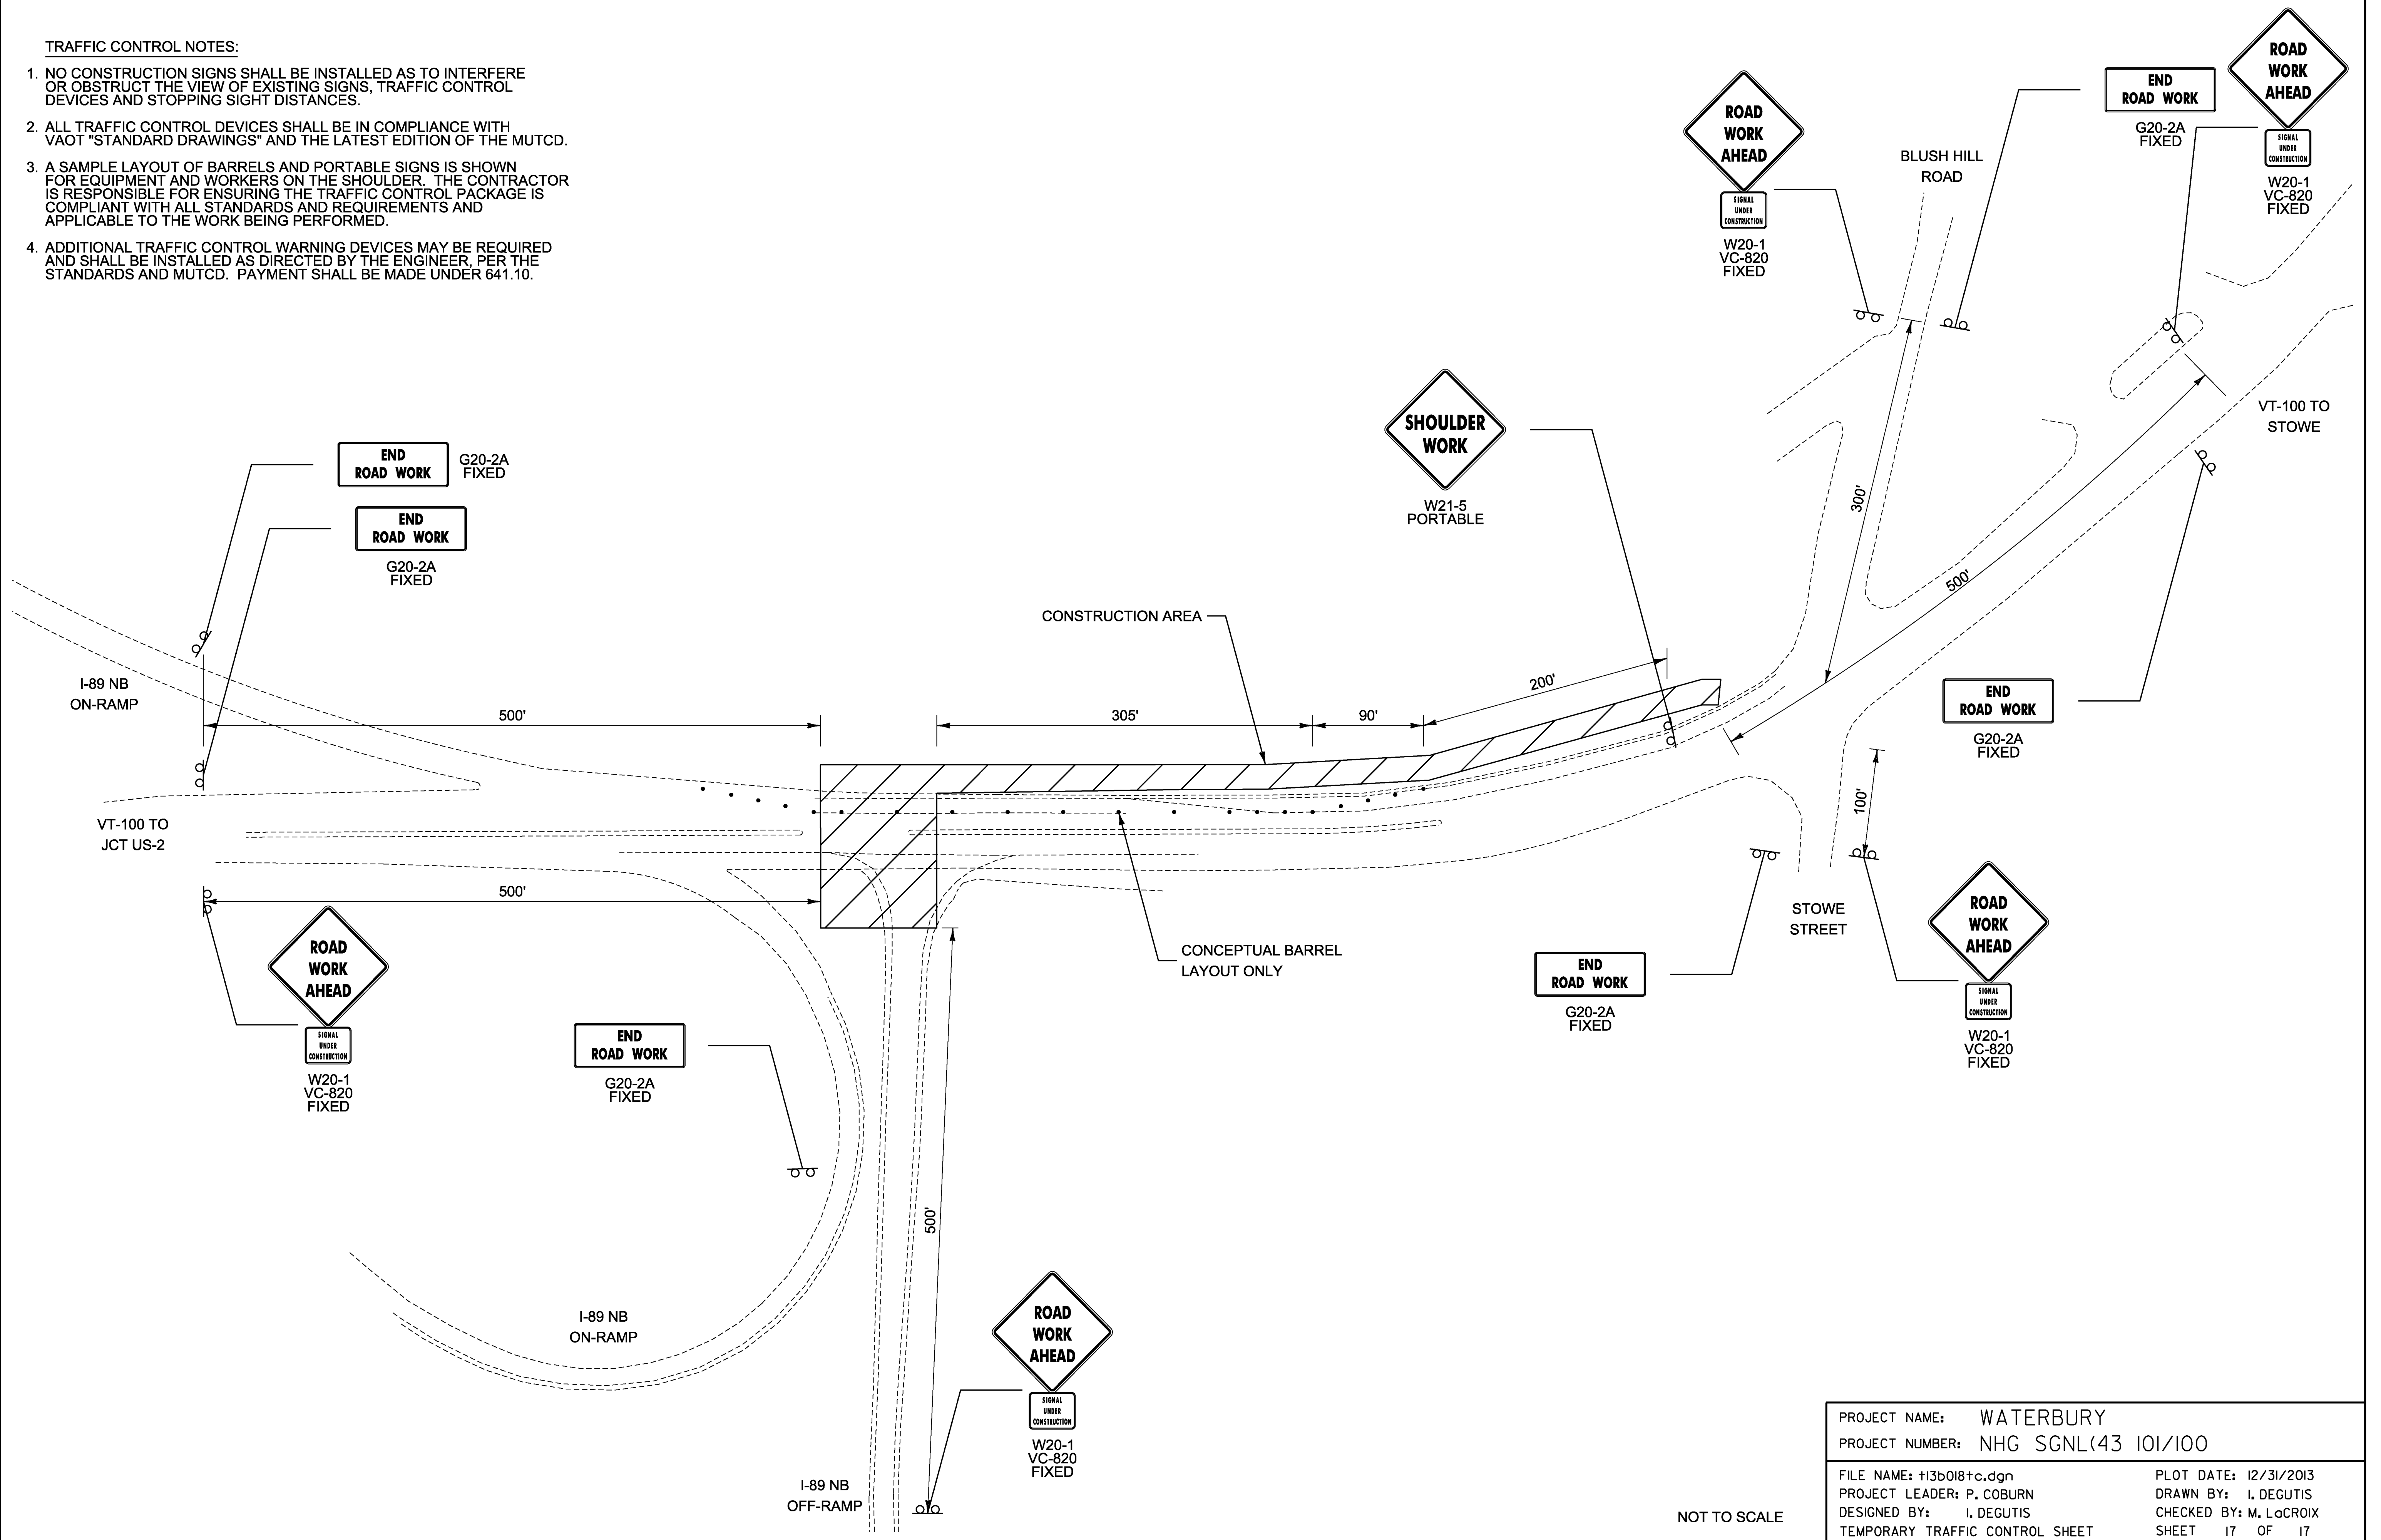

PROJECT NAME: WATERBURY	
PROJECT NUMBER: NHG SGNL(43 101/100)	
FILE NAME: +13b018+c.dgn	PLOT DATE: 12/31/2013
PROJECT LEADER: P. COBURN	DRAWN BY: I. DEGUTIS
DESIGNED BY: I. DEGUTIS	CHECKED BY: M. LACROIX
TEMPORARY TRAFFIC CONTROL SHEET	SHEET 17 OF 17

**APPROVED**  
By Ian Degutis at 6:20 am, Jun 09, 2014

FRITZ BROTHERS ENGINEERING, LTD.


June 2, 2014

STRUCTURAL CALCULATIONS & DRAWINGS

FOR

TRAFFIC SIGNAL POLE FOUNDATIONS

WATERBURY NHG SGNL(43), VERMONT  
VT ROUT 100 & I-89 EXIT 10 NB OFF RAMP

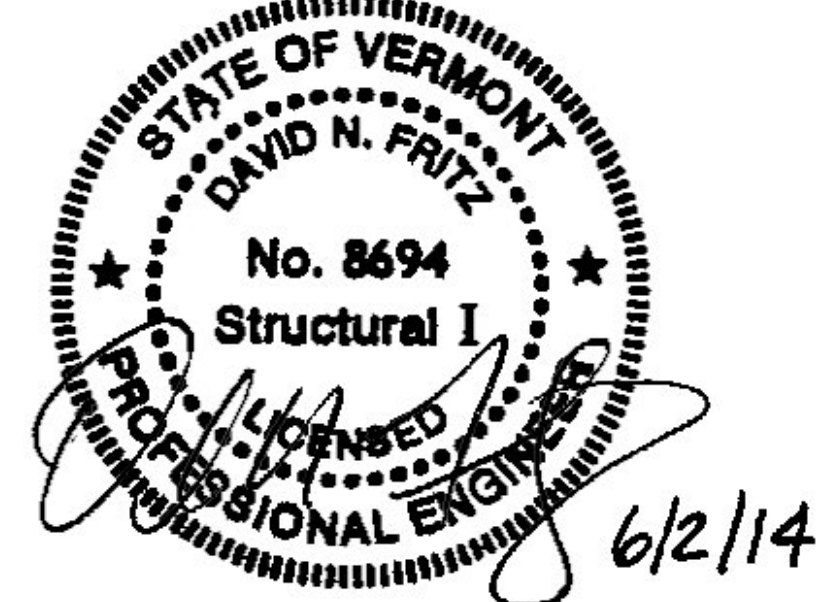


2009 AASHTO SPECIFICATION  
VTRANS MREI 10-01


VTRANS STANDARD SPECIFICATIONS FOR CONSTRUCTION

PROPRIETARY INFORMATION  
THESE DOCUMENTS, DRAWINGS AND CALCULATIONS AND ALL INFORMATION RELATED TO THEM  
ARE THE EXCLUSIVE PROPERTY AND THE PROPRIETARY INFORMATION OF FRITZ BROTHERS  
ENGINEERING, LTD. AND ARE FURNISHED SOLELY UPON THE CONDITIONS THAT THEY WILL BE  
RETAINED IN THE STRICTEST CONFIDENCE AND SHALL NOT BE DUPLICATED, USED OR  
DISCLOSED IN WHOLE OR IN PART FOR ANY PURPOSE, IN ANY WAY, WITHOUT THE PRIOR  
WRITTEN PERMISSION OF FRITZ BROTHERS ENGINEERING, LTD.

2800 POSSUM HOLLOW RD. SE, NEW PHILADELPHIA OHIO 44663-7322  
PHONE: 330-844-0994 • FAX: 330-308-5461

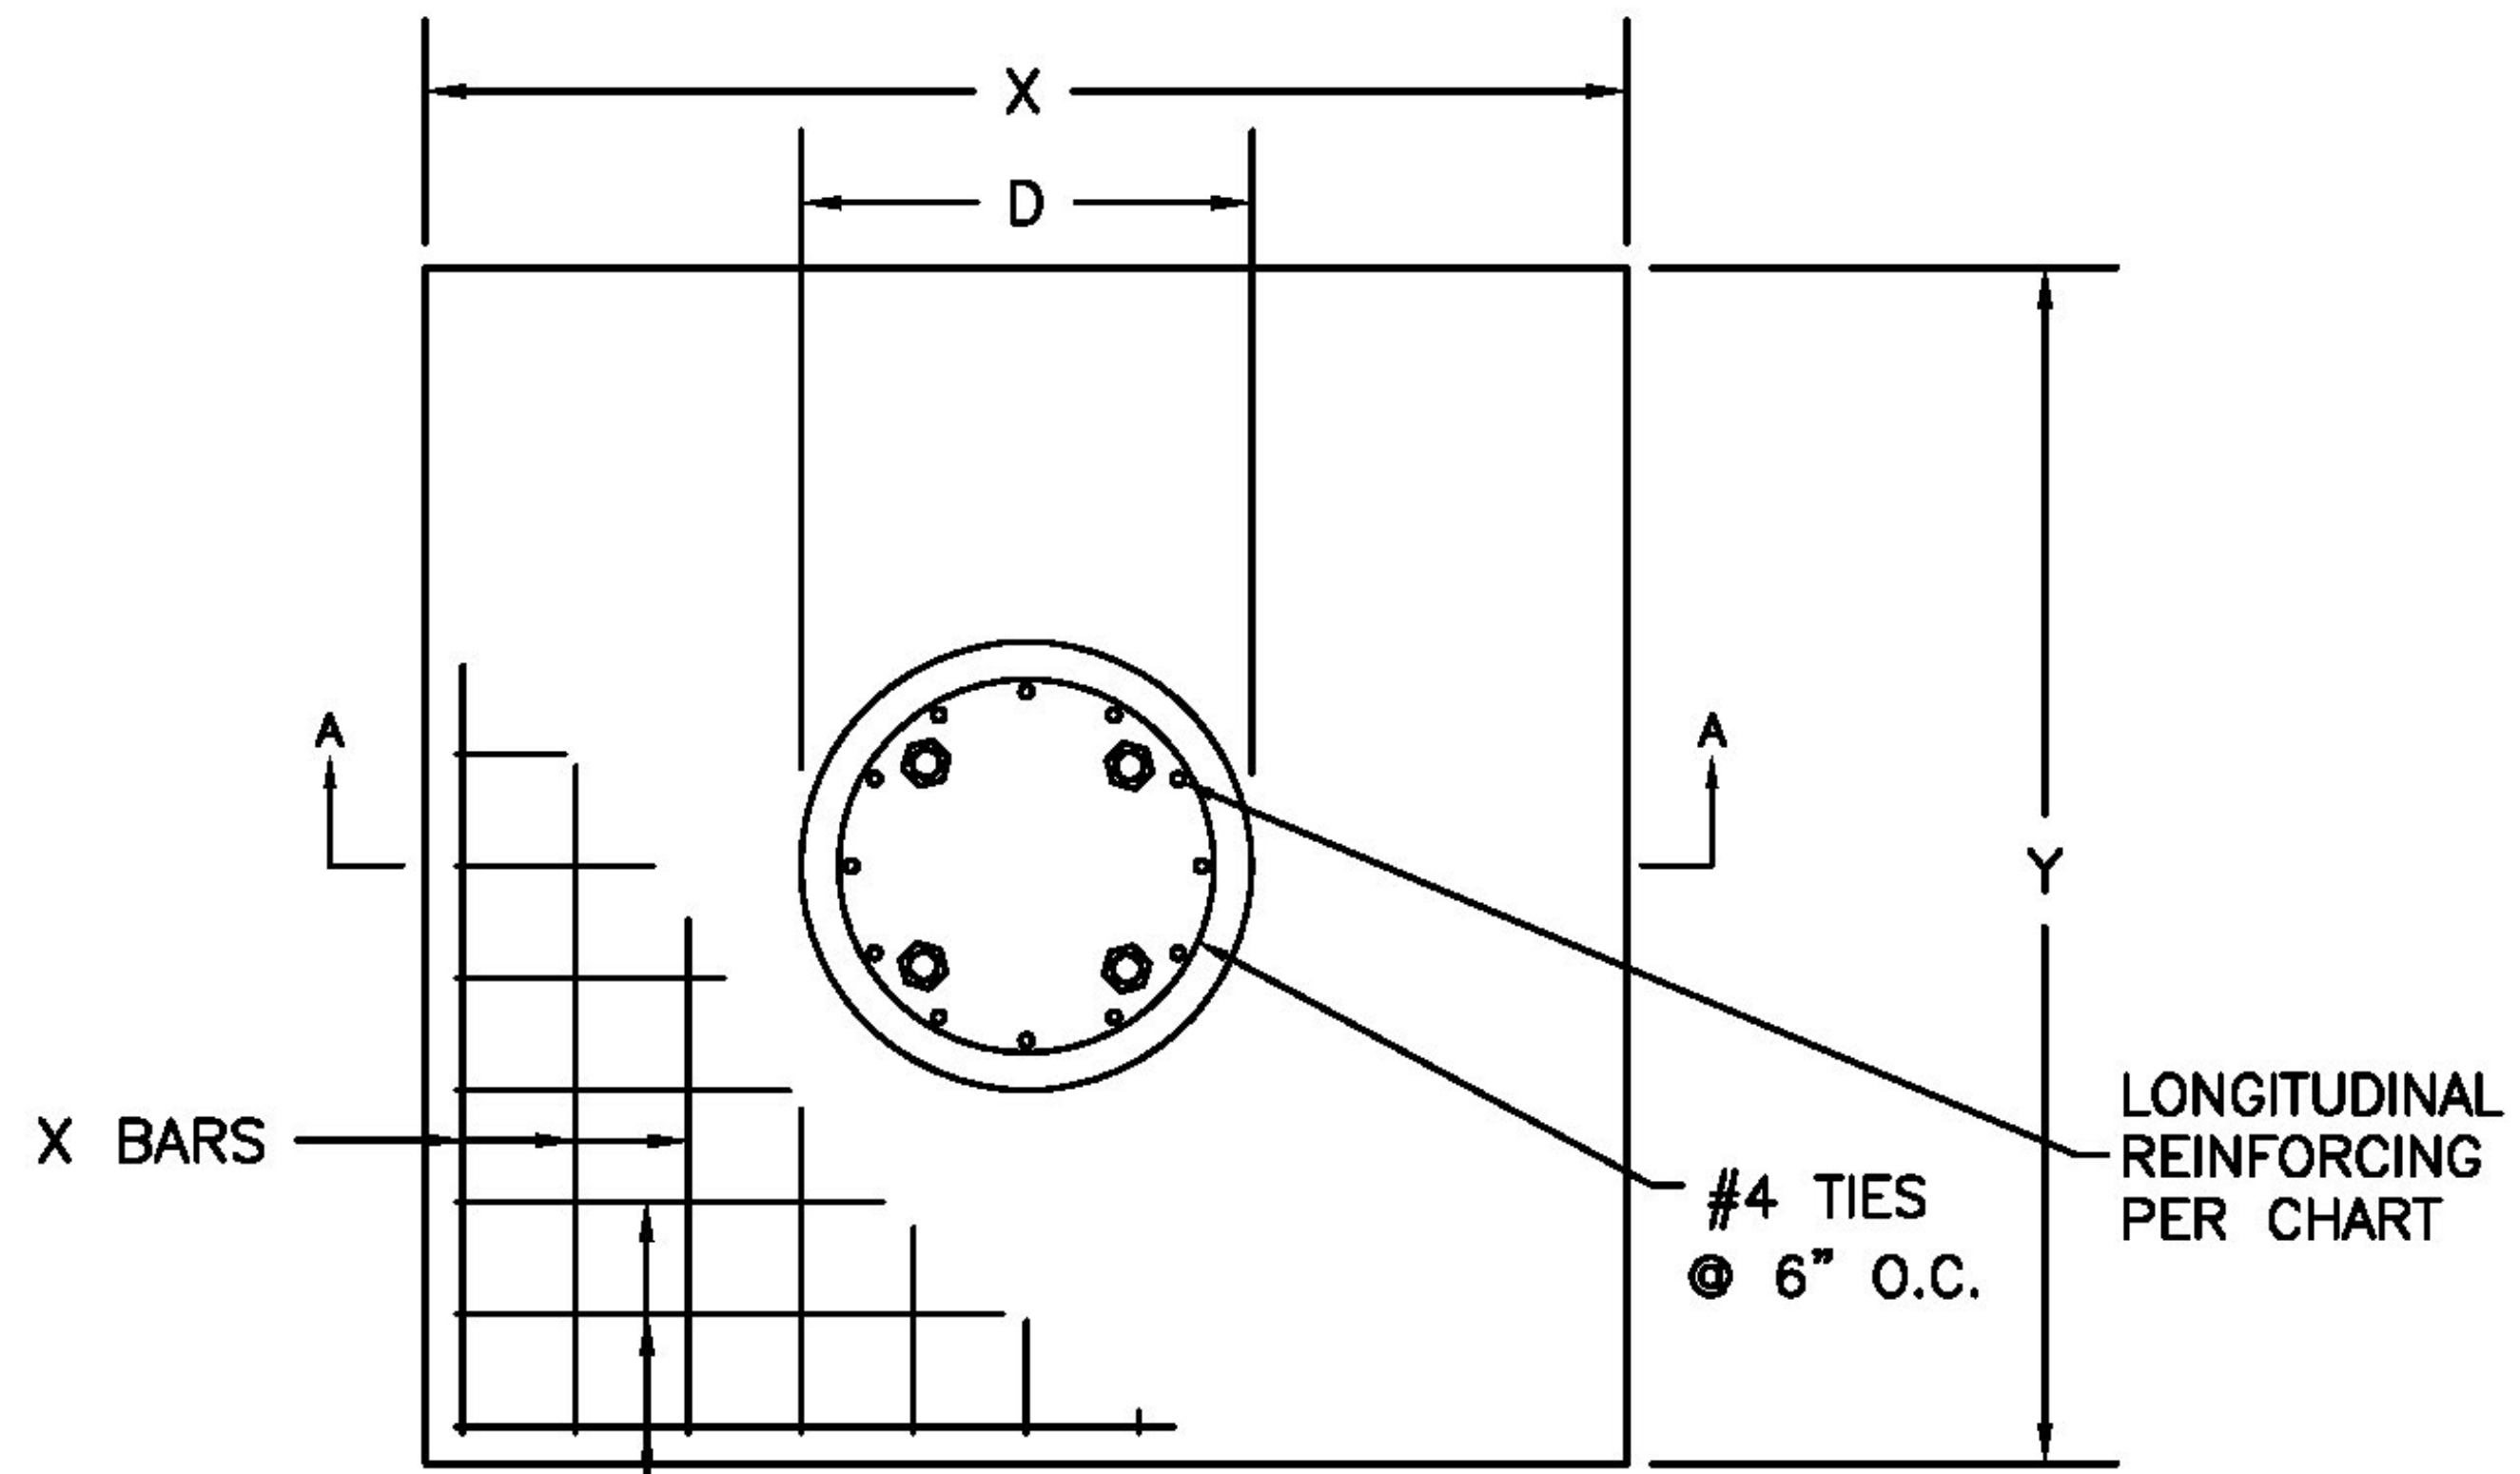


PLAN VIEW (4)- "L" BEND 55 KSI ANCHOR BOLTS, SIZE PER CHART. PLACEMENT PER POLE MANUFACTURER'S DRAWING.

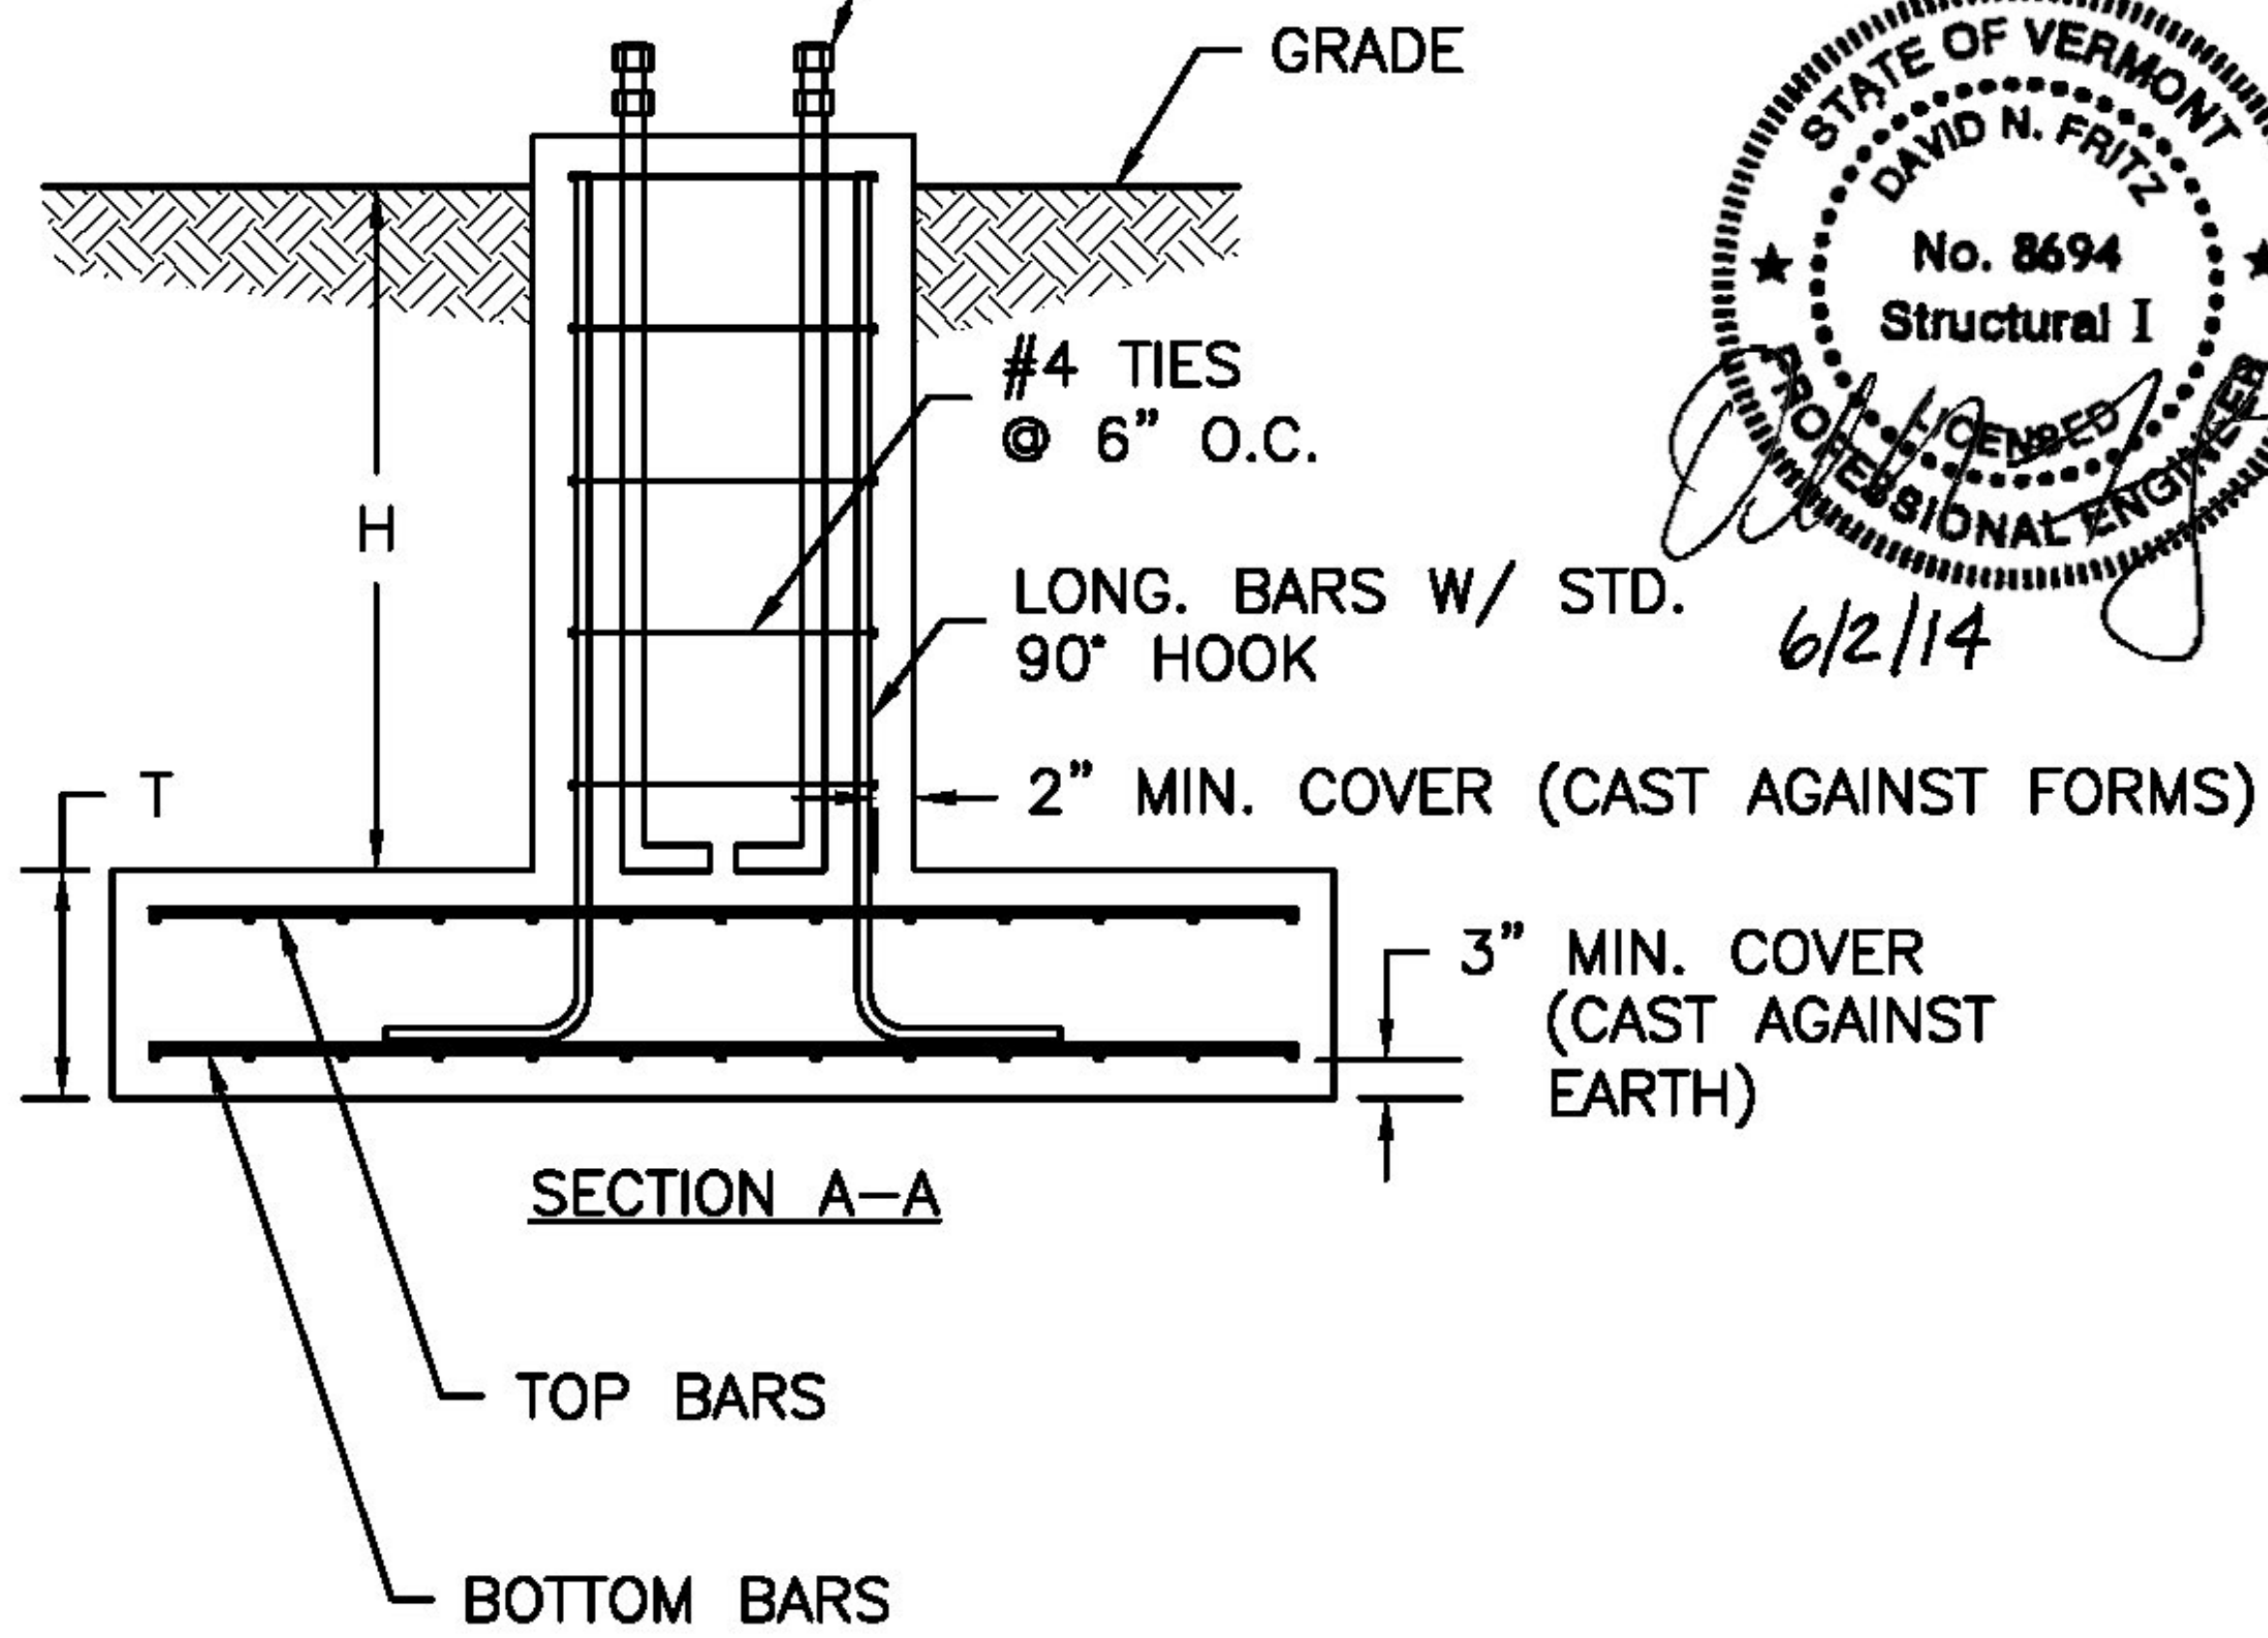

TRAFFIC SIGNAL POLE FOUNDATION DESIGN  
 WATERBURY NHG SGNL(43), VERMONT  
 VT ROUTE 100 & 1-89 EXIT 10 NB OFF RAMP  
 DRAWING NO. 235821-SF

NOTES:

1. FOUNDATION IS BASED ON SOIL BEARING CAPACITY OF 1,300 PSF.
2. GROUND SLOPE PER CROSS SECTIONS.
3. IF ACTUAL SITE CONDITIONS VARY FROM ABOVE INFORMATION, FOUNDATION REDESIGN IS REQUIRED.
4. MIN. CONCRETE COMPRESSIVE STRENGTH OF 3,500 PSI @ 28 DAYS.  
REINFORCING: ASTM A615 GR. 60.
5. FOUNDATION SHALL BE CAST AGAINST UNDISTURBED SOIL AND BACKFILLED WITH WELL COMPACTED GRANULAR MATERIAL.
6. IF REQUIRED, INSTALL CONDUIT PER OWNER SPECIFICATIONS.

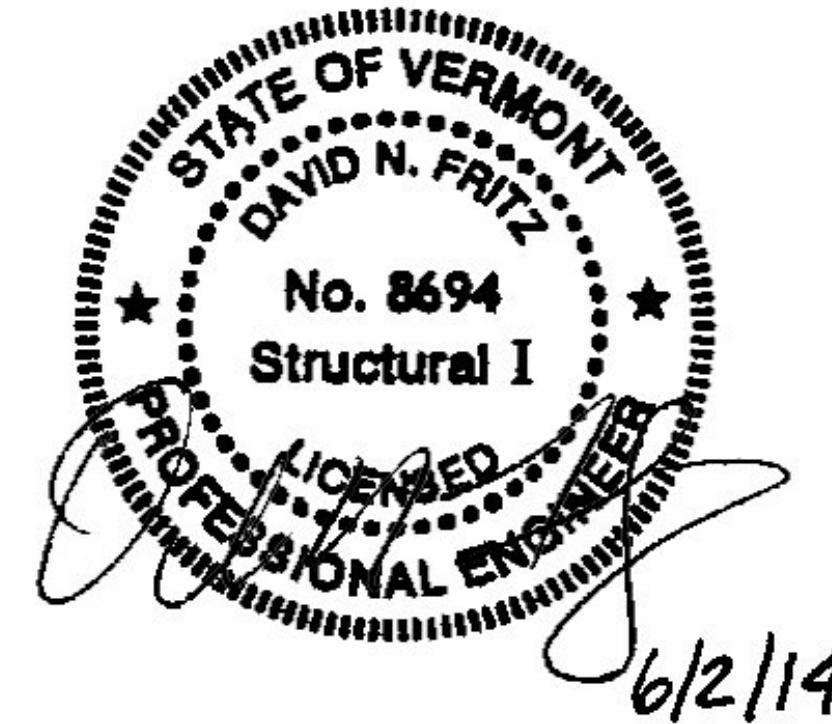


POLE ID	D	H	T	X	Y	ANCHOR BOLTS
MAP-1, 42', B-102	3'-0"	2'-6"	1'-6"	9'-6"	9'-6"	1 1/2" X 54" X 6"
TOTAL NO. OF REBARS REQUIRED						
	LONG.	X-TOP	X-BOT.	Y-TOP	Y-BOT.	
	12-#6	13-#5	13-#5	13-#5	13-#5	

POLE ID	D	H	T	X	Y	ANCHOR BOLTS
MAP-2, 34'/31', B-103	3'-0"	3'-6"	1'-6"	13'-0"	8'-0"	1 1/2" X 54" X 6"
TOTAL NO. OF REBARS REQUIRED						
	LONG.	X-TOP	X-BOT.	Y-TOP	Y-BOT.	
	12-#6	11-#5	11-#8	17-#5	17-#5	

VALMONT DRAWING NO. VT235821P1

**TRAFFIC SIGNAL POLE FOUNDATION DESIGN**  
**WATERBURY NHG SGNL(43), VERMONT**  
**VT ROUTE 100 & 1-89 EXIT 10 NB OFF RAMP**  
**DRAWING NO. 235821-SF**

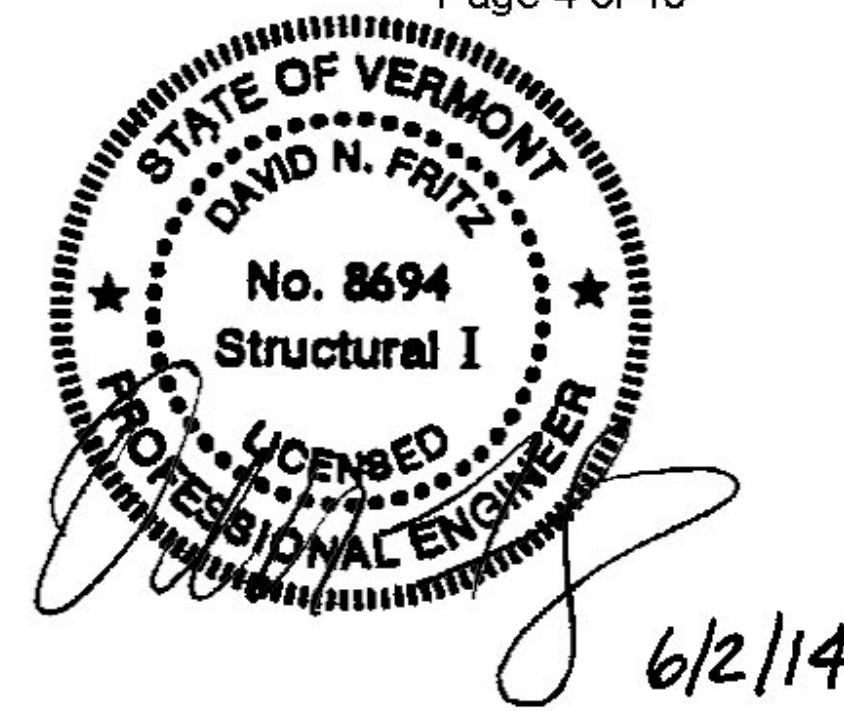

**TRAFFIC SIGNAL POLE FOUNDATION DESIGN  
WATERBURY NHG SGNL(43), VERMONT  
VT ROUTE 100 & I-89 EXIT 10 NB OFF RAMP**

Spread Footing Analysis

DRAWING NO. 235821-SF

	GROUP II MAP-1, 42'	GROUP III MAP-1, 42'	GROUP II MAP-2, 34'/31'	GROUP III MAP-2, 34'/31'
Structure ID	B-102	B-102	B-103	B-103
Fx - Shear (lbs)	6	576	5	8
Fz - Axial (lbs)	2,126	3,267	2,612	4,380
Fy - Shear (lbs)	1,622	812	2,376	1,592
Mx - Moment (ft-lbs)	33,229	15,476	62,830	63,629
Mz - Torsion (ft-lbs)	41,890	17,129	30,658	19,018
My - Moment (ft-lbs)	30,728	67,623	19,102	39,496

Depth to Ground Water (ft)	6.8	6.8	3.1	3.1
Soil Unit Wt (pcf)	120	120	120	120
Soil Friction Angle (deg)	32	32	32	32
At Rest Earth Pressure Coef.	0.38	0.38	0.38	0.38
Soil Friction Coef.	0.40	0.40	0.40	0.40
Conc. Unit Wt. (pcf)	150	150	150	150
Concrete Strength (psi)	3500	3500	3500	3500
Reinforcing Yield (psi)	60000	60000	60000	60000

Pedestal Diameter (ft)	3.00	3.00	3.00	3.00
Pedestal Height (ft)	2.50	2.50	3.50	3.50
Footing Thickness (ft)	1.50	1.50	1.50	1.50
X - Footing Width (ft)	9.50	9.50	13.00	13.00
Y - Footing Width (ft)	9.50	9.50	8.00	8.00

<b>Check O.T. &amp; Sliding:</b>				
Pedestal Wt. (lb)	2651	2651	3535	3535
Footing Wt. (lb)	20306	20306	13666	13666
Soil Wt. (lb)	24954	24954	38292	38292
Pole Wt. (lb)	2126	3267	2612	4380
Total Wt. (lb)	50037	51178	58104	59872
X - Factor of Safety (O.T.)	5.98	12.98	3.11	3.35
Y - Factor of Safety (O.T.)	7.73	3.48	19.75	9.84
Factor of Safety (Sliding)	12.34	20.56	9.78	15.04
	<b>OK</b>	<b>OK</b>	<b>OK</b>	<b>OK</b>

<b>Check Torsional Resistance:</b>				
Bot. Of Footing Friction	47536	48619	61009	62866
Top of Footing Friction	31193	31193	51694	51694
Side of Pedestal Friction	1259	1259	2467	2467
Passive Pressure Coefficient	3.25	3.25	3.25	3.25
Side of Footing Passive	85915	85915	137248	137248
Total Torsional Resistance	165902	166986	252418	254275
Factor of Safety (Torsion)	3.96	9.75	8.23	13.37
	<b>OK</b>	<b>OK</b>	<b>OK</b>	<b>OK</b>

	MAP-1, 42'	MAP-1, 42'	MAP-2, 34'/31'	MAP-2, 34'/31'
Structure ID	B-102	B-102	B-103	B-103
<b>Check Bearing Capacity:</b>				
X - Moment about toe (ft-lbs)	39717	18724	74710	71589
Y - Moment about toe (ft-lbs)	30752	69927	19127	39536
Area (sf)	90.25	90.25	104	104
X - Section Modulus (cf)	142.9	142.9	138.7	138.7
Y - Section Modulus (cf)	142.9	142.9	225.3	225.3
X - Eccentricity (ft)	0.615	1.366	0.329	0.660
e<=1/6 B	<b>OK</b>	<b>OK</b>	<b>OK</b>	<b>OK</b>
Y - Eccentricity (ft)	0.794	0.366	1.286	1.196
e<=1/6 B	<b>OK</b>	<b>OK</b>	<b>OK</b>	<b>OK</b>
Scenario 1 - No Tension:				
Qa (psf)	617	209	1013	917
Qb (psf)	1048	1187	1182	1267
Qc (psf)	492	925	105	235
Qd (psf)	61	-53	-65	-116
Scenario 2 - Corner Tension:				
Zero Pressure Angle (radians)	0.6589	1.3092	0.0967	0.2062
H1 (ft) - SELECT VALUE	14.171	11.130	8.729	9.584
X- Leg (ft)	23.147	11.522	90.455	46.817
Y - Leg (ft)	17.922	43.031	8.770	9.791
H2 (ft)	8.355	1.953	7.474	6.923
H3 (ft)	6.659	8.673	0.766	1.753
L1 (ft)	29.275	44.547	90.880	47.830
L2 (ft)	17.260	7.818	77.819	34.549
L3 (ft)	13.757	34.712	7.979	8.751
Load Offset (ft)	8.511	6.728	5.432	5.644
Moment of Inertia (ft^4)	5764.98	3226.35	2328.78	2549.69
Qa (psf)	617	208	1013	917
Qb (psf)	<b>1047</b>	<b>1188</b>	<b>1183</b>	<b>1270</b>
Qc (psf)	492	926	104	232
Psoil (lbs)	50035	51180	58105	59872
Papplied (lbs)	50037	51178	58104	59872
% Difference	<b>0.00</b>	<b>0.00</b>	<b>0.00</b>	<b>0.00</b>
	<b>OK</b>	<b>OK</b>	<b>OK</b>	<b>OK</b>

**Check Settlement:**

Subgrade Material	Gravel/Rock	Gravel/Rock	Gravel/Rock	Gravel/Rock
	<b>OK</b>	<b>OK</b>	<b>OK</b>	<b>OK</b>

**Concrete Structural Design:**

X - Q at face of pedestal (psf)	900	853	1118	1134
Y - Q at face of pedestal (psf)	857	1098	846	946
Mx at face of pedestal (pos.)	55697	61092	32386	34455
My at face of pedestal (pos.)	54980	65195	195786	213741
Mx at face of pedestal (neg.)	26340	26340	16125	16125
My at face of pedestal (neg.)	26340	26340	104813	104813


Structure ID	MAP-1, 42' B-102	MAP-1, 42' B-102	MAP-2, 34'/31' B-103	MAP-2, 34'/31' B-103
<b>X-Direction - Top Slab Reinforcing:</b>				
Load Factor	1.3	1.3	1.3	1.3
Mu (k-in)	411	411	1635	1635
phi	0.9	0.9	0.9	0.9
Mn (k-in)	457	457	1817	1817
Bar Diameter (in)	<b>0.625</b>	<b>0.625</b>	<b>0.625</b>	<b>0.625</b>
Cover	2	2	2	2
d (in)	15.06	15.06	15.06	15.06
Rn (ksi)	0.0177	0.0177	0.0834	0.0834
m	20.17	20.17	20.17	20.17
p - reinforcing ratio required	0.0003	0.0003	0.0014	0.0014
p - s+t	0.0018	0.0018	0.0018	0.0018
p min (1.33 x p)	0.0004	0.0004	0.0019	0.0019
p bal	0.0249	0.0249	0.0249	0.0249
p max	0.0187	0.0187	0.0187	0.0187
p required	0.0018	0.0018	0.0019	0.0019
As - (in ² ) - Top Bars	3.69	3.69	3.24	3.24
Number of Bars - Top	<b>13</b>	<b>13</b>	<b>11</b>	<b>11</b>

<b>X-Direction - Bottom Slab Reinforcing:</b>				
Mu (k-in)	858	1017	3054	3334
phi	0.9	0.9	0.9	0.9
Mn (k-in)	953	1130	3394	3705
Bar Diameter (in)	<b>0.625</b>	<b>0.625</b>	<b>1.000</b>	<b>1.000</b>
Cover	3	3	3	3
d (in)	14.06	14.06	13.50	13.50
Rn (ksi)	0.0423	0.0501	0.1940	0.2118
m	20.17	20.17	20.17	20.17
p - reinforcing ratio required	0.0007	0.0008	0.0033	0.0037
p - s+t	0.0018	0.0018	0.0018	0.0018
p min (1.33 x p)	0.0009	0.0011	0.0044	0.0049
p bal	0.0249	0.0249	0.0249	0.0249
p max	0.0187	0.0187	0.0187	0.0187
p required	0.0018	0.0018	0.0044	0.0049
As - (in ² ) - Top Bars	3.69	3.69	7.69	8.42
Number of Bars - Top	<b>13</b>	<b>13</b>	<b>10</b>	<b>11</b>

	MAP-1, 42'	MAP-1, 42'	MAP-2, 34'/31'	MAP-2, 34'/31'
Structure ID	B-102	B-102	B-103	B-103
<b>Y-Direction - Top Slab Reinforcing:</b>				
Mu (k-in)	411	411	252	252
phi	0.9	0.9	0.9	0.9
Mn (k-in)	457	457	280	280
Bar Diameter (in)	<b>0.625</b>	<b>0.625</b>	<b>0.625</b>	<b>0.625</b>
Cover	2	2	2	2
d (in)	15.06	15.06	15.06	15.06
Rn (ksi)	0.0177	0.0177	0.0079	0.0079
m	20.17	20.17	20.17	20.17
p - reinforcing ratio required	0.0003	0.0003	0.0001	0.0001
p - s+t	0.0018	0.0018	0.0018	0.0018
p min (1.33 x p)	0.0004	0.0004	0.0002	0.0002
p bal	0.0249	0.0249	0.0249	0.0249
p max	0.0187	0.0187	0.0187	0.0187
p required	0.0018	0.0018	0.0018	0.0018
As - (in ² ) - Top Bars	3.69	3.69	5.05	5.05
Number of Bars - Top	<b>13.0</b>	<b>13.0</b>	<b>17.0</b>	<b>17.0</b>

<b>Y-Direction - Bottom Slab Reinforcing:</b>				
Mu (k-in)	869	953	505	538
phi	0.9	0.9	0.9	0.9
Mn (k-in)	965	1059	561	597
Bar Diameter (in)	<b>0.625</b>	<b>0.625</b>	<b>0.625</b>	<b>0.625</b>
Cover	3	3	3	3
d (in)	14.06	14.06	14.06	14.06
Rn (ksi)	0.0428	0.0470	0.0182	0.0194
m	20.17	20.17	20.17	20.17
p - reinforcing ratio required	0.0007	0.0008	0.0003	0.0003
p - s+t	0.0018	0.0018	0.0018	0.0018
p min (1.33 x p)	0.0010	0.0010	0.0004	0.0004
p bal	0.0249	0.0249	0.0249	0.0249
p max	0.0187	0.0187	0.0187	0.0187
p required	0.0018	0.0018	0.0018	0.0018
As - (in ² ) - Top Bars	3.69	3.69	5.05	5.05
Number of Bars - Top	<b>13.0</b>	<b>13.0</b>	<b>17.0</b>	<b>17.0</b>

	MAP-1, 42'	MAP-1, 42'	MAP-2, 34'/31'	MAP-2, 34'/31'
Structure ID	B-102	B-102	B-103	B-103
<b>Vertical Direction - Pedestal Reinforcing:</b>				
Load Factor	1.3	1.3	1.3	1.3
Strength Reduction Factor	0.7	0.7	0.7	0.7
Mu (k-in)	592	862	888	966
Concrete Strength (psi)	3500	3500	3500	3500
Reinforcing Steel Yield (psi)	60000	60000	60000	60000
Concrete Cover (in)	2	2	2	2
Shear Reinf. Dia. (in)	0.5	0.5	0.5	0.5
Tension Reinf. Dia. (in)	<b>0.75</b>	<b>0.75</b>	<b>0.75</b>	<b>0.75</b>
No. of Bars	<b>12</b>	<b>12</b>	<b>12</b>	<b>12</b>
Tie Bars	<b>#4 @6"</b>	<b>#4 @6"</b>	<b>#4 @6"</b>	<b>#4 @6"</b>
e (in)	278.35	263.95	339.90	220.45
As (in ² )	5.30	5.30	5.30	5.30
Ag (in ² )	1017.88	1017.88	1017.88	1017.88
m	20.17	20.17	20.17	20.17
D (in)	36.00	36.00	36.00	36.00
Ds (in)	30.25	30.25	30.25	30.25
p - reinforcement ratio	0.0052	0.0052	0.0052	0.0052
phi*Pn (lbs)	7692	8139	6231	9871
Pu (lbs)	2764	4247	3396	5694
	<b>OK</b>	<b>OK</b>	<b>OK</b>	<b>OK</b>

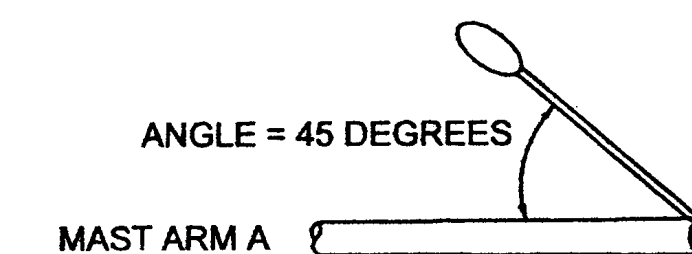


LUMINAIRE ORIENTATION


NOTES:

1. ALL MAST ARM FOOTINGS SHALL INCLUDE A 4" REVEAL. ELEVATIONS SHOWN IN CROSS-SECTIONS ARE APPROXIMATE FINAL GRADE ELEVATIONS FOR CONTRACTOR BIDDING PURPOSES ONLY. ACTUAL FOOTING ELEVATIONS SHALL BE DETERMINED BY THE CONTRACTOR PRIOR TO SUBMITTING WORKING DRAWINGS.
2. MAST ARM FOOTING SIZES ARE NOT TO SCALE. FOOTING DESIGNS SHALL BE DETERMINED BY THE CONTRACTOR IN ACCORDANCE WITH SOIL CONDITIONS AND ACTUAL MAST ARM LOADINGS TRANSMITTED TO THE TOP OF THE FOOTINGS.
3. PLEASE REFER TO SHEET 3-4 FOR BORING INFORMATION. FOR ADDITIONAL INFORMATION PLEASE REFER TO THE GEOTECHNICAL REPORT IN THE CONTRACT DOCUMENTS.
4. SIGNAL HEADS SHALL BE MOUNTED ON THE VERTICAL CENTER OF THE MAST ARM.

MAST ARM POLE #1  
ARM A  
LOOKING NORTH-EAST ON  
VT 100 NORTH


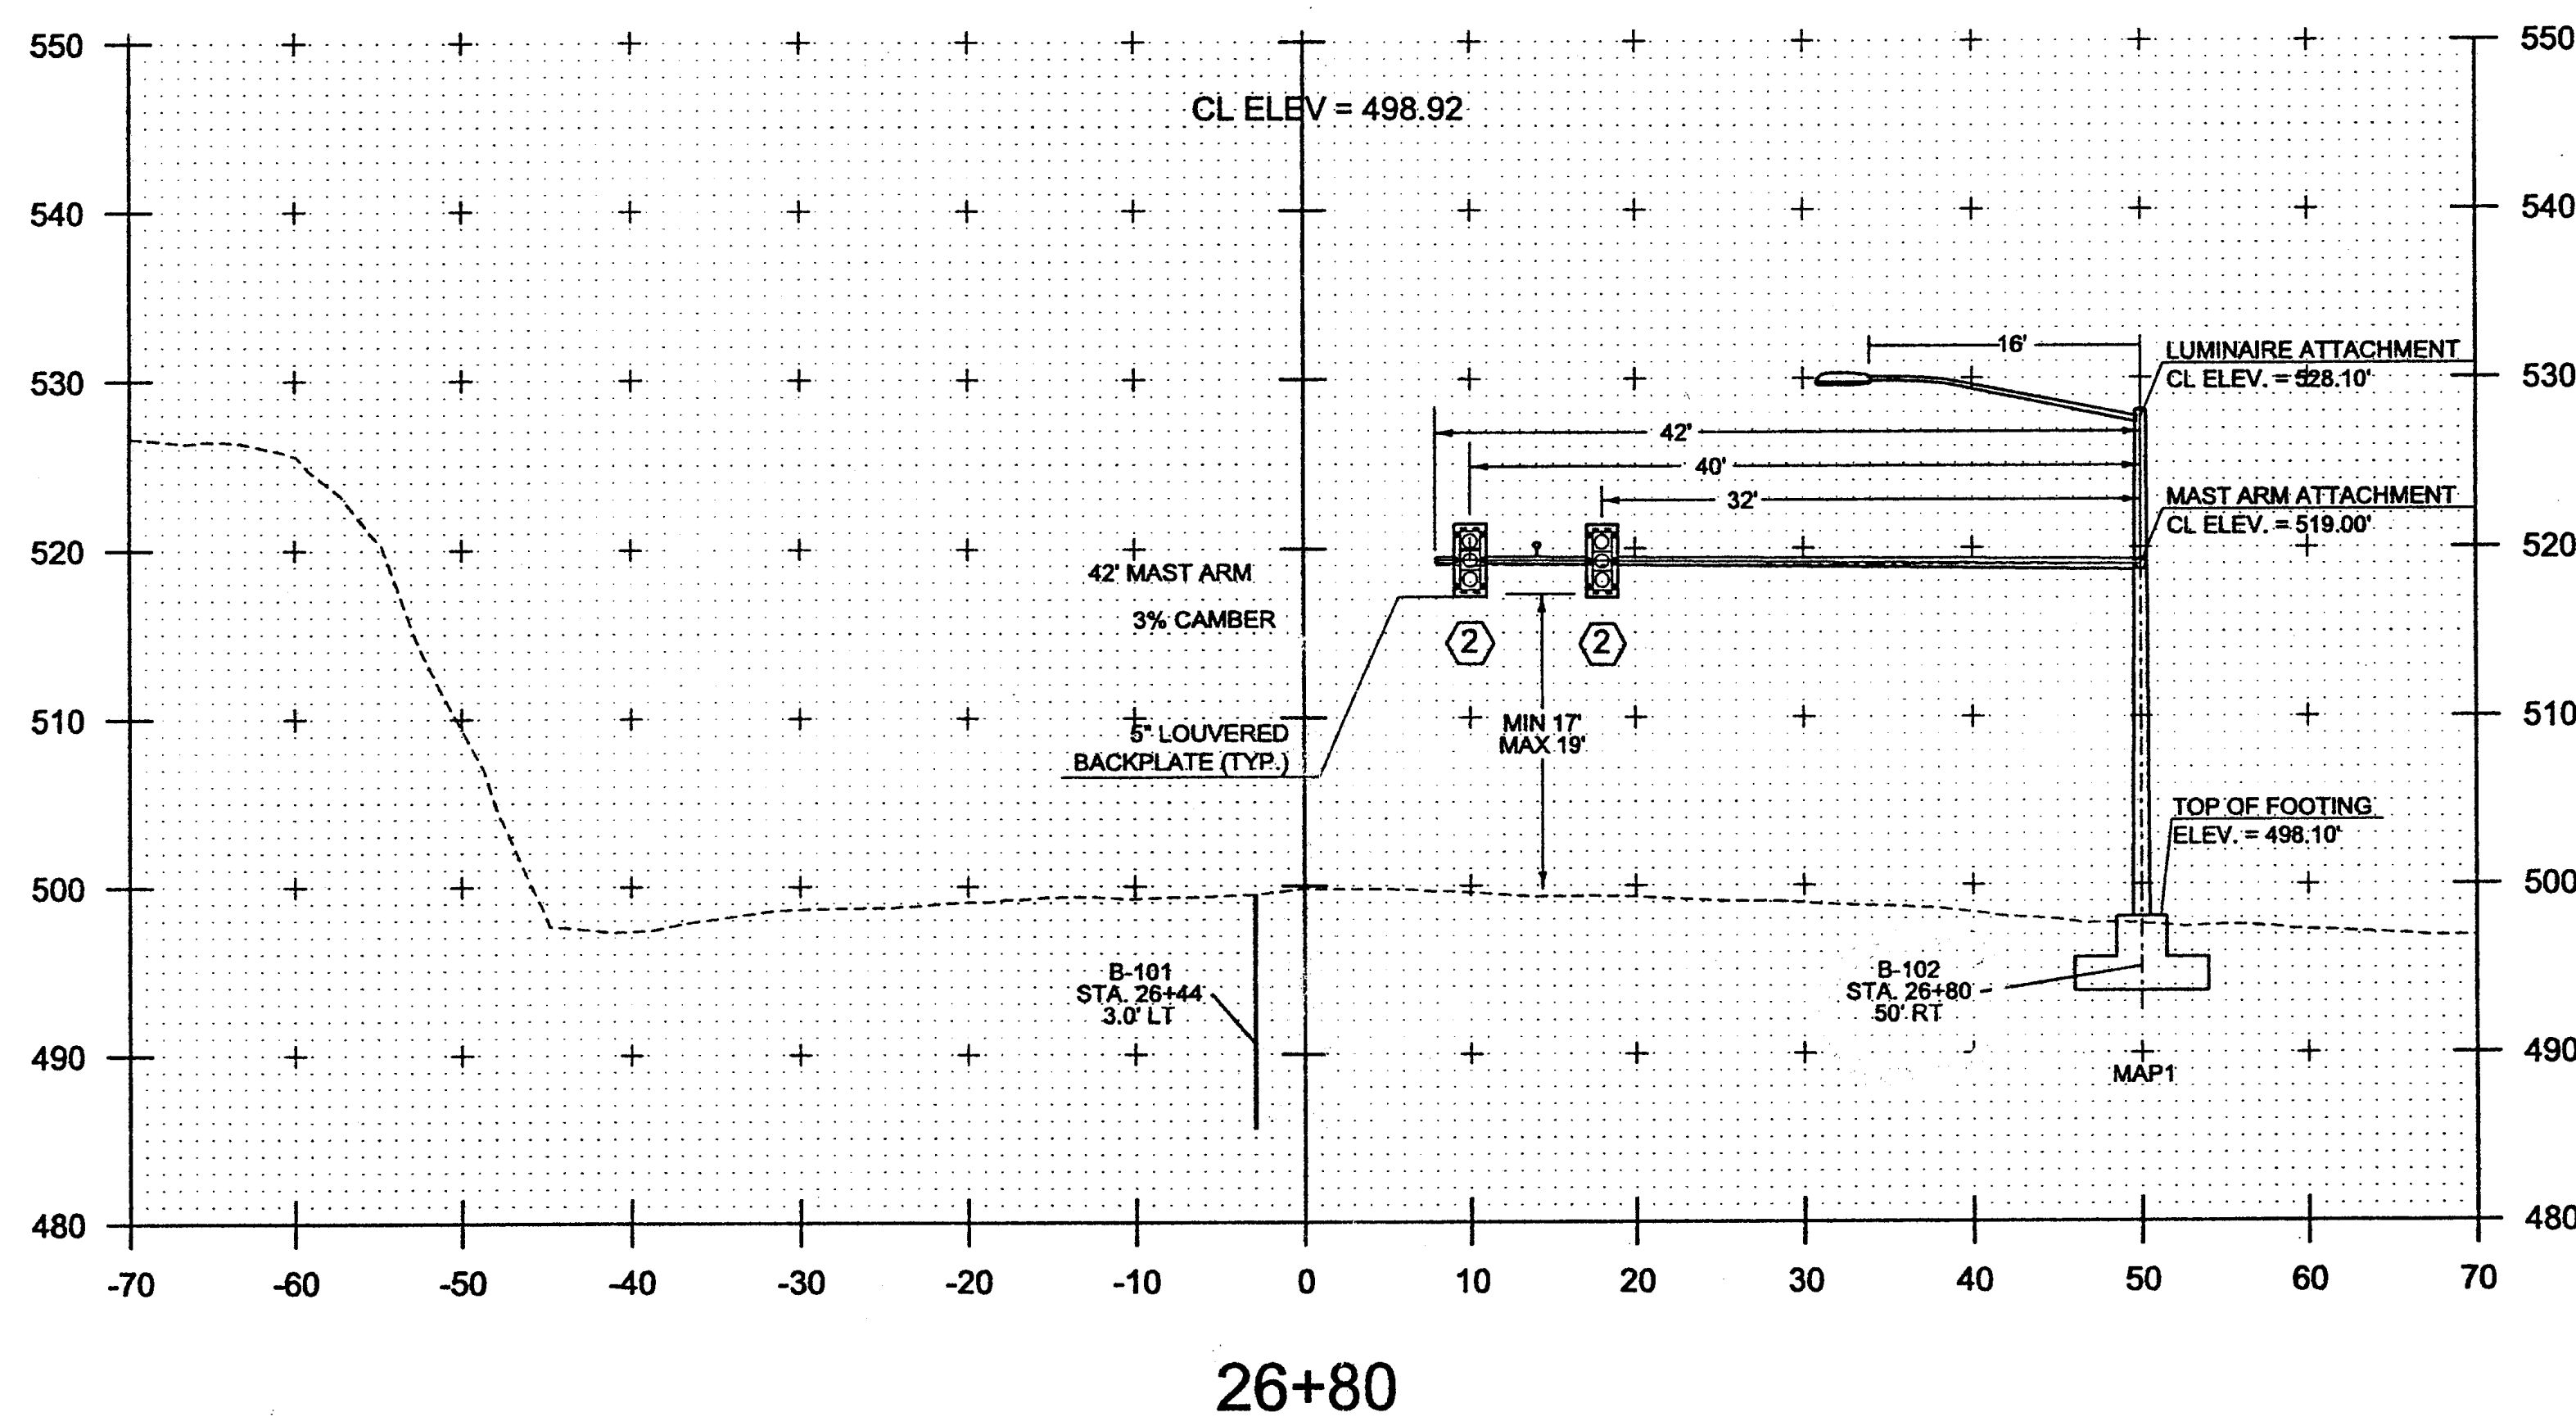


NEW	LEGEND
?	VIDEO DETECTION CAMERA
⚡	PREEMPTION STROBE
†	OPTICAL PREEMPTION DETECTOR

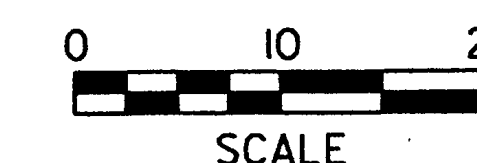

PROJECT NAME:	WATERBURY
PROJECT NUMBER:	NHG SGNL(43)
FILE NAME:	t13b018traf.dgn
PROJECT LEADER:	P. COBURN
DESIGNED BY:	I. DEGUTIS
MAST ARM CROSS SECTION SHEET 1	
PLOT DATE:	12/31/2013
DRAWN BY:	I. DEGUTIS
CHECKED BY:	M. LaCROIX
SHEET 14	OF 17


MAST ARM POLE #2  
ARM B  
LOOKING NORTH-WEST ON  
I-89 NB EXIT 10 OFF-RAMP

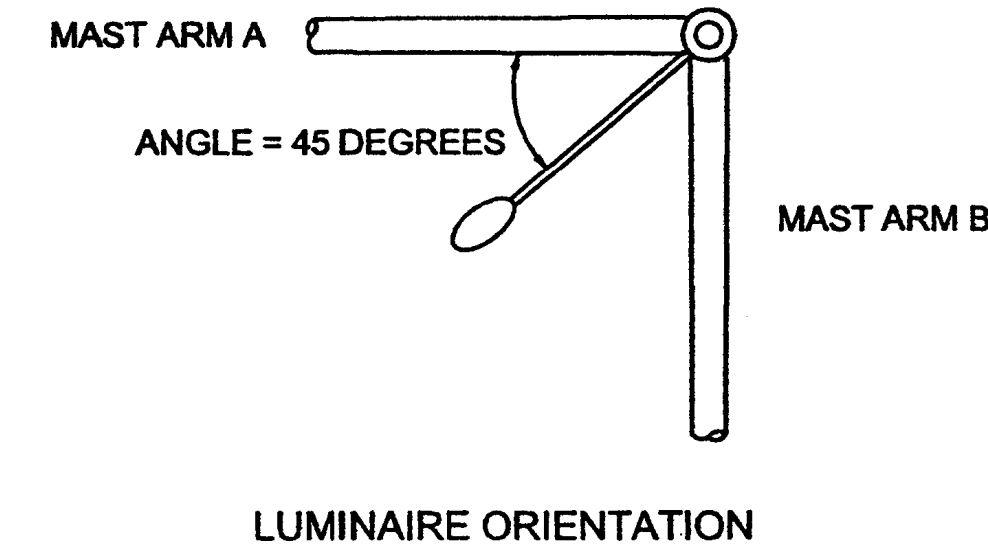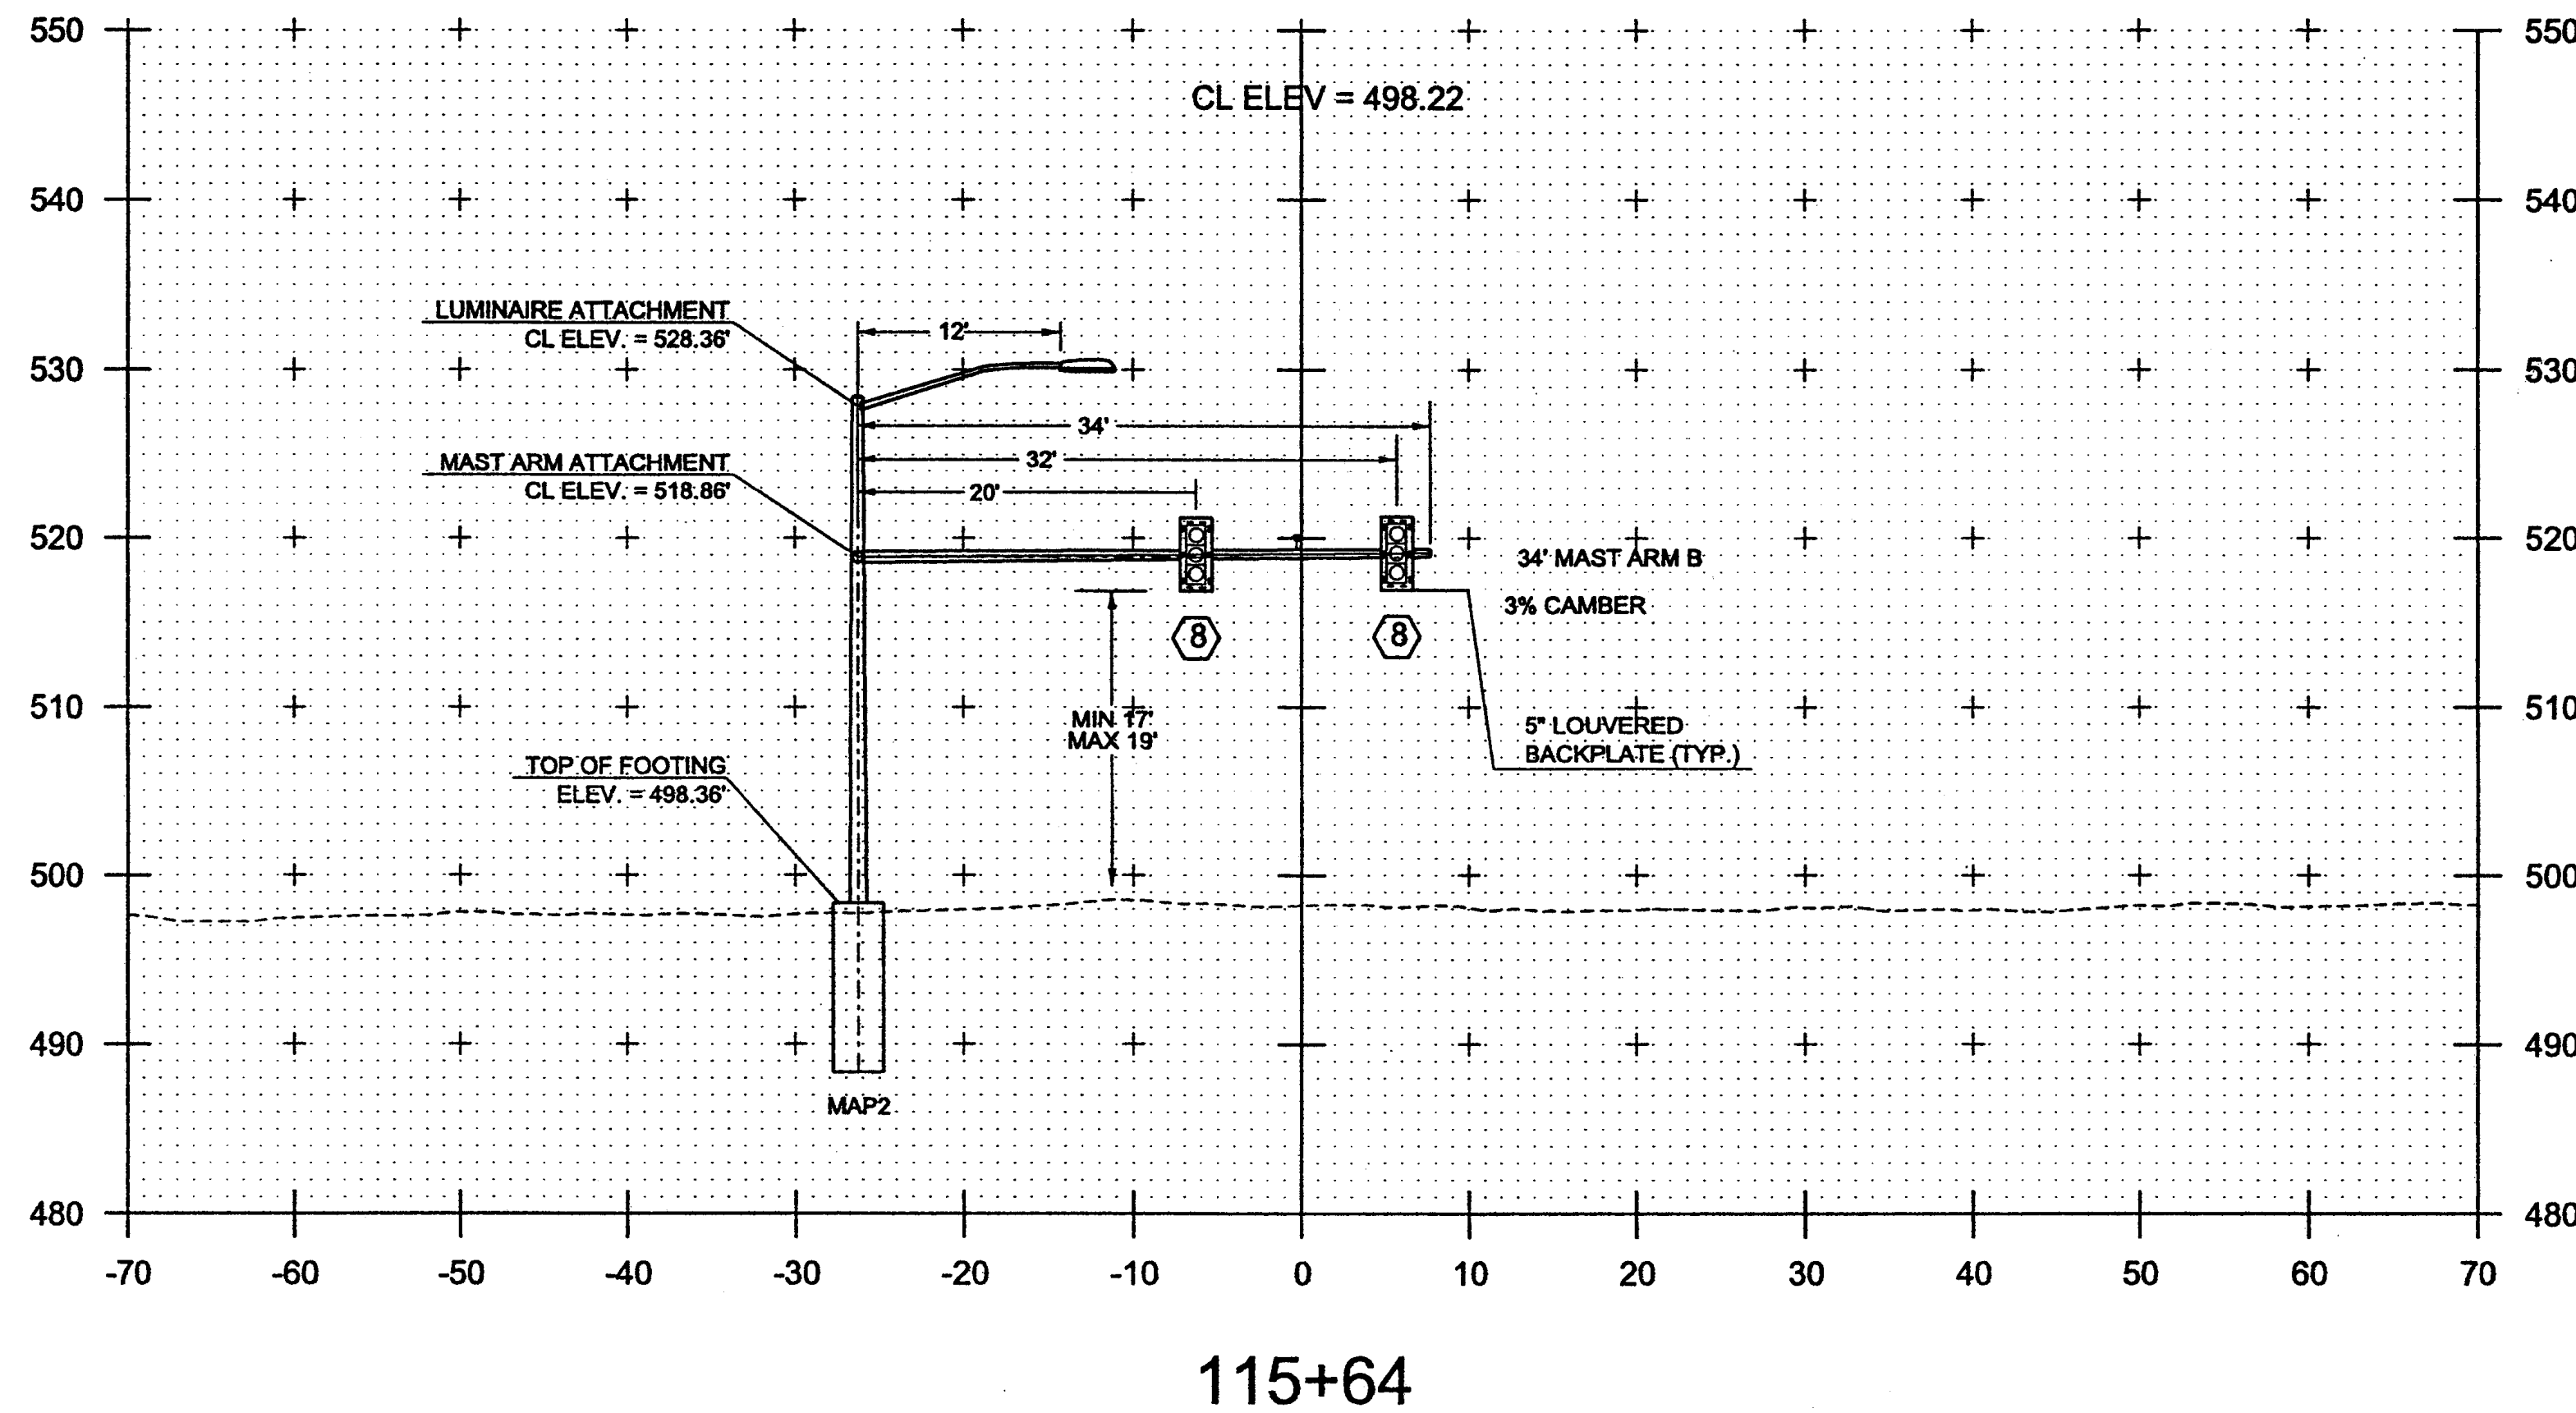


NOTES :

1. ALL MAST ARM FOOTINGS SHALL INCLUDE A 4" REVEAL. ELEVATIONS SHOWN IN CROSS-SECTIONS ARE APPROXIMATE FINAL GRADE ELEVATIONS FOR CONTRACTOR BIDDING PURPOSES ONLY. ACTUAL FOOTING ELEVATIONS SHALL BE DETERMINED BY THE CONTRACTOR PRIOR TO SUBMITTING WORKING DRAWINGS.
2. MAST ARM FOOTING SIZES ARE NOT TO SCALE. FOOTING DESIGNS SHALL BE DETERMINED BY THE CONTRACTOR IN ACCORDANCE WITH SOIL CONDITIONS AND ACTUAL MAST ARM LOADINGS TRANSMITTED TO THE TOP OF THE FOOTINGS.
3. PLEASE REFER TO SHEET 3-4 FOR BORING INFORMATION. FOR ADDITIONAL INFORMATION PLEASE REFER TO THE GEOTECHNICAL REPORT IN THE CONTRACT DOCUMENTS.
4. SIGNAL HEADS SHALL BE MOUNTED ON THE VERTICAL CENTER OF THE MAST ARM.

MAST ARM POLE #2  
ARM A  
LOOKING SOUTH-WEST ON  
VT 100 SOUTH

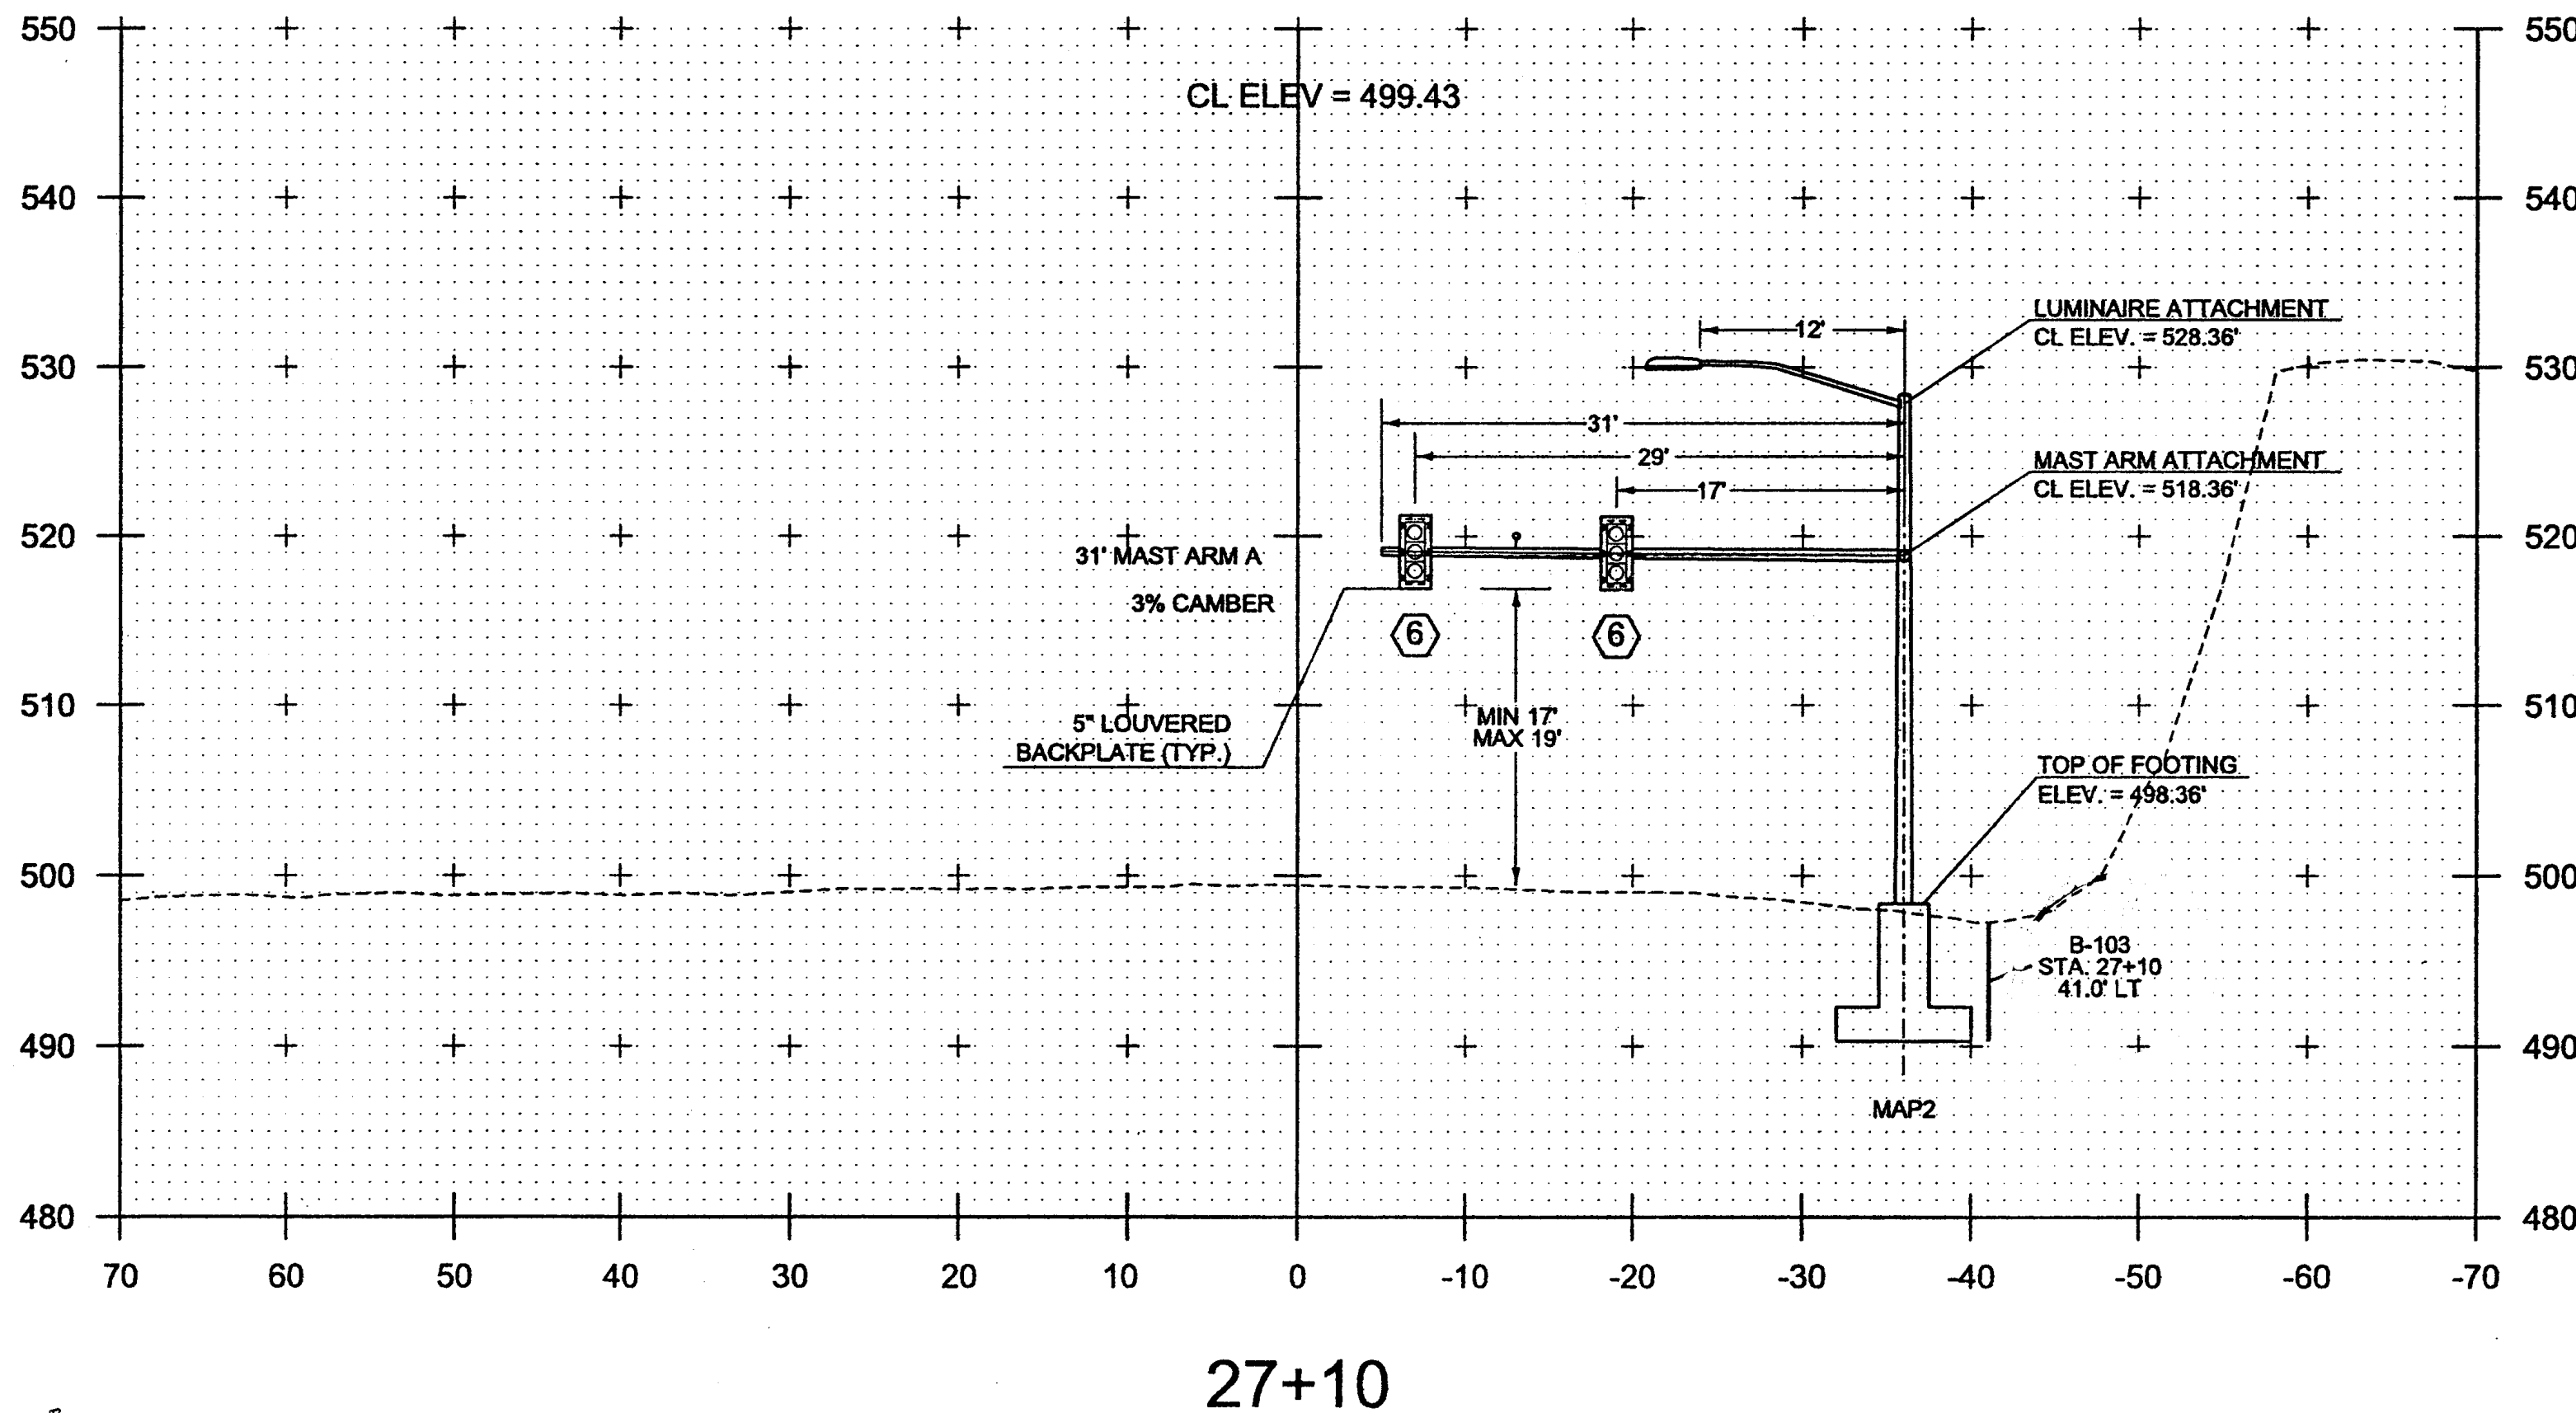

NEW	LEGEND
⬇	VIDEO DETECTION CAMERA
⬇	PREEMPTION STROBE
⬇	OPTICAL PREEMPTION DETECTOR

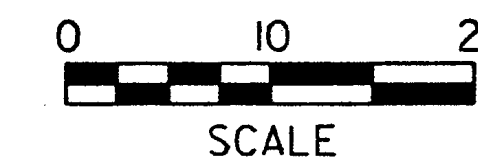

PROJECT NAME: WATERBURY  
PROJECT NUMBER: NHG SCNL(43)


FILE NAME: t13b018traf.dgn PLOT DATE: 12/31/2013  
PROJECT LEADER: P. COBURN DRAWN BY: L. DEGUTIS  
CHECKED BY: M. BROWN

Certified by ISO9001 International Quality Control System

### JXC-300CA Series LED Vehicular Lamps

#### Features & Specifications

- Compliance with ITE/Caltrans specifications
- Retrofit design & UV stabilized lens
- MIL-STD-883 mechanical vibration
- MIL-STD-810F moisture resistant
- Compliant to FCC Title 47
- Fully compatible with NEMA controllers/conflict monitors
- Wide viewing angle for span wire/mast arm mount

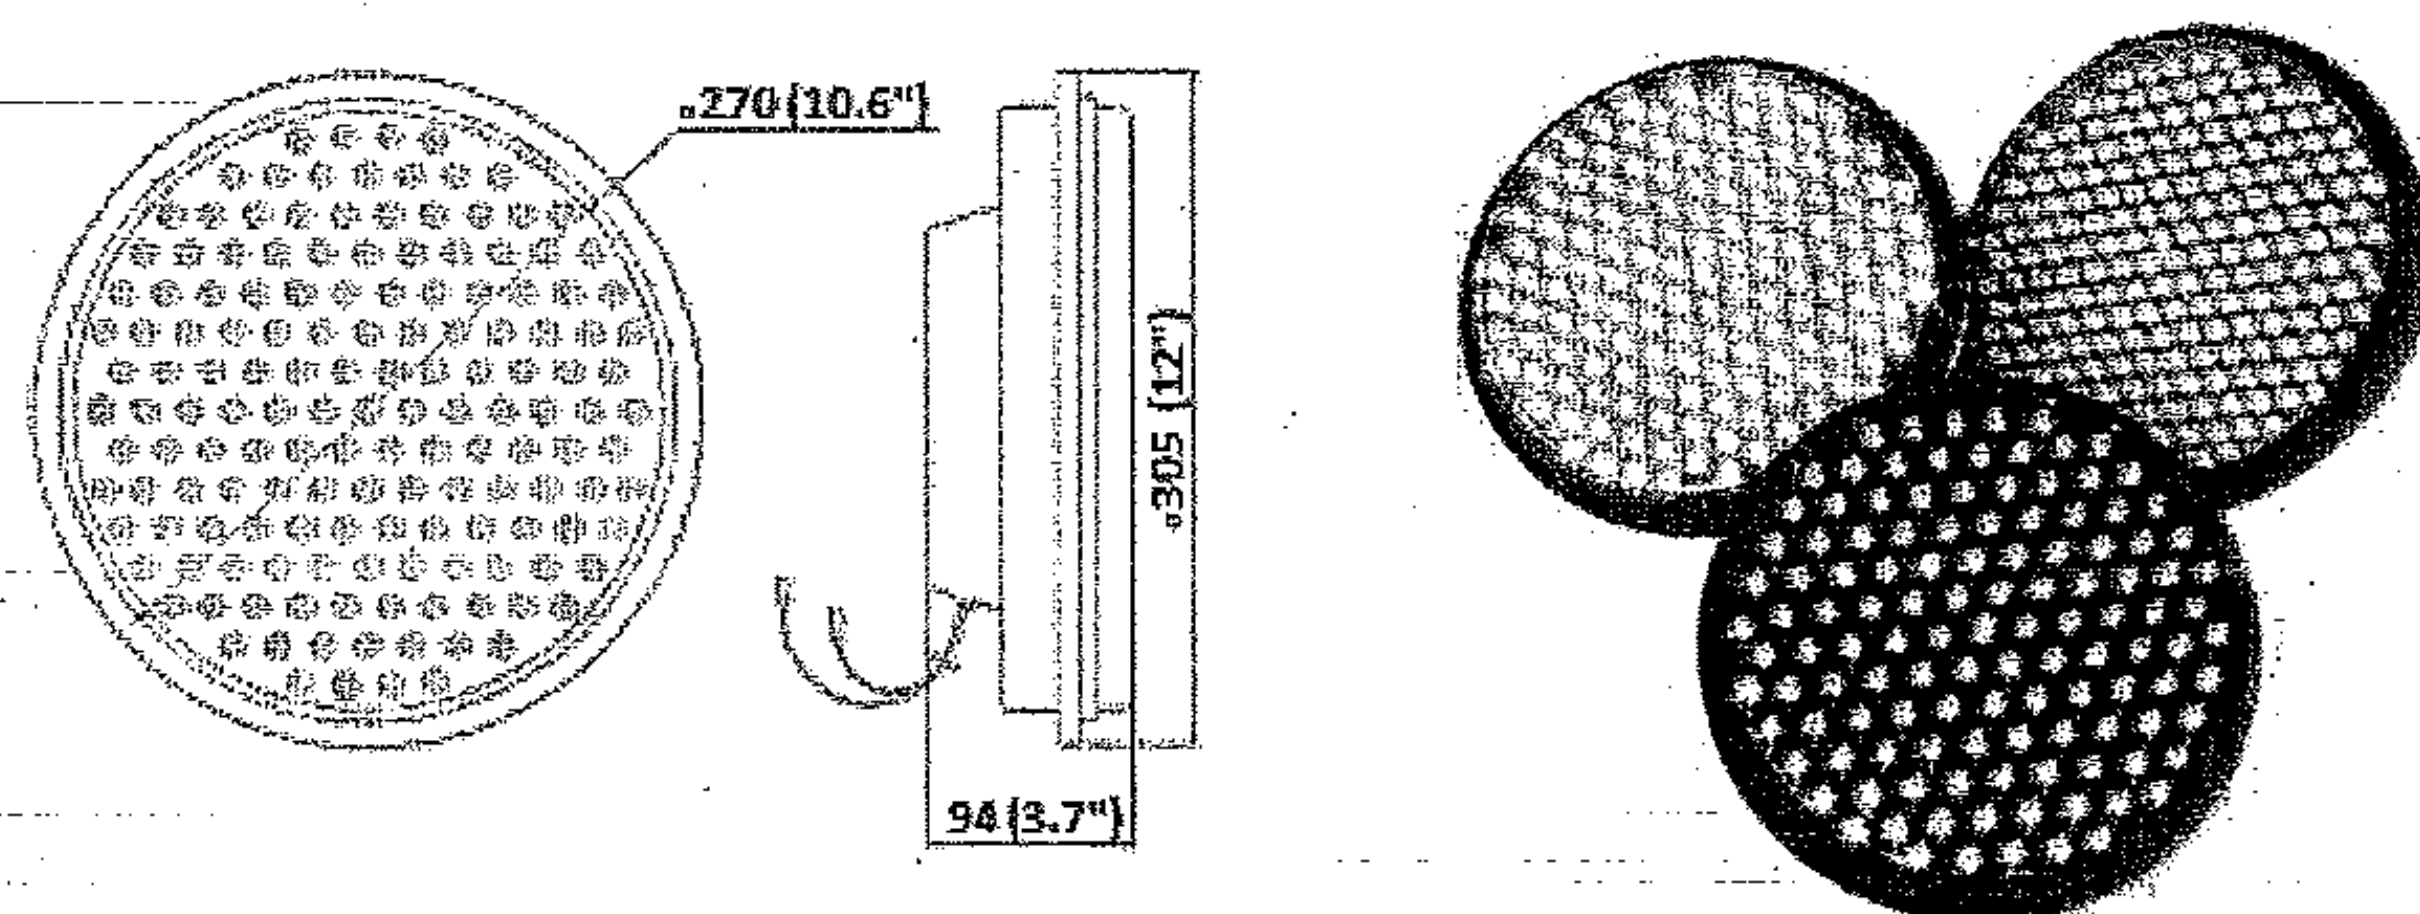

Model Number	JXC-300CAR	JXC-300CAY	JXC-300CAG
Size (mm)	300mm	300mm	300mm
Color (nm)	Red (626)	Yellow (592)	Green (505)
Voltage (Typical)	120V - 60hz	120V - 60hz	120V - 60hz
Voltage Range	80V - 135V	80V - 135V	80V - 135V
Power (w) Typical	10.5	17	12
Operation Temperature	-40°F to +165°F	-40°F to +165°F	-40°F to +165°F
Power Factor	> 0.9	> 0.9	> 0.9
T.H.D.	< 20%	< 20%	< 20%
ITE/Caltrans Specifications	Yes	Yes	Yes

All characteristics, including, chromaticity, moisture and vibration resistance, electronic noise, transient protection, etc., are conformed to standards specified in ITE LED Vehicle Signal Modules.



**SIGNALSRYG, INC.  
FRED CHAMBERLIN**

**PROJECT:  
WATERBURY NHG SIGNAL  
43**

**LIGHTING SUBMITTAL  
03/26/2014**


**Mike Mone** | Project Specialist Direct Line (802) 448-7607  
58 Miller Lane | Williston, VT 05495 | Office (802) 660-9900 | Fax (802) 660-8700 |  
[mike.mone@graybar.com](mailto:mike.mone@graybar.com)  
[www.graybar.com](http://www.graybar.com) -

---

**Steven Merritt** | Outside Sales Representative Direct Line 802-448-7627  
21 Allen Street | Rutland, VT 05701 | Office (802) 660-9900 | Fax (802) 775-3863 |  
[steven.merritt@graybar.com](mailto:steven.merritt@graybar.com)  
[www.graybar.com](http://www.graybar.com) -

# LEDGEND®

ROADWAY LED LUMINAIRE

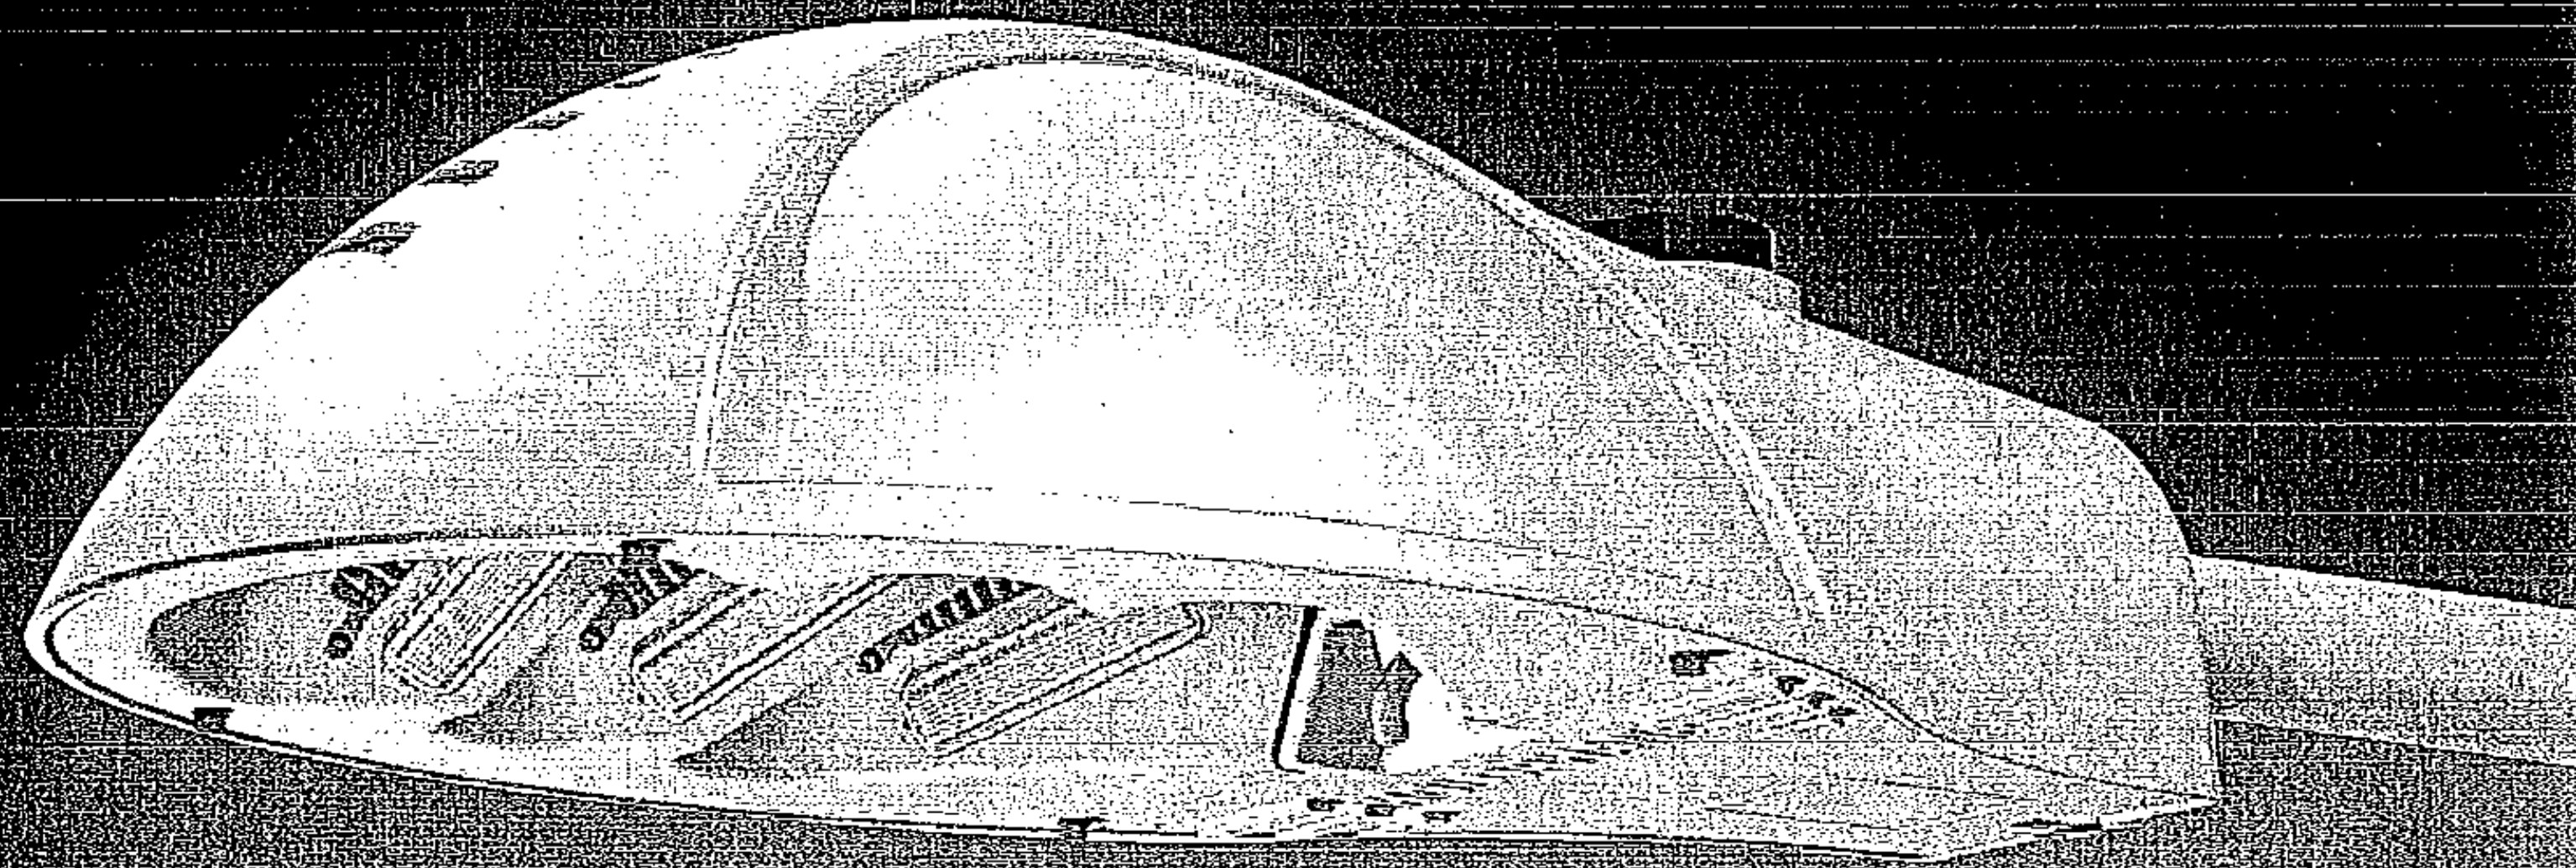

## Our History of Roadway Lighting is Legendary

- Permanent prismatic glass optics protect LED's, control light, and reduce glare
- Optimized maintained thermal management system for maximum performance and life
- Precise optical control for high application efficacy
- Multiple lumen packages offer design flexibility
- Environmentally friendly design with zero uplight prevents light pollution
- Optional dual driver system extends driver life up to 100,000 hours
- Dimming options reduce energy load

  
**HOLOPHANE®**  
LEADER IN LIGHTING SOLUTIONS



HL-2454 7/10



ROADWAY LEDGEND

# ORDERING INFORMATION

## DIMENSIONAL DETAILS

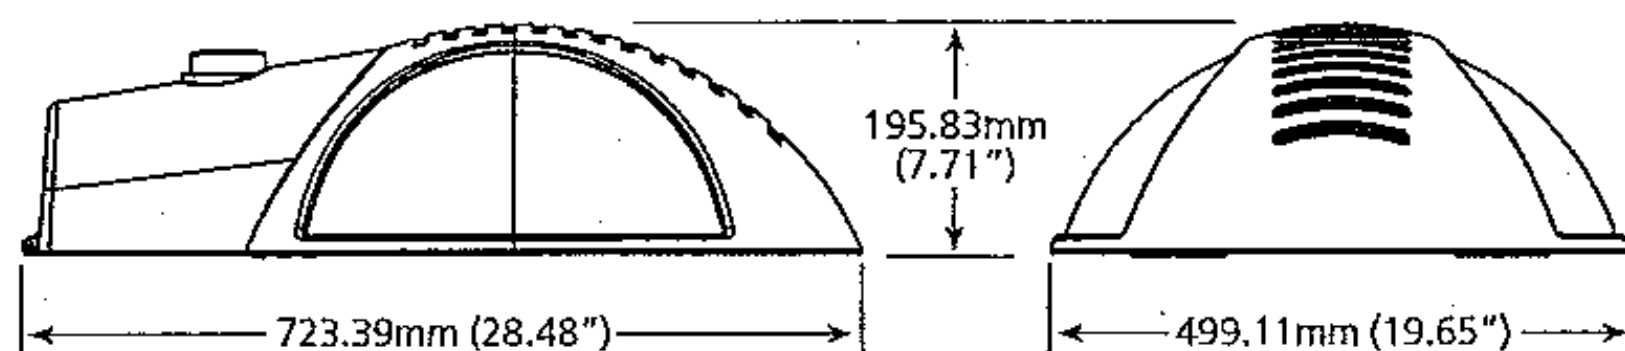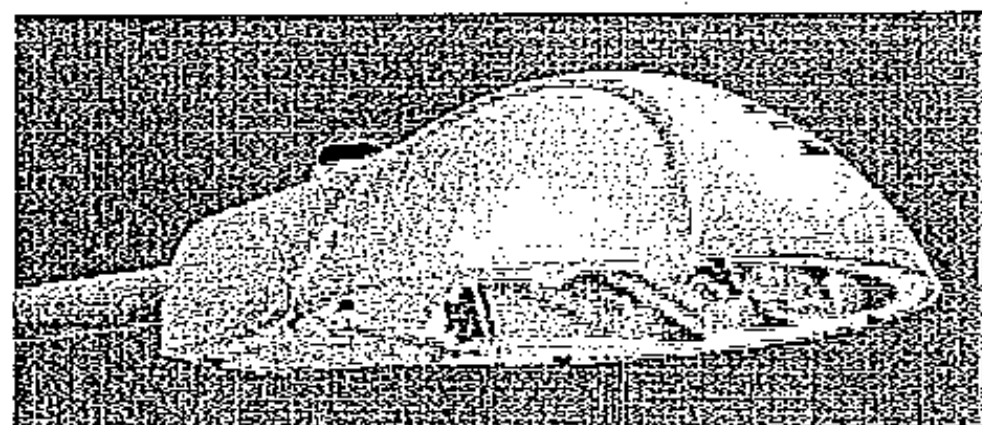

Maximum Weight: 12.7 kg (28 lbs)  
 Maximum E.P.A.: 0.62 sq. ft.

## PERFORMANCE SPECIFICATIONS

### General Construction

Rugged die cast aluminum housing, low copper aluminum, allow for corrosion resistance and long life. Horizontal arm mount with +/-6 degrees vertical adjustment. Four bolt mast arm provides easy, secure installation and adjustability for arms 1 1/4 to 2" (1 1/4- 2 3/8 inch O.D.) Trigger latch disengages for easy access to four-bolt-mounting, terminal block, surge protection module, LED drivers, and electronic transfer switch. An optimized maintained thermal management system is achieved by combining a robust heat sink utilizing both convection and conduction methodology with a mechanical design that provides maximum airflow ensuring a minimum of 50,000 hours L70 at 25°C operating ambient. Internal perforated stainless steel cover protects the luminaire against dirt and foliage build up while maintaining the integrity of the airflow requirement. Solar guard technology isolates top cover of luminaire from thermal heat sink through four touch points providing protection from solar loading while not in operation.

### Environmental

Luminaire design and tested to comply with ANSI C136:31 2001 for 100,000 cycles at 3G acceleration for normal road and bridge applications. The range of luminaire operation is -40°C to +50°C. Six sealed LED light engines meet dust and moisture rating of IP-66 per IEC 60068-2-3 1987 ensures long component life and protection from the environment. The luminaire is finished with polyester paint applied after a pretreatment process to ensure maximum durability. The finish shall pass the 1000 hour salt fog test per ASTM B117 and D1654 standard. The luminaire passed Humidity testing per IEC 60068-2-3 1987 and passed Temperature-Voltage Cycling and Condensing Humidity testing per Acuity Brands Validation Test Specification 902-00007-001

### Regulatory

The luminaire is designed to meet CSA-C22.2 number 250, wet location. See chart below for model rating based on drive current and led combination.

Series	Drive Current	Number of LEDs	CSA ambient listing
LEDG	350mA	36,60,72,84,96,108,120	40°C
LEDG	525mA	36,48,60,72,84,96,108,120	40°C
LEDG	700mA	72,60,48,36	40°C
LEDG	700mA	84	35°C
LEDG	700mA	96	30°C
LEDG	700mA	108	25°C

The luminaire is ROHS compliant. Luminaire meets EMI compliance per FCC Title 47 CFR Part 15, Class A.

### Electrical

The surge protection is tested to ANSI/IEEE62.41-2002 specification. For the AS voltage option (120-277), the device meets category C high (20kV, 10kA). For AH voltage rating (347-480), the protection level is category C low. (6kV, 3kA) The surge protection module (SPD) protects all downstream electronics such as led drivers, transfer switch, and relays for the purpose of protecting from electrical disturbances such as nearby lightning strikes. Extended life driver option (EL 350 mA only) provides both main and auxiliary driver system extending system driver to 200,000 hours minimum. The control in EL option constantly monitors an output current of the main driver. In the event of a main driver failure (no output current), the control switches power to the auxiliary driver. The auxiliary driver is not energized during normal operation. The photocontrol receptacle is adjustable without tools and is ROAM compatible. The luminaire is designed to conform to ANSI C82.77:2002 for maximum total harmonic distortion (THD) -20%. Inrush current complies with NEMA410:2004 table B-2 and line fluctuations and ramp input voltage per UL 991:2004. The luminaire conforms to electromagnetic compatibility tests for electrostatic discharge (ESD) per IEC 61000-4-2:2001, Level 4.

### Optical

Environmentally friendly, zero uplight luminaire reduces light pollution. Glass optics provides minimal dirt depreciation and will not discolor or become brittle over time. The permanence of glass results in less dirt depreciation and more maintained lumens on the intended space. The luminaire is available with narrow, medium, and wide asymmetric distributions designed to maximize pole spacing and reduce energy usage resulting in a lower total cost of ownership. The highly engineered light engine is designed to restrict direct view of individual LED's increasing visual comfort within the field of view. The luminaire is available with LED color temperatures of 4000K and 5000K. Reference [www.Holophane.com](http://www.Holophane.com) for individual photometric tests on LEDgend LED luminaire that are tested per LM79 guidelines. Consult factory for LM80 data as that varies per LED chip manufacturer.

### Warranty

Five year limited warranty on LED light engine. Five year limited warranty on LED drivers. Five year limited warranty on non electrical components.

PREFERRED SELECTIONS

Most Frequently Ordered Catalog Numbers

<b>LEDG</b>	<b>120</b>	<b>35</b>	<b>5K</b>	<b>AS</b>	<b>H</b>	<b>L3</b>	<b>R</b>
1	2	3	4	5	6	7	8
LUMINAIRE	LED'S	CURRENT	TEMPERATURE	VOLTAGE	COLOR	OPTICS	OPTIONS
LEDG	120	35	5K	AS	H	L3	R

CATALOG NUMBERS FOR ENTIRE PRODUCT OFFERING

(Pricing and lead times may be affected)



STEP 1: LUMINAIRE

LEDG LEDgend  
LED luminaire

STEP 2: QUANTITY OF LED'S

120	120
108	108
096	96
084	84
072	72
060	60
048	48
036	36

STEP 3: DRIVE CURRENT

35 350mA driver  
53 525mA driver  
70¹ 700mA driver  
¹ Not available with 120 code

STEP 4: COLOR TEMPERATURE

4K 4,000K CCT +/- 250K  
5K 5,000K CCT +/- 250K

STEP 5: VOLTAGE

AS Auto-sensing (120-277V)  
AH¹ Auto-sensing (347-480V)  
¹ Not available with 36 LED's with 35 or 53 drive currents

STEP 6: HOUSING COLOR

A As specified  
G Gray  
H Graphite  
K Black  
N Green  
W White  
Z Bronze



*Colors are just a representation. Custom colors are available upon request

STEP 7: OPTICS

L1 Type I, narrow asymmetric  
L2 Type II, medium asymmetric  
L3 Type III, wide asymmetric  
L4 Type IV, forward throw

STEP 8: OPTIONS

B 0-10 Volt dimming, bi-level dimming, constant lumen output  
D ROAM 0-10 volt dimming control  
EL Extended life driver system  
PSC Shorting cap  
SP Single pack for UPS

Photocontrols

PCS 120-277 Volt DTL  
P34 347 volt DTL twist-off  
P48 480 volt DTL twist-off  
R NEMA twist-off photocontrol receptacle

STEP 9: ACCESSORIES


F1 Single fusing  
F2 Double fusing  
BR-1055-XX P2 tenon adapter  
SPDPLUGIN Replacement surge protector auto-sensing voltage (120-277V)  
SPDPLUGIN-48 Replacement surge protector auto-sensing voltage (347-480V)

OPERATING CHARACTERISTICS




Number of LED's	CCT	Drive Current	Minimum Delivered Lumens ²	Wattage	IPVC	170°C/25°C	170°C/40°C
120	4000K	350mA	9652	129	75	106,000	83,000
108	4000K	350mA	8778	116	76	110,000	85,000
96	4000K	350mA	7903	103	77	117,000	88,000
84	4000K	350mA	7029	91	77	125,000	92,000
72	4000K	350mA	6049	81	75	135,000	98,000
60	4000K	350mA	5037	65	77	146,000	106,000
48	4000K	350mA	4049	52	78	159,000	115,000
36	4000K	350mA	3060	42	73	171,000	124,000
120	4000K	525mA	12660	198	64	65,000	51,000
108	4000K	525mA	11492	178	65	68,000	53,000
96	4000K	525mA	10324	159	65	72,000	56,000
84	4000K	525mA	9156	148	62	78,000	61,000
72	4000K	525mA	7988	120	67	85,000	65,000
60	4000K	525mA	6736	99	68	94,000	72,000
48	4000K	525mA	5490	79	69	104,000	79,000
36	4000K	525mA	4241	62	68	115,000	87,000
108	4000K	700mA	14320	240	60	50,000	NA
96	4000K	700mA	13055	213	61	51,000	NA
84	4000K	700mA	11829	187	63	53,000	NA
72	4000K	700mA	9780	162	60	60,000	47,000
60	4000K	700mA	8625	133	65	65,000	52,000
48	4000K	700mA	6937	107	65	73,000	58,000
36	4000K	700mA	5248	80	66	77,000	66,000

¹ Minimum lumen values, reference photometric test for delivered lumens for each distribution  
² For 5000K use 1.045 multiplier X 4000 K lumen value

CAT# LEDG 060 70 4K AS K L3

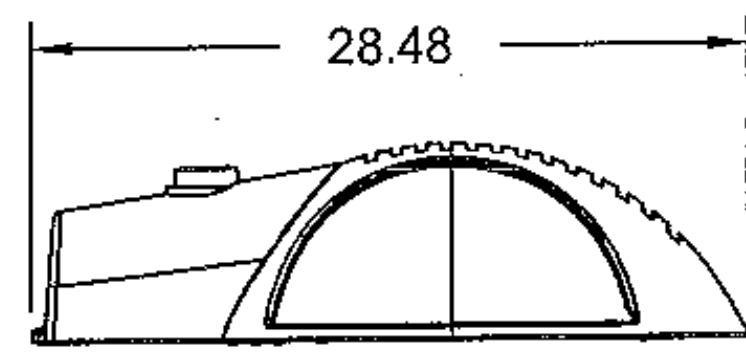

Weight = 28lbs  
EPA = .62

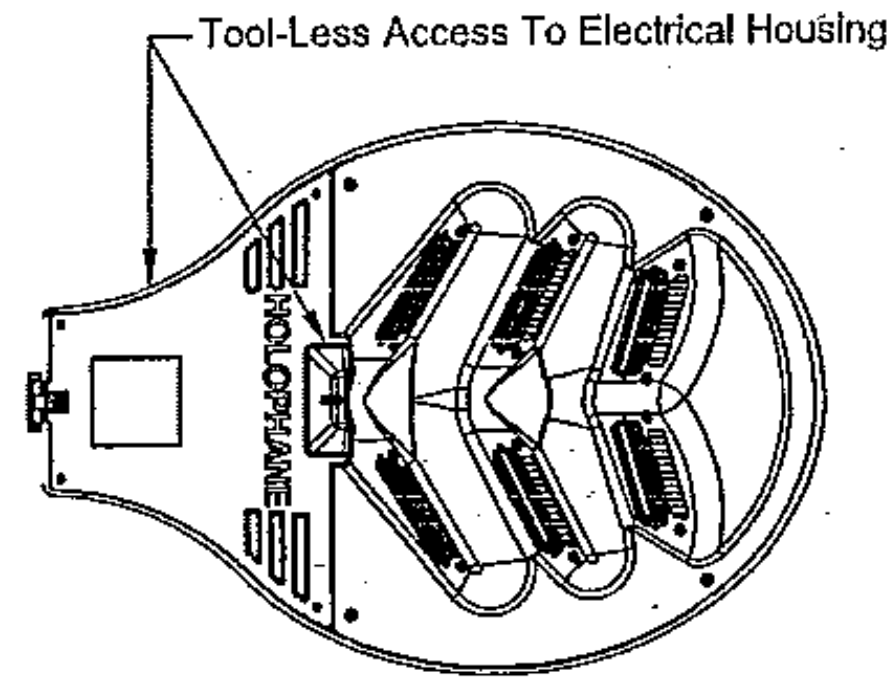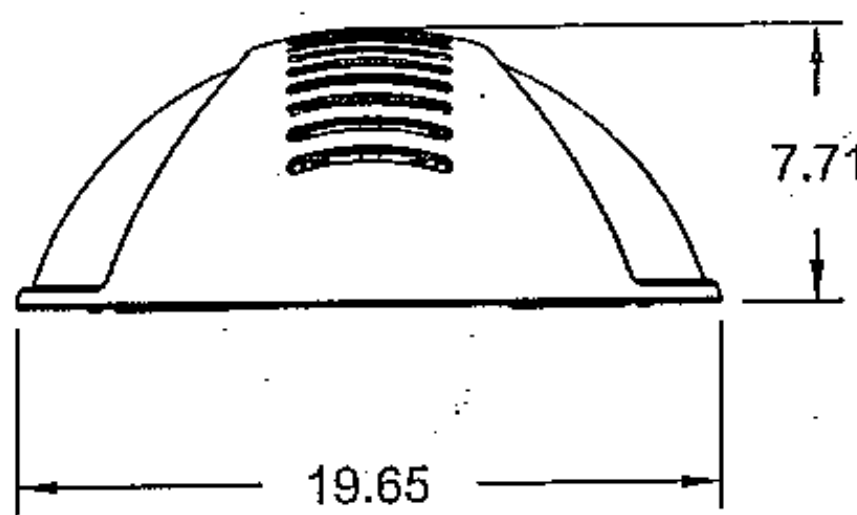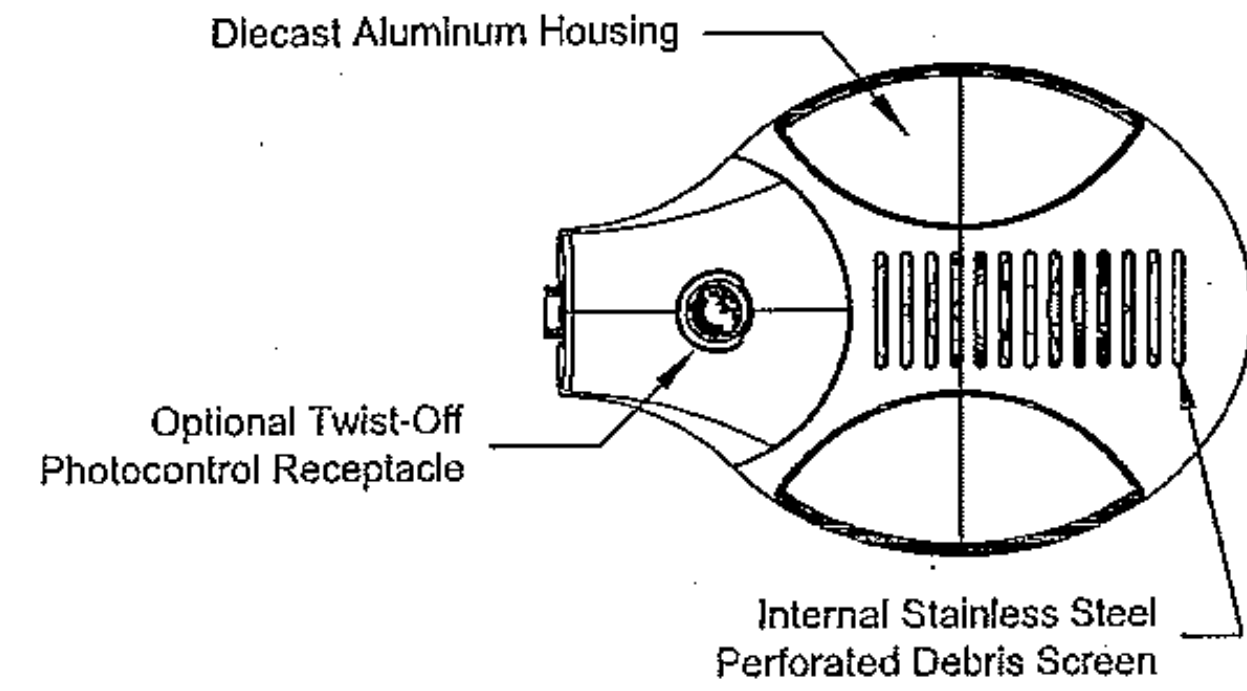

LEDGEND™  
LED Roadway Lighting

Functional  
Outdoor

Customer Preferred: (Most Frequently Ordered Catalog Numbers)

LEDG 120 35 4K AS G L1 R F1  
K L2  
W

LEDG	060	70	4k
Series	Number of LED'S	Drive Current	Color Temperature
LEDgend LED Roadway	120 = 120 LED'S 108 = 108 LED'S 096 = 96 LED'S 084 = 84 LED'S 072 = 72 LED'S 060 = 60 LED'S 048 = 48 LED'S *036 = 36 LED'S	35 = 350mA Driver 53 = 525mA Driver *70 = 700mA Driver	4K = 4,000 K CCT +/- 250K 5K = 5,000 K CCT +/- 250K

AS	K	L3
Voltage	Housing Color	Optics
AS = Auto-Sensing Voltage (120 thru 277) *AH = Auto-Sensing Voltage (347 thru 480)	A = As Specified G = Gray H = Graphite K = Black N = Green W = White Z = Bronze	L1 = Type I, Narrow Asymmetric L2 = Type II, Medium Asymmetric L3 = Type III, Wide Asymmetric L4 = Type IV, Forward Throw

R	
Options	Accessories

**OPTIONS**  
B = Constant Lumen Output, Bi-Level Dimming  
C = Constant Lumen Output  
DE = ROAM CONCIERGE Dimming Control  
VE = ROAMVIEW Dimming Control  
EL = Extended Life - Driver  
PCS = DTL Solid-State Lighting Photocontrol 120-277V  
P34 = DTL Twist-Off Photocontrol 347V  
P48 = DTL Twist-Off Photocontrol 480V  
PSC = Shorting Cap  
R = NEMA Twist-Off Photocontrol Receptacle  
SP = Single Pack For UPS

**ACCESSORIES**  
F1 = Single Fusing (120, 240, 277, 347V)  
F2 = Double Fusing (208, 240, 480V)  
BR-1055-XX = P2 Tenon Adapter  
LEDGHSS = House Side Shield

**NOTES:**  
*Not available with 36 LED's with 35 or 53 drive currents or with options B, C, DE, VE, EL or PCS  
*Not available with B, C, DE or VE options with 53 drive current  
*Not available with 120 LED's



© 2010 Acuity Brands Lighting, Inc., All Rights Reserved

THIS DRAWING, WHEN APPROVED, SHALL BECOME THE COMPLETE SPECIFICATION FOR THE MATERIAL TO BE FURNISHED BY HOLOPHANE ON THE ORDER NOTED ABOVE. A UNIT OF SIMILAR DESIGN MAY BE SUPPLIED, BUT ONLY AFTER APPROVAL BY THE CUSTOMER. ALL MATERIALS AND WORKMANSHIP SHALL BE SUBJECT TO INSPECTION AND WILL BE SUPPLIED WITH EACH ANCHOR BOLT. ORDER TO MATCH THE POLE PROVIDED. THIS PRINT IS THE PROPERTY OF HOLOPHANE AND IS LOANED SUBJECT TO RETURN UPON DEMAND AND UPON EXPRESS WRITTEN NOTICE. IT IS NOT TO BE REPRODUCED OR TRANSMITTED IN ANY MANNER WITHOUT THE WRITTEN PERMISSION OF HOLOPHANE. CONNECTION WITH MATERIAL FURNISHED BY HOLOPHANE.

ORDER #:	
TYPE:	
DRAWN:	JRM
DATE:	10/31/12
DWG #:	LUM_LEDG

ORDERING INFORMATION:

# Specifications

## General Construction

Rugged die cast aluminum housing, low copper aluminum, allow for corrosion resistance and long life. Horizontal arm mount with +/-6 degrees vertical adjustment. Four bolt mast arm provides easy, secure installation and adjustability for arms 1-1/4 & 2 inch pipe (1.66" & 2.38" O.D.) Trigger latch disengages for easy access to four bolt mounting, terminal block, surge protection module, LED drivers, and electronic transfer switch. An optimized maintained thermal management system is achieved by combining a robust heat sink utilizing both convection and conduction methodology with a mechanical design that provides maximum airflow ensuring a minimum of 50,000 hours L70 at 25C operating ambient. Internal perforated stainless steel cover protects the luminaire against dirt and foliage build up while maintaining the integrity of the airflow requirement. Solar guard technology isolates top cover of luminaire from thermal heat sink through four touch points providing protection from solar loading while not in operation.

## Environmental

Luminaire design and tested to comply with ANSI C136:31 2001 for 100,000 cycles at 3G acceleration for normal road and bridge applications. The range of luminaire operation is -40C to +50C.

Six sealed LED light engines meet dust and moisture rating of IP-66 per IEC 60068-2-3 1987 ensures long component life and protection from the environment.

The luminaire is finished with polyester paint applied after a pretreatment process to ensure maximum durability. The finish shall pass the 1000 hour salt fog test per ASTM B117 and D1654 standard.

The luminaire passed Humidity testing per IEC 60068-2-3 1987 and passed Temperature-Voltage Cycling and Condensing Humidity testing per Acuity Brands Validation Test Specification 902-00007-001

## Regulatory

The luminaire is safety listed to CSA-C22.2 number 250, wet location. See chart below for model rating based on drive current and led combination.

Series	Drive Current	Number of LED'S	CSA Ambient Listing
LEDG	350 mA	36,60,72,84,96,108,120	40C
LEDG	525 mA	36,48,60,72,84,96,108,120	40C
LEDG	700 mA	72,60,48,36	40C
LEDG	700 mA	84	35C
LEDG	700 mA	96	30C
LEDG	700 mA	108	25C

The luminaire is ROHS compliant. Luminaire meets EMI compliance per FCC Title 47 CFR Part 15, Class A.

## Electrical

The surge protection is tested to ANSI/IEEE62.41-2002 specification. For the AS voltage option (120-277), the device meets category C high (20kV, 10kA). For AH voltage rating (347-480), the protection level is category C low. (6kV, 3kA) The surge protection module (SPD) protects all downstream electronics such as led drivers, transfer switch, and relays for the purpose of protecting from electrical disturbances such as nearby lightning strikes.

Extended life driver option (EL 350 mA only) provides both main and auxiliary driver system extending system driver to 200,000 hours minimum. The control in EL option constantly monitors an output current of the Main Driver. In the event of a Main driver failure (no output current), the control switches power to the Auxiliary driver. The Auxiliary driver is not energized during normal operation.

The photocontrol receptacle is adjustable without tools and is ROAM compatible.

The luminaire is designed to conform to ANSI C82.77:2002 for Maximum Total Harmonic Distortion (THD) -20%. Inrush current complies with NEMA410:2004 table B-2 and line Fluctuations and Ramp input voltage per UL 991:2004.

The luminaire conforms to Electromagnetic compatibility tests for Electrostatic Discharge (ESD) per IEC 61000-4-2:2001, Level 4.

## Optical

Environmentally friendly, zero uplight luminaire reduces light pollution. Glass optics provides minimal dirt depreciation and will not discolor or become brittle over time. The permanence of glass results in less dirt depreciation and more maintained lumens on the intended space. The luminaire is available with narrow, medium, and wide asymmetric distributions designed to maximize pole spacing and reduce energy usage resulting in a lower total cost of ownership. The highly engineered light engine is designed to restrict direct view of individual LED's increasing visual comfort within the field of view. The luminaire is available with LED color temperatures of 4000K and 5000K. The minimum color rendering index (CRI) is 70.

Reference [www.Holophane.com](http://www.Holophane.com) for individual photometric tests on LEDgend LED luminaire that are tested per LM79 guidelines. Consult factory for LM80 data as that varies per LED chip manufacturer.

**LEDGEND™**  
LED Roadway Lighting

Functional  
Outdoor

**HOLOPHANE®**  
LEADER IN LIGHTING SOLUTIONS  
An Acuity Brands Company  
© 2010 Acuity Brands Lighting, Inc. All Rights Reserved

THIS DRAWING, WHEN APPROVED, SHALL BECOME THE COMPLETE SPECIFICATION FOR THE MATERIAL TO BE FURNISHED BY HOLOPHANE ON THE ORDER NOTED ABOVE. A UNIT OF SIMILAR DESIGN MAY BE SUBSTITUTED AT THE OPTION OF THE BUYER. ALL DIMENSIONS AND WRITINGS ON POLE ORDERS AND ANCHOR BOLT TEMPLATE PRINT WILL BE SUPPLIED WITH EACH ANCHOR BOLT ORDER TO MATCH THE POLE PROVIDED. THIS PRINT IS THE PROPERTY OF HOLOPHANE AND IS LOANED TO THE BUYER FOR THE PURPOSE OF THE ORDER. IT IS THE CONDITION THAT IT WILL NOT BE USED DIRECTLY OR INDIRECTLY IN ANY WAY DETRIMENTAL TO OUR INTERESTS, AND ONLY IN CONNECTION WITH MATERIAL FURNISHED BY HOLOPHANE.

ORDER #:

TYPE:

DRAWN: LJS

DATE: 10/6/11

DWG #: LUM_LEDG

**Operating Characteristics**

Number of LED's	CCT	Drive Current	Min Delivered lumens *	Input operating Amps						Input Watts	LPW	L70 @ 25C	L70 @ 40C	Driver life @25C hrs
				120V	208V	240V	277V	347V	480V					
120	4000K	350Ma	9652	1.07	0.63	0.55	0.48	0.37	0.27	129	75	106,000	83,000	100,000
108	4000K	350Ma	8778	0.96	0.57	0.50	0.43	0.33	0.24	116	76	110,000	85,000	100,000
96	4000K	350Ma	7903	0.86	0.50	0.44	0.38	0.30	0.22	103	77	117,000	88,000	100,000
84	4000K	350Ma	7029	0.75	0.44	0.39	0.34	0.26	0.19	91	77	125,000	92,000	100,000
72	4000K	350Ma	6049	0.68	0.40	0.36	0.32	0.23	0.18	81	75	135,000	98,000	100,000
60	4000K	350Ma	5037	0.54	0.32	0.28	0.24	0.19	0.14	65	77	146,000	106,000	100,000
48	4000K	350Ma	4049	0.43	0.25	0.22	0.19	0.15	0.11	52	78	159,000	115,000	100,000
36	4000K	350Ma	3060	0.35	0.22	0.19	0.16	NA	NA	42	73	171,000	124,000	100,000
120	4000K	525Ma	12660	1.65	0.95	0.86	0.75	0.60	0.43	198	64	65,000	51,000	100,000
108	4000K	525Ma	11492	1.49	0.86	0.77	0.68	0.54	0.39	178	65	68,000	53,000	100,000
96	4000K	525Ma	10324	1.32	0.76	0.69	0.60	0.48	0.34	159	65	72,000	56,000	100,000
84	4000K	525Ma	9156	1.22	0.73	0.65	0.59	0.44	0.33	148	62	78,000	61,000	100,000
72	4000K	525Ma	7988	0.98	0.57	0.50	0.44	0.35	0.26	120	67	85,000	65,000	100,000
60	4000K	525Ma	6736	0.83	0.48	0.43	0.38	0.30	0.22	99	68	94,000	72,000	100,000
48	4000K	525Ma	5490	0.66	0.38	0.34	0.30	0.24	0.17	79	69	104,000	79,000	100,000
36	4000K	525Ma	4241	0.52	0.31	0.27	0.25	NA	NA	62	68	115,000	87,000	100,000
108	4000K	700Ma	14320	2.01	1.15	1.02	0.90	0.70	0.51	240	60	50,000	NA	50,000
96	4000K	700Ma	13055	1.79	1.02	0.91	0.80	0.62	0.45	213	61	51,000	NA	65,000
84	4000K	700Ma	11829	1.56	0.89	0.79	0.70	0.54	0.40	187	63	53,000	NA	80,000
72	4000K	700Ma	9780	1.34	0.77	0.68	0.60	0.47	0.34	162	60	60,000	47,000	95,000
60	4000K	700Ma	8625	1.12	0.64	0.57	0.50	0.39	0.28	133	65	65,000	52,000	100,000
48	4000K	700Ma	6937	0.91	0.52	0.46	0.41	0.31	0.23	107	65	73,000	58,000	100,000
36	4000K	700Ma	5248	0.67	0.38	0.34	0.30	0.23	0.17	80	66	77,000	66,000	100,000

- * Minimum lumen values, reference photometric test for delivered lumens for each distribution
- For 5000K use 1.045 multiplier X 4000 K lumen value

Warranty  
 Limited warranty located at  
[www.acuitybrands.com/CustomerResources/Terms_and_conditions.aspx](http://www.acuitybrands.com/CustomerResources/Terms_and_conditions.aspx)

Actual performance may differ as a result of end-user environment and application.  
 Actual wattage may differ by +/-8% when operating between 120-480V +/-10%.

NOTE: Specifications subject to change without notice.

**LEDGEND™**

**LED Roadway Lighting**

**Functional Outdoor**

**HOLOPHANE®**  
 LEADER IN LIGHTING SOLUTIONS  
 An Acuity Brands Company

© 2010 Acuity Brands Lighting, Inc. All Rights Reserved


THIS DRAWING, WHEN APPROVED, SHALL BECOME THE COMPLETE SPECIFICATION FOR THE MATERIAL TO BE FURNISHED BY HOLOPHANE ON THE ORDER NOTED ABOVE. A UNIT OF SIMILAR DESIGN MAY BE SUPPLIED, BUT ONLY AFTER APPROVAL BY THE CUSTOMER IS OBTAINED. THE CUSTOMER SHALL BE RESPONSIBLE FOR OBTAINING ALL NECESSARY PERMITS AND APPROVALS. HOLOPHANE SHALL BE SUPPLIED WITH EACH ANCHOR BOLT ORDER TO MATCH THE ROLE PROVIDED. THIS PRINT IS THE PROPERTY OF HOLOPHANE AND IS LOANED SUBJECT TO RETURN UPON DEMAND AND UPON EXPRESS WRITTEN NOTICE. THIS DRAWING IS NOT TO BE REPRODUCED OR TRANSMITTED IN ANY MANNER WITHOUT THE WRITTEN PERMISSION AND ONLY IN CONNECTION WITH MATERIAL FURNISHED BY HOLOPHANE.

ORDER #: _____  
 TYPE: _____  
 DRAWN: JRM  
 DATE: 1/21/13  
 DWG #: LUM_LEDG

**OUTDOOR PHOTOMETRIC REPORT**  
 CATALOG: LEDG 060 70 4K AS 2H L3



TEST #: 500974  
 TEST LAB: ACUITY BRANDS LIGHTING GRANVILLE LAB  
 ISSUE DATE: 4/20/2011  
 CATALOG #: LEDG 060 70 4K AS 2H L3  
 LUMINAIRE: LEDGEND  
 LAMP CAT #: CREE XP-G  
 LAMP: 10 X 12 4K LED ARRAY CREE XP-G  
 LAMP OUTPUT: TOTAL LUMINAIRE LUMENS: 8627.2  
 TEST BASED ON ABSOLUTE PHOTOMETRY *  
 BALLASTCAT: BL-1142  
 BALLAST: 2 X 120V 150W ELECTRONIC LED INTA 0700C 210 FO  
 INPUT WATTAGE: 140  
 LUMINOUS OPENING: CIRCULAR (DIA: 3")  
 Max Cd: 5,428.0 AT HORIZONTAL: 65°, VERTICAL: 67.5°  
 Roadway Class: SHORT, TYPE III

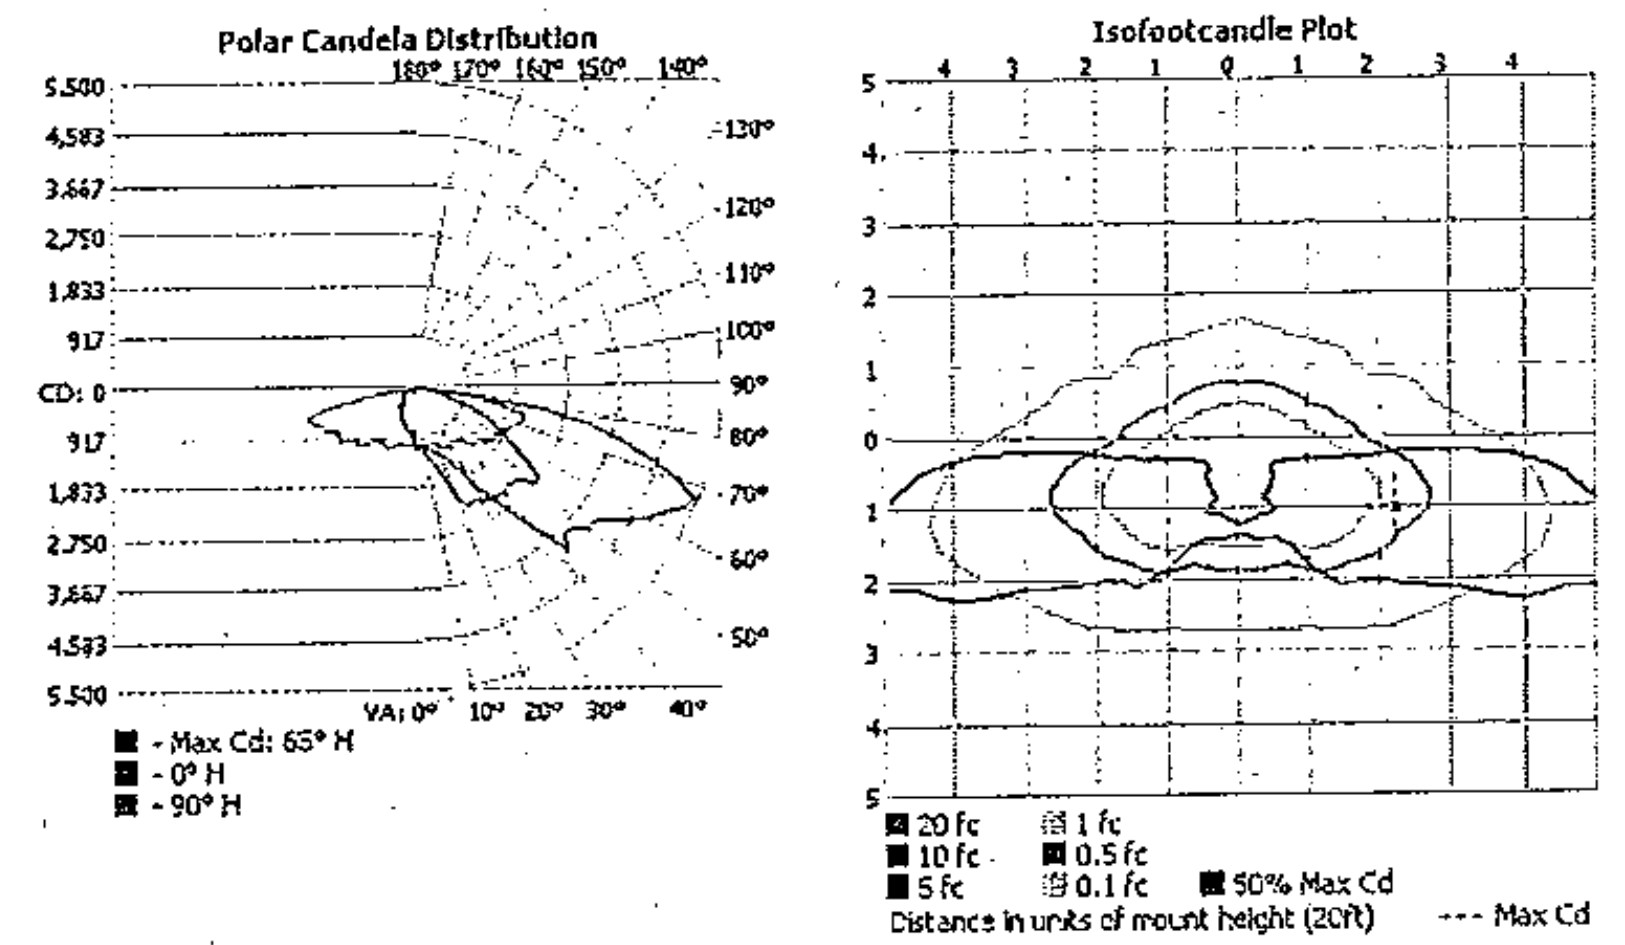

*TEST BASED ON ABSOLUTE PHOTOMETRY WHERE LAMP LUMENS=LUMENS TOTAL.  
 *CUTOFF CLASSIFICATION AND EFFICIENCY CANNOT BE PROPERLY CALCULATED FOR ABSOLUTE PHOTOMETRY.  
 VISUAL PHOTOMETRIC TOOL 1.2.46 COPYRIGHT 2014, ACUITY BRANDS LIGHTING  
 REPORTED DATA CALCULATED FROM MANUFACTURER'S DATA FILE, BASED ON IESNA RECOMMENDED METHODS.

**ZONAL LUMEN SUMMARY**

Zone	Lumens	% Luminaire
0-30	1,030.1	11.9%
0-40	2,023.0	23.4%
0-60	5,303.4	61.5%
60-90	3,323.8	38.5%
70-100	1,466.5	17%
90-120	0	0%
0-90	8,627.2	100%
90-180	0	0%
0-180	8,627.2	100%

**LUMENS PER ZONE**

Zone	Lumens	% Total	Zone	Lumens	% Total
0-10	100.0	1.2%	90-100	0	0%
10-20	314.9	3.7%	100-110	0	0%
20-30	615.3	7.1%	110-120	0	0%
30-40	992.9	11.5%	120-130	0	0%
40-50	1,443.2	16.7%	130-140	0	0%
50-60	1,837.3	21.3%	140-150	0	0%
60-70	1,857.3	21.5%	150-160	0	0%
70-80	1,269.9	14.7%	160-170	0	0%
80-90	196.5	2.3%	170-180	0	0%


**ROADWAY SUMMARY**

Distribution:	TYPE III, SHORT
Max Cd, 90 Deg Vert:	0
Max Cd, 80 to <90 Deg:	2,828.0
Downward Street Side:	7,102.0 82.3%
Downward House Side:	1,524.5 17.7%
Downward Total:	8,626.5 100%
Upward Street Side:	0 0%
Upward House Side:	0 0%
Upward Total:	0 0%
Total Lumens:	8,626.5 100%

**LCS TABLE**

BUG RATING	B1 - U0 - G2
<b>FORWARD LIGHT</b>	
Low(0-30):	689.8 8%
Medium(30-60):	3,567.1 41.3%
High(60-80):	2,685.8 31.1%
Very High(80-90):	159.3 1.8%
<b>BACK LIGHT</b>	
Low(0-30):	340.1 3.9%
Medium(30-60):	705.9 8.2%
High(60-80):	442.4 5.1%
Very High(80-90):	36.2 0.4%
<b>UPLIGHT</b>	
Low(90-100):	0 0%
High(100-180):	0 0%
TRAPPED LIGHT:	0.8 0%

OUTDOOR PHOTOMETRIC REPORT  
CATALOG: LEDG 060 70 4K AS 2H L3

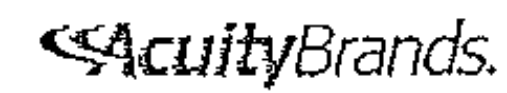

CANDELA TABLE - TYPE C


	0	10	20	30	40	50	60	70	80	90	100	110	120	130	140	150	160	170	180	
0	1083	1083	1083	1083	1083	1083	1083	1083	1083	1083	1083	1083	1083	1083	1083	1083	1083	1083	1083	1083
5	1128	1129	1129	1124	1118	1113	1105	1096	1089	1084	1079	1078	1076	1076	1075	1068	1061	1055		
10	1299	1297	1297	1289	1275	1258	1243	1226	1213	1201	1187	1170	1149	1132	1121	1109	1089	1068	1052	
15	1551	1547	1530	1499	1478	1460	1431	1406	1388	1374	1357	1273	1236	1212	1196	1169	1122	1086	1056	
20	2134	2098	2072	2023	2012	1970	1910	1786	1676	1562	1495	1426	1367	1306	1240	1193	1161	1139	1092	
25	2322	2284	2269	2311	2367	2431	2343	2240	2134	2019	1896	1726	1608	1527	1444	1350	1258	1231	1215	
30	2356	2327	2311	2370	2407	2356	2306	2294	2321	2494	2588	2549	2250	2075	1766	1531	1407	1272	1195	
35	2425	2425	2474	2537	2534	2460	2402	2417	2561	2922	3207	3466	3115	2563	2241	1984	1602	1341	1193	
40	2463	2508	2633	2717	2702	2711	2737	3005	3490	3723	3808	4022	4000	3430	2675	2056	1796	1552	1226	
45	2442	2566	2646	2651	2632	2707	3020	3665	4148	4263	4369	3909	4157	3737	3404	2839	2396	1637	1466	
50	2697	2780	2918	2878	2776	2807	3196	3814	4095	4704	4890	4799	4006	4009	3645	2956	2283	1829	1479	
55	2526	2607	2750	2776	2851	3116	4198	4577	4806	4294	4668	4919	4894	4234	3910	3390	2513	1918	1677	
60	1837	1920	1989	1985	2088	2449	3441	4620	4897	5181	4649	4768	5075	4806	4309	3970	3153	2091	1602	
65	1535	1574	1654	1624	1698	2032	2741	3045	3661	4363	4671	4692	4924	5295	4916	4313	3661	2675	1817	
70	881	898	957	1027	1120	1456	1889	2450	2541	2788	3400	4122	4266	5007	5386	4998	4059	3057	1949	
75	474	494	515	567	616	642	745	918	1407	1861	2168	2621	3378	3826	4797	4692	4104	3115	2014	
80	230	238	250	293	333	391	432	455	473	584	926	1427	1952	2220	2828	3434	3477	1296	897	
85	62	64	68	86	104	124	139	150	160	161	138	139	162	150	135	148	144	127	120	
90	0	0	0	0	0	0	0	0	0	0	0	0	0	0	0	0	0	0	0	
95	0	0	0	0	0	0	0	0	0	0	0	0	0	0	0	0	0	0	0	
160	0	0	0	0	0	0	0	0	0	0	0	0	0	0	0	0	0	0	0	0
165	0	0	0	0	0	0	0	0	0	0	0	0	0	0	0	0	0	0	0	0
170	0	0	0	0	0	0	0	0	0	0	0	0	0	0	0	0	0	0	0	0
175	0	0	0	0	0	0	0	0	0	0	0	0	0	0	0	0	0	0	0	0
180	0	0	0	0	0	0	0	0	0	0	0	0	0	0	0	0	0	0	0	0

50074 500974  
VISUAL 3D PHOTOMETRIC TOOL

PAGE 4 OF 4


**HOLOPHANE®**

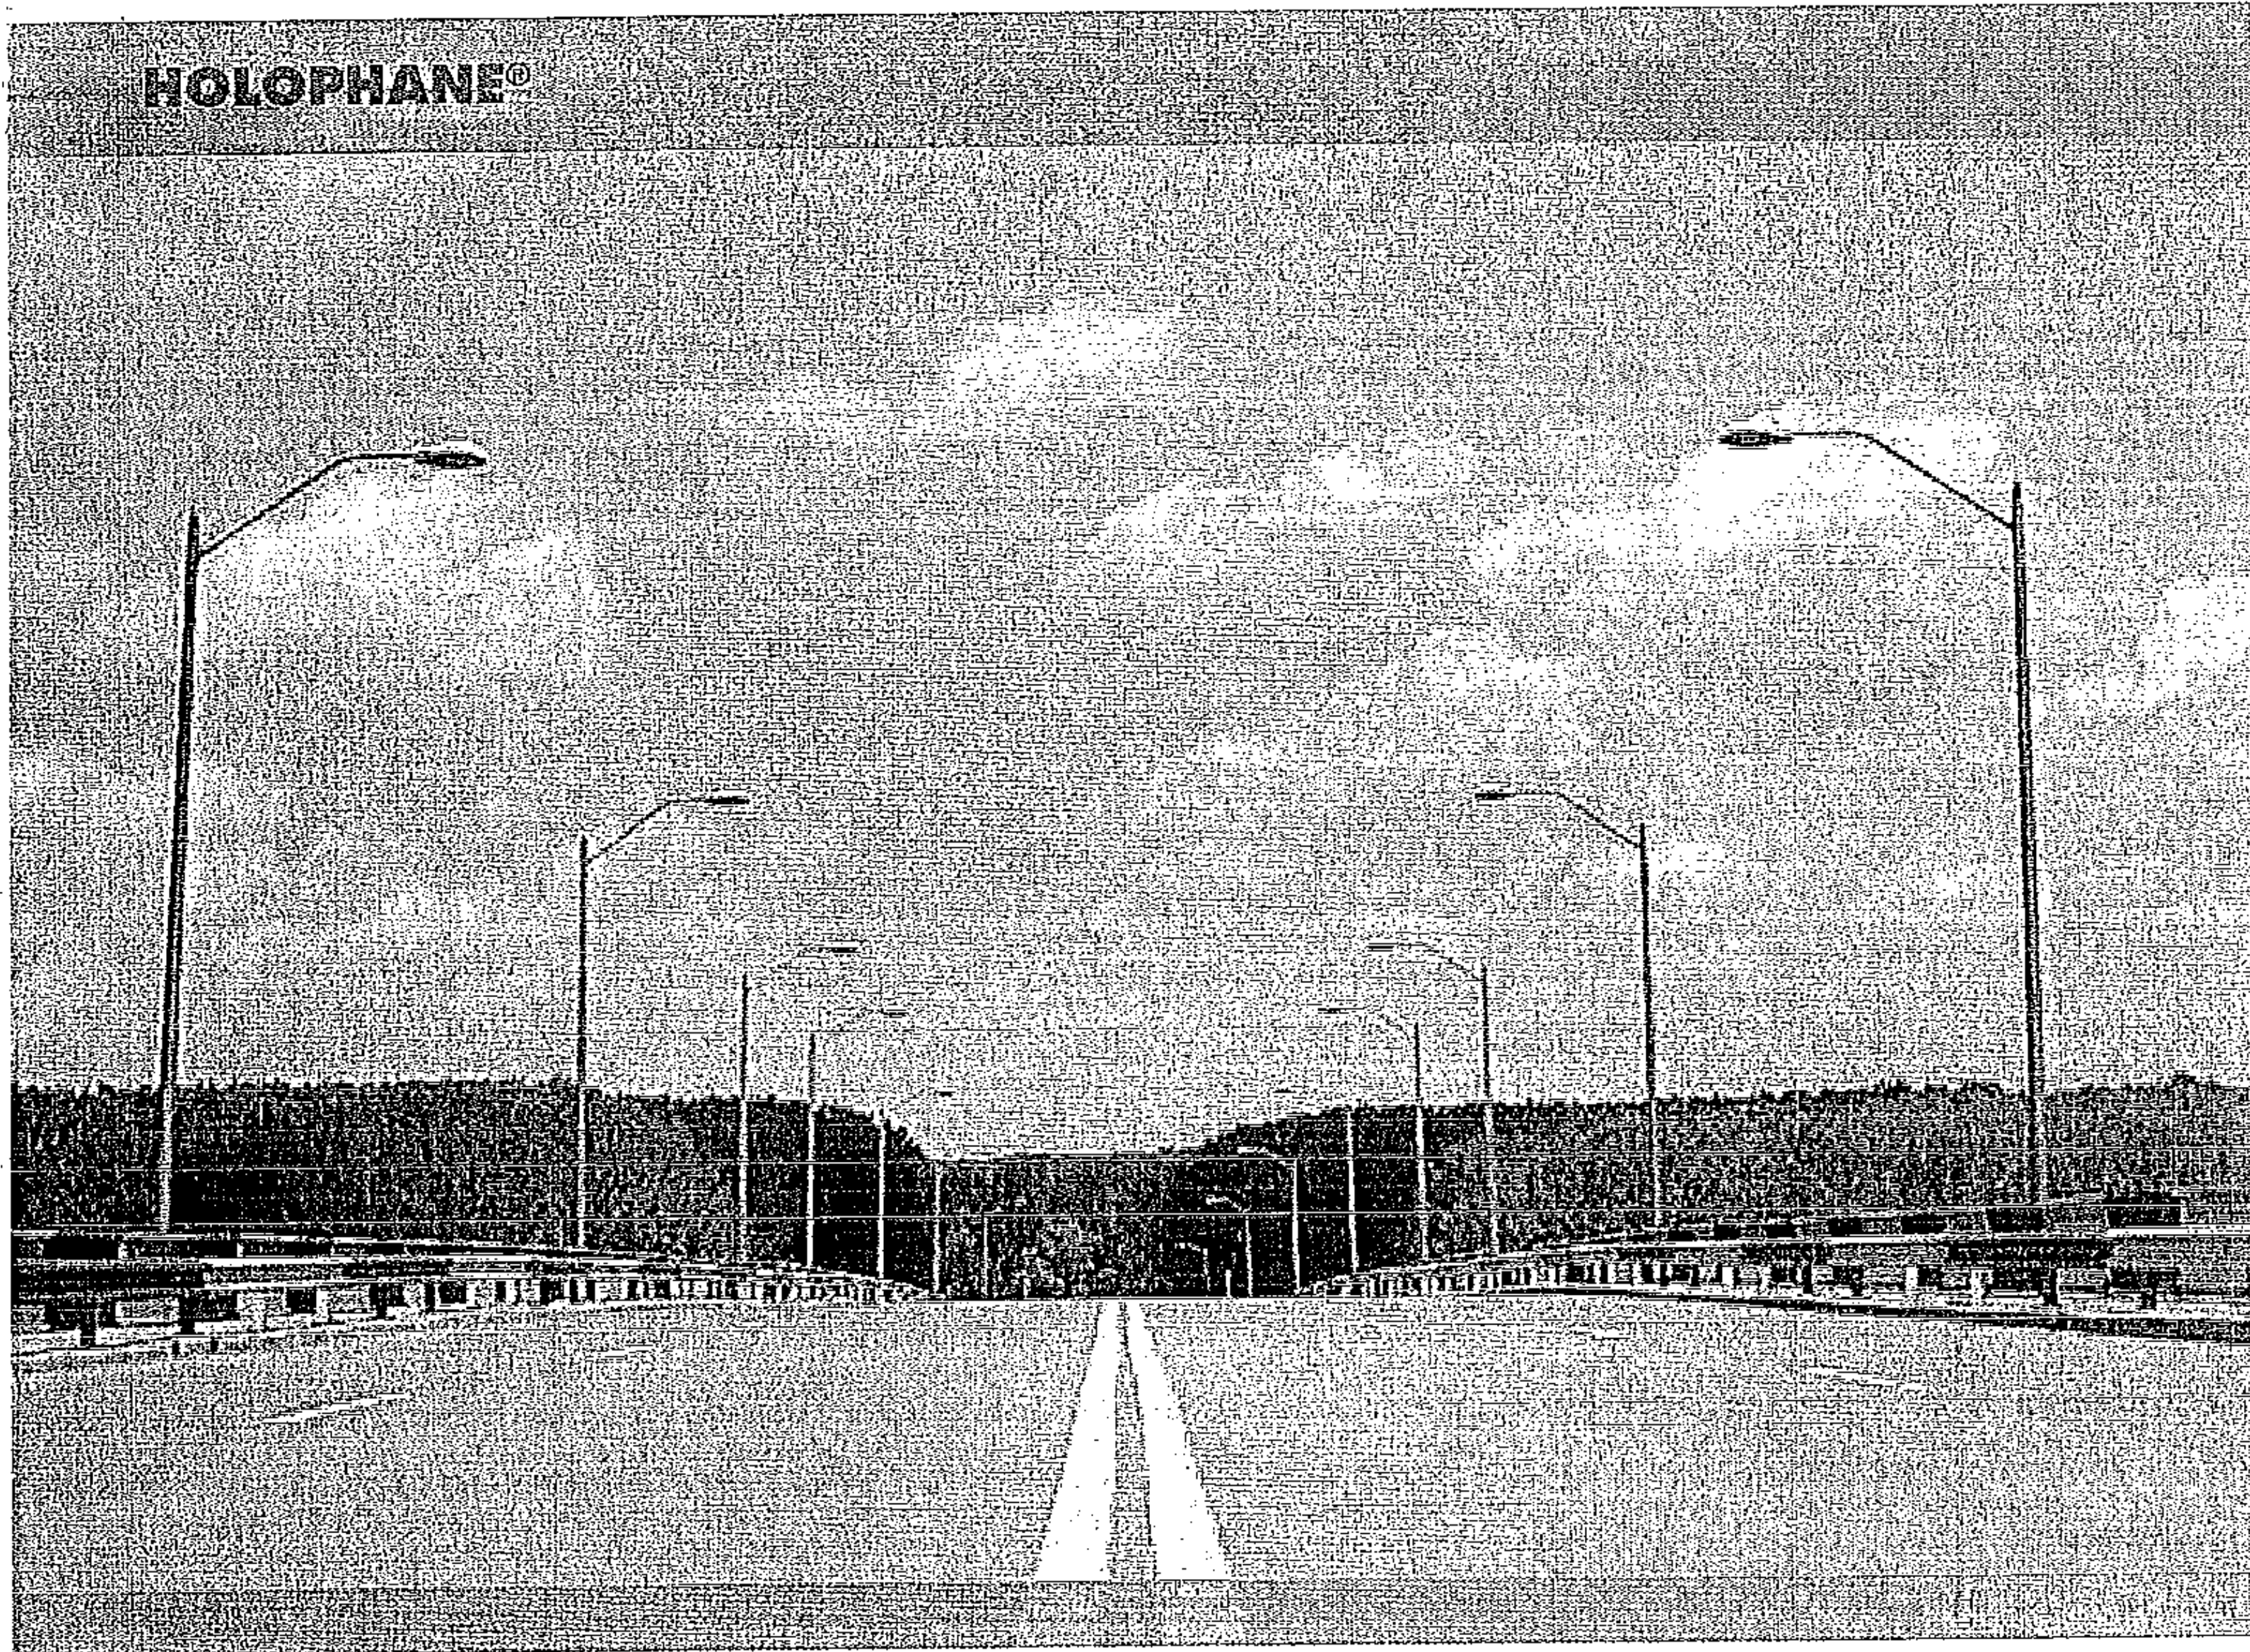


# LEDGEND®

## ROADWAY AND AREA LED

HOLOPHANE IS THE PREEMINENT  
INNOVATOR AND LEADING BRAND  
IN ROADWAY LIGHTING SYSTEMS  
DESIGNED TO MEET INDUSTRY-  
SPECIFIC NEEDS.

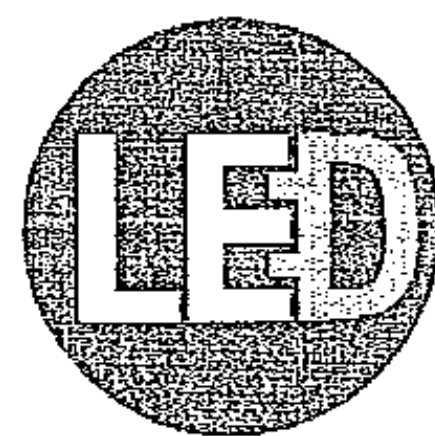

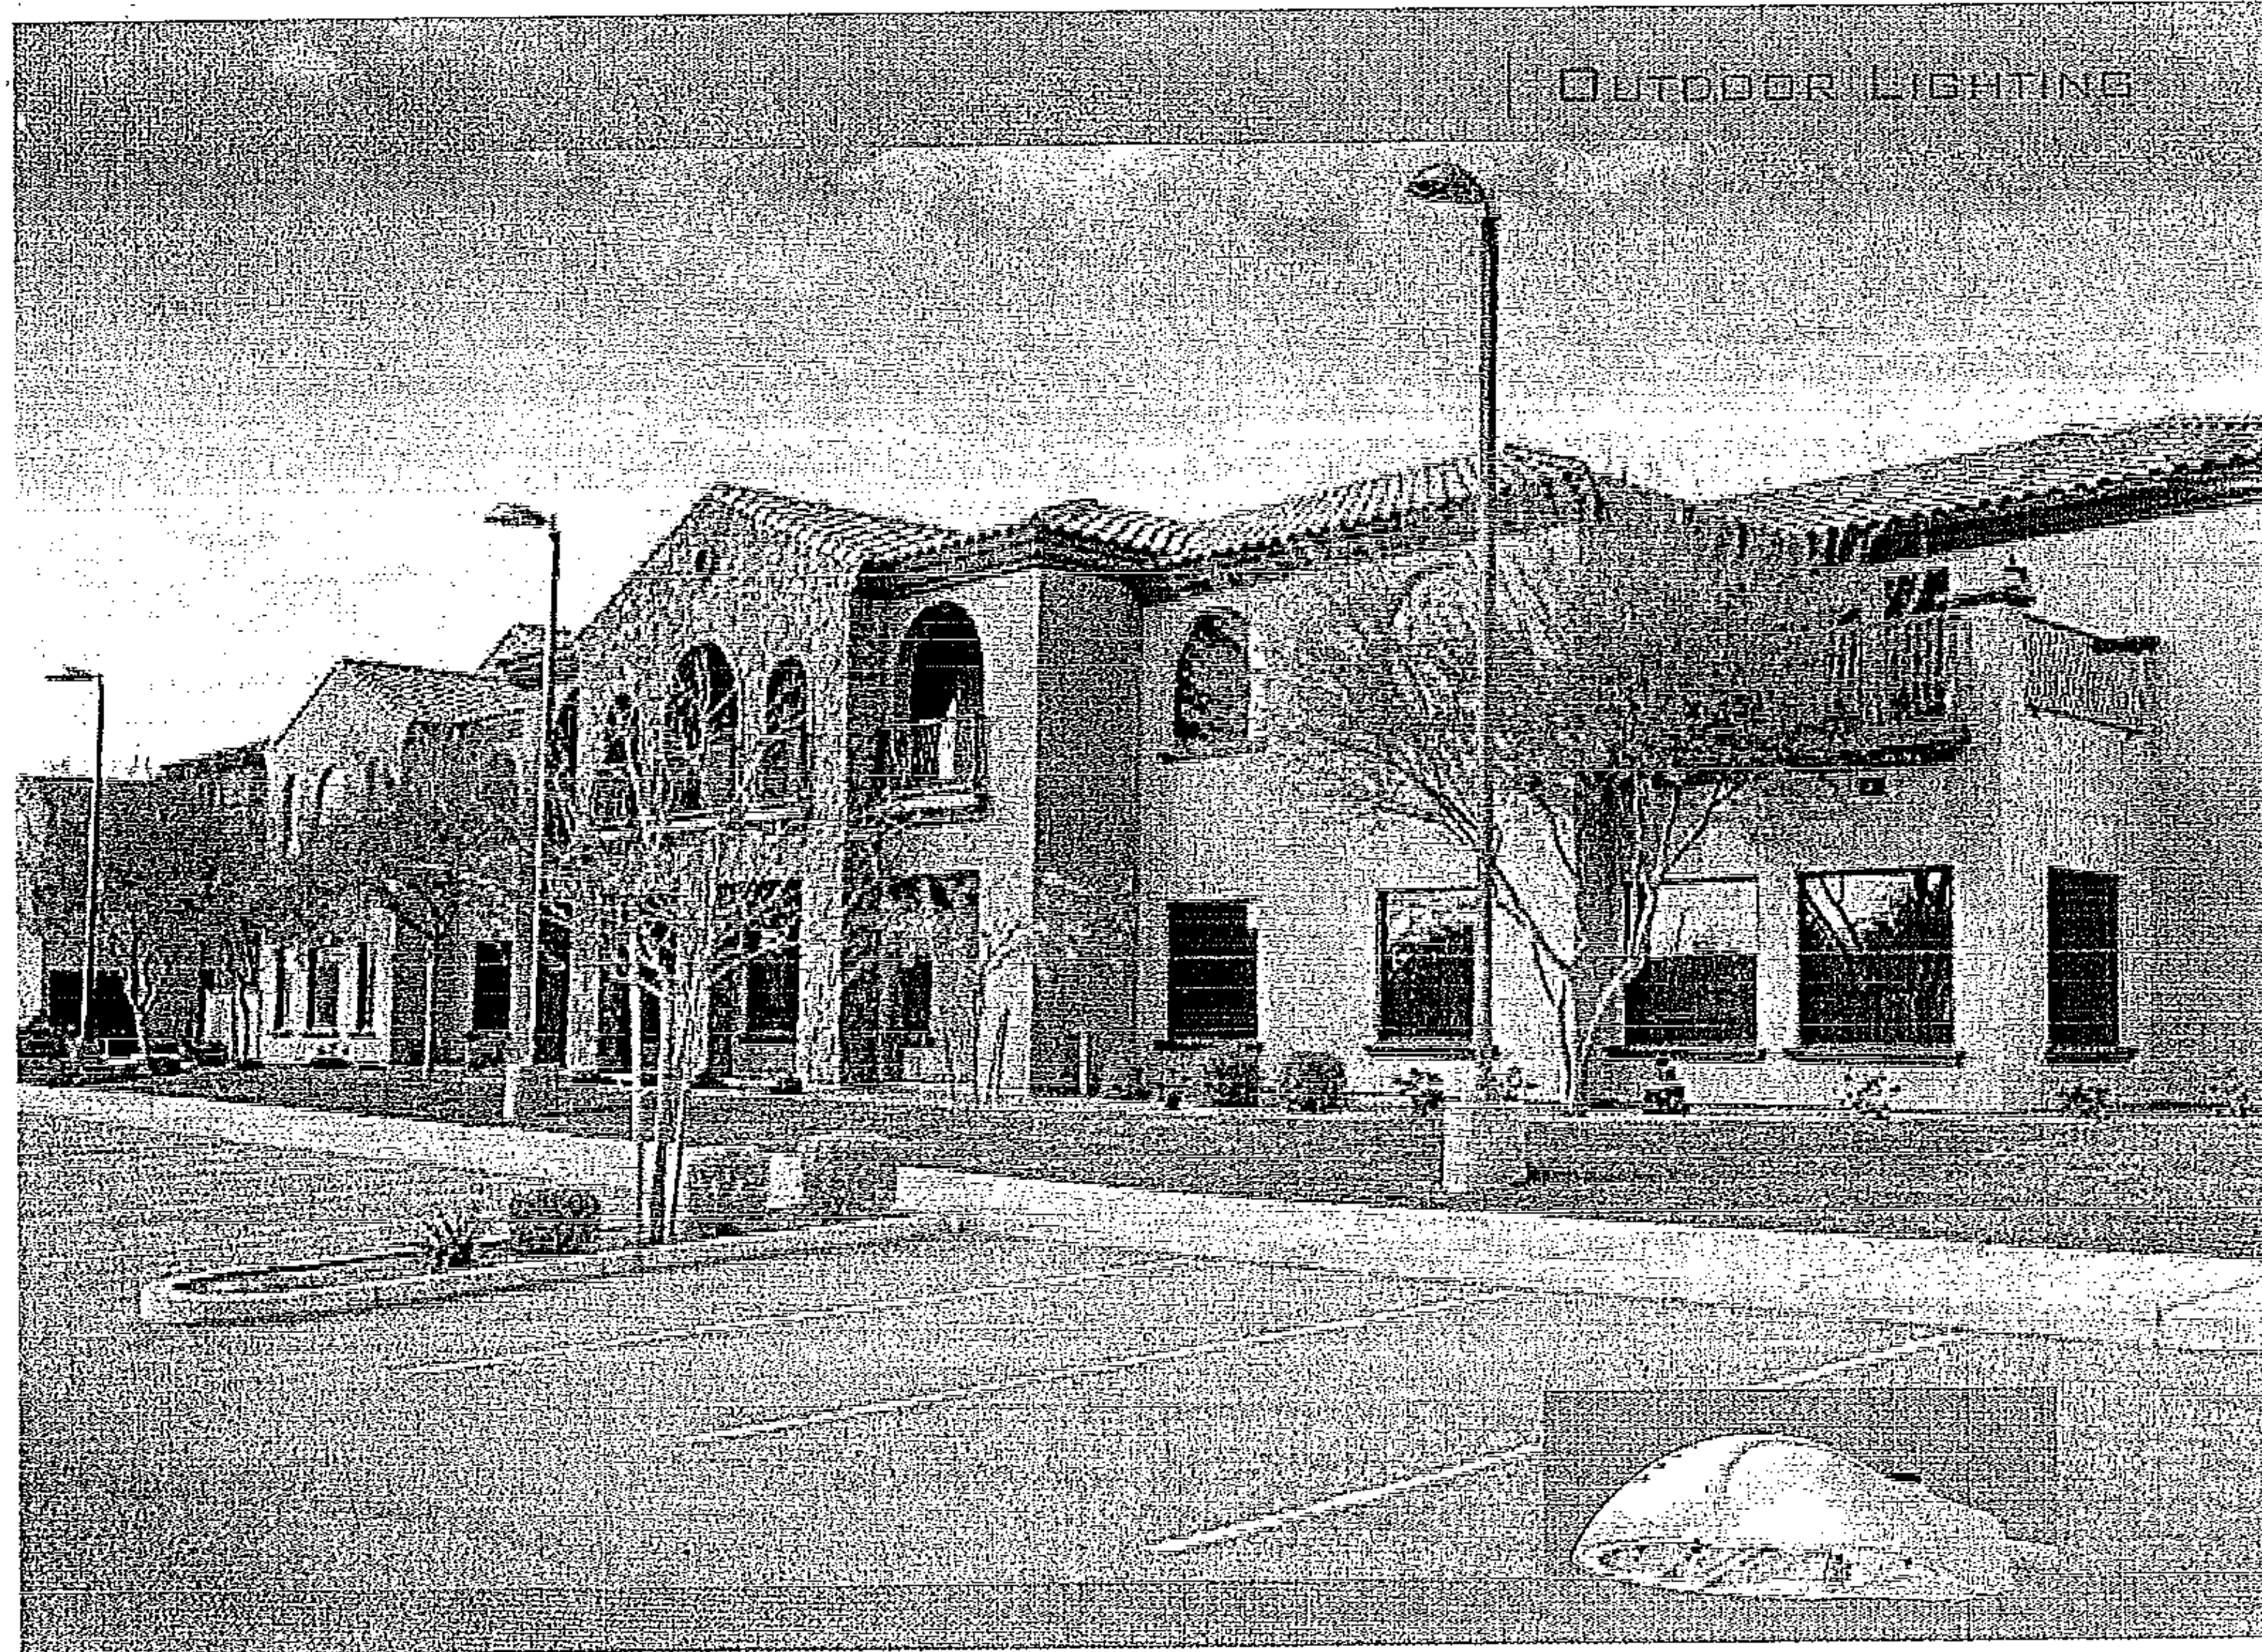

### FEATURES AND BENEFITS


- Permanent prismatic glass optics protect LED's, control light, and reduce glare
- Optimized maintained thermal management system for maximum performance and life
- Precise optical control for high application efficacy
- Multiple lumen packages offer design flexibility replacing 50-310 watt luminaires
- Environmentally friendly design with zero uplight prevents light pollution
- Optional dual driver system extends driver life up to 200,000 hours
- Dimming options reduce energy load
- Area and roadway lighting distributions

### TYPICAL APPLICATIONS

- Municipal Streets and Public Roadways
- Residential Areas
- Campuses
- Military Bases
- Industrial Parks
- Hotels/Resorts
- Bridges
- Municipal Parks
- Recreation Centers
- Parking Lots

**HOLOPHANE®**

## Our History in Lighting is Legendary

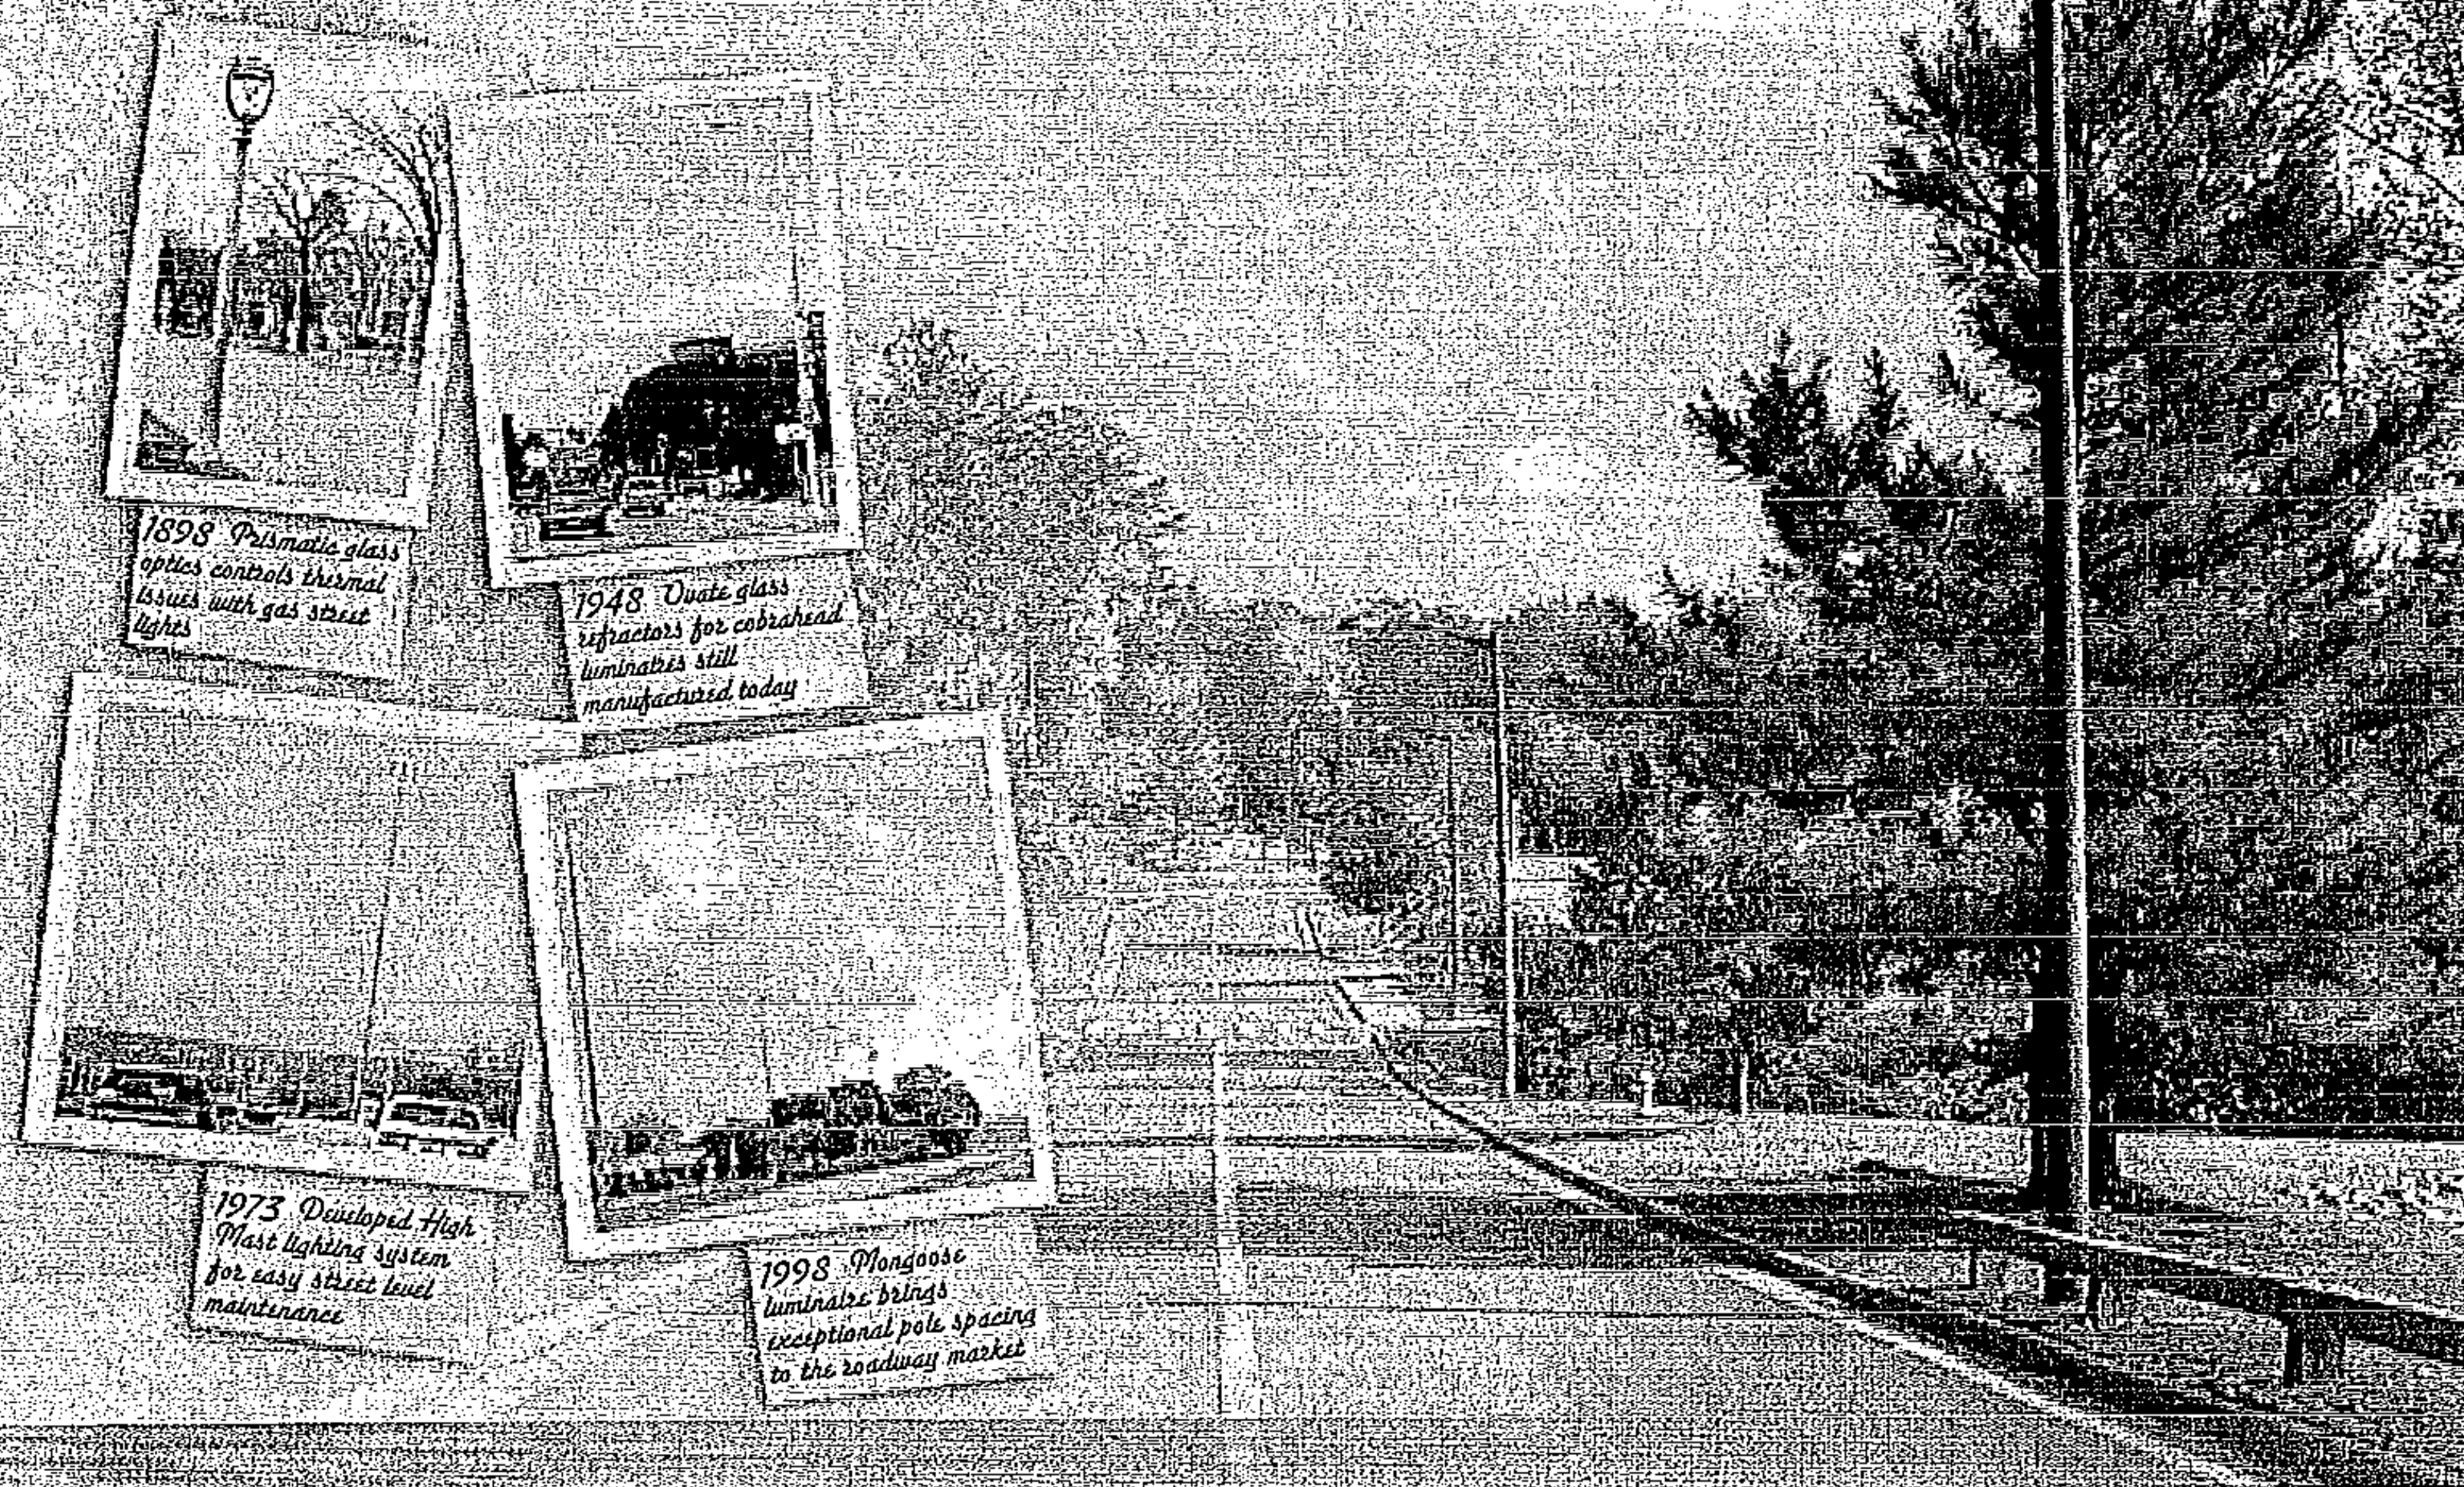


DURING THE 1890s, HOLOPHANE PIONEERED GLASS GLOBES FOR GAS STREET LIGHTS THAT ILLUMINATED MAIN STREETS ACROSS AMERICA. WE WERE ALSO INSTRUMENTAL IN DEVELOPING THE TECHNOLOGY TO MANAGE THE THERMAL ISSUES POSED BY THE GAS BURNERS. DURING THE 1940s, HOLOPHANE DEVELOPED AN OVATE REFRACTOR THAT REVOLUTIONIZED STREET LIGHTING BY UTILIZING PRISMATIC GLASS TECHNOLOGY. WE STILL PRODUCE THESE REFRACTORS IN OUR GLASS PLANT IN NEWARK, OHIO, WITH MILLIONS OF UNITS INSTALLED IN COBRAHEAD STYLE ROADWAY PRODUCTS WORLDWIDE.

### New LEDgend Luminaires


This heritage of leadership in lighting technology continues as Holophane leverages its technical expertise to efficiently control both the optical and thermal challenges associated with LED technology. Holophane LEDgend luminaires meet modern demands for sustainability and long-term performance by combining superior quality with outstanding engineering to effectively manage heat for longer luminaire life and higher lumen output.

Premium LEDgend luminaires are designed to enhance visual comfort and safety for pedestrians and drivers. Their sustainable modular design facilitates fixture upgrades as LED technology advances over time.

# LEGENDARY ENGINEERING

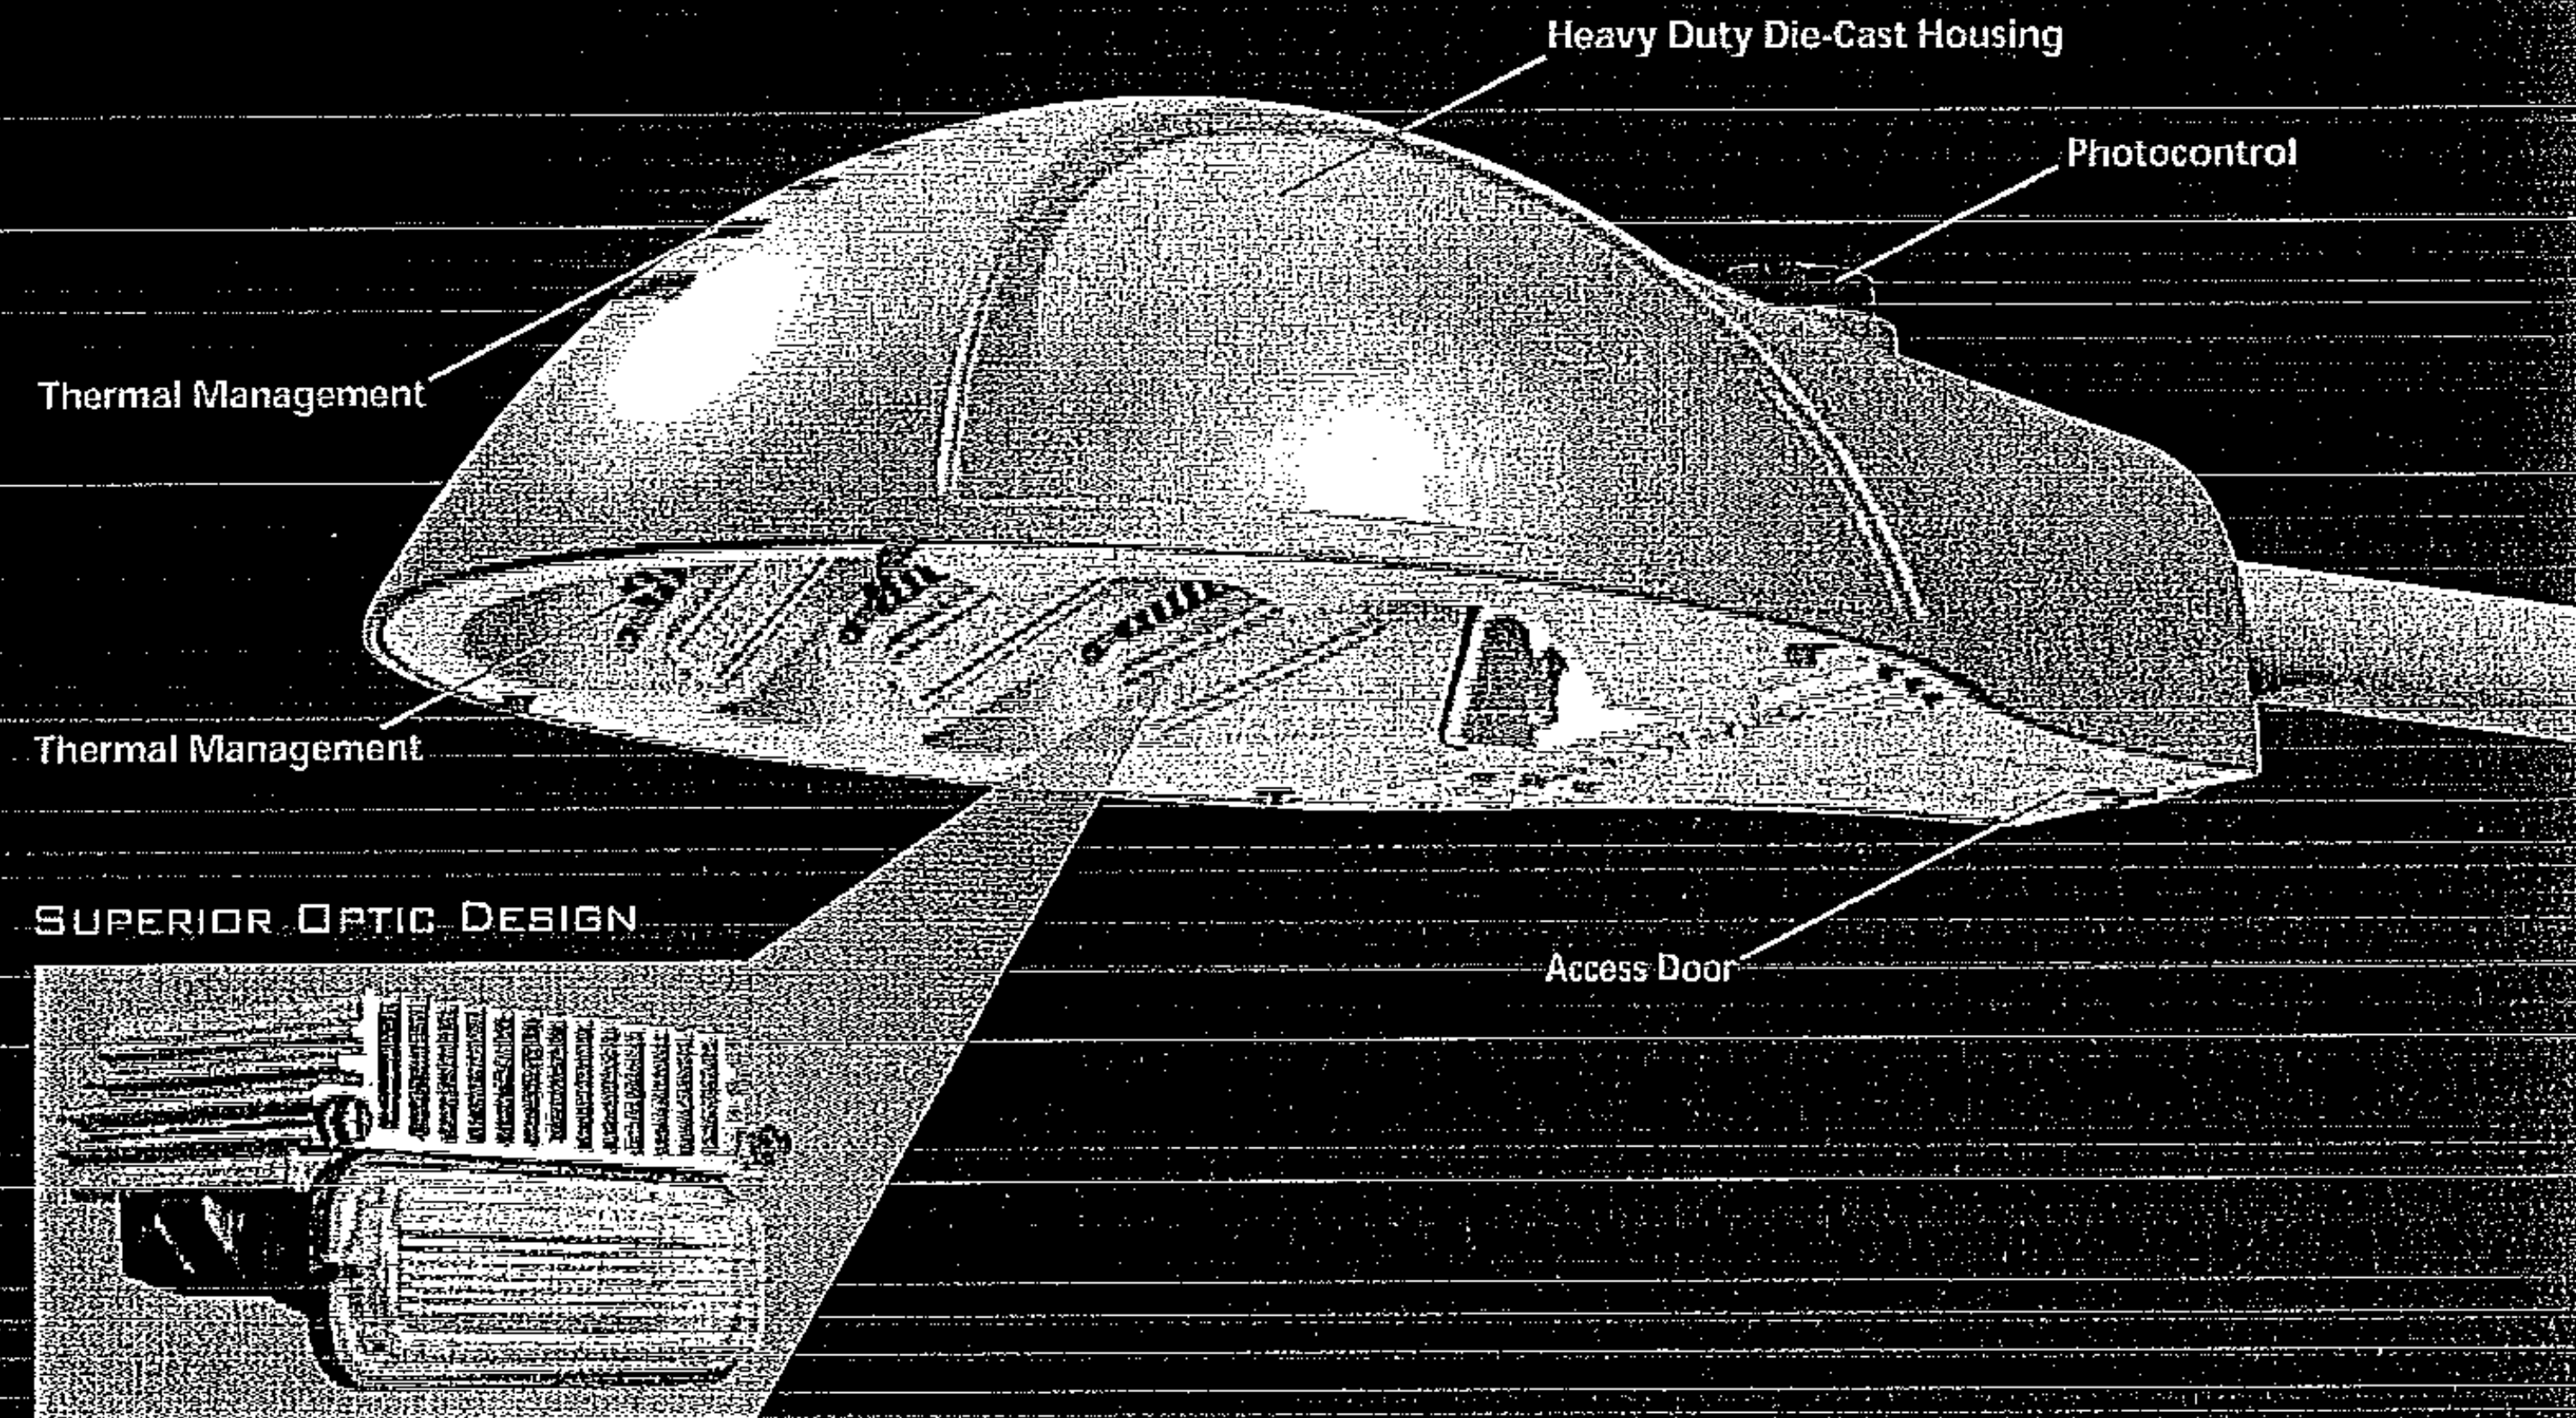


Heavy Duty Die-Cast Housing holds and protects electronic driver, optics and other luminaire components.


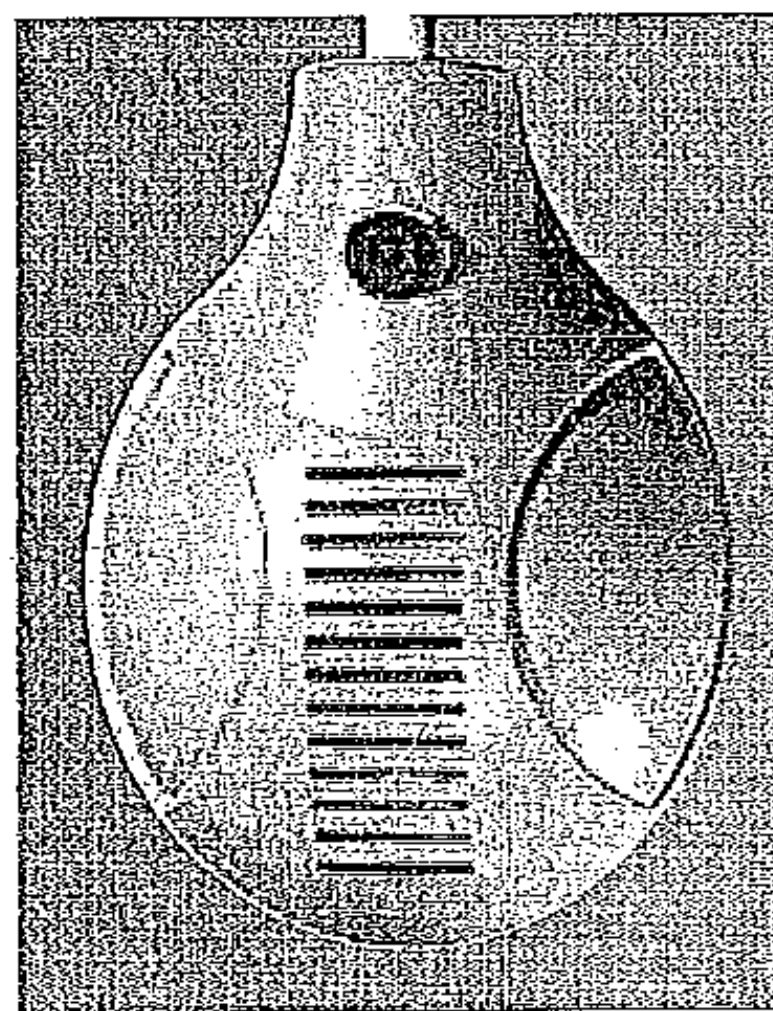


Thermal Management engineered to provide intricate heat sinking design allowing air convection and conduction to keep LEDs and Driver cool.

Superior Optical Design features precise optical control via high performance reflector and prismatic glass refractor lens.

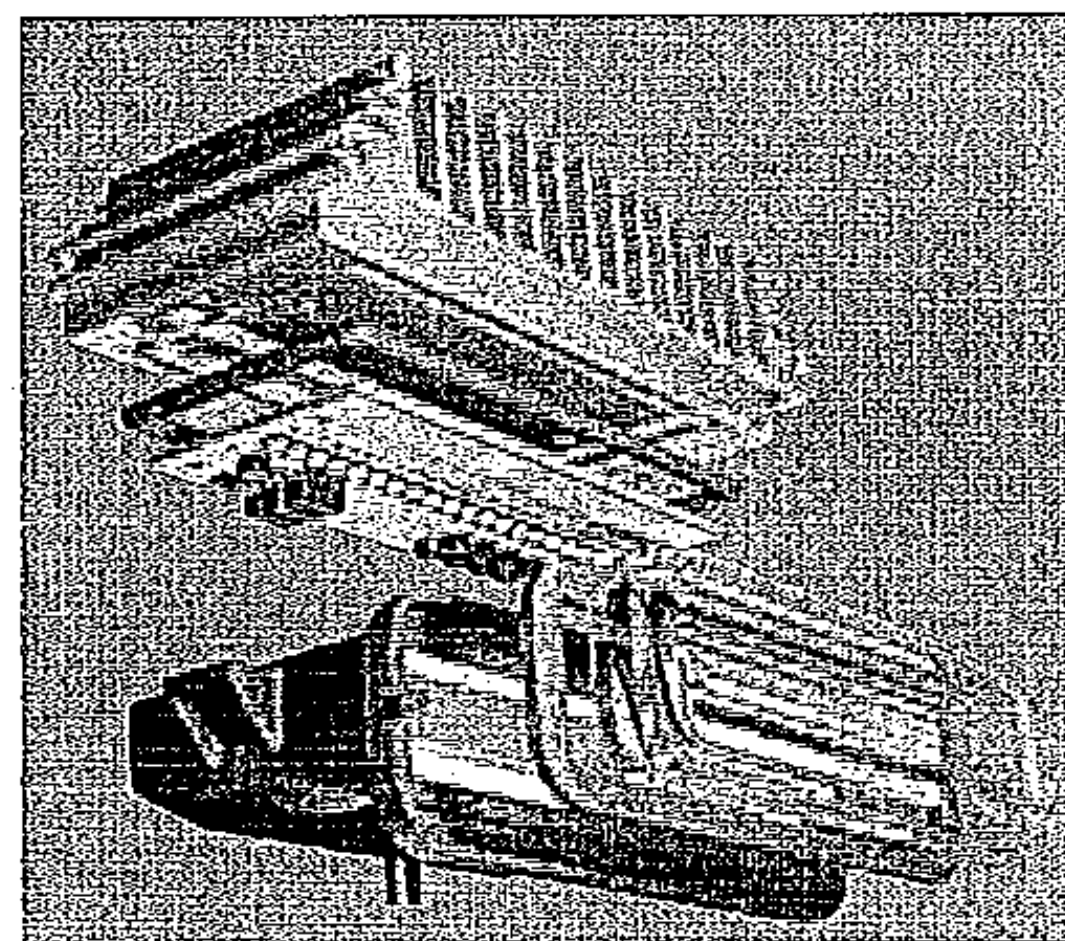


Photocontrol saves energy and reduces costs with reliability and accurate light sensing.

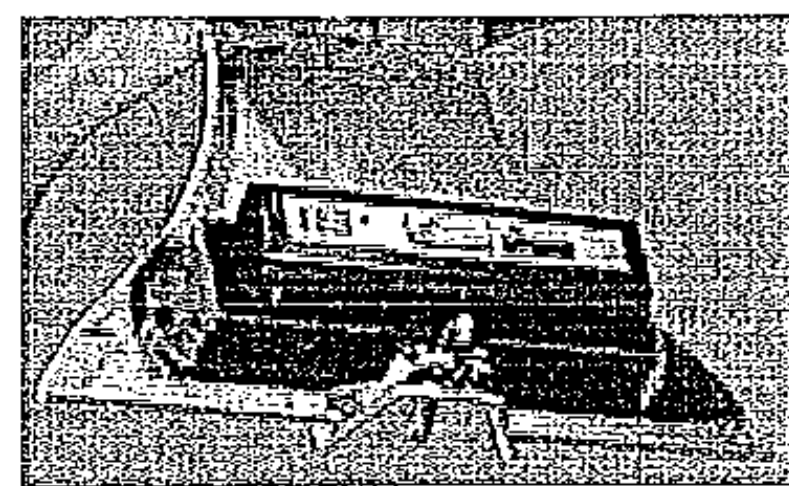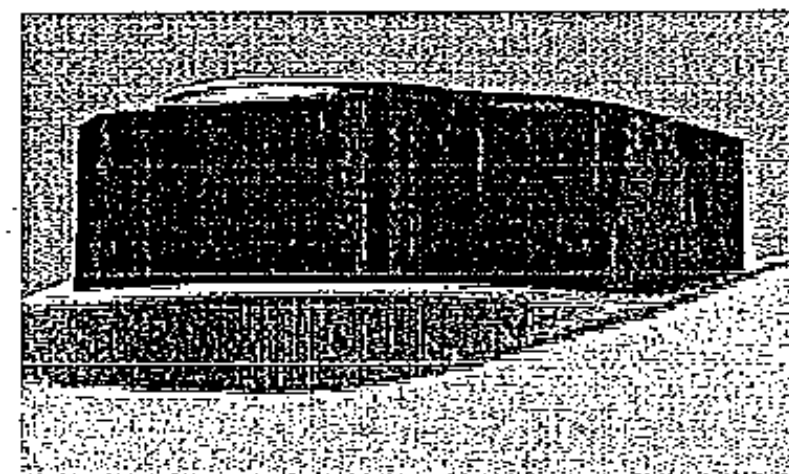

Access Door provides tool-less access to LED driver, terminal block, surge module and arm mounting bolts.

## THERMAL MANAGEMENT

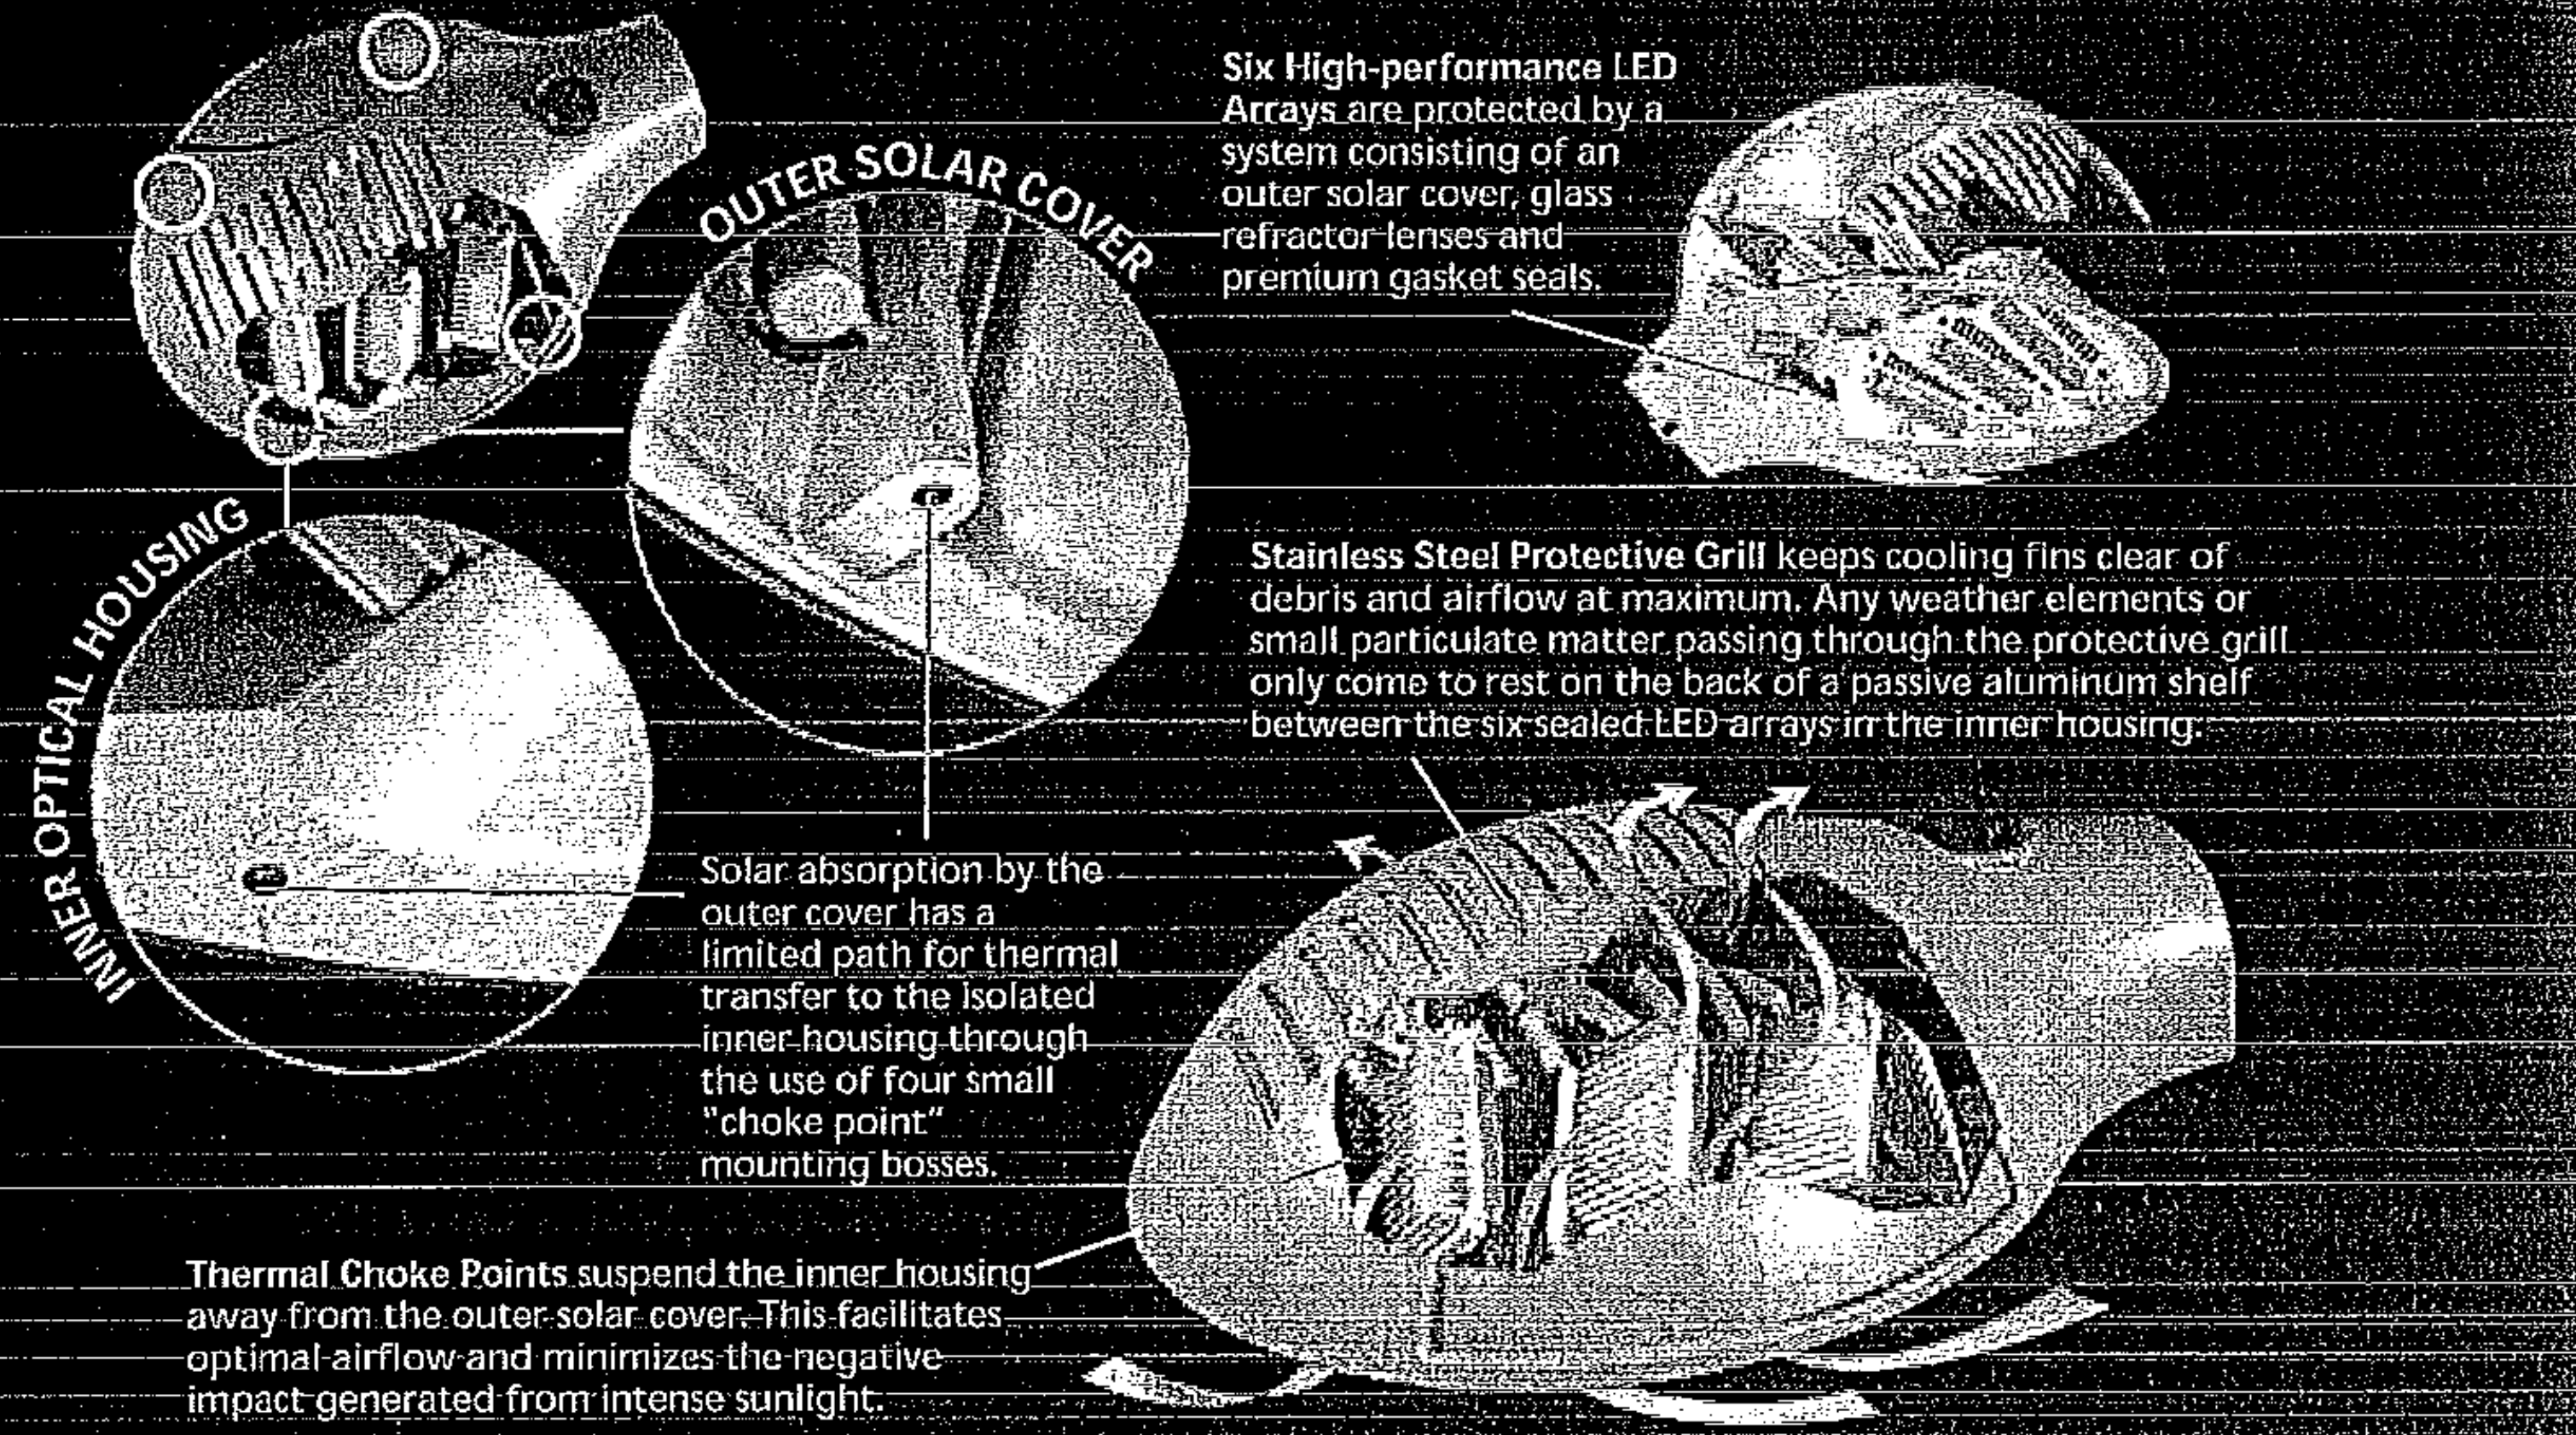


### Better maintained thermal performance and lower Junction Temperature equals longer life and higher delivered lumen output for the LED

Electrical current that is not converted into light at the semiconductor junction turns into heat and results in increasing temperatures that reduce lumen output and LED life. Junction temperature is affected by the ambient temperature surrounding the LEDs, the thermal path junction through the heat sink, air flow through the unit and the outside ambient temperature.


LEDgend luminaires incorporate intricate heat sinking technology to provide air convection and conduction that keeps the LEDs and the driver cool to ensure longer life, higher delivered lumens and color consistency. An internal perforated cover prevents debris accumulation and facilitates flow-through ventilation to keep components cool.

Holophane LEDgend luminaires are designed for a minimum 80,000 hours of maintenance-free operation in a 40C ambient attaining 70 percent of the initial lumen output (350mA only). Longer life is attained when the fixtures operate at lower ambient temperatures of 15°C to 25°C.

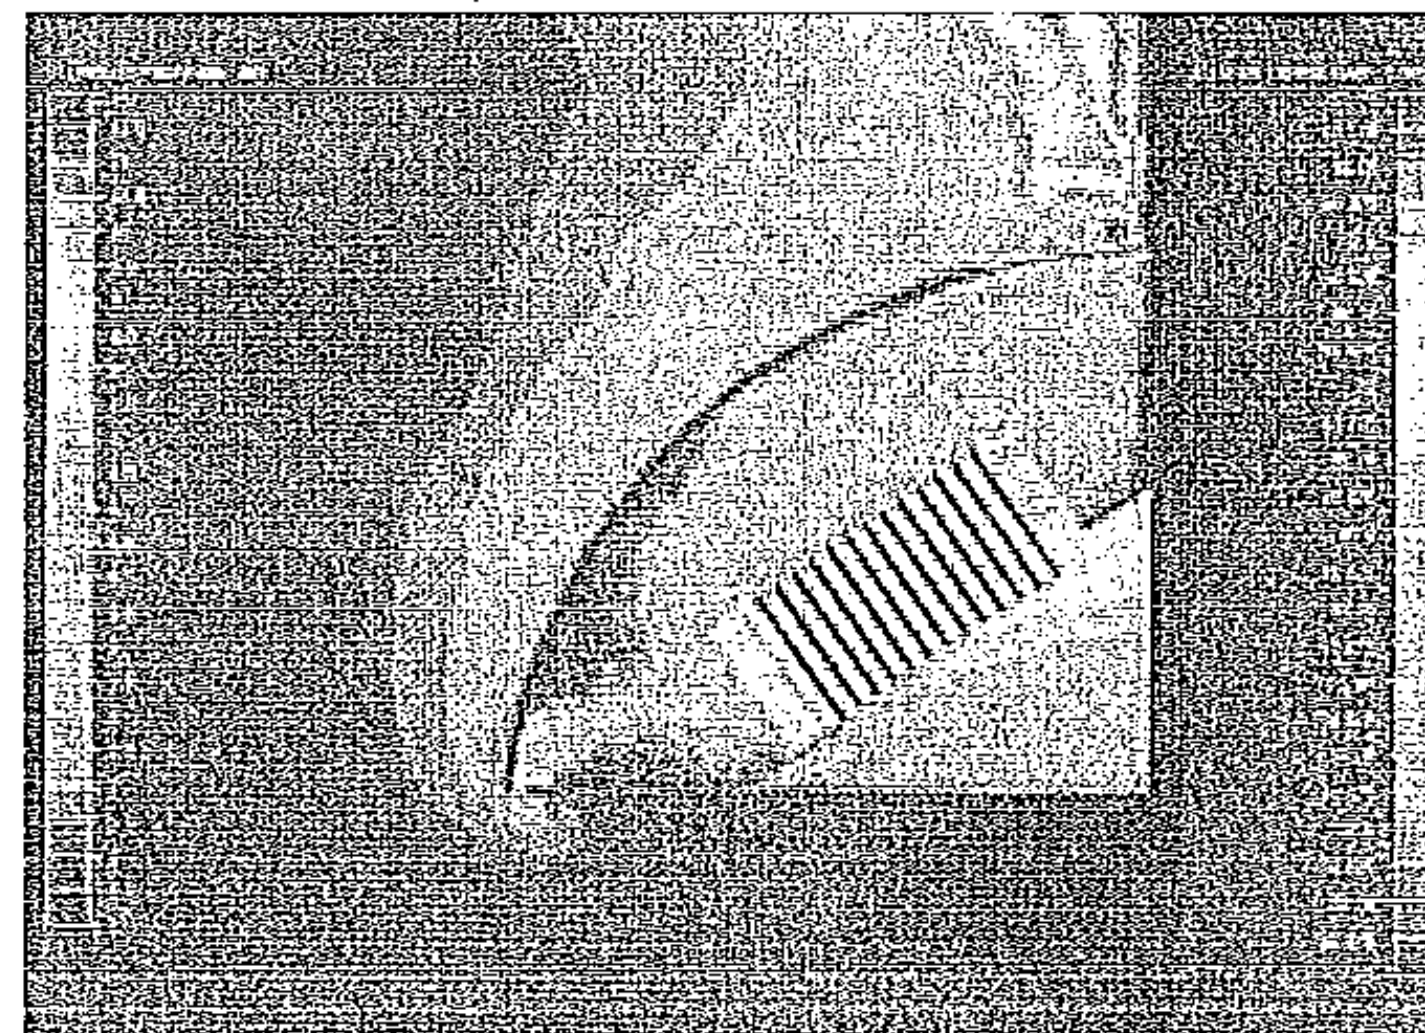

Thermal "venturi effect" optimizes heat transfer


# PRECISE OPTICAL CONTROL

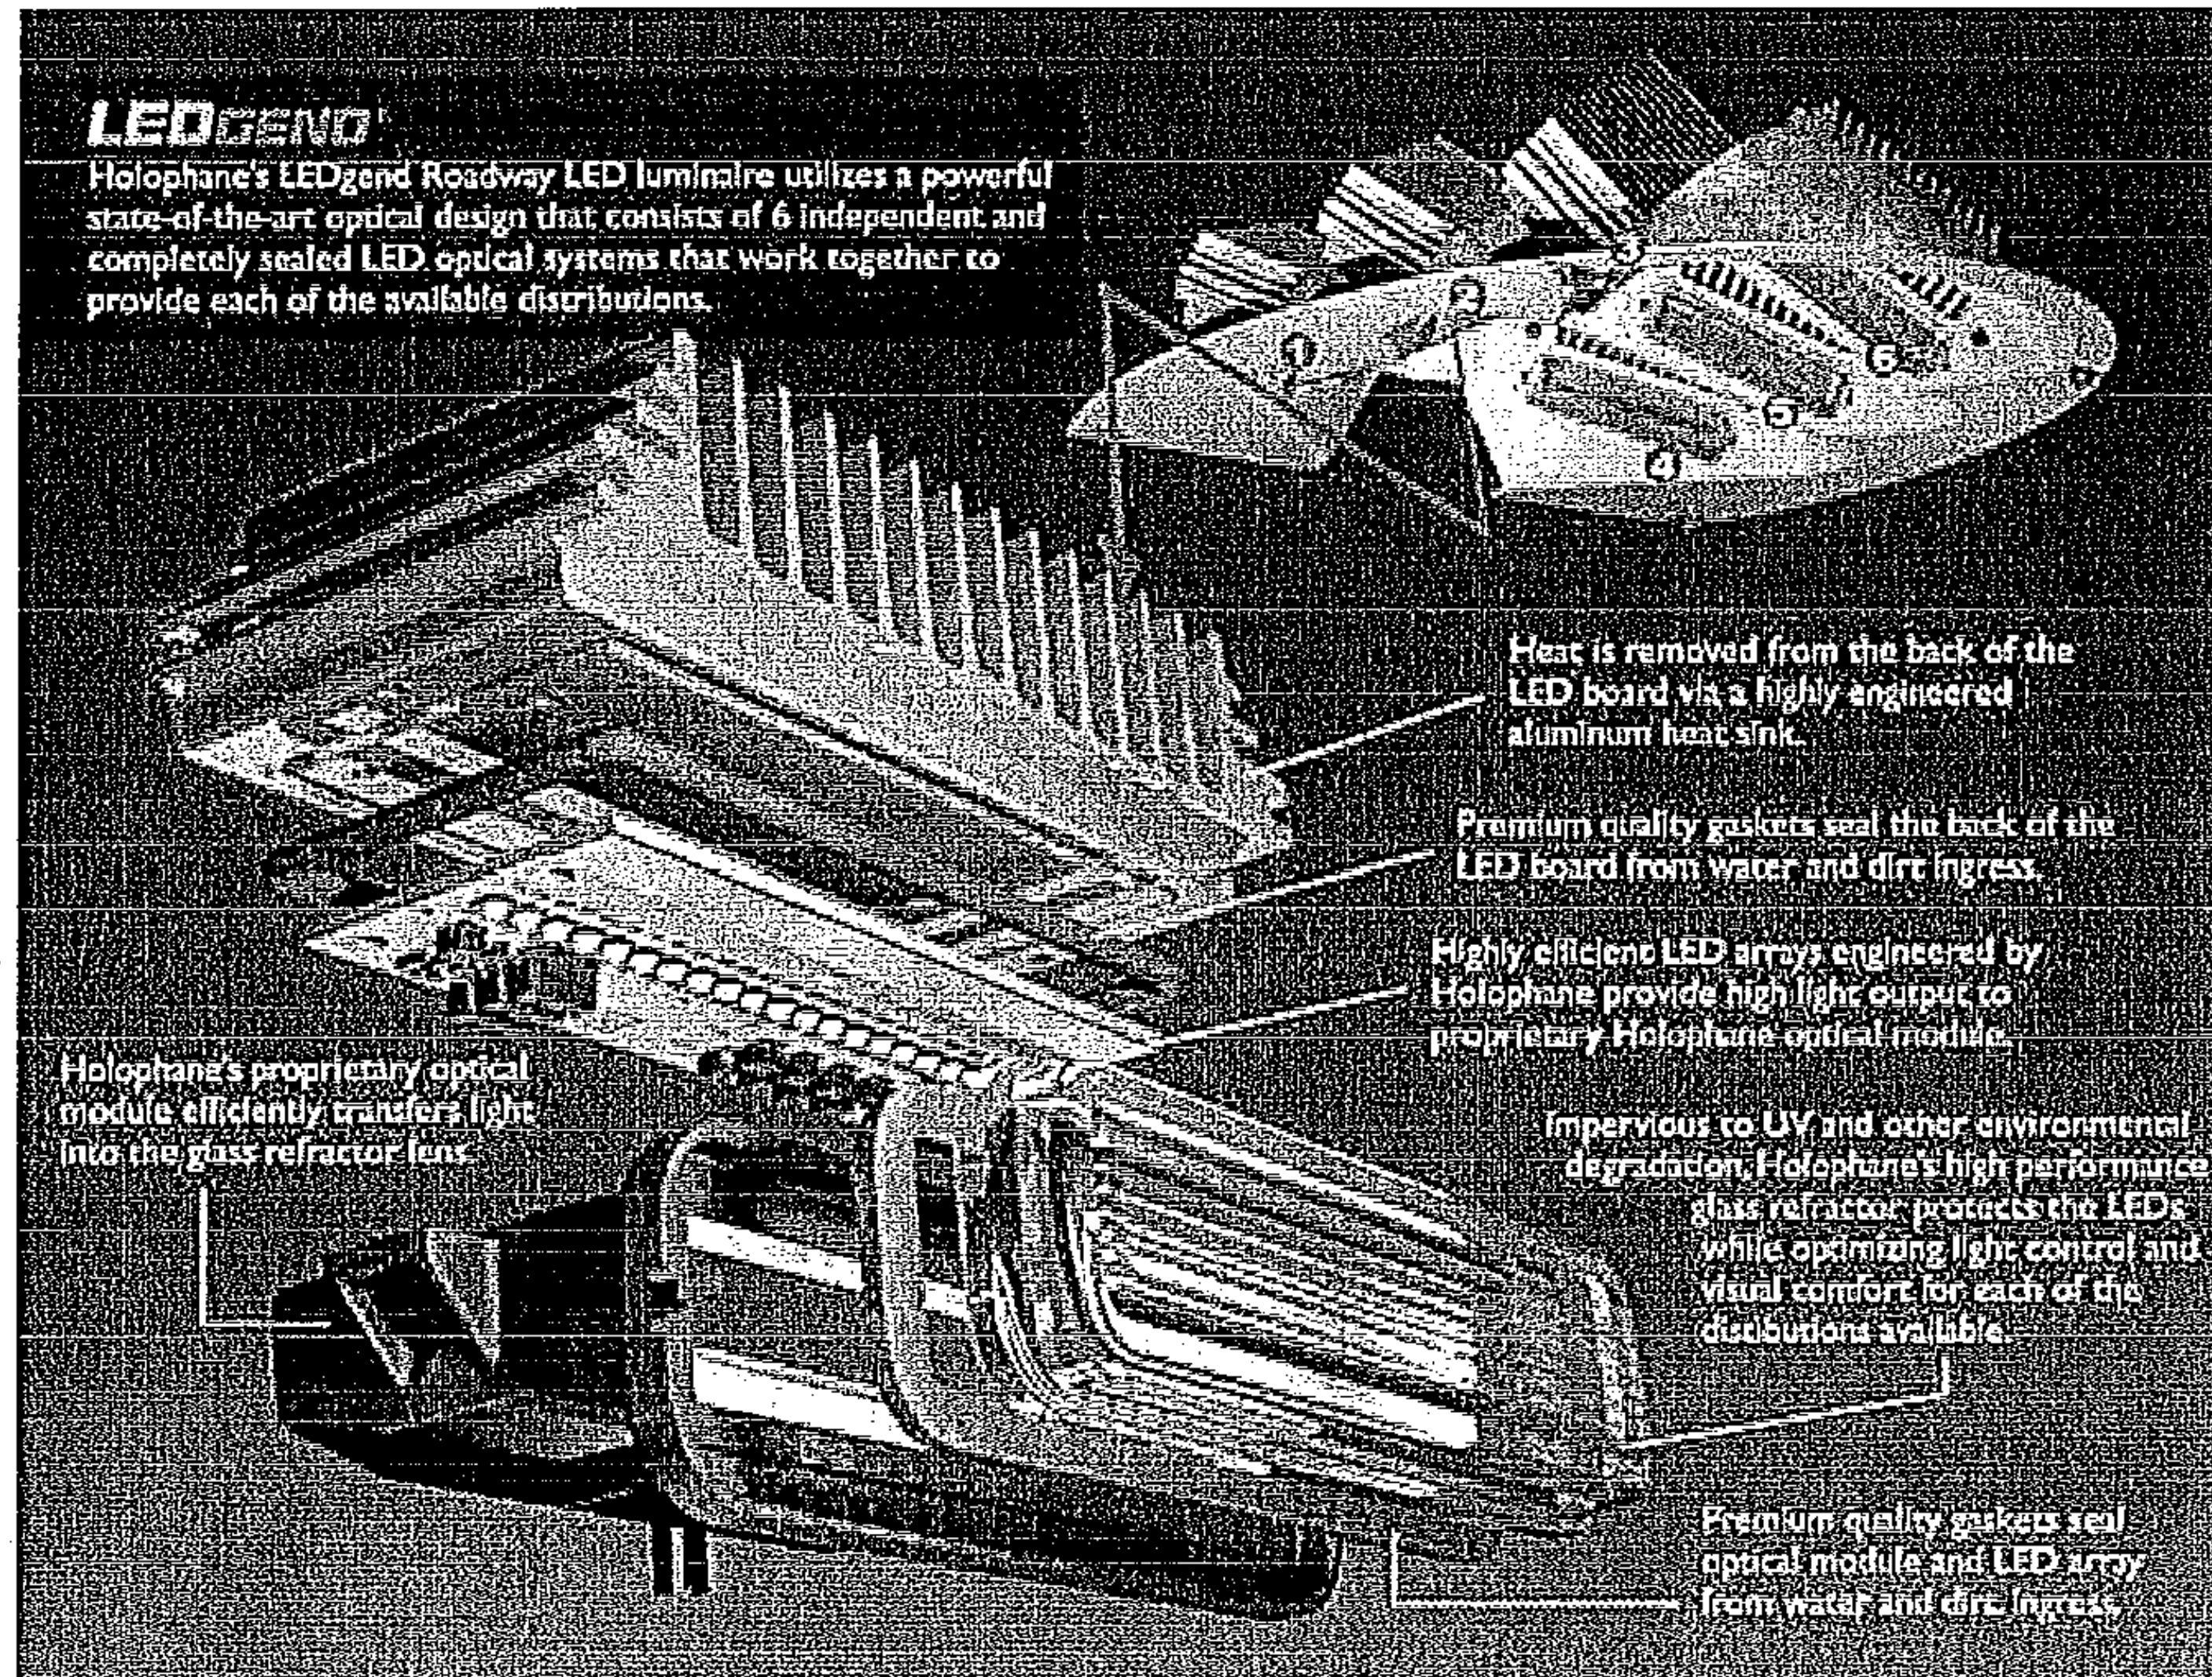

The fixtures' prismatic glass refractor lens offers permanence and ensures long-term performance with very low dirt depreciation, resulting in more light within the intended space. A sealed optical system provides an IP66 ingress rating against water and dust and extends component life. Glass optics, a legendary core value to the Holophane brand, never yellow, haze, scratch, or discolor and will not become brittle over time.

LEDgend luminaire optics are designed to maximize pole spacing and reduce energy usage resulting in a lower total cost of ownership.

The LEDgend's highly engineered light engine is designed to restrict the direct view of individual LED's. The result is a luminaire that appears "wholly luminous" without the unsightly view of individual LED points of light, increasing visual comfort within the field of view.

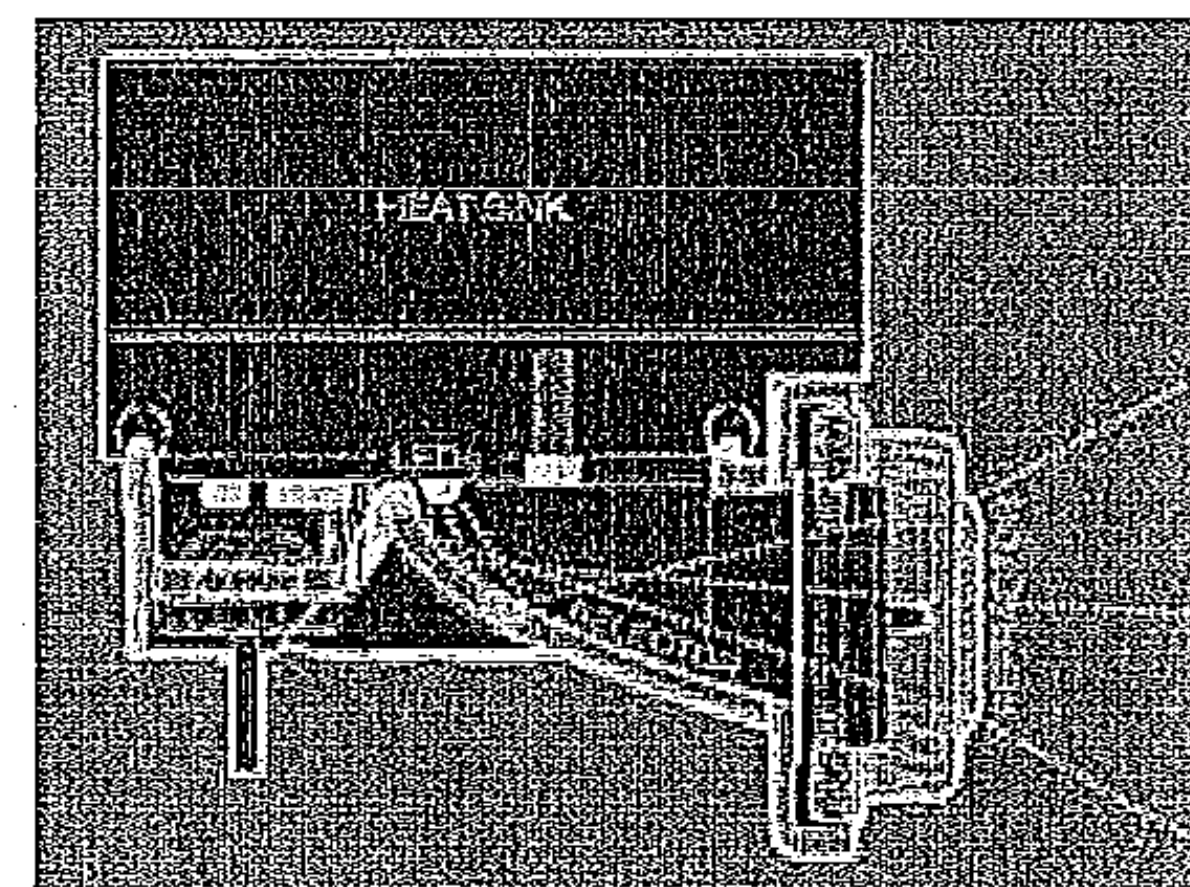

Cross section of a LEDgend LED optical module illustrating how the reflector bends the light into the glass refractor.


# APPLICATION EFFICACY

A major benefit of the LEDgend luminaire is directing the distribution precisely on task. The benefit to the customer is that poles may be spaced further apart, improving visibility, minimizing light trespass, improving visual comfort, with less consumed wattage as compared to traditional sources and competitive LED products.

A major component to evaluating LED sourced luminaires is applied lumens. This is a metric that defines how well a luminaire distributes the lighting in the intended space while meeting the uniformity and veiling luminance (glare) requirements per industry standards for roadway lighting.

The example on the right illustrates applied lumens comparing an existing HPS cobrahead and competing LED roadway luminaire to the LEDgend luminaire.

**Application:** Three lanes each direction with thirty five foot poles mounted in staggered configuration with luminaire placed at edge of pavement. This simulation is a replacement of existing 150 HPS luminaires originally designed to meet 1 footcandle maintained with a 3.0:1 Avg/Min uniformity ratio.

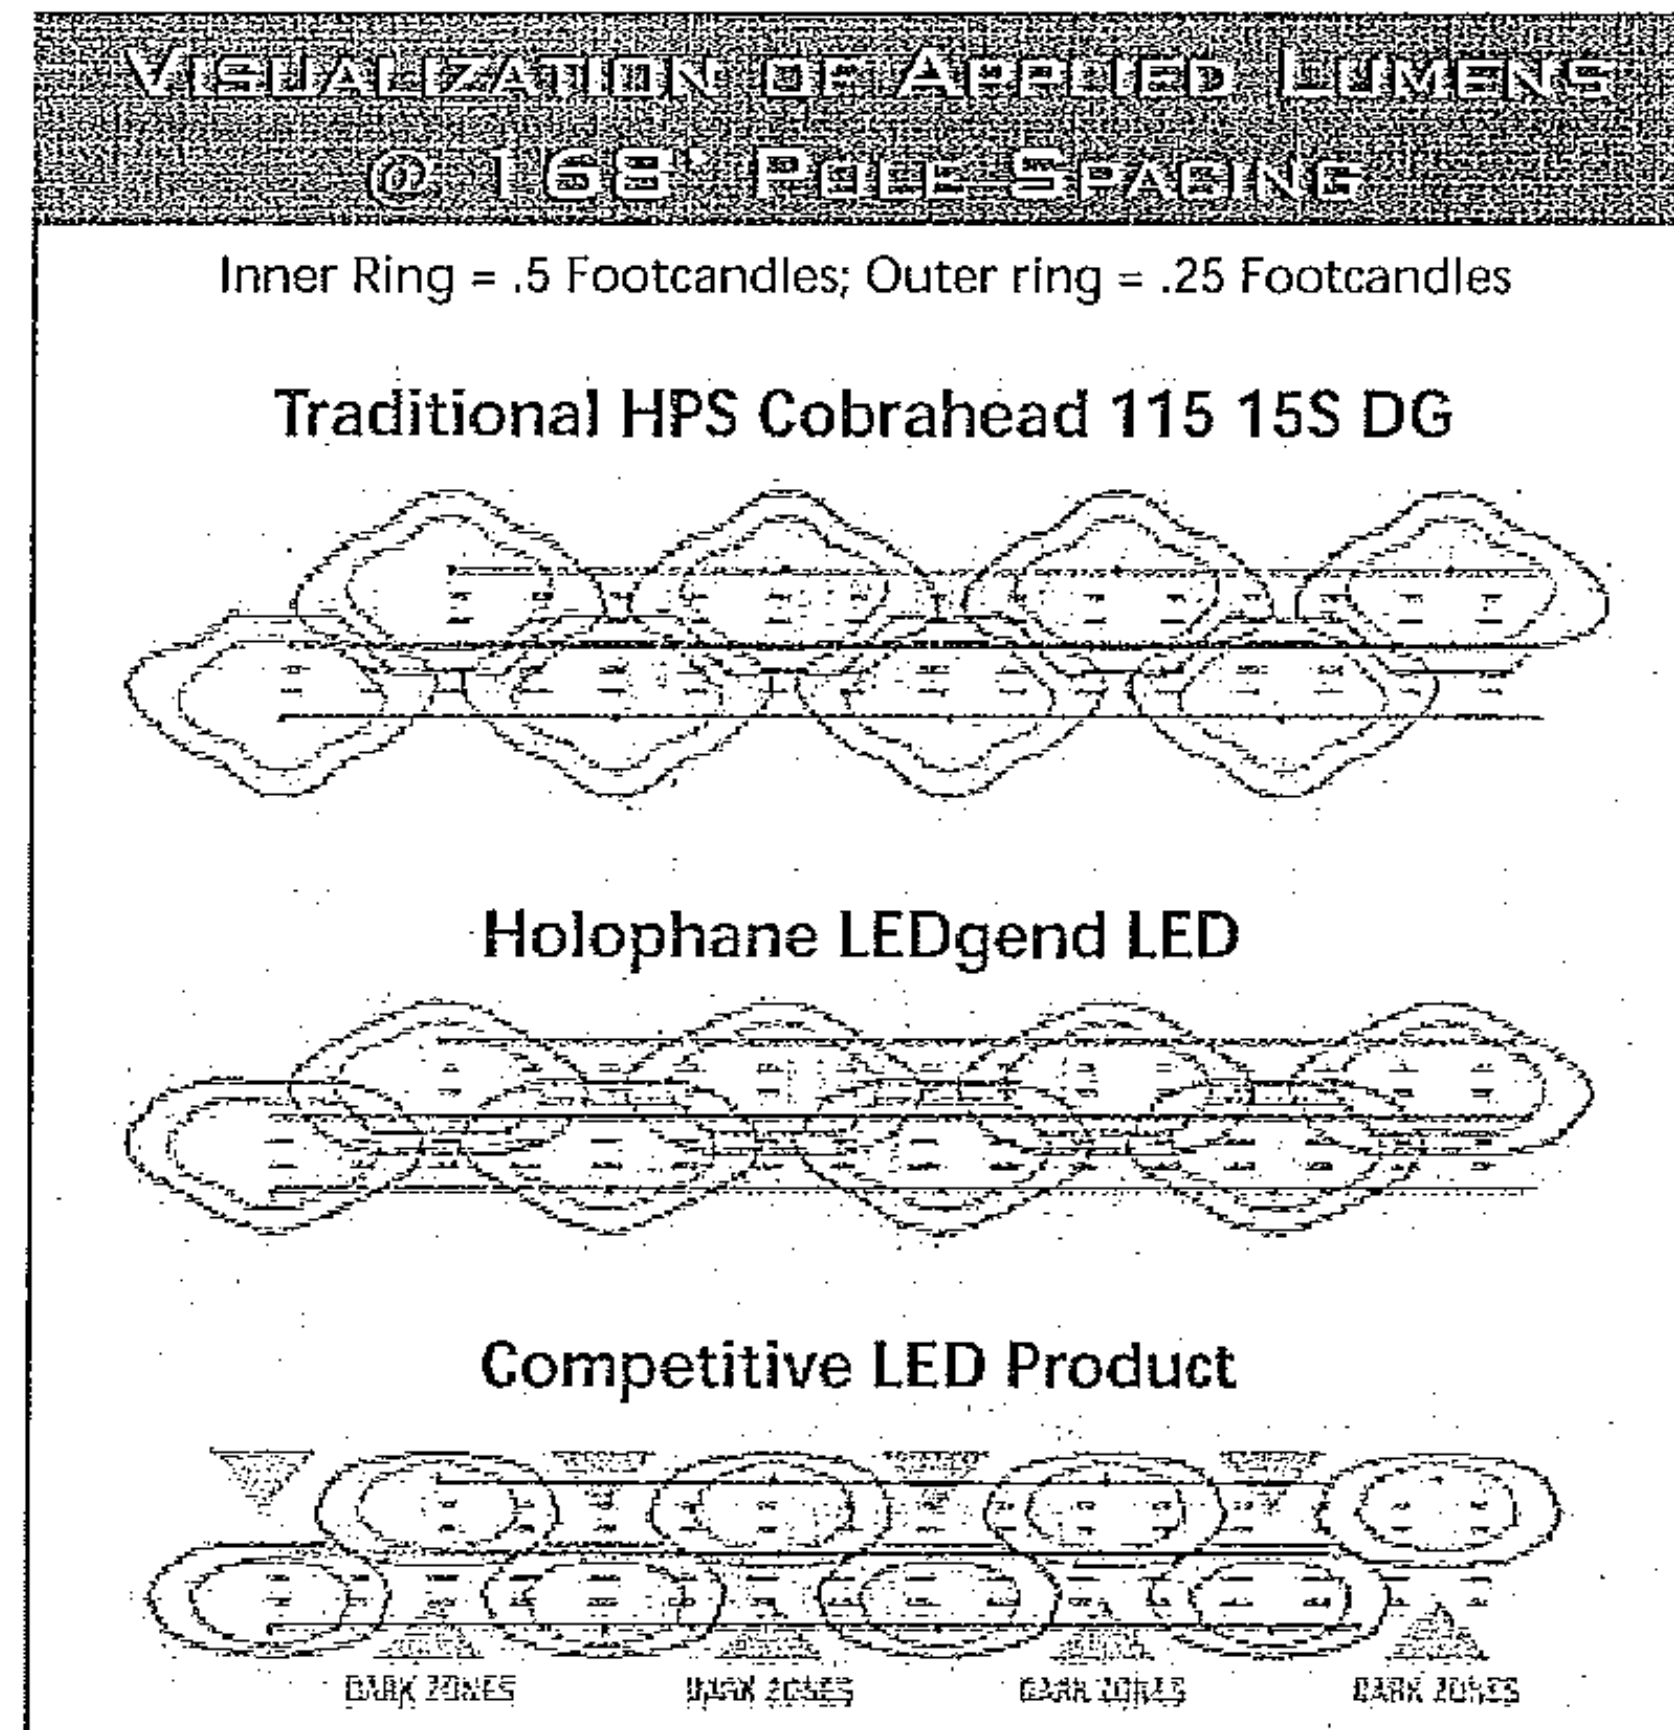

## SYSTEM COMPARISON:

Luminaire Performance	150 HPS Oval Cobrahead	LEDgend	LED Competitor
	115-15S-DG	LEDG120L3	Type 3
Pole Spacing	168	168	168
Average Footcandles	1.00	1.00	0.75 ¹
Avg/Min	2.33:1	2.86:1	2.14:1
Max/Min	5.09:1	4.60:1	5.14:1
Power (Watts)	186	129	157
Energy Savings	Baseline	31%	16%

¹ To meet 1.0 average footcandle, 3.0:1 Avg/Min uniformity, poles for LED Competitor would need to be spaced 125 foot staggered grid.


**LEDgend meets existing maintained light levels with 31% energy savings over existing HPS Cobraheads.**

**As compared to a typical LED competitor, the LEDgend provides 25% more light on the roadway while consuming 22% less energy**

## DIMMING CAPABILITIES


### Bi-Level Dimming

Many municipalities are looking for the ability to reduce their energy loads even further by dimming luminaires during off-peak hours. The LEDgend luminaire is available with an integral control system that automatically reduces power. Light output is set at 100% until the midpoint of the night, then reduces to 50% light output for up to five hours. Since LEDs deliver more efficacy (lpw) when driven at lower power, this translates to an energy savings of up to 55% during the dimmed state. The integrated intelligence of the control device daily monitors on/off cycles and adjusts for current sunset/ sunrise time so that the luminaire is always synchronized with the environment. And all of this without the need for an expensive external control system... Perfect for seamlessly enabling this great energy reduction on existing installations.

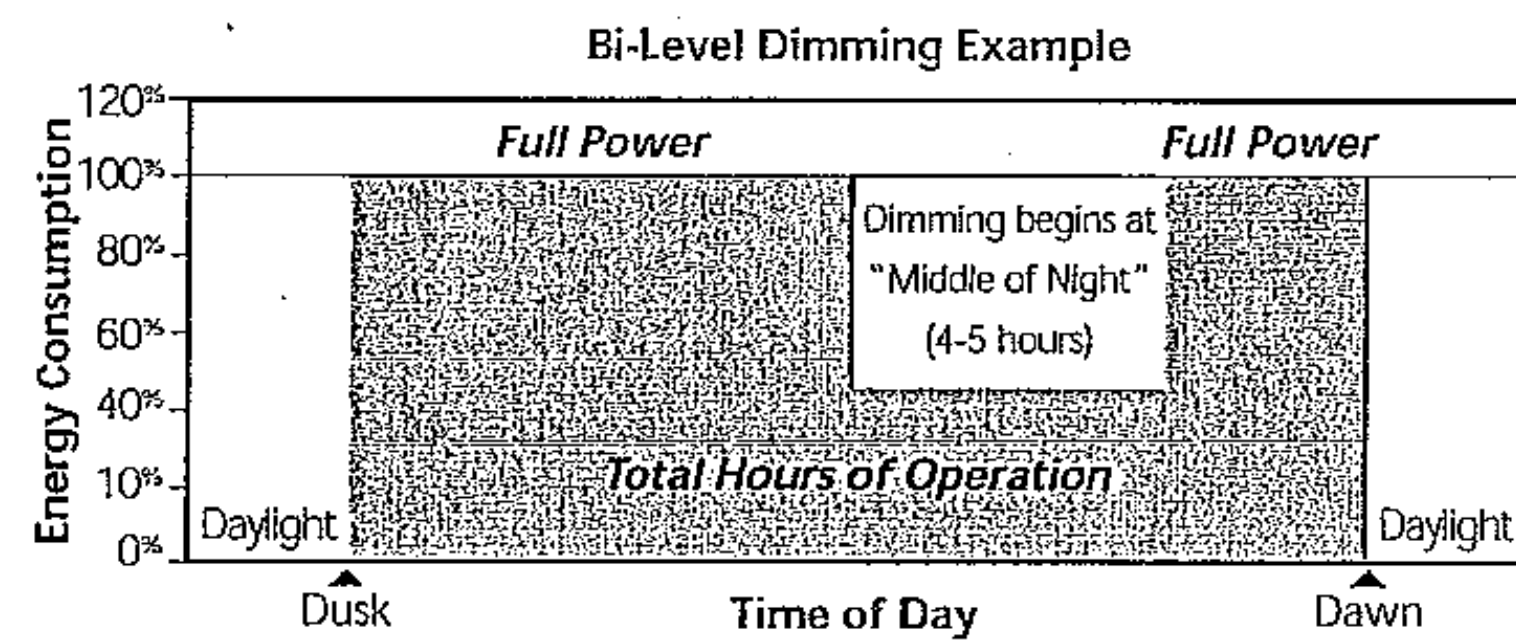

### Constant Lumen Output

Another innovative option available with the LEDgend is constant lumen output (CLO). This option provides constant lumen output for the entire life of the luminaire. The embedded intelligence compensates for the natural lumen depreciation of the LED. Since most street lighting is designed to maintain a specific level of lighting, this avoids the traditional waste of light and energy that would normally occur for any lighting installation. The luminaire is initially driven at roughly 60% of power, and then power is gradually increased as the system ages. Over the lifetime of the installation, this can provide a 15% overall energy savings. This allows LEDgend to add a whole new level of incremental energy savings while ensuring that light levels are maintained for the entire life of the installation. And most importantly, it accelerates the early years of energy savings so critical to ensuring a good economic payback.

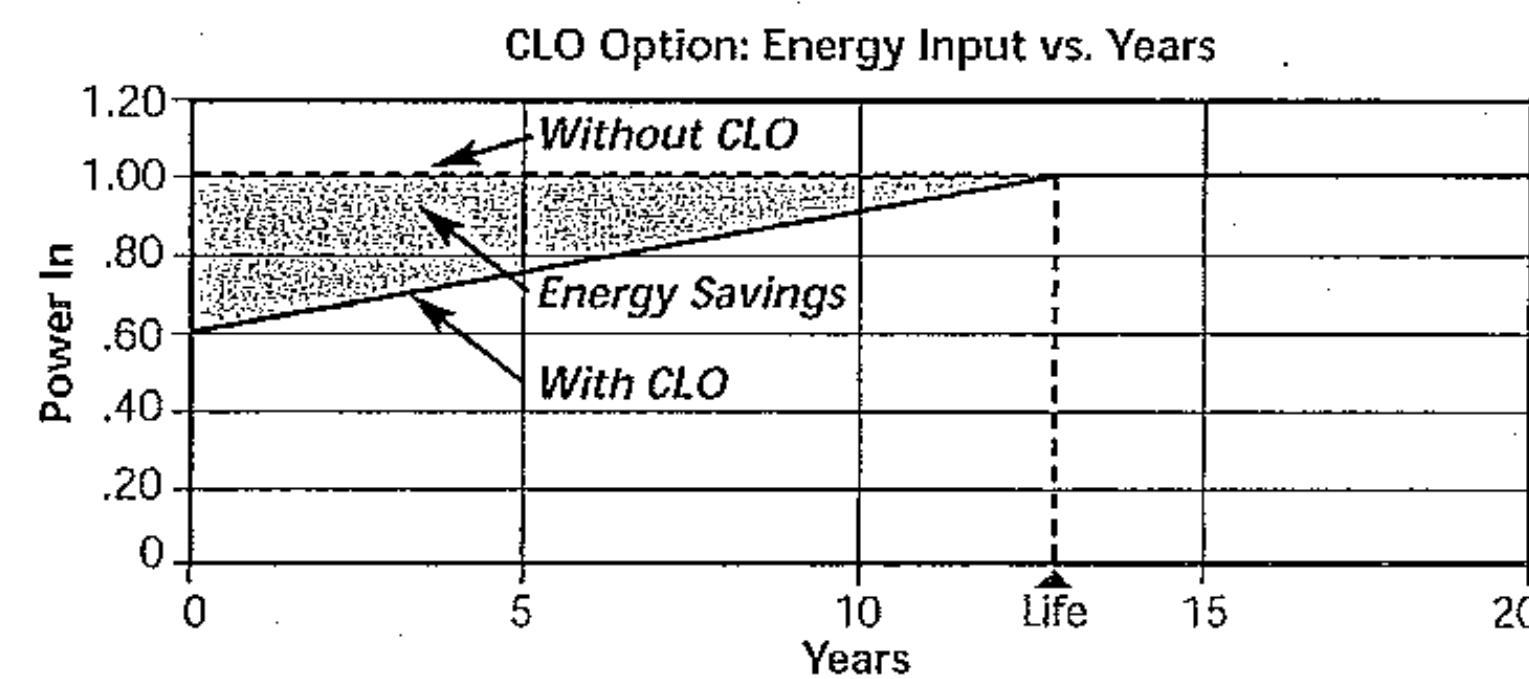


## SURGE PROTECTION

Most electronic ballasts or drivers cannot survive long-term outdoor transient levels without added surge protection. State of the art Holophane-designed surge protection extends LEDgend luminaire life by protecting electronic devices from electrical disturbances, including nearby lightning strikes. This protection extends to all downstream electronics including LED drivers, photo controls, and relays. Instead of replacing an expensive light engine or driver, all that may be needed is a replacement surge device. As a result, LEDgend luminaires offer a higher level of protection and a more economical replacement solution if and when mother nature strikes.

## DUAL DRIVER

A major benefit of LED technology is long life. The benefit to our customers is reduced maintenance costs. The optional dual driver system available with LEDgend luminaires increases driver life to approximately 200,000 hours (350mA only). The dual driver system incorporates an electronic transfer switch that senses current on the main driver and will switch to the auxiliary driver when a failure occurs. The auxiliary driver does not energize until the main driver fails and includes a built in time delay that eliminates nuisance switching due to power fluctuations. Luminaires incorporating the dual driver system eliminate a trip to the field to replace a failed driver, which reduces travel and labor expenses. Fewer inventoried replacement parts and less equipment rental and labor coordination translate into significant maintenance savings that free capital for today's more pressing city service demands.

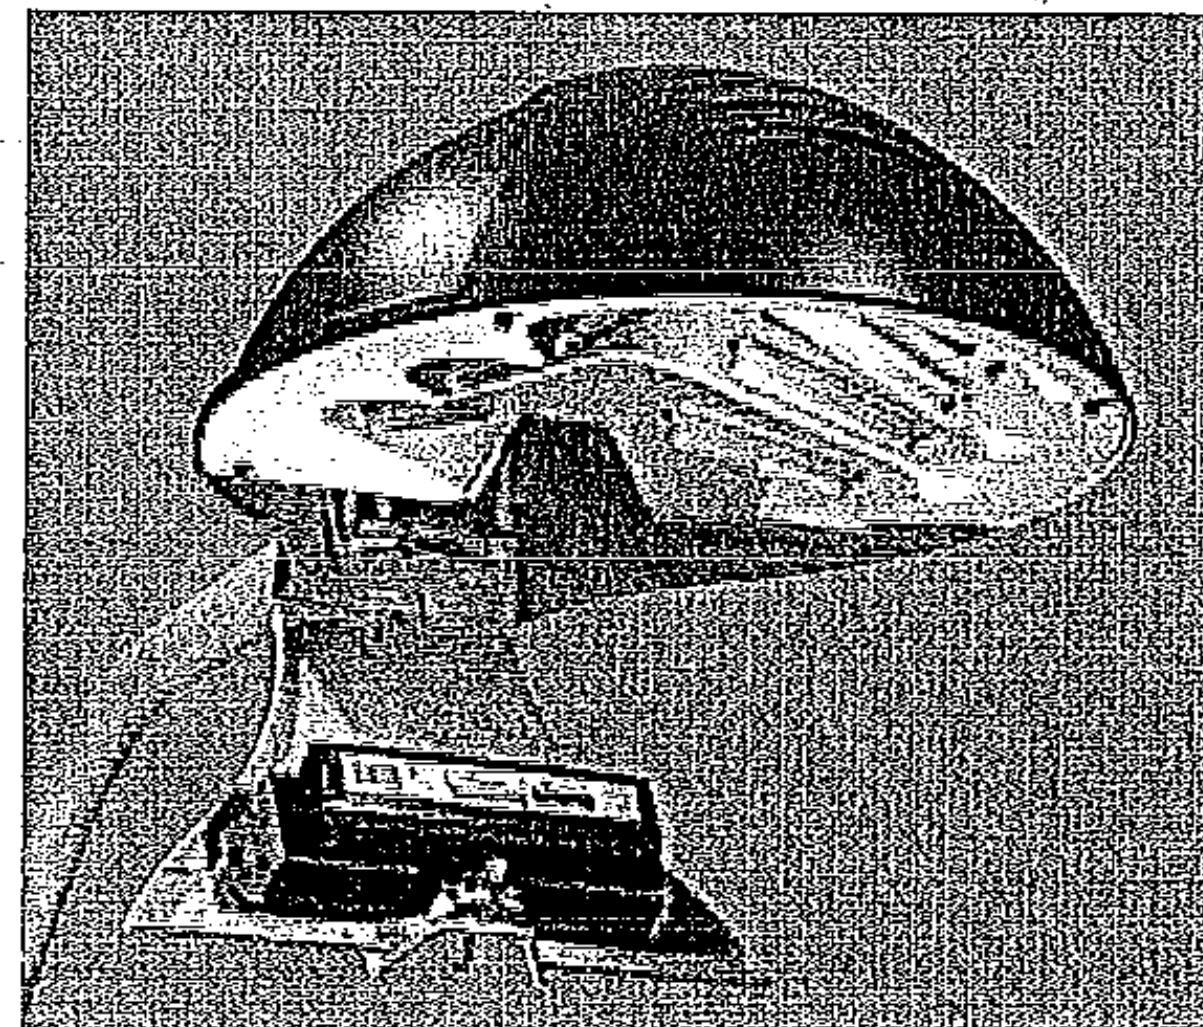

Intelligent lighting systems utilizing Acuity Brands ROAM® technology provide system monitoring, control and dimming interface capability. Holophane LEDgend luminaires incorporate this type of intelligence and offer various alternatives to meet specific dimming needs. For more information on ROAM controls visit [www.roamcontrols.com](http://www.roamcontrols.com)



**HOLOPHANE**  
LEADER IN LIGHTING SOLUTIONS

An Acuity Brands Company

**Acuity Brands Lighting, Inc.**

Holophane Headquarters: 3825 Columbus Road  
Granville, OH 43023

Holophane Canada, Inc.: 9040 Leslie Street,  
Suite 200, Richmond Hill, ON L4B 3M4

Holophane Europe Limited: Bond Ave.  
Milton Keynes MK1 1JG, England

Holophane S.A. de C.V.: Apartado Postal No.  
986, Nahuajpan de Juarez, 53000 Edo. de Mexico

Contact your local Holophane factory sales representative for application assistance and computer-aided design and cost studies. For information on other Holophane products and systems, call the Inside Sales Service Department at 866-759-1577. In Canada call 905-707-5830 or fax 905-707-5605.

**Limited Warranty and Limitation of Liability**  
Refer to the Holophane limited material warranty and limitation of liability on this product which are published in the Terms and Conditions section of the current Indoor Buyer's Guide (HL-2140) and is available from your local Holophane sales representative.

Visit our web site at [www.holophane.com](http://www.holophane.com)

Luminaires may utilize fluorescent or high intensity discharge sources that contain small amounts of mercury. New disposal labeling for these lamps includes the mercury identifier shown on the left to indicate that the lamp contains mercury and should be disposed of in accordance with local requirements.



Information sources regarding lamp recycling and disposal are included on the packaging of most mercury-containing lamps and also can be located at [www.lamprecycle.org](http://www.lamprecycle.org).

Product specifications may change without notice. Please contact your local Holophane factory sales representative for the latest product information.



Buying products with the FSC label supports the growth of responsible forest management worldwide. The eco savings in the production of this brochure:

- 1 tree preserved for the future
- 2 lbs waterborne waste not created
- 358 gallons wastewater flow saved
- 40 lbs solid waste not generated
- 78 lbs net greenhouse gases prevented
- 597,360 BTUs energy not consumed



**APPROVED**

Valmont Industries, Inc.  
West Highway 275  
P.O. Box 358  
Valley, Nebraska 68064-0358 USA  
(402) 359-2201

A Light & Traffic Structure Proposal  
for  
VERMONT D.O.T.  
WATERBURY  
PROJECT NO. NHG SGNL(43)

Valmont Order No.: 235821

Prepared By:  
Barry N. Sladek, P.E.  
Senior Professional Engineer  
May 12, 2014  
  
Revision B



Proprietary Information  
These documents, drawings and/or calculations and all information related to them are the exclusive property and the proprietary information of Valmont Industries, Inc. and are furnished solely upon the conditions that they will be retained in strictest confidence and shall not be duplicated, used or disclosed in whole or in part for any purpose, in any way, without the prior written permission of Valmont Industries, Inc.



Valmont Industries, Inc.  
West Highway 275  
P.O. Box 358  
Valley, Nebraska 68064-0358 USA  
(402) 359-2201

Table Of Contents

34' & 31' MAST ARMS W/12' LUM ARM..... 1  
42' MAST ARM & 16' LUM ARM .....25

Proprietary Information

These documents, drawings and/or calculations and all information related to them are the exclusive property and the proprietary information of Valmont Industries, Inc. and are furnished solely upon the conditions that they will be retained in strictest confidence and shall not be duplicated, used or disclosed in whole or in part for any purpose, in any way, without the prior written permission of Valmont Industries, Inc.

IN ACCORDANCE WITH AASHTO-2009 RQMTS. (FINAL DEFLECTED POSITION)  
BY BNS 5/12/2014 VERSION Fuse 1.10.0.540 32-bit

SUBJECT: VERMONT, 34' & 31' MAST ARMS W/12' LUM ARM

FOLDER: VTTRAF FILE: 3431L12

ELEVATION OF FOUNDATION ABOVE SURROUNDING TERRAIN = 0.0 (FT)  
STEPS INCLUDED ? NO

RECURRENCE INTERVAL = 50 SPECIAL FATIGUE WIND SPEEDS  
FATIGUE CATEGORY = 2

TRUCK GUST: YES GALLOPING : NO TRUCK GUST = 45 MPH  
WIND VELOCITY = 90 MPH CRITERIA: AASHTO-2009  
AASHTO ICE INCLUDED ? YES

DESIGN SUMMARY  
POLE

=====

HEIGHT (FT)	POLE SHAFT WEIGHT (LBS)	GROUND LINE DIAMETER (IN)	TOP DIAMETER (IN)
27.00	775	13.00	9.22

SECTION CHARACTERISTICS SECTION 1  
SHAPE ROUND  
BASE DIAMETER (IN) 13.00  
TOP DIAMETER (IN) 9.22  
THICKNESS (IN) 0.23910  
LENGTH (FT) 27.00  
WEIGHT (LBS) 775  
TAPER (IN/FT) 0.1400  
YIELD STRENGTH (KSI) 55  
MATERIAL S105 - 55  
BASE WELD FATIGUE CATEGORY = E ( FULL-PEN )

BASE PLATE ( SQUARE )  
MATERIAL = S70 - 36 ksi  
WIDTH = 20.00 IN  
THICKNESS = 1.500 IN  
YIELD STRENGTH = 36 KSI

ANCHOR BOLTS

=====

MATERIAL = S100 - 55 ksi  
BOLT DIAMETER = 1.50 IN  
BOLT CIRCLE = 19.00 IN  
QUANTITY = 4  
YIELD STRENGTH = 55 KSI

SUBJECT: VERMONT, 34' & 31' MAST ARMS W/12' LUM ARM

FOLDER: VTTRAF FILE: 3431L12

DESIGN SUMMARY (CONTINUED)  
 ARMS

SIGNAL AND SIGN ARM 1		SIGNAL AND SIGN ARM 2	
SPAN LENGTH	= 34.00 FT	SPAN LENGTH	= 31.00 FT
TAPER	= 0.14 IN/FT	TAPER	= 0.14 IN/FT
BASE SECTION		BASE SECTION	
BASE O.D.	= 11.50 IN	BASE O.D.	= 11.00 IN
THICKNESS	= 0.1793 IN	THICKNESS	= 0.1793 IN
LENGTH	= 34.00 FT	LENGTH	= 31.00 FT
YIELD STR.	= 55 KSI	YIELD STR.	= 55 KSI

BASE WELD FATIGUE CATEGORY = Full-Pen / E

***** SIMPLEX DIMENSIONS *****  
 ARM 1 ARM 2

CONNECTION BOLT DATA

NUMBER	=	4	4
BOLT DIAMETER (IN)	=	1.250	1.250
ASTM SPECIFICATION	=	A325	A325
HORIZONTAL SPACING (IN)	=	14.50	14.50
VERTICAL SPACING (IN)	=	14.50	14.50

ATTACHMENT PLATE DATA

HORIZONTAL WIDTH (IN)	=	17.75	17.75
VERTICAL WIDTH (IN)	=	17.75	17.75
THICKNESS (IN)	=	1.500	1.500
YIELD STRENGTH (KSI)	=	36	36
GUSSET THICKNESS (IN)			
- VERTICAL	=	0.250	0.250
- HORIZONTAL	=	0.250	0.250

ATTACHMENT TYPE

ARM 1: SIMPLEX - RING-STIFFENED BOX, TAPPED, BASE WELD TYPE = Full-Pen  
 ARM 2: SIMPLEX - RING-STIFFENED BOX, TAPPED, BASE WELD TYPE = Full-Pen

ANALYSIS OF VALMONT INDUSTRIES LIGHTING STRUCTURE  
IN ACCORDANCE WITH AASHTO-2009 RQMTS. (FINAL DEFLECTED POSITION)  
BY BNS 5/12/2014 VERSION Fuse 1.10.0.540 32-bit

SUBJECT: VERMONT, 34' & 31' MAST ARMS W/12' LUM ARM

FOLDER: VTTRAF FILE: 3431L12

LUMINAIRE ARM 1

=====

STYLE DS70-12

SPAN LENGTH = 12.00 FT

UPPER (OR ONLY) MEMBER

SHAPE = Round

ROUNDED BASE O.D. = 2.38 IN

OUTER END O.D. = 2.38 IN

THICKNESS = 0.1540 IN

UNBENT LENGTH = 12.62 FT

LOWER MEMBER

SHAPE = Round

ROUNDED BASE O.D. = 2.38 IN

OUTER END O.D. = 2.38 IN

THICKNESS = 0.1540 IN

UNBENT LENGTH = 12.62 FT

ANALYSIS OF VALMONT INDUSTRIES LIGHTING STRUCTURE  
 IN ACCORDANCE WITH AASHTO-2009 RQMTS. (FINAL DEFLECTED POSITION)  
 BY BNS 5/12/2014 VERSION Fuse 1.10.0.540 32-bit

SUBJECT: VERMONT, 34' & 31' MAST ARMS W/12' LUM ARM

FOLDER: VTTRAF FILE: 3431L12

ELEVATION OF FOUNDATION ABOVE SURROUNDING TERRAIN = 0.0 (FT)  
 STEPS INCLUDED ? NO

RECURRENCE INTERVAL = 50 SPECIAL FATIGUE WIND SPEEDS  
 FATIGUE CATEGORY = 2

TRUCK GUST: YES GALLOPING : NO TRUCK GUST = 45 MPH  
 WIND VELOCITY = 90 MPH CRITERIA: AASHTO-2009  
 AASHTO ICE INCLUDED ? YES

DESCRIPTION OF EPA LOADING *

POSITION OF LOAD	MOUNTING HEIGHT** (FT)	CENTROID HEIGHT** (FT)	DISTANCE TO CENT. FROM POLE (FT)	WEIGHT (LBS)	EFFECTIVE PROJECTED AREA SQ. (FT)
MAST ARM 1	20.00	27.00	27.00	50	2.00
MAST ARM 2	20.00	27.00	24.00	40	2.00

DESCRIPTION OF SIGNAL LOADING *

POSITION OF SIGNAL	MOUNTING HEIGHT** (FT)	CENTROID HEIGHT** (FT)	DISTANCE TO CENT. FROM POLE (FT)	SIGNAL WEIGHT (LBS)	SIGNAL VERTICAL PLANE (FT^2)	PROJECTED HORIZONTAL PLANE (FT^2)
ARM 1	20.00	20.00	34.00	96	13.72	3.60
ARM 1	20.00	20.00	34.00	70	8.67	1.80
ARM 1	20.00	20.00	20.00	70	8.67	1.80
ARM 2	20.00	20.00	31.00	96	13.72	3.60
ARM 2	20.00	20.00	31.00	70	8.67	1.80
ARM 2	20.00	20.00	17.00	70	8.67	1.80

DESCRIPTION OF LUMINAIRE *

MOUNTING** HEIGHT	CENTROID** HEIGHT	DISTANCE TO CENT. FROM POLE	WEIGHT	PROJECTED AREA
-------------------	-------------------	-----------------------------	--------	----------------

POSITION	SHAPE	(FT)	(FT)	(FT)	(LBS)	(FT^2)
LUMINAIRE ARM	1 ROUND	26.50	30.00	13.00	55	3.30

* THE VALUES SHOWN IN THIS TABLE MUST NOT BE EXCEEDED WITHOUT CONSULTING VALMONT. ANY SIZES OR OTHER DIMENSIONS NOT PROVIDED BY THE SPECIFYING AGENCY HAVE BEEN ESTIMATED BY VALMONT.

** THESE HEIGHTS ARE ABOVE BOTTOM OF BASE PLATE OR TRANSFORMER BASE.

SUBJECT: VERMONT, 34' & 31' MAST ARMS W/12' LUM ARM

FOLDER: VTTRAF FILE: 3431L12

R E S U L T S S U M M A R Y

MAXIMUM COMBINED STRESS RATIO  
 IN EACH MAJOR COMPONENT  
 =====(GROUPS I, II & III)=====

POLE (AT 20.00 (FT)) = 0.75  
 SIGNAL AND SIGN ARM 1 = 0.56  
 SIGNAL AND SIGN ARM 2 = 0.53  
 LUMINAIRE ARM 1 = 0.45  
 BASE PLATE = 0.73  
 ANCHOR BOLTS = 0.95  
 S/S ARM 1 ATTACH. BOLTS = 0.42  
 S/S ARM 1 ATTACH. PLATE = 0.63  
 S/S ARM 2 ATTACH. BOLTS = 0.36  
 S/S ARM 2 ATTACH. PLATE = 0.56

MAXIMUM FATIGUE STRESS  
 RATIO IN EACH MAJOR COMPONENT  
 =====(GROUP IV)=====

POLE (AT 0.00 FT) = 0.98  
 SIGNAL AND SIGN ARM 1  
 ARM TUBE = 1.00  
 BUILT-UP BOX GUSSET = 0.57  
 SIMPLEX BOLTS = 0.41  
 SIGNAL AND SIGN ARM 2  
 ARM TUBE = 0.95  
 BUILT-UP BOX GUSSET = 0.50  
 SIMPLEX BOLTS = 0.36  
 ANCHOR BOLT = 0.63

MAXIMUM REACTIONS APPLIED TO FOUNDATION  
 =====

BENDING MOMENT = 77794 FT-LBS  
 TORSION = 30659 FT-LBS  
 SHEAR FORCE = 2370 LBS  
 AXIAL FORCE = 4387 LBS

MAXIMUM BENDING + AXIAL DEAD WT. STRESS  
 =====

POLE = 16.16 KSI  
 SIGN/SIGNAL ARM 1 = 11.84 KSI  
 SIGN/SIGNAL ARM 2 = 10.85 KSI  
 LUMINAIRE ARM 1 = 6.20 KSI

RESULTANT DEFLECTION OF POLE TOP  
 CAUSED BY DEAD WEIGHT  
 =====

1.08 DEGREES

SUBJECT: VERMONT, 34' & 31' MAST ARMS W/12' LUM ARM

FOLDER: VTTRAF FILE: 3431L12

SIGNAL AND SIGN ARM 1

=====

SHAPE	= Round
SPAN LENGTH	= 34.00 FT
BASE O.D.	= 11.50 IN
TAPER	= 0.14 IN/FT
ATTACH. HT. *	= 20.00 FT
ORIENTATION **	= 0 DEGREES
SLOPE AT BASE	= 0 DEGREES

CENTROID LOCATION

HORIZONTAL	= 15.52 FT
ABOVE ATTACH.	= 0.00 FT

UNBENT LENGTH = 34.00 FT  
MATERIAL-BASE = S105 - 55 ksi  
WEIGHT = 608 LBS  
BASE WELD FATIGUE CATEGORY = Full-Pen / E

ARM 1 SECTIONS

=====

BASE SECTION	
THICKNESS	= 0.1793 IN
LENGTH	= 34.00 FT
YIELD STRENGTH	= 55 KSI

SIGNAL AND SIGN ARM 2

=====

SHAPE	= Round
SPAN LENGTH	= 31.00 FT
BASE O.D.	= 11.00 IN
TAPER	= 0.14 IN/FT
ATTACH. HT. *	= 20.00 FT
ORIENTATION **	= 90 DEGREES
SLOPE AT BASE	= 0 DEGREES

CENTROID LOCATION

HORIZONTAL	= 14.23 FT
ABOVE ATTACH.	= 0.00 FT

UNBENT LENGTH = 31.00 FT  
MATERIAL-BASE = S105 - 55 ksi  
WEIGHT = 537 LBS  
BASE WELD FATIGUE CATEGORY = Full-Pen / E

ARM 2 SECTIONS

=====

BASE SECTION	
THICKNESS	= 0.1793 IN
LENGTH	= 31.00 FT
YIELD STRENGTH	= 55 KSI

- * THIS IS HEIGHT OF ATTACHMENT TO POLE ABOVE BOTTOM OF BASE PLATE OR TRANSFORMER BASE. SEE *** BELOW.
- ** ARM ORIENTATIONS ARE ANGLES FROM +X AXIS IN X-Y PLANE. X AND Y AXIES ARE PERPENDICULAR/PARALLEL TO SIDES OF POLE BASE PLATE. SEE *** BELOW.
- *** IF ARM IS ATTACHED WITH A CLAMP, HEIGHT AND ORIENTATION MUST NOT BE CHANGED FROM VALUES SHOWN ABOVE WITHOUT CONSULTING VALMONT.

ANALYSIS OF VALMONT INDUSTRIES LIGHTING STRUCTURE  
IN ACCORDANCE WITH AASHTO-2009 RQMTS. (FINAL DEFLECTED POSITION)  
BY BNS 5/12/2014 VERSION Fuse 1.10.0.540 32-bit

SUBJECT: VERMONT, 34' & 31' MAST ARMS W/12' LUM ARM

FOLDER: VTTRAF FILE: 3431L12

LUMINAIRE ARM 1 ( DS70-12 )

=====

SPAN LENGTH	=	12.00 FT
ORIENTATION **	=	0 DEGREES
TOP MEMBER		
SHAPE	=	ROUND
BASE O.D.	=	2.38 IN
OUTER END O.D.	=	2.38 IN
THICKNESS	=	0.1540 IN
ATTACH. HT. *	=	26.50 FT
RISE	=	3.50 FT
SLOPE AT BASE	=	26.0 DEGREES
CENTROID LOCATION		
HORIZONTAL	=	5.88 FT
VERTICAL	=	2.24 FT
SPAN TO JOINT	=	8.44 FT
YIELD STRENGTH	=	36 KSI
UNBENT LENGTH	=	12.62 FT
UNBENT LENGTH TO JOINT	=	8.44 FT

BOTTOM MEMBER

SHAPE	=	ROUND
DIAMETER	=	2.38 IN
THICKNESS	=	0.1540 IN
ATTACH. HT. *	=	24.25 FT
CENTROID LOCATION		
HORIZONTAL	=	4.00 FT
VERTICAL	=	3.73 FT
YIELD STRENGTH	=	36 KSI
UNBENT LENGTH	=	9.98 FT
MATERIAL	=	S109 - 36 ksi
WEIGHT	=	84 LBS

* THESE HEIGHTS ARE ABOVE BOTTOM OF BASE PLATE OR  
TRANSFORMER BASE.

+ ELLIPTICAL CROSS SECTION; FIRST DIAMETER IS HORIZONTAL.

** ARM ORIENTATIONS ARE ANGLES FROM +X AXIS IN X-Y PLANE.  
X AND Y AXES ARE PERPENDICULAR/PARALLEL TO SIDES OF  
POLE BASE PLATE. SEE *** BELOW.

*** IF ARM IS ATTACHED WITH A CLAMP, HEIGHT AND  
ORIENTATION MUST NOT BE CHANGED FROM VALUES SHOWN  
ABOVE WITHOUT CONSULTING VALMONT.

ANALYSIS OF VALMONT INDUSTRIES LIGHTING STRUCTURE  
 IN ACCORDANCE WITH AASHTO-2009 RQMTS. (FINAL DEFLECTED POSITION)  
 BY BNS 5/12/2014 VERSION Fuse 1.10.0.540 32-bit

SUBJECT: VERMONT, 34' & 31' MAST ARMS W/12' LUM ARM

FOLDER: VTTRAF FILE: 3431L12

FORCES AND MOMENTS WITH WIND ACTING PERPENDICULAR TO EACH ARM

ARM TYPE	ARM NO.	ANALYSIS LOCATION	GROUP LOAD NO.	FORCES (LBS)			MOMENTS (FT-LBS)		
				AXIAL	FY	FZ	TORSION	MY	MZ
SIGNAL 1	1	BASE	1	20	15	891	6	17778	296
SIGNAL 1	1	BASE	2	68	1164	845	330	16577	30249
SIGNAL 1	1	BASE	3	93	824	1588	199	35295	19366
SIGNAL 2	2	BASE	1	14	17	810	6	14886	315
SIGNAL 2	2	BASE	2	53	1140	763	328	13770	26975
SIGNAL 2	2	BASE	3	70	790	1476	199	30247	17100
LUMIN. 1	1	TOP BASE	1	571	2	9	0	41	12
LUMIN. 1	1	TOP BASE	2	563	101	9	0	43	670
LUMIN. 1	1	TOP BASE	3	935	79	19	0	77	561
LUMIN. 1	1	BOT BASE	1	623	1	4	1	30	9
LUMIN. 1	1	BOT BASE	2	606	62	4	53	32	517
LUMIN. 1	1	BOT BASE	3	1008	32	11	50	60	405

ANALYSIS OF VALMONT INDUSTRIES LIGHTING STRUCTURE  
 IN ACCORDANCE WITH AASHTO-2009 RQMTS. (FINAL DEFLECTED POSITION)  
 BY BNS 5/12/2014 VERSION Fuse 1.10.0.540 32-bit

SUBJECT: VERMONT, 34' & 31' MAST ARMS W/12' LUM ARM

FOLDER: VTTRAF FILE: 3431L12

STRESSES WITH WIND ACTING PERPENDICULAR TO EACH ARM

ANAL. LOCATION			GROUP LOAD NO.	COMB. STR. RATIO	APPLIED STRESS (KSI)			ALLOW. STRESS (KSI)		
ARM TYPE	ARM NO.	SITE			AXIAL	BEND.	SHEAR	AXIAL	BEND.	SHEAR
SIG	1	BASE	1	0.33	0.00	11.84	0.28	33.00	36.30	18.15
SIG	1	BASE	2	0.48	0.01	22.97	0.56	33.00	48.28	24.14
SIG	1	BASE	3	0.56	0.01	26.80	0.63	33.00	48.28	24.14
SIG	2	BASE	1	0.30	0.00	10.85	0.27	33.00	36.30	18.15
SIG	2	BASE	2	0.46	0.01	22.07	0.57	33.00	48.28	24.14
SIG	2	BASE	3	0.53	0.01	25.32	0.62	33.00	48.28	24.14
LUM	1	TOP	1	0.06	0.53	0.86	0.02	21.60	23.76	11.88
LUM	1	TOP	2	0.45	0.52	13.44	0.19	21.60	31.60	15.80
LUM	1	TOP	3	0.40	0.87	11.34	0.15	21.60	31.60	15.80
LUM	1	BOT	1	0.05	0.58	0.63	0.02	21.60	23.76	11.88
LUM	1	BOT	2	0.36	0.56	10.36	0.65	21.60	31.60	15.80
LUM	1	BOT	3	0.30	0.94	8.20	0.56	21.60	31.60	15.80

ANALYSIS OF VALMONT INDUSTRIES LIGHTING STRUCTURE  
IN ACCORDANCE WITH AASHTO-2009 RQMTS. (FINAL DEFLECTED POSITION)  
BY BNS 5/12/2014 VERSION Fuse 1.10.0.540 32-bit

SUBJECT: VERMONT, 34' & 31' MAST ARMS W/12' LUM ARM

FOLDER: VTTRAF FILE: 3431L12

GROUP IV FATIGUE ANALYSIS OF ARMS:

---

ANAL. LOCATION		LOAD CASE	BENDING	SHEAR
ARM	ARM		MOMENT	FORCE
TYPE NO.	SITE		(FT-LBS)	(LBS)
SIG 1	BASE	NATURAL WIND GUST	6725	282
SIG 1	BASE	TRUCK-INDUCED GUST	3382	160
SIG 2	BASE	NATURAL WIND GUST	5886	268
SIG 2	BASE	TRUCK-INDUCED GUST	3033	156

ANALYSIS OF VALMONT INDUSTRIES LIGHTING STRUCTURE  
 IN ACCORDANCE WITH AASHTO-2009 RQMTS. (FINAL DEFLECTED POSITION)  
 BY BNS 5/12/2014 VERSION Fuse 1.10.0.540 32-bit

SUBJECT: VERMONT, 34' & 31' MAST ARMS W/12' LUM ARM

FOLDER: VTTRAF FILE: 3431L12

GROUP IV FATIGUE ANALYSIS OF ARMS:

ANAL. LOCATION		LOAD CASE =====	STRESS RATIO	STRESS CAT.	BENDING STRESS KSI	SHEAR STRESS KSI
ARM TYPE	ARM NO. SITE					
SIG	1	NATURAL WIND GUST	1.00	E	4.48	0.11
SIG	1	TRUCK-INDUCED GUST	0.50	E	2.25	0.05
SIG	2	NATURAL WIND GUST	0.95	E	4.29	0.11
SIG	2	TRUCK-INDUCED GUST	0.49	E	2.21	0.05

ANALYSIS OF VALMONT INDUSTRIES LIGHTING STRUCTURE  
 IN ACCORDANCE WITH AASHTO-2009 RQMTS. (FINAL DEFLECTED POSITION)  
 BY BNS 5/12/2014 VERSION Fuse 1.10.0.540 32-bit

SUBJECT: VERMONT, 34' & 31' MAST ARMS W/12' LUM ARM

FOLDER: VTTRAF FILE: 3431L12

THIS PAGE PROVIDES THE PERTINENT INFORMATION CONCERNING THE ANALYSIS  
 OF THE ARM-TO-POLE ATTACHMENT COMPONENTS OF THE SIGNAL AND SIGN ARMS.

***** INPUT DATA *****  
 ARM 1 ARM 2

CONNECTION BOLT DATA

```

=====
NUMBER                =      4      4
BOLT DIAMETER (IN)    =    1.250  1.250
ASTM SPECIFICATION    =     A325  A325
HORIZONTAL SPACING (IN) =    14.50  14.50
VERTICAL SPACING (IN) =    14.50  14.50
  
```

ATTACHMENT PLATE DATA

```

=====
HORIZONTAL WIDTH (IN) =    17.75  17.75
VERTICAL WIDTH (IN)  =    17.75  17.75
THICKNESS (IN)       =     1.500  1.500
YIELD STRENGTH (KSI) =      36    36
GUSSET THICKNESS (IN)
- VERTICAL            =     0.250  0.250
- HORIZONTAL          =     0.250  0.250
  
```

ATTACHMENT TYPE

```

=====
ARM 1:  SIMPLEX - RING-STIFFENED BOX, TAPPED,  BASE WELD TYPE = Full-Pen
ARM 2:  SIMPLEX - RING-STIFFENED BOX, TAPPED,  BASE WELD TYPE = Full-Pen
  
```

***** RESULTS *****

ANALYSIS OF SIGNAL/SIGN ARM SIMPLEX BOLTS

ARM	MAX. BOLT CSR	GROUP LOAD NO.	TENSION LBS	APPLIED STRESS KSI	ALLOWABLE STRESS KSI
1	0.42	3	22642	18.45	44.22
2	0.36	3	19609	15.98	44.22

ANALYSIS OF SIGNAL/SIGN ARM SIMPLEX PLATES

ARM	MAX. PLATE CSR	GROUP LOAD NO.	APPLIED STRESS KSI	ALLOWABLE STRESS KSI	ANGLE OF FAILURE LINE DEGREES	LENGTH OF BEND LINE IN
1	0.63	3	19.96	31.60	45	13.56
2	0.56	3	17.60	31.60	45	14.06

ANALYSIS OF VALMONT INDUSTRIES LIGHTING STRUCTURE  
 IN ACCORDANCE WITH AASHTO-2009 RQMTS. (FINAL DEFLECTED POSITION)  
 BY BNS 5/12/2014 VERSION Fuse 1.10.0.540 32-bit

SUBJECT: VERMONT, 34' & 31' MAST ARMS W/12' LUM ARM

FOLDER: VTTRAF FILE: 3431L12

GROUP IV FATIGUE ANALYSIS OF SIGNAL AND SIGN / POLE CONNECTION: ARM

COMPONENT	LOAD	STRESS RATIO	STRESS CAT.	STRESS (KSI)
BUILT-UP BOX GUSSET	NATURAL WIND GUST	0.57	E'	1.47
	TRUCK-INDUCED GUST	0.21	E'	0.55
POLE CROSS SECTION				
	TRUCK-INDUCED GUST	0.48	E	2.18
SIMPLEX BOLT	NATURAL WIND GUST	0.41	D	2.88
	TRUCK-INDUCED GUST	0.21	D	1.44
BUILT-UP BOX GUSSET	NATURAL WIND GUST	0.50	E'	1.29
	TRUCK-INDUCED GUST	0.19	E'	0.50
POLE CROSS SECTION				
	TRUCK-INDUCED GUST	0.43	E	1.96
SIMPLEX BOLT	NATURAL WIND GUST	0.36	D	2.52
	TRUCK-INDUCED GUST	0.19	D	1.30

ANALYSIS OF VALMONT INDUSTRIES LIGHTING STRUCTURE  
 IN ACCORDANCE WITH AASHTO-2009 RQMTS. (FINAL DEFLECTED POSITION)  
 BY BNS 5/12/2014 VERSION Fuse 1.10.0.540 32-bit

SUBJECT: VERMONT, 34' & 31' MAST ARMS W/12' LUM ARM

FOLDER: VTTRAF FILE: 3431L12

POLE PROPERTIES

HEIGHT (FT)	DIAMETER (IN)	WALL THK. (IN)	ROUNDNESS RATIO %	D/T	MOMENTS OF INERTIA (IN^4)	SECTION MODULUS (IN^3)	AREA (IN^2)
27.00	9.220	0.2391	100.00	38.56	67.93	15.13	6.74
26.50	9.290	0.2391	100.00	38.85	69.53	15.36	6.80
24.25	9.605	0.2391	100.00	40.17	77.04	16.45	7.03
22.00	9.920	0.2391	100.00	41.49	85.08	17.58	7.27
20.00	10.200	0.2391	100.00	42.66	92.68	18.61	7.48
18.50	10.410	0.2391	100.00	43.54	98.66	19.40	7.64
17.00	10.620	0.2391	100.00	44.42	104.90	20.21	7.80
14.50	10.970	0.2391	100.00	45.88	115.87	21.60	8.06
12.00	11.320	0.2391	100.00	47.34	127.58	23.03	8.32
9.50	11.670	0.2391	100.00	48.81	140.06	24.50	8.58
7.00	12.020	0.2391	100.00	50.27	153.32	26.03	8.85
4.50	12.370	0.2391	100.00	51.74	167.39	27.60	9.11
2.00	12.720	0.2391	100.00	53.20	182.30	29.21	9.37
0.00	13.000	0.2391	100.00	54.37	194.85	30.54	9.58

ANALYSIS OF VALMONT INDUSTRIES LIGHTING STRUCTURE  
 IN ACCORDANCE WITH AASHTO-2009 RQMTS. (FINAL DEFLECTED POSITION)  
 BY BNS 5/12/2014 VERSION Fuse 1.10.0.540 32-bit

SUBJECT: VERMONT, 34' & 31' MAST ARMS W/12' LUM ARM

FOLDER: VTTRAF FILE: 3431L12

ANALYSIS OF POLE: FORCES AND MOMENTS

SECTION GROUP		FORCES (LBS)			MOMENTS (FT-LBS)			WIND
HEIGHT*	LOAD	=====			=====			DIRECT**
(FT)	NO.	FX	FY	FZ	MX	MY	MZ	(DEGREES)
26.50	1	546	2	-157	-3	-41	11	0
26.50	2	538	109	-154	-189	-42	643	90
26.50	3	893	88	-265	-158	-77	539	90
20.00	1	40	32	2013	-15266	19345	0	0
20.00	2	122	2265	1930	-16248	18147	30657	90
20.00	3	175	1508	3526	-32496	37946	19018	90
0.00	1	2	2	2612	-15588	19753	0	0
0.00	2	5	2376	2612	-62830	19102	30658	90
0.00	3	8	1592	4380	-63629	39496	19018	90

* THESE HEIGHTS ARE ABOVE THE POLE BASE PLATE.

** THESE ARE DIRECTIONS TOWARD WHICH THE WIND IS FLOWING.  
 THEY ARE ANGLES FROM THE +X AXIS IN THE X-Y PLANE

ANALYSIS OF VALMONT INDUSTRIES LIGHTING STRUCTURE  
 IN ACCORDANCE WITH AASHTO-2009 RQMTS. (FINAL DEFLECTED POSITION)  
 BY BNS 5/12/2014 VERSION Fuse 1.10.0.540 32-bit

SUBJECT: VERMONT, 34' & 31' MAST ARMS W/12' LUM ARM

FOLDER: VTTRAF FILE: 3431L12

ANALYSIS OF POLE: STRESSES

SECTION HEIGHT* (FT)	GROUP LOAD NO.	COMB. STR. RATIO	APPLIED STRESS (KSI)			ALLOW. STRESS (KSI)		
			AXIAL	BEND.	SHEAR	AXIAL	BEND	SHEAR
26.50	1	0.00	0.02	0.03	0.17	33.00	36.30	18.15
26.50	2	0.00	0.02	0.15	0.41	33.00	48.28	24.14
26.50	3	0.00	0.04	0.14	0.47	33.00	48.28	24.14
20.00	1	0.45	0.27	15.89	0.01	33.00	36.30	18.15
20.00	2	0.52	0.26	15.71	10.49	33.00	48.28	24.14
20.00	3	0.75	0.47	32.20	6.54	33.00	48.28	24.14
0.00	1	0.28	0.27	9.89	0.00	33.00	36.30	18.15
0.00	2	0.62	0.27	25.79	6.52	33.00	48.28	24.14
0.00	3	0.65	0.46	29.42	4.07	33.00	48.28	24.14

* THESE HEIGHTS ARE ABOVE THE POLE BASE PLATE.

ANALYSIS OF VALMONT INDUSTRIES LIGHTING STRUCTURE  
 IN ACCORDANCE WITH AASHTO-2009 RQMTS. (FINAL DEFLECTED POSITION)  
 BY BNS 5/12/2014 VERSION Fuse 1.10.0.540 32-bit

SUBJECT: VERMONT, 34' & 31' MAST ARMS W/12' LUM ARM

FOLDER: VTTRAF FILE: 3431L12

GROUP IV ANALYSIS OF POLE:

SECTION HEIGHT* (FT)	LOAD CASE	AXIAL (LBS)	BENDING (FT-LBS)
0.0	NATURAL WIND GUST	N/A	11265
0.0	TRUCK GUST	N/A	3458

GROUP IV ANALYSIS OF POLE:

SECTION HEIGHT* (FT)	LOAD CASE	STRESS RATIO	STRESS CATEGORY	STRESS BENDING (KSI)
0.0	NATURAL WIND GUST	0.98	E	4.43
0.0	TRUCK GUST	0.31	E	1.38

* THESE HEIGHTS ARE ABOVE THE POLE BASE PLATE.

ANALYSIS OF VALMONT INDUSTRIES LIGHTING STRUCTURE  
IN ACCORDANCE WITH AASHTO-2009 RQMTS. (FINAL DEFLECTED POSITION)  
BY BNS 5/12/2014 VERSION Fuse 1.10.0.540 32-bit

SUBJECT: VERMONT, 34' & 31' MAST ARMS W/12' LUM ARM

FOLDER: VTTRAF FILE: 3431L12

ARM DEFLECTIONS:

---

ARM TYPE	ARM NO.	GROUP LOAD NO.	LOAD CASE NAME	DEFLECTION (IN)
SIGN	1	4	NATURAL WIND GUST	4.985
SIGN	1	4	TRUCK-INDUCED GUST	1.924
SIGN	2	4	NATURAL WIND GUST	4.042
SIGN	2	4	TRUCK-INDUCED GUST	1.598

ANALYSIS OF VALMONT INDUSTRIES LIGHTING STRUCTURE  
IN ACCORDANCE WITH AASHTO-2009 RQMTS. (FINAL DEFLECTED POSITION)  
BY BNS 5/12/2014 VERSION Fuse 1.10.0.540 32-bit

SUBJECT: VERMONT, 34' & 31' MAST ARMS W/12' LUM ARM

FOLDER: VTTRAF FILE: 3431L12

BASE PLATE ( SQUARE )

=====

WIDTH	=	20.00 IN
THICKNESS	=	1.500 IN
YIELD STRENGTH	=	36 KSI
STATIC COMBINED STRESS RATIO	=	0.73
BASE WELD TYPE	=	FULL-PEN

ANALYSIS OF BASE PLATE

=====

COMBINED STRESS RATIO	=	0.73
GROUP LOAD NUMBER	=	3
CRITICAL WIND DIRECT.*	=	50.00 DEGREES
ALIGNMENT OF THE BEND LINE	=	315.00 DEGREES
BOLT FORCE	=	50166 LBS
BOLT-TO-BEND LINE MOMENT ARM	=	3.00 IN
WIDTH OF BENDING SECTION	=	15.28 IN
APPLIED BENDING STRESS	=	26.26 KSI
ALLOWABLE BENDING STRESS	=	35.91 KSI

ANCHOR BOLTS

=====

QUANTITY	=	4
BOLT DIAMETER	=	1.50 IN
BOLT CIRCLE	=	19.00 IN
INITIAL BOLT ANGLE	=	45.00 DEGREES
BOLT LENGTH	=	54 IN
YIELD STRENGTH	=	55.00 KSI
STATIC COMBINED STRESS RATIO	=	0.95
FATIGUE STRESS RATIO	=	0.63

ANALYSIS OF VALMONT INDUSTRIES LIGHTING STRUCTURE  
 IN ACCORDANCE WITH AASHTO-2009 RQMTS.  
 BY BNS 5/12/2014 VERSION Fuse 1.10.0.540 32-bit

SUBJECT: VERMONT, 34' & 31' MAST ARMS W/12' LUM ARM

FOLDER: VTTRAF FILE: 3431L12

ANALYSIS OF ANCHOR BOLTS

GROUP LOAD NO.	CRITICAL	MAX.	AXIAL FORCE (LBS)	SHEAR FORCE (LBS)	APPLIED		ALLOWABLE		BOLT CONST "K"
	WIND DIRECT* (DEG)	COMB. STRESS RATIO			STRESS (KSI)	SHEAR	STRESS (KSI)	SHEAR	
1	0	0.18	16436	0	11.66	0.00	27.50	16.50	0.60
2	55	0.70	42732	3425	30.31	2.43	36.58	21.95	0.60
3	55	0.95	50092	2159	35.53	1.53	36.58	21.95	0.60

FATIGUE ANALYSIS OF ANCHOR BOLTS

LOAD CASE	STR. RATIO	AXIAL (LBS)
NATURAL WIND GUST	0.63	6203.8
TRUCK-INDUCED GUST	0.16	-1544.1

* THESE ARE DIRECTIONS TOWARD WHICH THE WIND IS FLOWING.

SUBJECT: VERMONT, 34' & 31' MAST ARMS W/12' LUM ARM

FOLDER: VTTRAF FILE: 3431L12

*** POLE DEFLECTION INFORMATION ***

ELEVATION FT	X-DEFL. (IN)	Y-DEFL. (IN)	DEFLECTION ANGLE, DEGREE	
			X-	Y-
=====				
GP. LD. 1 ; WIND ANGLE 0				
27.00	2.79	2.18	0.86	0.66
26.50	2.70	2.11	0.86	0.66
24.25	2.29	1.80	0.85	0.66
22.00	1.89	1.49	0.84	0.66
20.00	1.54	1.22	0.84	0.66
18.50	1.29	1.02	0.75	0.59
17.00	1.07	0.85	0.67	0.53
14.50	0.75	0.60	0.54	0.43
12.00	0.50	0.40	0.43	0.34
9.50	0.30	0.24	0.32	0.25
7.00	0.16	0.13	0.23	0.18
4.50	0.06	0.05	0.14	0.11
2.00	0.01	0.01	0.06	0.05
0.00	0.00	0.00	0.00	0.00
GP. LD. 2 ; WIND ANGLE 90				
27.00	2.61	5.89	0.83	1.58
26.50	2.52	5.72	0.83	1.58
24.25	2.15	4.97	0.82	1.57
22.00	1.78	4.22	0.81	1.57
20.00	1.45	3.56	0.81	1.56
18.50	1.22	3.08	0.72	1.48
17.00	1.01	2.63	0.65	1.39
14.50	0.72	1.94	0.52	1.22
12.00	0.48	1.34	0.41	1.04
9.50	0.29	0.85	0.31	0.84
7.00	0.15	0.47	0.22	0.63
4.50	0.06	0.19	0.14	0.41
2.00	0.01	0.04	0.06	0.18
0.00	0.00	0.00	0.00	0.00
GP. LD. 3 ; WIND ANGLE 90				
27.00	5.48	7.01	1.70	1.98
26.50	5.30	6.80	1.70	1.98
24.25	4.51	5.86	1.69	1.98
22.00	3.73	4.92	1.67	1.97
20.00	3.05	4.09	1.66	1.96
18.50	2.56	3.49	1.49	1.81
17.00	2.12	2.94	1.33	1.66
14.50	1.50	2.13	1.08	1.41
12.00	1.00	1.45	0.85	1.16
9.50	0.61	0.90	0.65	0.91
7.00	0.32	0.49	0.45	0.67

4.50

0.13

0.20

0.28

0.43

ANALYSIS OF VALMONT INDUSTRIES LIGHTING STRUCTURE  
IN ACCORDANCE WITH AASHTO-2009 RQMTS. (FINAL DEFLECTED POSITION)  
BY BNS 5/12/2014 VERSION Fuse 1.10.0.540 32-bit

SUBJECT: VERMONT, 34' & 31' MAST ARMS W/12' LUM ARM

FOLDER: VTTRAF FILE: 3431L12

*** POLE DEFLECTION INFORMATION ***

ELEVATION FT	X-DEFL. (IN)	Y-DEFL. (IN)	DEFLECTION ANGLE, DEGREE	
			X-	Y-
2.00	0.02	0.04	0.12	0.19
0.00	0.00	0.00	0.00	0.00

IN ACCORDANCE WITH AASHTO-2009 RQMTS. (FINAL DEFLECTED POSITION)

BY BNS

5/12/2014

VERSION Fuse 1.10.0.540 32-bit

SUBJECT: VERMONT, 42' MAST ARM & 16' LUM ARM

FOLDER: VTTRAF FILE: 4216

ELEVATION OF FOUNDATION ABOVE SURROUNDING TERRAIN = 0.0 (FT)  
STEPS INCLUDED ? NO

RECURRENCE INTERVAL = 50 SPECIAL FATIGUE WIND SPEEDS  
FATIGUE CATEGORY = 2

TRUCK GUST: YES GALLOPING : NO TRUCK GUST = 45 MPH  
WIND VELOCITY = 90 MPH CRITERIA: AASHTO-2009  
AASHTO ICE INCLUDED ? YES

DESIGN SUMMARY  
POLE

HEIGHT (FT)	POLE SHAFT WEIGHT (LBS)	GROUND LINE DIAMETER (IN)	TOP DIAMETER (IN)
27.00	775	13.00	9.22

SECTION CHARACTERISTICS SECTION 1  
SHAPE ROUND  
BASE DIAMETER (IN) 13.00  
TOP DIAMETER (IN) 9.22  
THICKNESS (IN) 0.23910  
LENGTH (FT) 27.00  
WEIGHT (LBS) 775  
TAPER (IN/FT) 0.1400  
YIELD STRENGTH (KSI) 55  
MATERIAL S105 - 55  
BASE WELD FATIGUE CATEGORY = E( FULL-PEN )

BASE PLATE ( SQUARE )  
MATERIAL = S70 - 36 ksi  
WIDTH = 20.00 IN  
THICKNESS = 1.500 IN  
YIELD STRENGTH = 36 KSI

ANCHOR BOLTS

MATERIAL = S100 - 55 ksi  
BOLT DIAMETER = 1.50 IN  
BOLT CIRCLE = 19.00 IN  
QUANTITY = 4  
YIELD STRENGTH = 55 KSI

SUBJECT: VERMONT, 42' MAST ARM & 16' LUM ARM

FOLDER: VTTRAF FILE: 4216

DESIGN SUMMARY (CONTINUED)  
ARMS

SIGNAL AND SIGN ARM 1

SPAN LENGTH = 42.00 FT  
TAPER = 0.14 IN/FT  
BASE SECTION  
BASE O.D. = 12.50 IN  
THICKNESS = 0.2092 IN  
LENGTH = 42.00 FT  
YIELD STR. = 55 KSI

BASE WELD FATIGUE CATEGORY = Full-Pen / E

***** SIMPLEX DIMENSIONS *****  
ARM 1

CONNECTION BOLT DATA

NUMBER = 4  
BOLT DIAMETER (IN) = 1.250  
ASTM SPECIFICATION = A325  
HORIZONTAL SPACING (IN) = 14.50  
VERTICAL SPACING (IN) = 14.50

ATTACHMENT PLATE DATA

HORIZONTAL WIDTH (IN) = 17.75  
VERTICAL WIDTH (IN) = 17.75  
THICKNESS (IN) = 1.500  
YIELD STRENGTH (KSI) = 36  
GUSSET THICKNESS (IN)  
- VERTICAL = 0.250  
- HORIZONTAL = 0.313

ATTACHMENT TYPE

ARM 1: SIMPLEX - RING-STIFFENED BOX, THRU, BASE WELD TYPE = Full-Pen

ANALYSIS OF VALMONT INDUSTRIES LIGHTING STRUCTURE  
IN ACCORDANCE WITH AASHTO-2009 RQMTS. (FINAL DEFLECTED POSITION)  
BY BNS 5/12/2014 VERSION Fuse 1.10.0.540 32-bit

SUBJECT: VERMONT, 42' MAST ARM & 16' LUM ARM

FOLDER: VTTRAF FILE: 4216

LUMINAIRE ARM 1

=====

STYLE

SPAN LENGTH = 16.00 FT

UPPER (OR ONLY) MEMBER

SHAPE = Round

ROUNDED BASE O.D. = 2.38 IN

OUTER END O.D. = 2.38 IN

THICKNESS = 0.1540 IN

UNBENT LENGTH = 16.48 FT

LOWER MEMBER

SHAPE = Round

ROUNDED BASE O.D. = 2.38 IN

OUTER END O.D. = 2.38 IN

THICKNESS = 0.1540 IN

UNBENT LENGTH = 16.48 FT

ANALYSIS OF VALMONT INDUSTRIES LIGHTING STRUCTURE  
 IN ACCORDANCE WITH AASHTO-2009 RQMTS. (FINAL DEFLECTED POSITION)  
 BY BNS 5/12/2014 VERSION Fuse 1.10.0.540 32-bit

SUBJECT: VERMONT, 42' MAST ARM & 16' LUM ARM

FOLDER: VTTRAF FILE: 4216

ELEVATION OF FOUNDATION ABOVE SURROUNDING TERRAIN = 0.0 (FT)  
 STEPS INCLUDED ? NO

RECURRENCE INTERVAL = 50 SPECIAL FATIGUE WIND SPEEDS  
 FATIGUE CATEGORY = 2

TRUCK GUST: YES GALLOPING : NO TRUCK GUST = 45 MPH  
 WIND VELOCITY = 90 MPH CRITERIA: AASHTO-2009  
 AASHTO ICE INCLUDED ? YES

DESCRIPTION OF EPA LOADING *

POSITION OF LOAD	MOUNTING HEIGHT** (FT)	CENTROID HEIGHT** (FT)	DISTANCE TO CENT. FROM POLE (FT)	WEIGHT (LBS)	EFFECTIVE PROJECTED AREA SQ. (FT)
MAST ARM 1	20.00	27.00	37.00	50	2.00

DESCRIPTION OF SIGNAL LOADING *

POSITION OF SIGNAL	MOUNTING HEIGHT** (FT)	CENTROID HEIGHT** (FT)	DISTANCE TO CENT. FROM POLE (FT)	SIGNAL WEIGHT (LBS)	SIGNAL PROJECTED AREA VERTICAL PLANE (FT^2)	SIGNAL PROJECTED AREA HORIZONTAL PLANE (FT^2)
ARM 1	20.00	20.00	42.00	96	13.72	3.60
ARM 1	20.00	20.00	42.00	70	8.67	1.80
ARM 1	20.00	20.00	32.00	70	8.67	1.80

DESCRIPTION OF LUMINAIRE *

POSITION	SHAPE	MOUNTING** HEIGHT (FT)	CENTROID** HEIGHT (FT)	DISTANCE TO CENT. FROM POLE (FT)	WEIGHT (LBS)	PROJECTED AREA (FT^2)
LUMINAIRE ARM 1	ROUND	26.50	30.00	17.00	55	3.30

* THE VALUES SHOWN IN THIS TABLE MUST NOT BE EXCEEDED WITHOUT CONSULTING VALMONT. ANY SIZES OR OTHER DIMENSIONS NOT PROVIDED BY THE SPECIFYING AGENCY HAVE BEEN ESTIMATED BY VALMONT.

** THESE HEIGHTS ARE ABOVE BOTTOM OF BASE PLATE OR TRANSFORMER BASE.

SUBJECT: VERMONT, 42' MAST ARM & 16' LUM ARM

FOLDER: VTTRAF FILE: 4216

R E S U L T S S U M M A R Y

MAXIMUM COMBINED STRESS RATIO  
 IN EACH MAJOR COMPONENT  
 =====(GROUPS I, II & III)=====

POLE (AT 20.00 (FT)) = 0.90  
 SIGNAL AND SIGN ARM 1 = 0.59  
 LUMINAIRE ARM 1 = 0.63  
 BASE PLATE = 0.56  
 ANCHOR BOLTS = 0.62  
 S/S ARM 1 ATTACH. BOLTS = 0.59  
 S/S ARM 1 ATTACH. PLATE = 0.86

MAXIMUM FATIGUE STRESS  
 RATIO IN EACH MAJOR COMPONENT  
 =====(GROUP IV)=====

POLE (AT 0.00 FT) = 0.77  
 SIGNAL AND SIGN ARM 1  
 ARM TUBE = 1.00  
 BUILT-UP BOX GUSSET = 0.76  
 SIMPLEX BOLTS = 0.57  
 ANCHOR BOLT = 0.43

MAXIMUM REACTIONS APPLIED TO FOUNDATION  
 =====

BENDING MOMENT = 70959 FT-LBS  
 TORSION = 41891 FT-LBS  
 SHEAR FORCE = 1619 LBS  
 AXIAL FORCE = 3273 LBS

MAXIMUM BENDING + AXIAL DEAD WT. STRESS  
 =====

POLE = 19.77 KSI  
 SIGN/SIGNAL ARM 1 = 13.62 KSI  
 LUMINAIRE ARM 1 = 9.21 KSI

RESULTANT DEFLECTION OF POLE TOP  
 CAUSED BY DEAD WEIGHT  
 =====  
 1.34 DEGREES

SUBJECT: VERMONT, 42' MAST ARM & 16' LUM ARM

FOLDER: VTTRAF FILE: 4216

SIGNAL AND SIGN ARM 1

=====

SHAPE	= Round
SPAN LENGTH	= 42.00 FT
BASE O.D.	= 12.50 IN
TAPER	= 0.14 IN/FT
ATTACH. HT. *	= 20.00 FT
ORIENTATION **	= 0 DEGREES
SLOPE AT BASE	= 0 DEGREES
CENTROID LOCATION	
HORIZONTAL	= 18.85 FT
ABOVE ATTACH.	= 0.00 FT
UNBENT LENGTH	= 42.00 FT
MATERIAL-BASE	= S105 - 55 ksi
WEIGHT	= 912 LBS

ARM 1 SECTIONS

=====

BASE SECTION	
THICKNESS	= 0.2092 IN
LENGTH	= 42.00 FT
YIELD STRENGTH	= 55 KSI

BASE WELD FATIGUE CATEGORY = Full-Pen / E

* THIS IS HEIGHT OF ATTACHMENT TO POLE ABOVE BOTTOM OF  
BASE PLATE OR TRANSFORMER BASE. SEE *** BELOW.

** ARM ORIENTATIONS ARE ANGLES FROM +X AXIS IN X-Y PLANE.  
X AND Y AXIES ARE PERPENDICULAR/PARALLEL TO SIDES OF  
POLE BASE PLATE. SEE *** BELOW.

*** IF ARM IS ATTACHED WITH A CLAMP, HEIGHT AND  
ORIENTATION MUST NOT BE CHANGED FROM VALUES SHOWN  
ABOVE WITHOUT CONSULTING VALMONT.

SUBJECT: VERMONT, 42' MAST ARM & 16' LUM ARM

FOLDER: VTTRAF FILE: 4216

LUMINAIRE ARM 1 ( )

=====

SPAN LENGTH	=	16.00 FT
ORIENTATION **	=	0 DEGREES
TOP MEMBER		
SHAPE = ROUND		
BASE O.D.	=	2.38 IN
OUTER END O.D.	=	2.38 IN
THICKNESS	=	0.1540 IN
ATTACH. HT. *	=	26.50 FT
RISE	=	3.50 FT
SLOPE AT BASE	=	23.0 DEGREES
CENTROID LOCATION		
HORIZONTAL	=	7.90 FT
VERTICAL	=	2.25 FT
SPAN TO JOINT	=	10.86 FT
YIELD STRENGTH	=	36 KSI
UNBENT LENGTH	=	16.48 FT
UNBENT LENGTH		
TO JOINT	=	10.86 FT

BOTTOM MEMBER  
SHAPE = ROUND

DIAMETER	=	2.38 IN
THICKNESS	=	0.1540 IN
ATTACH. HT. *	=	24.25 FT
CENTROID LOCATION		
HORIZONTAL	=	5.00 FT
VERTICAL	=	3.02 FT
YIELD STRENGTH	=	36 KSI
UNBENT LENGTH	=	12.07 FT
MATERIAL	=	S109 - 36 ksi
WEIGHT	=	105 LBS

* THESE HEIGHTS ARE ABOVE BOTTOM OF BASE PLATE OR TRANSFORMER BASE.

+ ELLIPTICAL CROSS SECTION; FIRST DIAMETER IS HORIZONTAL.

** ARM ORIENTATIONS ARE ANGLES FROM +X AXIS IN X-Y PLANE. X AND Y AXIES ARE PERPENDICULAR/PARALLEL TO SIDES OF POLE BASE PLATE. SEE *** BELOW.

*** IF ARM IS ATTACHED WITH A CLAMP, HEIGHT AND ORIENTATION MUST NOT BE CHANGED FROM VALUES SHOWN ABOVE WITHOUT CONSULTING VALMONT.

SUBJECT: VERMONT, 42' MAST ARM & 16' LUM ARM

FOLDER: VTTRAF FILE: 4216

FORCES AND MOMENTS WITH WIND ACTING PERPENDICULAR TO EACH ARM

ARM TYPE	ARM NO.	ANALYSIS LOCATION	GROUP LOAD NO.	FORCES (LBS)			MOMENTS (FT-LBS)		
				AXIAL	FY	FZ	TORSION	MY	MZ
SIGNAL	1	BASE	1	41	0	1193	0	28116	0
SIGNAL	1	BASE	2	109	1210	1172	320	27377	39749
SIGNAL	1	BASE	3	160	863	1986	179	52703	24887
LUMIN.	1	TOP BASE	1	810	0	10	0	59	0
LUMIN.	1	TOP BASE	2	815	121	9	4	59	936
LUMIN.	1	TOP BASE	3	1336	93	21	5	108	722
LUMIN.	1	BOT BASE	1	855	0	5	0	49	0
LUMIN.	1	BOT BASE	2	848	66	5	62	50	755
LUMIN.	1	BOT BASE	3	1394	23	14	52	96	526

ANALYSIS OF VALMONT INDUSTRIES LIGHTING STRUCTURE  
 IN ACCORDANCE WITH AASHTO-2009 RQMTS. (FINAL DEFLECTED POSITION)  
 BY BNS 5/12/2014 VERSION Fuse 1.10.0.540 32-bit

SUBJECT: VERMONT, 42' MAST ARM & 16' LUM ARM

FOLDER: VTTRAF FILE: 4216

STRESSES WITH WIND ACTING PERPENDICULAR TO EACH ARM

ANAL. LOCATION			GROUP LOAD NO.	COMB. STR. RATIO	APPLIED STRESS (KSI)			ALLOW. STRESS (KSI)		
ARM TYPE	ARM NO.	SITE			AXIAL	BEND.	SHEAR	AXIAL	BEND.	SHEAR
SIG	1	BASE	1	0.38	0.01	13.61	0.30	33.00	36.30	18.15
SIG	1	BASE	2	0.48	0.01	23.36	0.49	33.00	48.28	24.14
SIG	1	BASE	3	0.59	0.02	28.21	0.58	33.00	48.28	24.14
LUM	1	TOP	1	0.08	0.75	1.18	0.02	21.60	23.76	11.88
LUM	1	TOP	2	0.63	0.76	18.77	0.27	21.60	31.60	15.80
LUM	1	TOP	3	0.52	1.24	14.61	0.22	21.60	31.60	15.80
LUM	1	BOT	1	0.08	0.79	0.97	0.01	21.60	23.76	11.88
LUM	1	BOT	2	0.52	0.79	15.15	0.75	21.60	31.60	15.80
LUM	1	BOT	3	0.40	1.30	10.70	0.57	21.60	31.60	15.80

ANALYSIS OF VALMONT INDUSTRIES LIGHTING STRUCTURE  
IN ACCORDANCE WITH AASHTO-2009 RQMTS. (FINAL DEFLECTED POSITION)  
BY BNS 5/12/2014 VERSION Fuse 1.10.0.540 32-bit

SUBJECT: VERMONT, 42' MAST ARM & 16' LUM ARM

FOLDER: VTTRAF FILE: 4216

GROUP IV FATIGUE ANALYSIS OF ARMS:

---

ANAL. LOCATION			BENDING	SHEAR
ARM	ARM	LOAD CASE	MOMENT	FORCE
TYPE NO.	SITE	=====	(FT-LBS)	(LBS)
SIG 1	BASE	NATURAL WIND GUST	9272	316
SIG 1	BASE	TRUCK-INDUCED GUST	4751	181

ANALYSIS OF VALMONT INDUSTRIES LIGHTING STRUCTURE  
 IN ACCORDANCE WITH AASHTO-2009 RQMTS. (FINAL DEFLECTED POSITION)  
 BY BNS 5/12/2014 VERSION Fuse 1.10.0.540 32-bit

SUBJECT: VERMONT, 42' MAST ARM & 16' LUM ARM

FOLDER: VTTRAF FILE: 4216

GROUP IV FATIGUE ANALYSIS OF ARMS:

ANAL. LOCATION		LOAD CASE =====	STRESS	STRESS	BENDING	SHEAR	
ARM	ARM		RATIO	CAT.	STRESS	STRESS	
TYPE	NO.	SITE			KSI	KSI	
SIG	1	BASE	NATURAL WIND GUST	1.00	E	4.49	0.09
SIG	1	BASE	TRUCK-INDUCED GUST	0.51	E	2.30	0.04

SUBJECT: VERMONT, 42' MAST ARM & 16' LUM ARM

FOLDER: VTTRAF FILE: 4216

THIS PAGE PROVIDES THE PERTINENT INFORMATION CONCERNING THE ANALYSIS  
 OF THE ARM-TO-POLE ATTACHMENT COMPONENTS OF THE SIGNAL AND SIGN ARMS.

***** INPUT DATA *****  
 ARM 1

CONNECTION BOLT DATA

=====

NUMBER	=	4
BOLT DIAMETER (IN)	=	1.250
ASTM SPECIFICATION	=	A325
HORIZONTAL SPACING (IN)	=	14.50
VERTICAL SPACING (IN)	=	14.50

ATTACHMENT PLATE DATA

=====

HORIZONTAL WIDTH (IN)	=	17.75
VERTICAL WIDTH (IN)	=	17.75
THICKNESS (IN)	=	1.500
YIELD STRENGTH (KSI)	=	36
GUSSET THICKNESS (IN)		
- VERTICAL	=	0.250
- HORIZONTAL	=	0.313

ATTACHMENT TYPE

=====

ARM 1: SIMPLEX - RING-STIFFENED BOX, THRU, BASE WELD TYPE = Full-Pen

***** RESULTS *****

ANALYSIS OF SIGNAL/SIGN ARM SIMPLEX BOLTS

=====

ARM	MAX. BOLT CSR	GROUP LOAD NO.	TENSION LBS	APPLIED STRESS KSI	ALLOWABLE STRESS KSI
1	0.59	3	32146	26.20	44.22

ANALYSIS OF SIGNAL/SIGN ARM SIMPLEX PLATES

=====

ARM	MAX. PLATE CSR	GROUP LOAD NO.	APPLIED STRESS KSI	ALLOWABLE STRESS KSI	ANGLE OF FAILURE LINE DEGREES	LENGTH OF BEND LINE IN
1	0.86	3	27.17	31.60	45	12.56

ANALYSIS OF VALMONT INDUSTRIES LIGHTING STRUCTURE  
 IN ACCORDANCE WITH AASHTO-2009 RQMTS. (FINAL DEFLECTED POSITION)  
 BY BNS 5/12/2014 VERSION Fuse 1.10.0.540 32-bit

SUBJECT: VERMONT, 42' MAST ARM & 16' LUM ARM

FOLDER: VTTRAF FILE: 4216

GROUP IV FATIGUE ANALYSIS OF SIGNAL AND SIGN / POLE CONNECTION: ARM

COMPONENT	LOAD	STRESS RATIO	STRESS CAT.	STRESS (KSI)
BUILT-UP BOX GUSSET	NATURAL WIND GUST	0.76	E'	1.98
	TRUCK-INDUCED GUST	0.26	E'	0.67
POLE CROSS SECTION	TRUCK-INDUCED GUST	0.68	E	3.06
	NATURAL WIND GUST	0.57	D	3.97
SIMPLEX BOLT	TRUCK-INDUCED GUST	0.29	D	2.03
	NATURAL WIND GUST			

ANALYSIS OF VERMONT INDUSTRIES LIGHTING STRUCTURE  
 IN ACCORDANCE WITH AASHTO-2009 RQMTS. (FINAL DEFLECTED POSITION)  
 BY BNS 5/12/2014 VERSION Fuse 1.10.0.540 32-bit

SUBJECT: VERMONT, 42' MAST ARM & 16' LUM ARM

FOLDER: VTTRAF FILE: 4216

POLE PROPERTIES

HEIGHT (FT)	DIAMETER (IN)	WALL THK. (IN)	ROUNDNESS RATIO %	D/T	MOMENTS OF INERTIA (IN ⁴ )	SECTION MODULUS (IN ³ )	AREA (IN ² )
27.00	9.220	0.2391	100.00	38.56	67.93	15.13	6.74
26.50	9.290	0.2391	100.00	38.85	69.53	15.36	6.80
24.25	9.605	0.2391	100.00	40.17	77.04	16.45	7.03
22.00	9.920	0.2391	100.00	41.49	85.08	17.58	7.27
20.00	10.200	0.2391	100.00	42.66	92.68	18.61	7.48
18.50	10.410	0.2391	100.00	43.54	98.66	19.40	7.64
17.00	10.620	0.2391	100.00	44.42	104.90	20.21	7.80
14.50	10.970	0.2391	100.00	45.88	115.87	21.60	8.06
12.00	11.320	0.2391	100.00	47.34	127.58	23.03	8.32
9.50	11.670	0.2391	100.00	48.81	140.06	24.50	8.58
7.00	12.020	0.2391	100.00	50.27	153.32	26.03	8.85
4.50	12.370	0.2391	100.00	51.74	167.39	27.60	9.11
2.00	12.720	0.2391	100.00	53.20	182.30	29.21	9.37
0.00	13.000	0.2391	100.00	54.37	194.85	30.54	9.58

SUBJECT: VERMONT, 42' MAST ARM & 16' LUM ARM

FOLDER: VTTRAF FILE: 4216

ANALYSIS OF POLE: FORCES AND MOMENTS

SECTION GROUP HEIGHT* LOAD (FT)	NO.	FORCES (LBS)			MOMENTS (FT-LBS)			WIND DIRECT** (DEGREES)
		FX	FY	FZ	MX	MY	MZ	
26.50	1	790	0	-171	0	-59	0	0
26.50	2	794	131	-171	-205	-59	913	90
26.50	3	1301	104	-291	-160	-108	704	90
20.00	1	48	0	1527	0	30335	0	0
20.00	2	122	1463	1503	-2102	29650	41889	90
20.00	3	179	1054	2462	-1501	56409	26457	90
0.00	1	3	0	2125	0	30831	0	0
0.00	2	6	1622	2126	-33229	30728	41890	90
0.00	3	576	812	3267	-15476	67623	17129	55

* THESE HEIGHTS ARE ABOVE THE POLE BASE PLATE.

** THESE ARE DIRECTIONS TOWARD WHICH THE WIND IS FLOWING.  
 THEY ARE ANGLES FROM THE +X AXIS IN THE X-Y PLANE

ANALYSIS OF VALMONT INDUSTRIES LIGHTING STRUCTURE  
 IN ACCORDANCE WITH AASHTO-2009 RQMTS. (FINAL DEFLECTED POSITION)  
 BY BNS 5/12/2014 VERSION Fuse 1.10.0.540 32-bit

SUBJECT: VERMONT, 42' MAST ARM & 16' LUM ARM

FOLDER: VTTRAF FILE: 4216

ANALYSIS OF POLE: STRESSES

SECTION HEIGHT* (FT)	GROUP LOAD NO.	COMB. STR. RATIO	APPLIED STRESS (KSI)			ALLOW. STRESS (KSI)		
			AXIAL	BEND.	SHEAR	AXIAL	BEND	SHEAR
26.50	1	0.00	0.03	0.05	0.23	33.00	36.30	18.15
26.50	2	0.00	0.03	0.17	0.59	33.00	48.28	24.14
26.50	3	0.01	0.04	0.15	0.66	33.00	48.28	24.14
20.00	1	0.55	0.20	19.56	0.01	33.00	36.30	18.15
20.00	2	0.73	0.20	19.17	13.90	33.00	48.28	24.14
20.00	3	0.90	0.33	36.38	8.82	33.00	48.28	24.14
0.00	1	0.34	0.22	12.11	0.00	33.00	36.30	18.15
0.00	2	0.50	0.22	17.78	8.57	33.00	48.28	24.14
0.00	3	0.60	0.34	27.25	3.57	33.00	48.28	24.14

* THESE HEIGHTS ARE ABOVE THE POLE BASE PLATE.

ANALYSIS OF VALMONT INDUSTRIES LIGHTING STRUCTURE  
 IN ACCORDANCE WITH AASHTO-2009 RQMTS. (FINAL DEFLECTED POSITION)  
 BY BNS 5/12/2014 VERSION Fuse 1.10.0.540 32-bit

SUBJECT: VERMONT, 42' MAST ARM & 16' LUM ARM

FOLDER: VTTRAF FILE: 4216

GROUP IV ANALYSIS OF POLE:

SECTION HEIGHT* (FT)	LOAD CASE	AXIAL (LBS)	BENDING (FT-LBS)
0.0	NATURAL WIND GUST	N/A	8791
0.0	TRUCK GUST	N/A	4835

GROUP IV ANALYSIS OF POLE:

SECTION HEIGHT* (FT)	LOAD CASE	STRESS RATIO	STRESS CATEGORY	STRESS BENDING (KSI)
0.0	NATURAL WIND GUST	0.77	E	3.45
0.0	TRUCK GUST	0.43	E	1.92

* THESE HEIGHTS ARE ABOVE THE POLE BASE PLATE.

ANALYSIS OF VALMONT INDUSTRIES LIGHTING STRUCTURE  
IN ACCORDANCE WITH AASHTO-2009 RQMTS. (FINAL DEFLECTED POSITION)  
BY BNS 5/12/2014 VERSION Fuse 1.10.0.540 32-bit

SUBJECT: VERMONT, 42' MAST ARM & 16' LUM ARM

FOLDER: VTTRAF FILE: 4216

ARM DEFLECTIONS:

---

ARM TYPE	ARM NO.	GROUP LOAD NO.	LOAD CASE NAME	DEFLECTION (IN)
SIGN	1	4	NATURAL WIND GUST	7.592
SIGN	1	4	TRUCK-INDUCED GUST	3.128

ANALYSIS OF VALMONT INDUSTRIES LIGHTING STRUCTURE  
IN ACCORDANCE WITH AASHTO-2009 RQMTS. (FINAL DEFLECTED POSITION)  
BY BNS 5/12/2014 VERSION Fuse 1.10.0.540 32-bit

SUBJECT: VERMONT, 42' MAST ARM & 16' LUM ARM

FOLDER: VTTRAF FILE: 4216

BASE PLATE ( SQUARE )

=====

WIDTH	=	20.00 IN
THICKNESS	=	1.500 IN
YIELD STRENGTH	=	36 KSI
STATIC COMBINED STRESS RATIO	=	0.56
BASE WELD TYPE	=	FULL-PEN

ANALYSIS OF BASE PLATE

=====

COMBINED STRESS RATIO	=	0.56
GROUP LOAD NUMBER	=	3
CRITICAL WIND DIRECT.*	=	70.00 DEGREES
ALIGNMENT OF THE BEND LINE	=	315.00 DEGREES
BOLT FORCE	=	38337 LBS
BOLT-TO-BEND LINE MOMENT ARM	=	3.00 IN
WIDTH OF BENDING SECTION	=	15.28 IN
APPLIED BENDING STRESS	=	20.07 KSI
ALLOWABLE BENDING STRESS	=	35.91 KSI

ANCHOR BOLTS

=====

QUANTITY	=	4
BOLT DIAMETER	=	1.50 IN
BOLT CIRCLE	=	19.00 IN
INITIAL BOLT ANGLE	=	45.00 DEGREES
BOLT LENGTH	=	54 IN
YIELD STRENGTH	=	55.00 KSI
STATIC COMBINED STRESS RATIO	=	0.62
FATIGUE STRESS RATIO	=	0.43

ANALYSIS OF VALMONT INDUSTRIES LIGHTING STRUCTURE  
 IN ACCORDANCE WITH AASHTO-2009 RQMTS.  
 BY BNS 5/12/2014 VERSION Fuse 1.10.0.540 32-bit

SUBJECT: VERMONT, 42' MAST ARM & 16' LUM ARM

FOLDER: VTTRAF FILE: 4216

ANALYSIS OF ANCHOR BOLTS

GROUP LOAD NO.	CRITICAL	MAX.	AXIAL FORCE (LBS)	SHEAR FORCE (LBS)	APPLIED		ALLOWABLE		BOLT CONST "K"
	WIND DIRECT* (DEG)	COMB. STRESS RATIO			STRESS (KSI)	SHEAR	STRESS (KSI)	SHEAR	
1	0	0.14	14300	0	10.14	0.00	27.50	16.50	0.60
2	90	0.51	29093	13518	20.63	9.59	36.58	21.95	0.60
3	90	0.62	37989	8583	26.94	6.09	36.58	21.95	0.60

FATIGUE ANALYSIS OF ANCHOR BOLTS

LOAD CASE	STR. RATIO	AXIAL (LBS)
NATURAL WIND GUST	0.43	-4207.0
TRUCK-INDUCED GUST	0.22	-2159.4

* THESE ARE DIRECTIONS TOWARD WHICH THE WIND IS FLOWING.

SUBJECT: VERMONT, 42' MAST ARM & 16' LUM ARM

FOLDER: VTTRAF FILE: 4216

*** POLE DEFLECTION INFORMATION ***

ELEVATION FT	X-DEFL. (IN)	Y-DEFL. (IN)	DEFLECTION ANGLE, DEGREE	
			X-	Y-
=====				
GP. LD. 1 ; WIND ANGLE 0				
27.00	4.35	0.00	1.34	0.00
26.50	4.21	0.00	1.34	0.00
24.25	3.58	0.00	1.33	0.00
22.00	2.96	0.00	1.32	0.00
20.00	2.41	0.00	1.31	0.00
18.50	2.02	0.00	1.17	0.00
17.00	1.67	0.00	1.04	0.00
14.50	1.18	0.00	0.85	0.00
12.00	0.78	0.00	0.67	0.00
9.50	0.48	0.00	0.50	0.00
7.00	0.25	0.00	0.35	0.00
4.50	0.10	0.00	0.22	0.00
2.00	0.02	0.00	0.09	0.00
0.00	0.00	0.00	0.00	0.00
GP. LD. 2 ; WIND ANGLE 90				
27.00	4.28	2.75	1.33	0.68
26.50	4.14	2.68	1.33	0.68
24.25	3.52	2.34	1.32	0.68
22.00	2.91	2.00	1.31	0.67
20.00	2.37	1.71	1.30	0.66
18.50	1.99	1.50	1.16	0.65
17.00	1.65	1.29	1.04	0.62
14.50	1.16	0.96	0.84	0.57
12.00	0.77	0.68	0.66	0.50
9.50	0.47	0.43	0.50	0.41
7.00	0.25	0.24	0.35	0.32
4.50	0.10	0.10	0.22	0.21
2.00	0.02	0.02	0.09	0.10
0.00	0.00	0.00	0.00	0.00
GP. LD. 3 ; WIND ANGLE 55				
27.00	8.83	1.29	2.66	0.31
26.50	8.55	1.25	2.66	0.31
24.25	7.30	1.09	2.65	0.31
22.00	6.05	0.93	2.63	0.30
20.00	4.96	0.79	2.61	0.30
18.50	4.18	0.69	2.36	0.29
17.00	3.48	0.60	2.12	0.28
14.50	2.47	0.45	1.74	0.26
12.00	1.66	0.31	1.39	0.23
9.50	1.01	0.20	1.06	0.19
7.00	0.54	0.11	0.76	0.15

4.50

0.22

0.05

0.47

0.10






ANALYSIS OF VALMONT INDUSTRIES LIGHTING STRUCTURE  
IN ACCORDANCE WITH AASHTO-2009 RQMTS. (FINAL DEFLECTED POSITION)  
BY BNS 5/12/2014 VERSION Fuse 1.10.0.540 32-bit

SUBJECT: VERMONT, 42' MAST ARM & 16' LUM ARM




FOLDER: VTTRAF FILE: 4216

*** POLE DEFLECTION INFORMATION ***

ELEVATION FT	X-DEFL. (IN)	Y-DEFL. (IN)	DEFLECTION ANGLE, DEGREE	
			X-	Y-
2.00	0.04	0.01	0.20	0.04
0.00	0.00	0.00	0.00	0.00

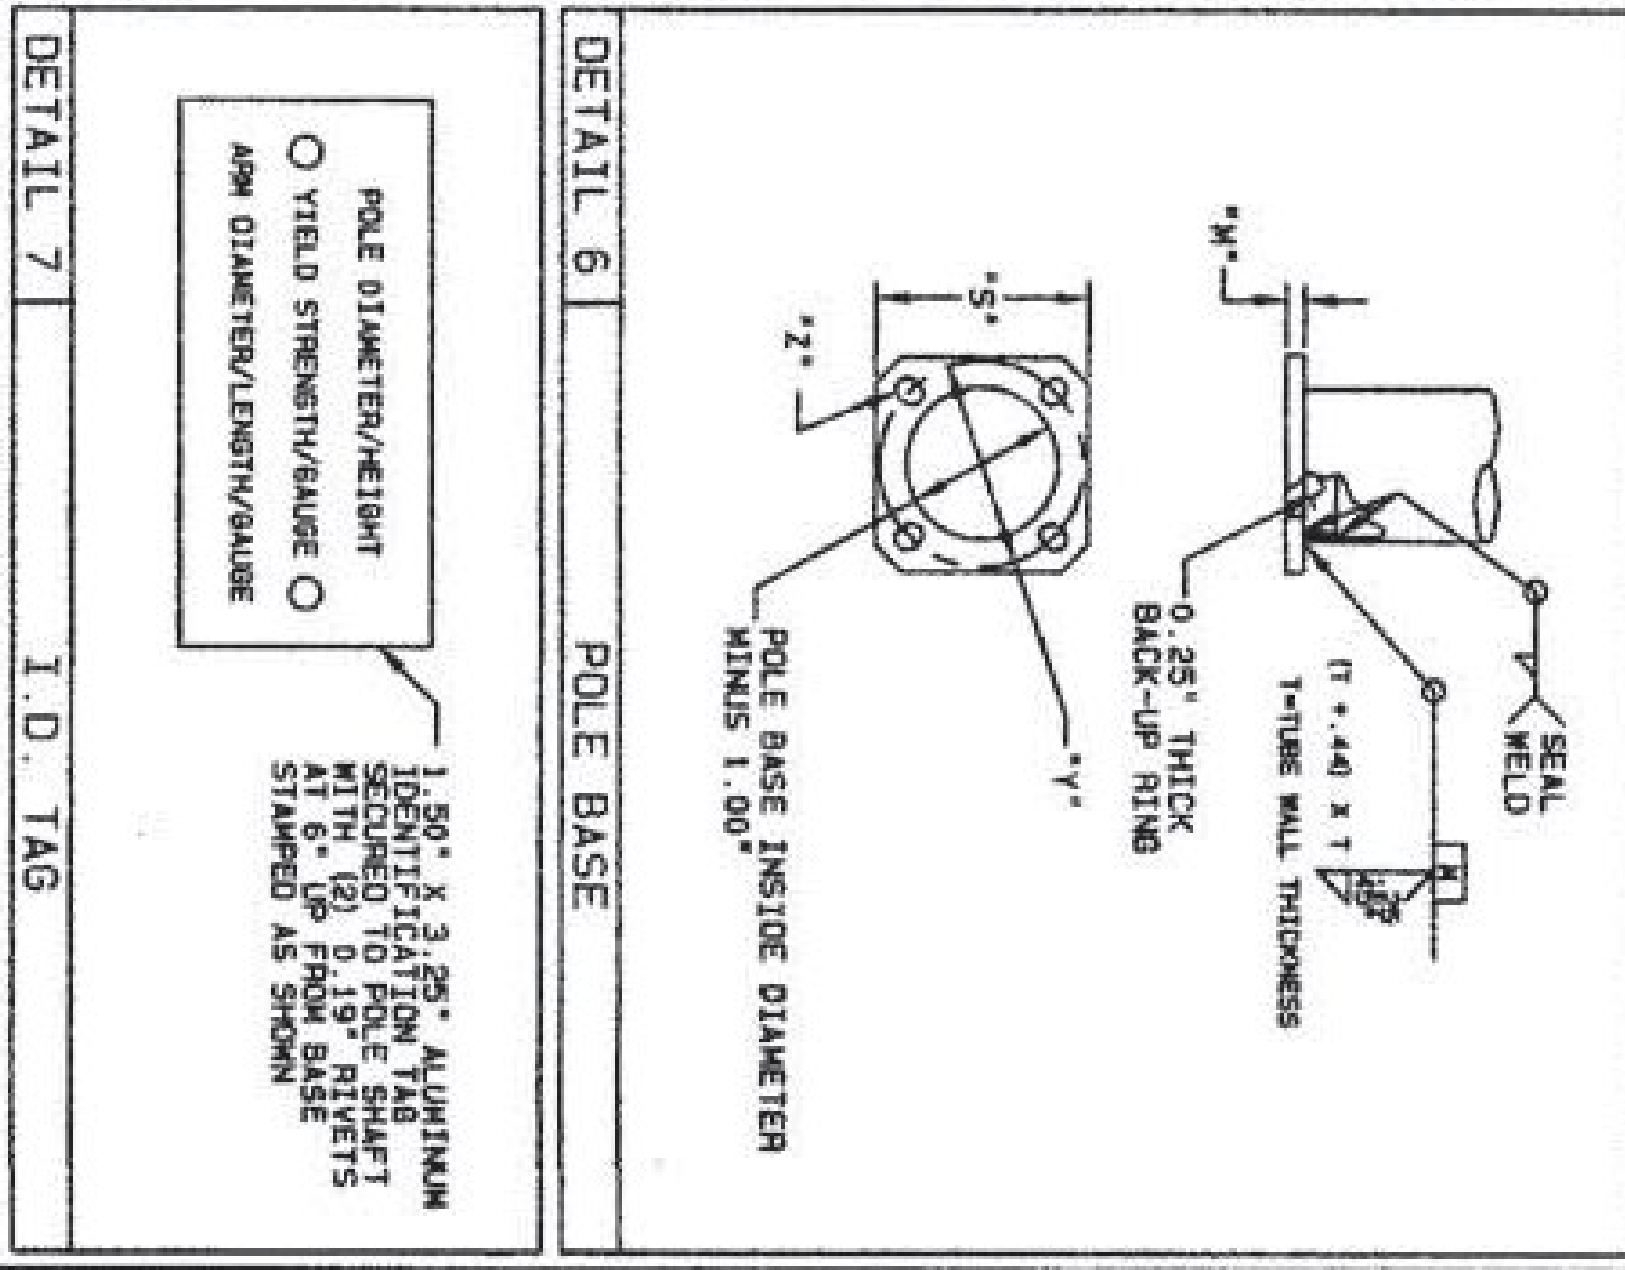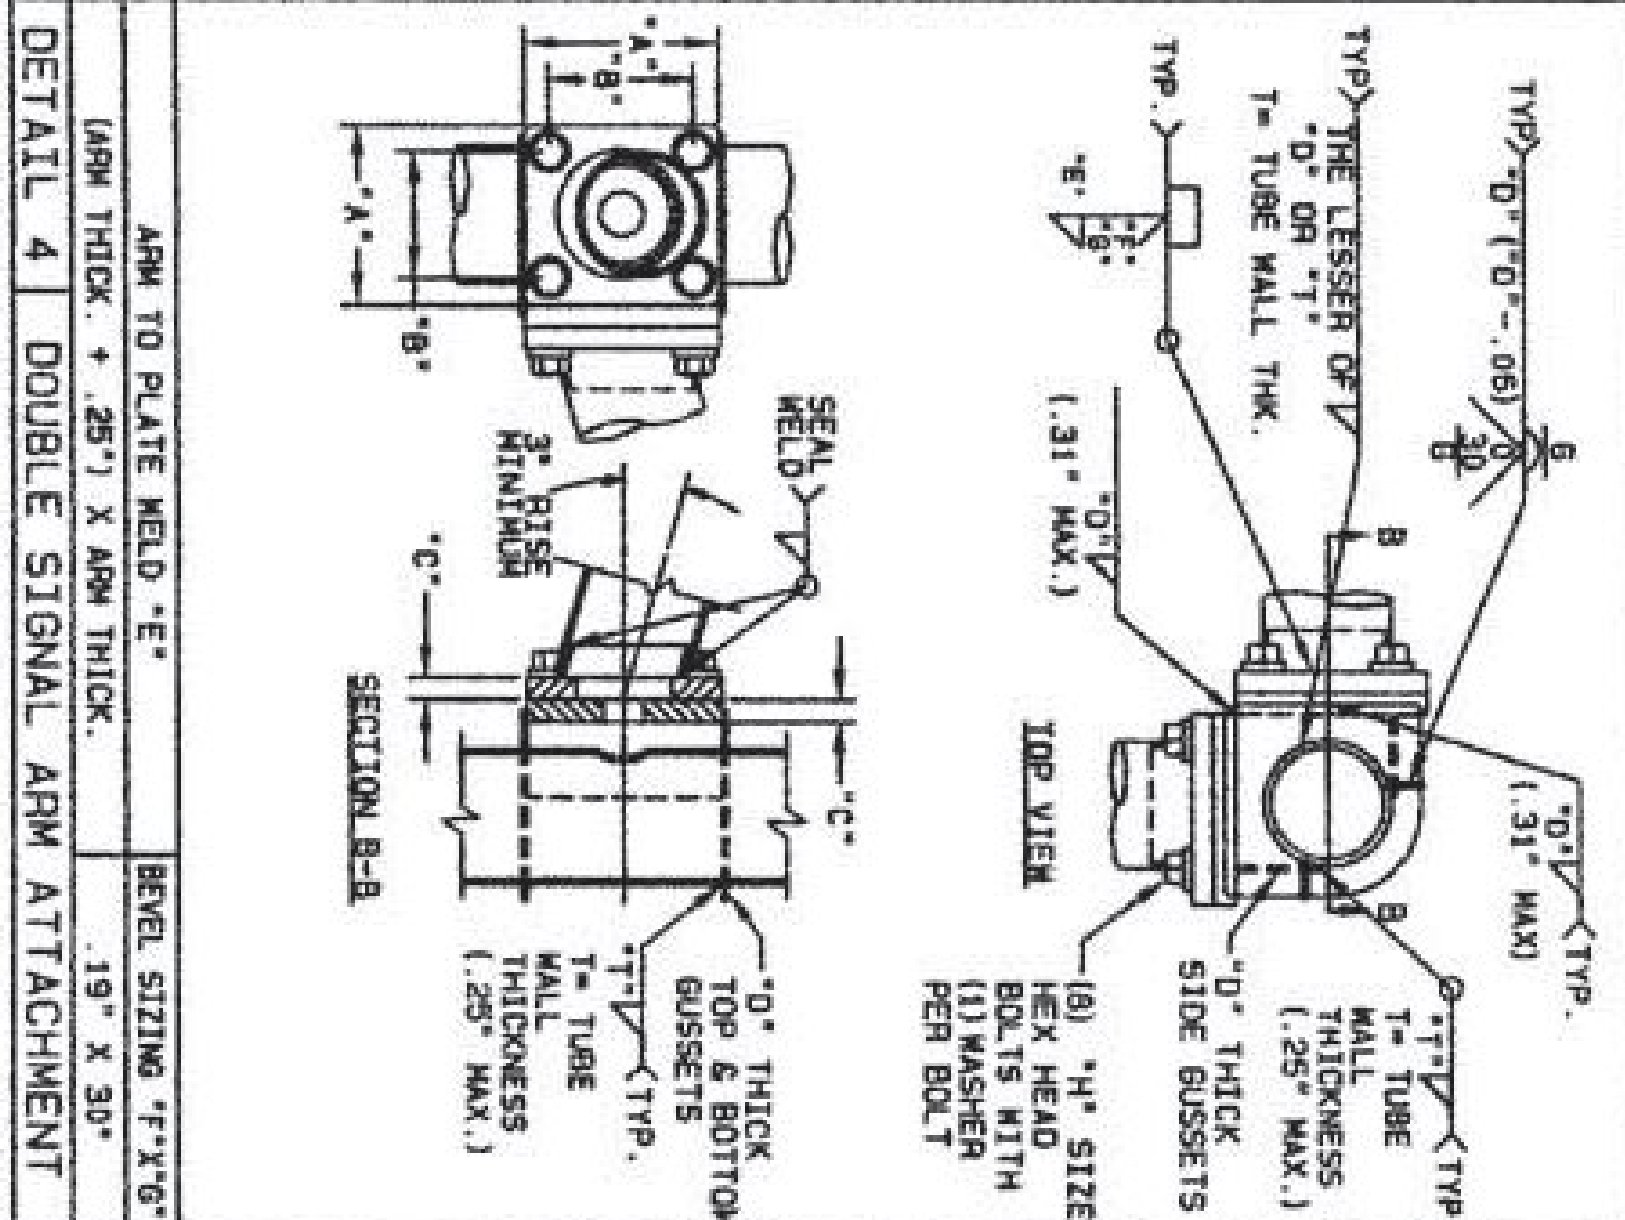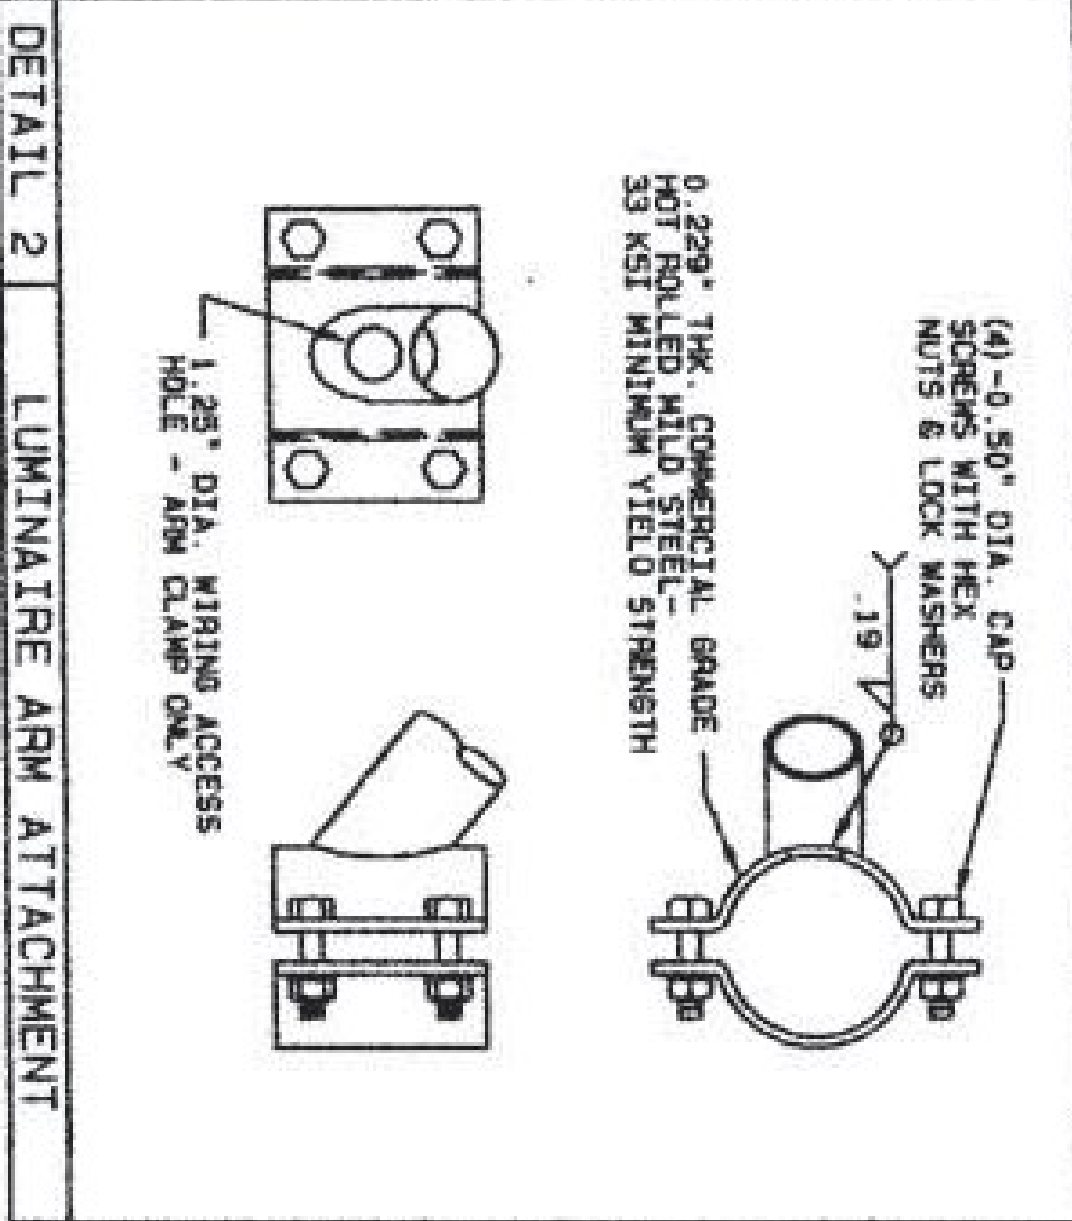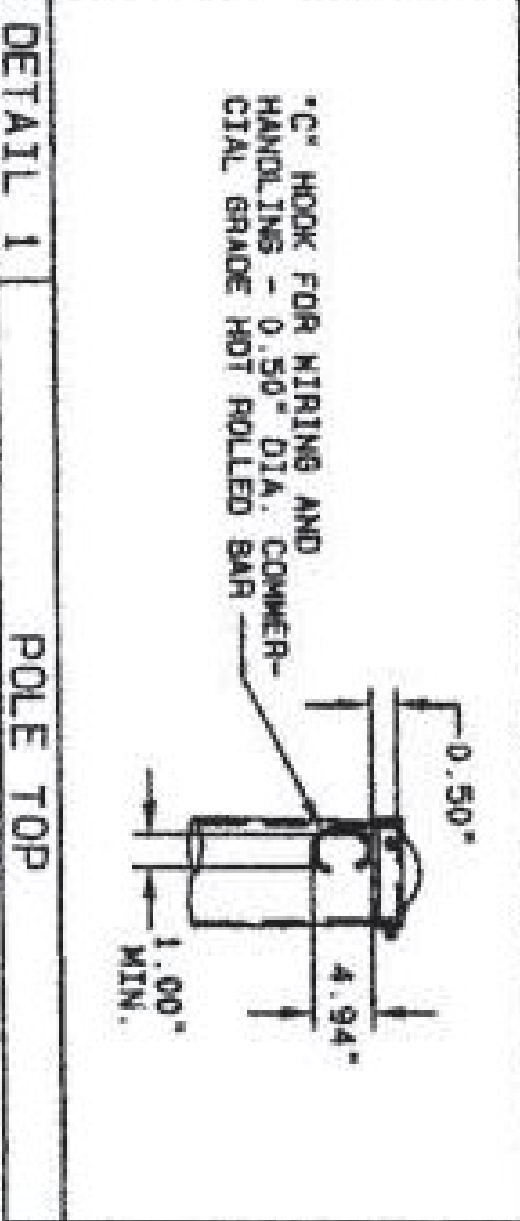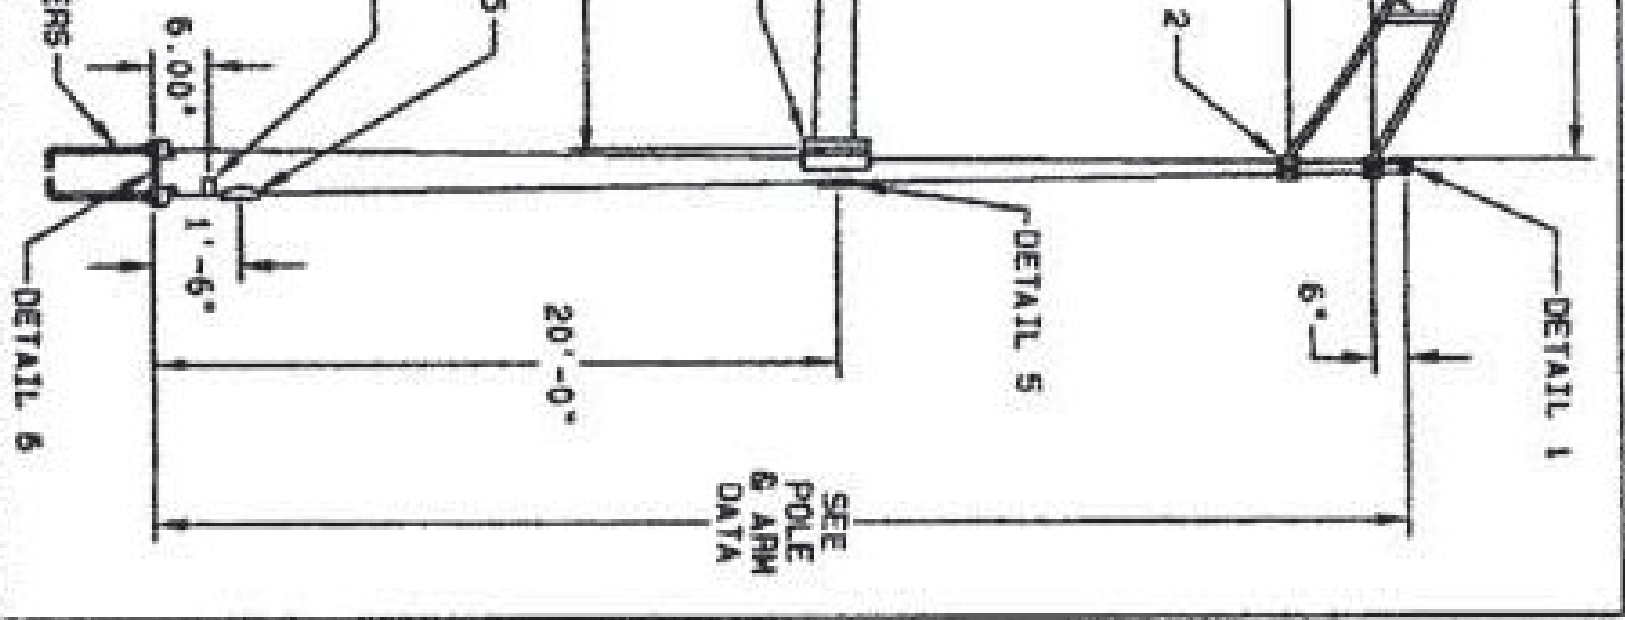


COMPONENT	ASTM DESIGNATION (K51)	MIN. YIELD STRENGTH (KSI)
1- STRUCTURE	A153	
2- HARDWARE	A153	

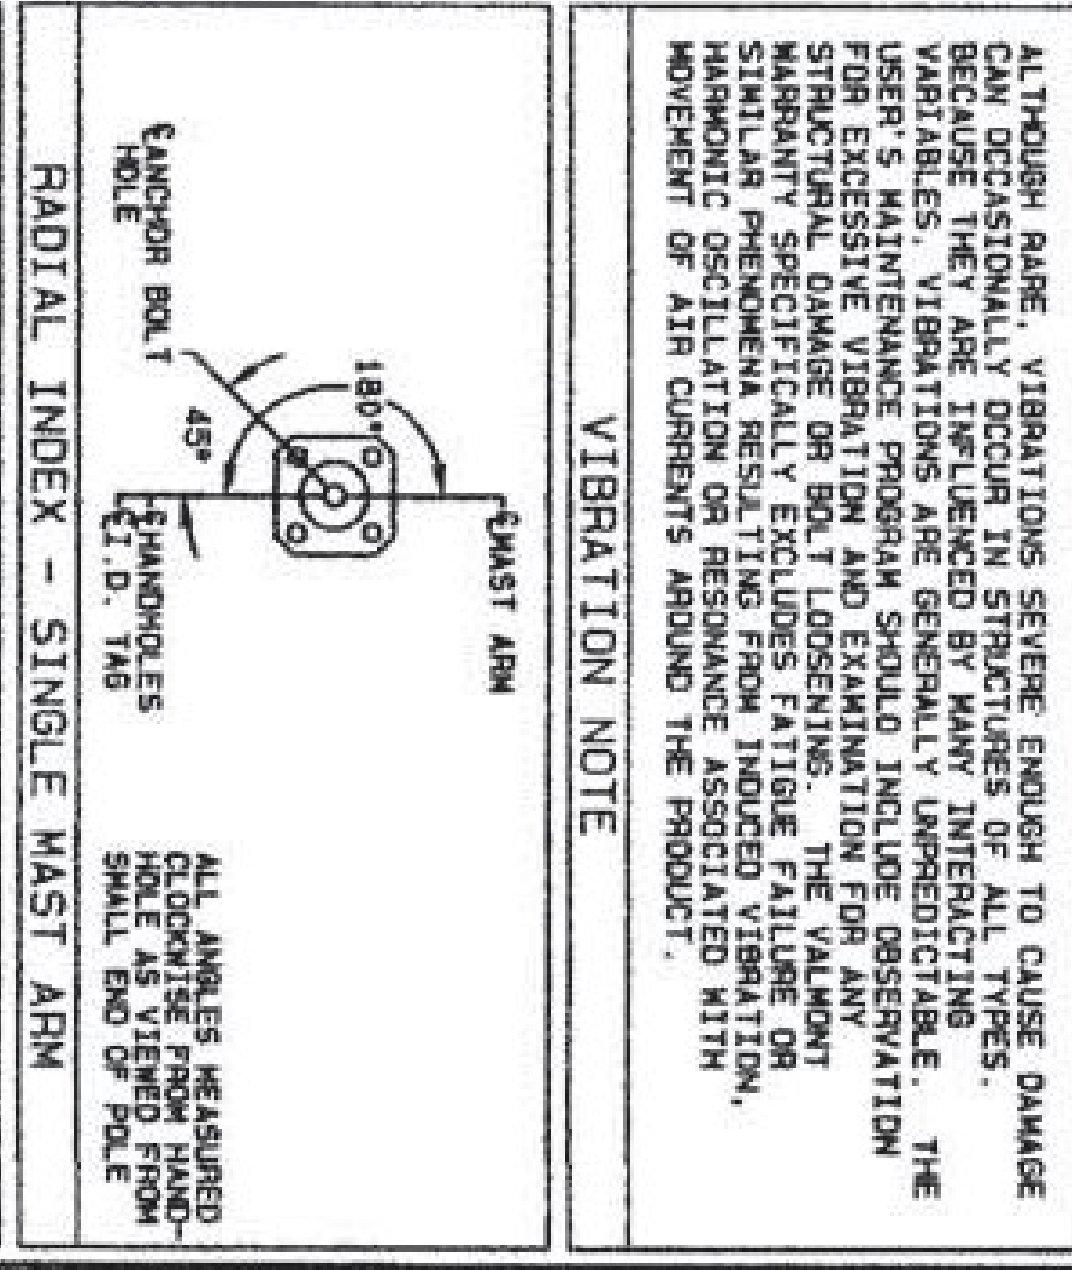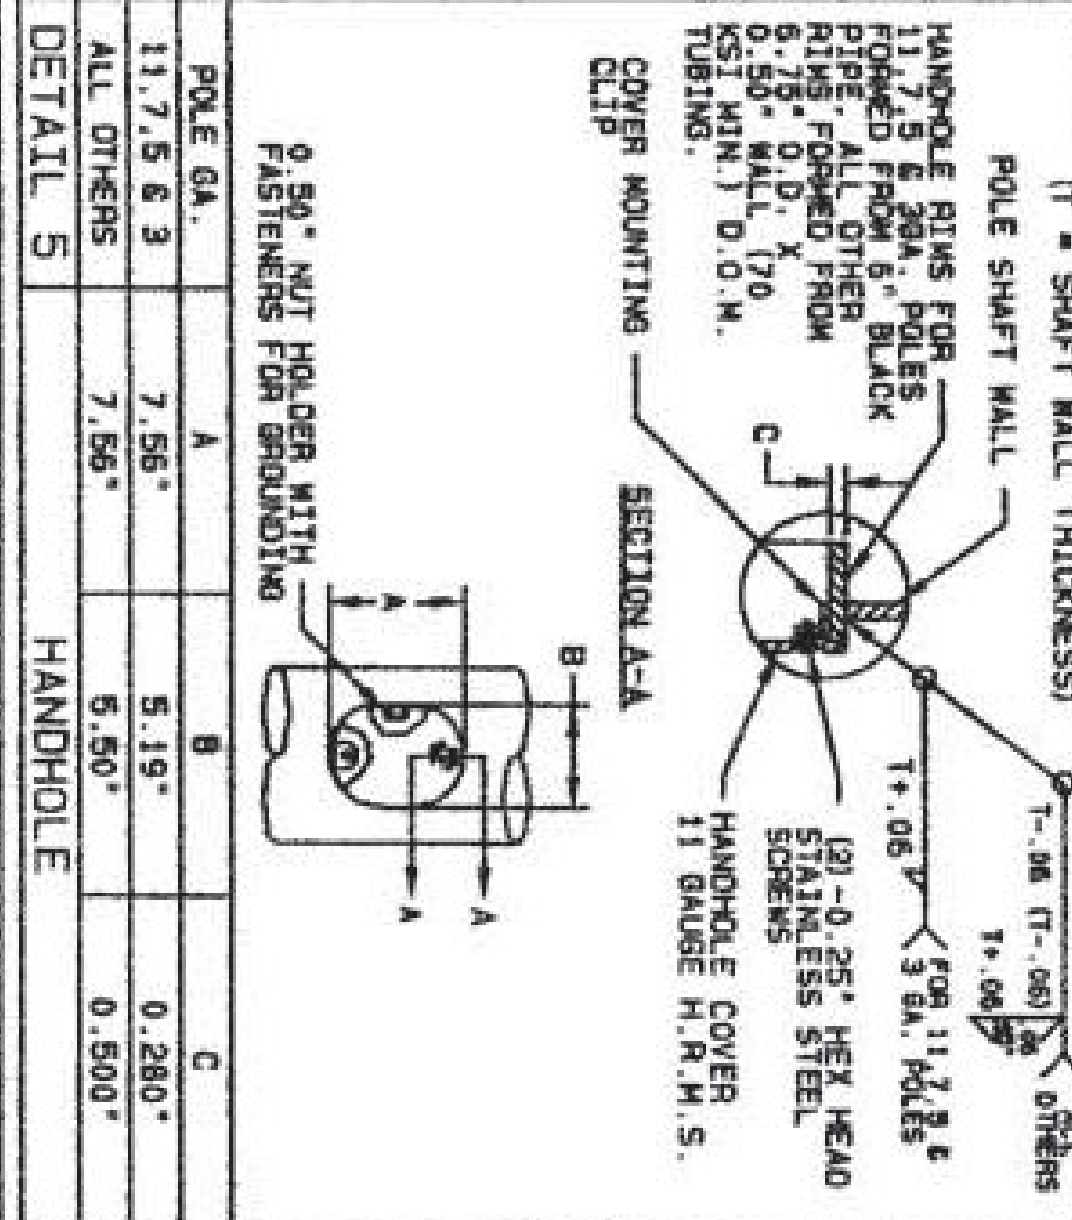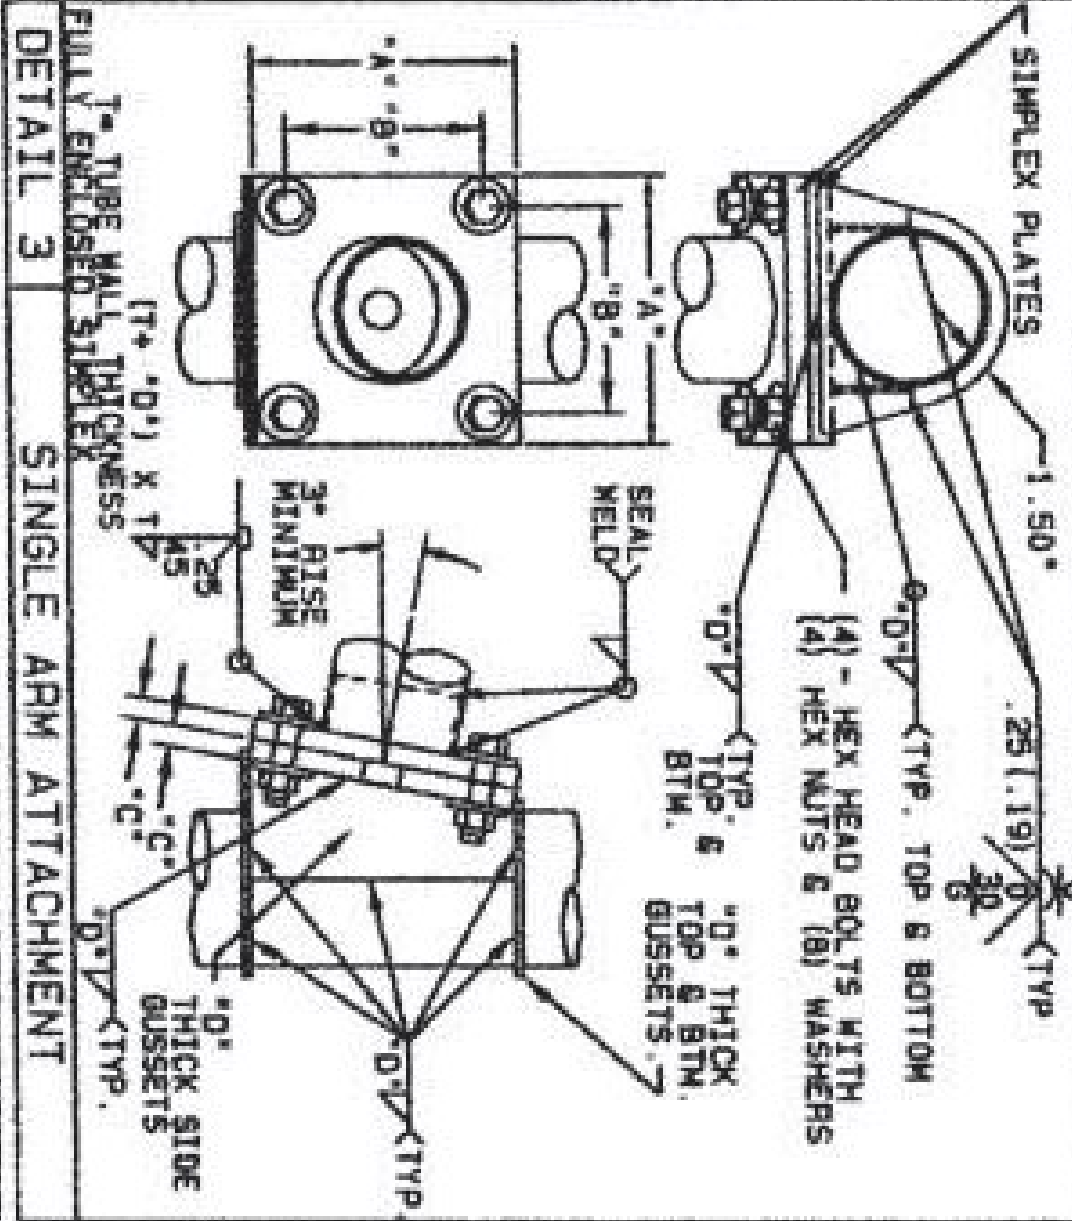

SIGNAL ARM ATTACHMENT DATA					
POLE BASE	A	B	C	D	SCREEN SIZE
SR. DIA. DBL	14.50"	14.50"	1.500"	0.313"	1.25" X 5.00"
SR. DR DBL	17.75"	14.50"	1.500"	0.250"	1.25" X 3.50"
13.00" DBL	17.75"	14.50"	1.500"	0.250"	1.25" X 3.50"

HANDHOLE			
POLE GA.	A	B	C
11.7.5 & 3	7.56"	5.19"	0.260"
ALL OTHERS	7.56"	5.50"	0.500"

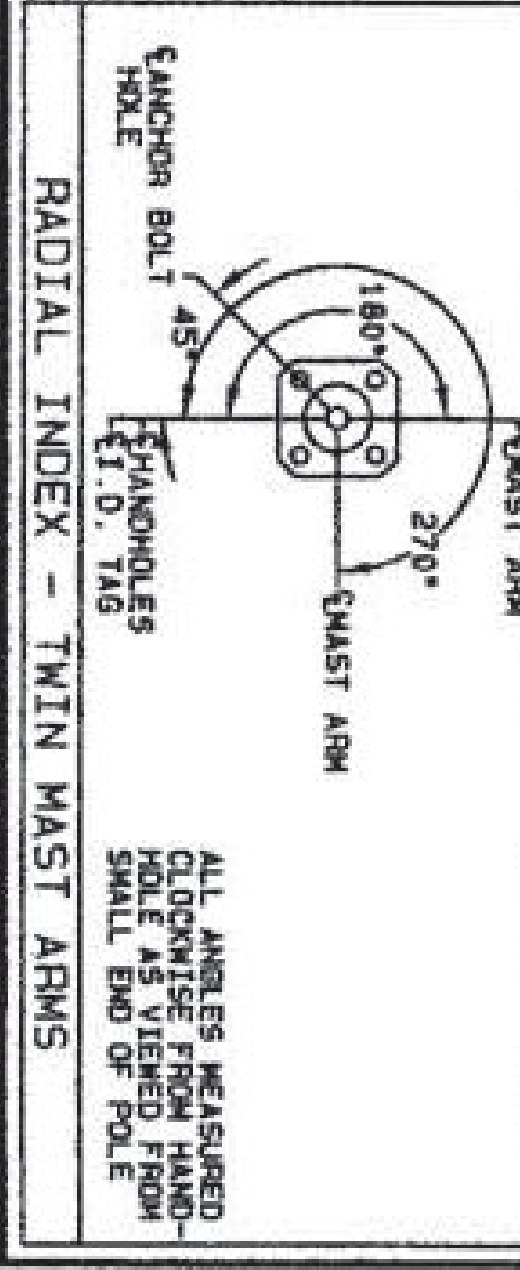

5564  
 G. COTE JR.  
 V. MONT  
 15 2014  
 ROAD TO HIGHWAY TECH  
 SHIP TO SIGNALS RVG. INC.  
 P.O. # 8706  
 HIGHWAY TECH  
 VT D.D.T. - WATERBURY  
 PROJ. NO. - NHG SGNL (43)  
 TITLE TRAFFIC SIGNAL STRUCTURES  
 VALMONT INDUSTRIES, INC. RESERVES  
 THE RIGHT TO DISCONTINUE OR  
 ENGINEER APPROVED MATERIALS  
 ACCOMMODATIONS TO FACILITATE THE  
 MANUFACTURING PROCESS.  
 VALMONT  
 43116V, NE 58064  
 (402) 399-2201  
 ORDER NUMBER: 235821-P1  
 PAGE NUMBER: 1 OF 2  
 DRAWING NUMBER: VT235821P1  
 REV: B

POLE AND SIGNAL ARM DATA

POLE TUBE			POLE BASE			ANCHOR BOLT			SIGNAL ARM TUBE			LUMINAIRE			
TOP DIA. (IN)	LENGTH (FT)	GAUGE OR THK. (IN)	SQUARE "S" (IN)	BOLT CIRCLE "Y" (IN)	THK. "M" (IN)	HOLE / SLOT "Z" (IN)	OIA. "K" (IN)	LENGTH "J" (IN)	HOOK "H" (IN)	THREAD LENGTH "U" (IN)	FIXED END DIA. (IN)	FREE END DIA. (IN)	GAUGE OR THICK (IN)	SPAN (FT)	ARM SPAN "L" (FT)
9.22	27.00	3	20.00	19.00	1.50	1.75	1.50	BY OTHERS			11.50	6.74	7	34.00	12.00
9.22	27.00	3	20.00	19.00	1.50	1.75	1.50	BY OTHERS			11.00	6.66	7	31.00	
9.22	27.00	3	20.00	19.00	1.50	1.75	1.50	BY OTHERS			12.50	6.62	5	42.00	16.00



MAY 15 2014

VT D.O.T. - WATERBURY  
 PROJ. NO. - NHG SGNL (43)  
 TITLE - TRAFFIC SIGNAL STRUCTURES

VALMONT INDUSTRIES, INC. RESERVES  
 THE RIGHT TO INSTALL VARIOUS,  
 ENGINEER APPROVED, MATERIAL HANGING  
 ACCOMMODATIONS TO FACILITATE THE  
 MANUFACTURING PROCESS.

**Valmont**  
 VALLEY, NE 68064  
 (402) 369-2201

ORDER NUMBER: 235821-P1  
 PAGE NUMBER: 2 OF 2  
 DRAWING NUMBER: VT235821P1  
 REV: B