


STATE OF VERMONT AGENCY OF TRANSPORTATION

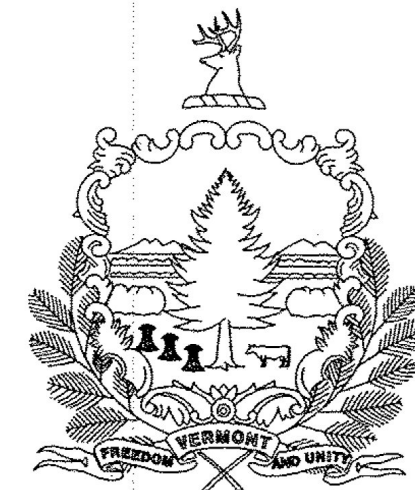

PROPOSED IMPROVEMENT TOWN OF LUDLOW COUNTY OF WINDSOR VT ROUTE 103 (PRINCIPAL ARTERIAL) (NHS)

BEGINNING IN THE TOWN OF LUDLOW ON VT ROUTE 103 AT MM 4.267 AND EXTENDING 1331.37 FEET (0.252 MILES)
SOUTH EASTERLY TO MM 4.015.

LENGTH OF PROJECT = 1331.37 FEET = 0.252 MILES

THE PROJECT SHALL CONSIST OF A NEW TRAFFIC SIGNAL SYSTEM, CURBING, PAVEMENT MARKINGS, SIGNING, STREET
LIGHTING, AND OTHER HIGHWAY RELATED ITEMS.

Record Plans



Contractor: THE BELDEN COMPANY, INC.
Resident Engineer: JACE CURTIS
Construction Began: APRIL 9, 2018
Construction Complete: NOVEMBER 14, 2018
Record Plans By: ROSS PEIRCE

I hereby certify that all construction required by this set of drawings has been accomplished as indicated herein.

BY: E-SIGNED by Jace Curtis on 2019-01-08 12:08:06 UTC Resident Engineer


Date: January 08, 2019

NOTE: Any further information concerning final quantities, amounts or other details relative to this project may be found at Central Files in the electronic archives.

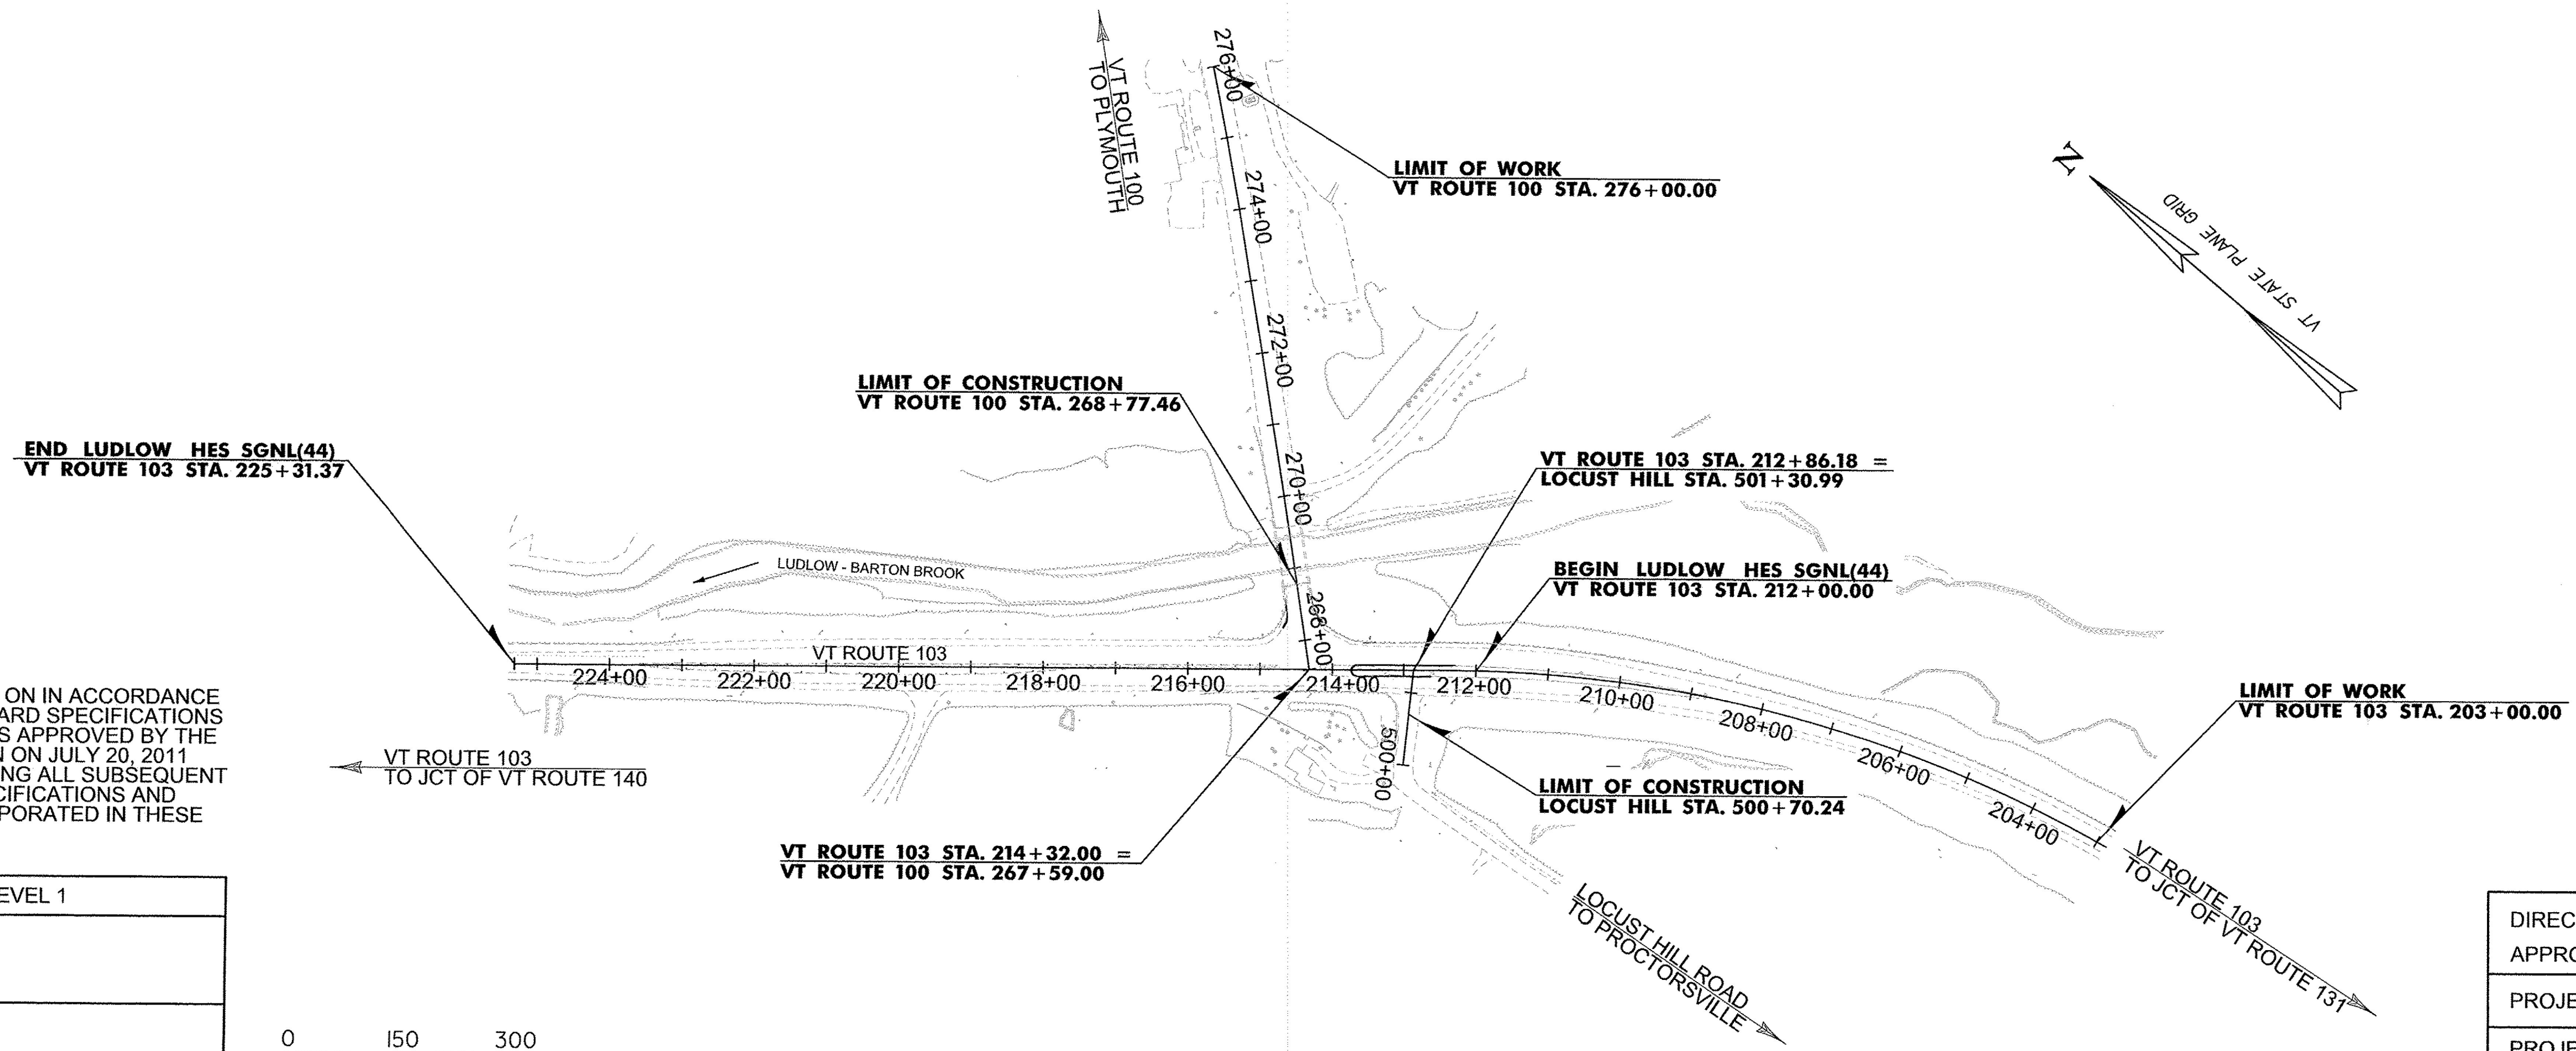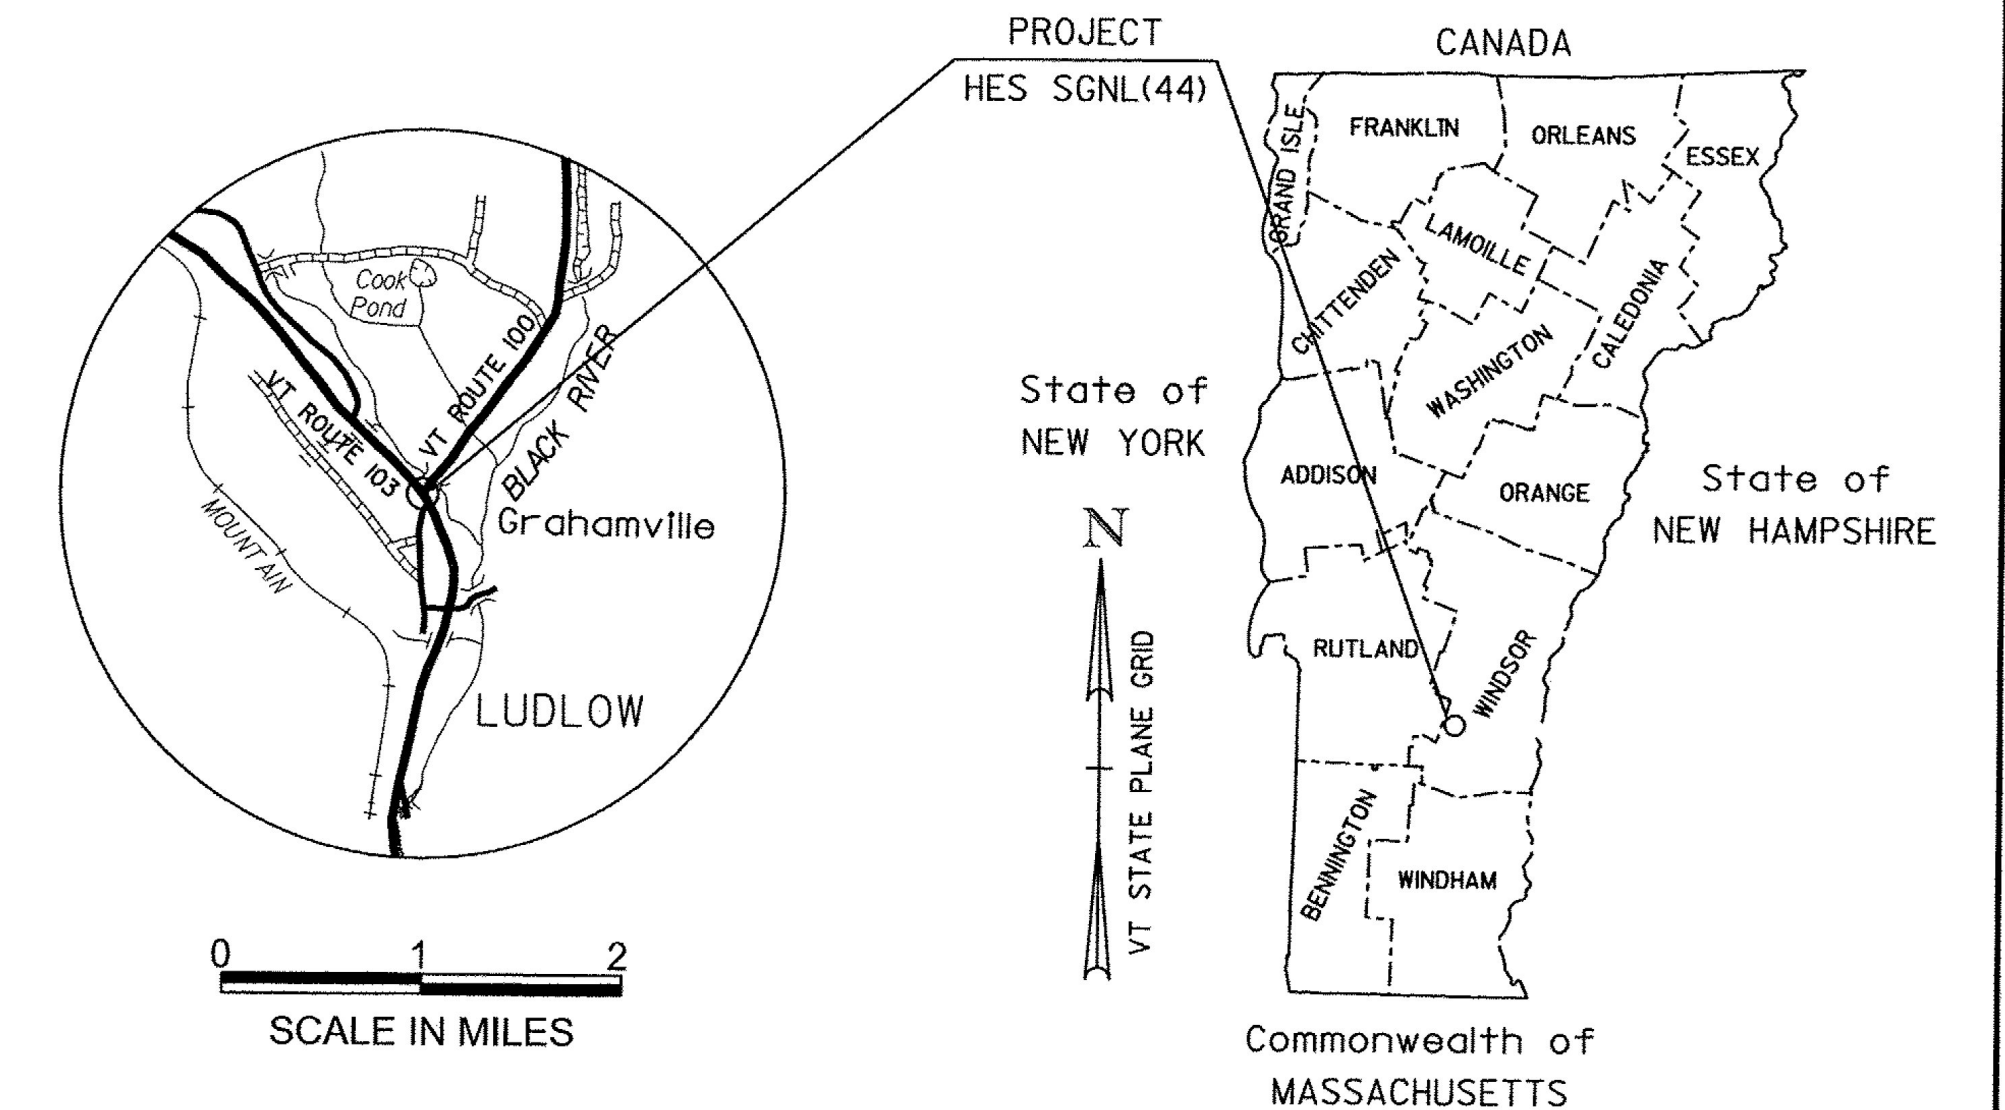

CONSTRUCTION IS TO BE CARRIED ON IN ACCORDANCE WITH THESE PLANS AND THE STANDARD SPECIFICATIONS FOR CONSTRUCTION DATED 2011, AS APPROVED BY THE FEDERAL HIGHWAY ADMINISTRATION ON JULY 20, 2011 FOR USE ON THIS PROJECT, INCLUDING ALL SUBSEQUENT REVISIONS AND SUCH REVISED SPECIFICATIONS AND SPECIAL PROVISIONS AS ARE INCORPORATED IN THESE PLANS.

QUALITY ASSURANCE PROGRAM : LEVEL 1	
SURVEYED BY :	VTRANS
SURVEYED DATE :	2013
DATUM	
VERTICAL :	NAVD 88
HORIZONTAL :	NAD 83(1996)

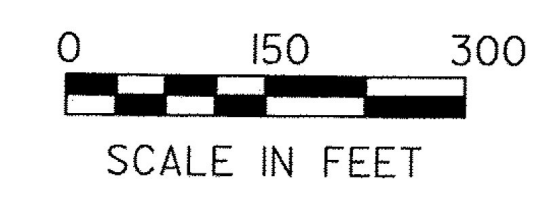

DIRECTOR OF PROJECT DELIVERY	
APPROVED <i>[Signature]</i>	DATE 4/6/2017
PROJECT MANAGER : PATRICIA COBURN, P.E.	
PROJECT NAME :	LUDLOW
PROJECT NUMBER :	HES SGNL(44)
SHEET 1 OF 43 SHEETS	