
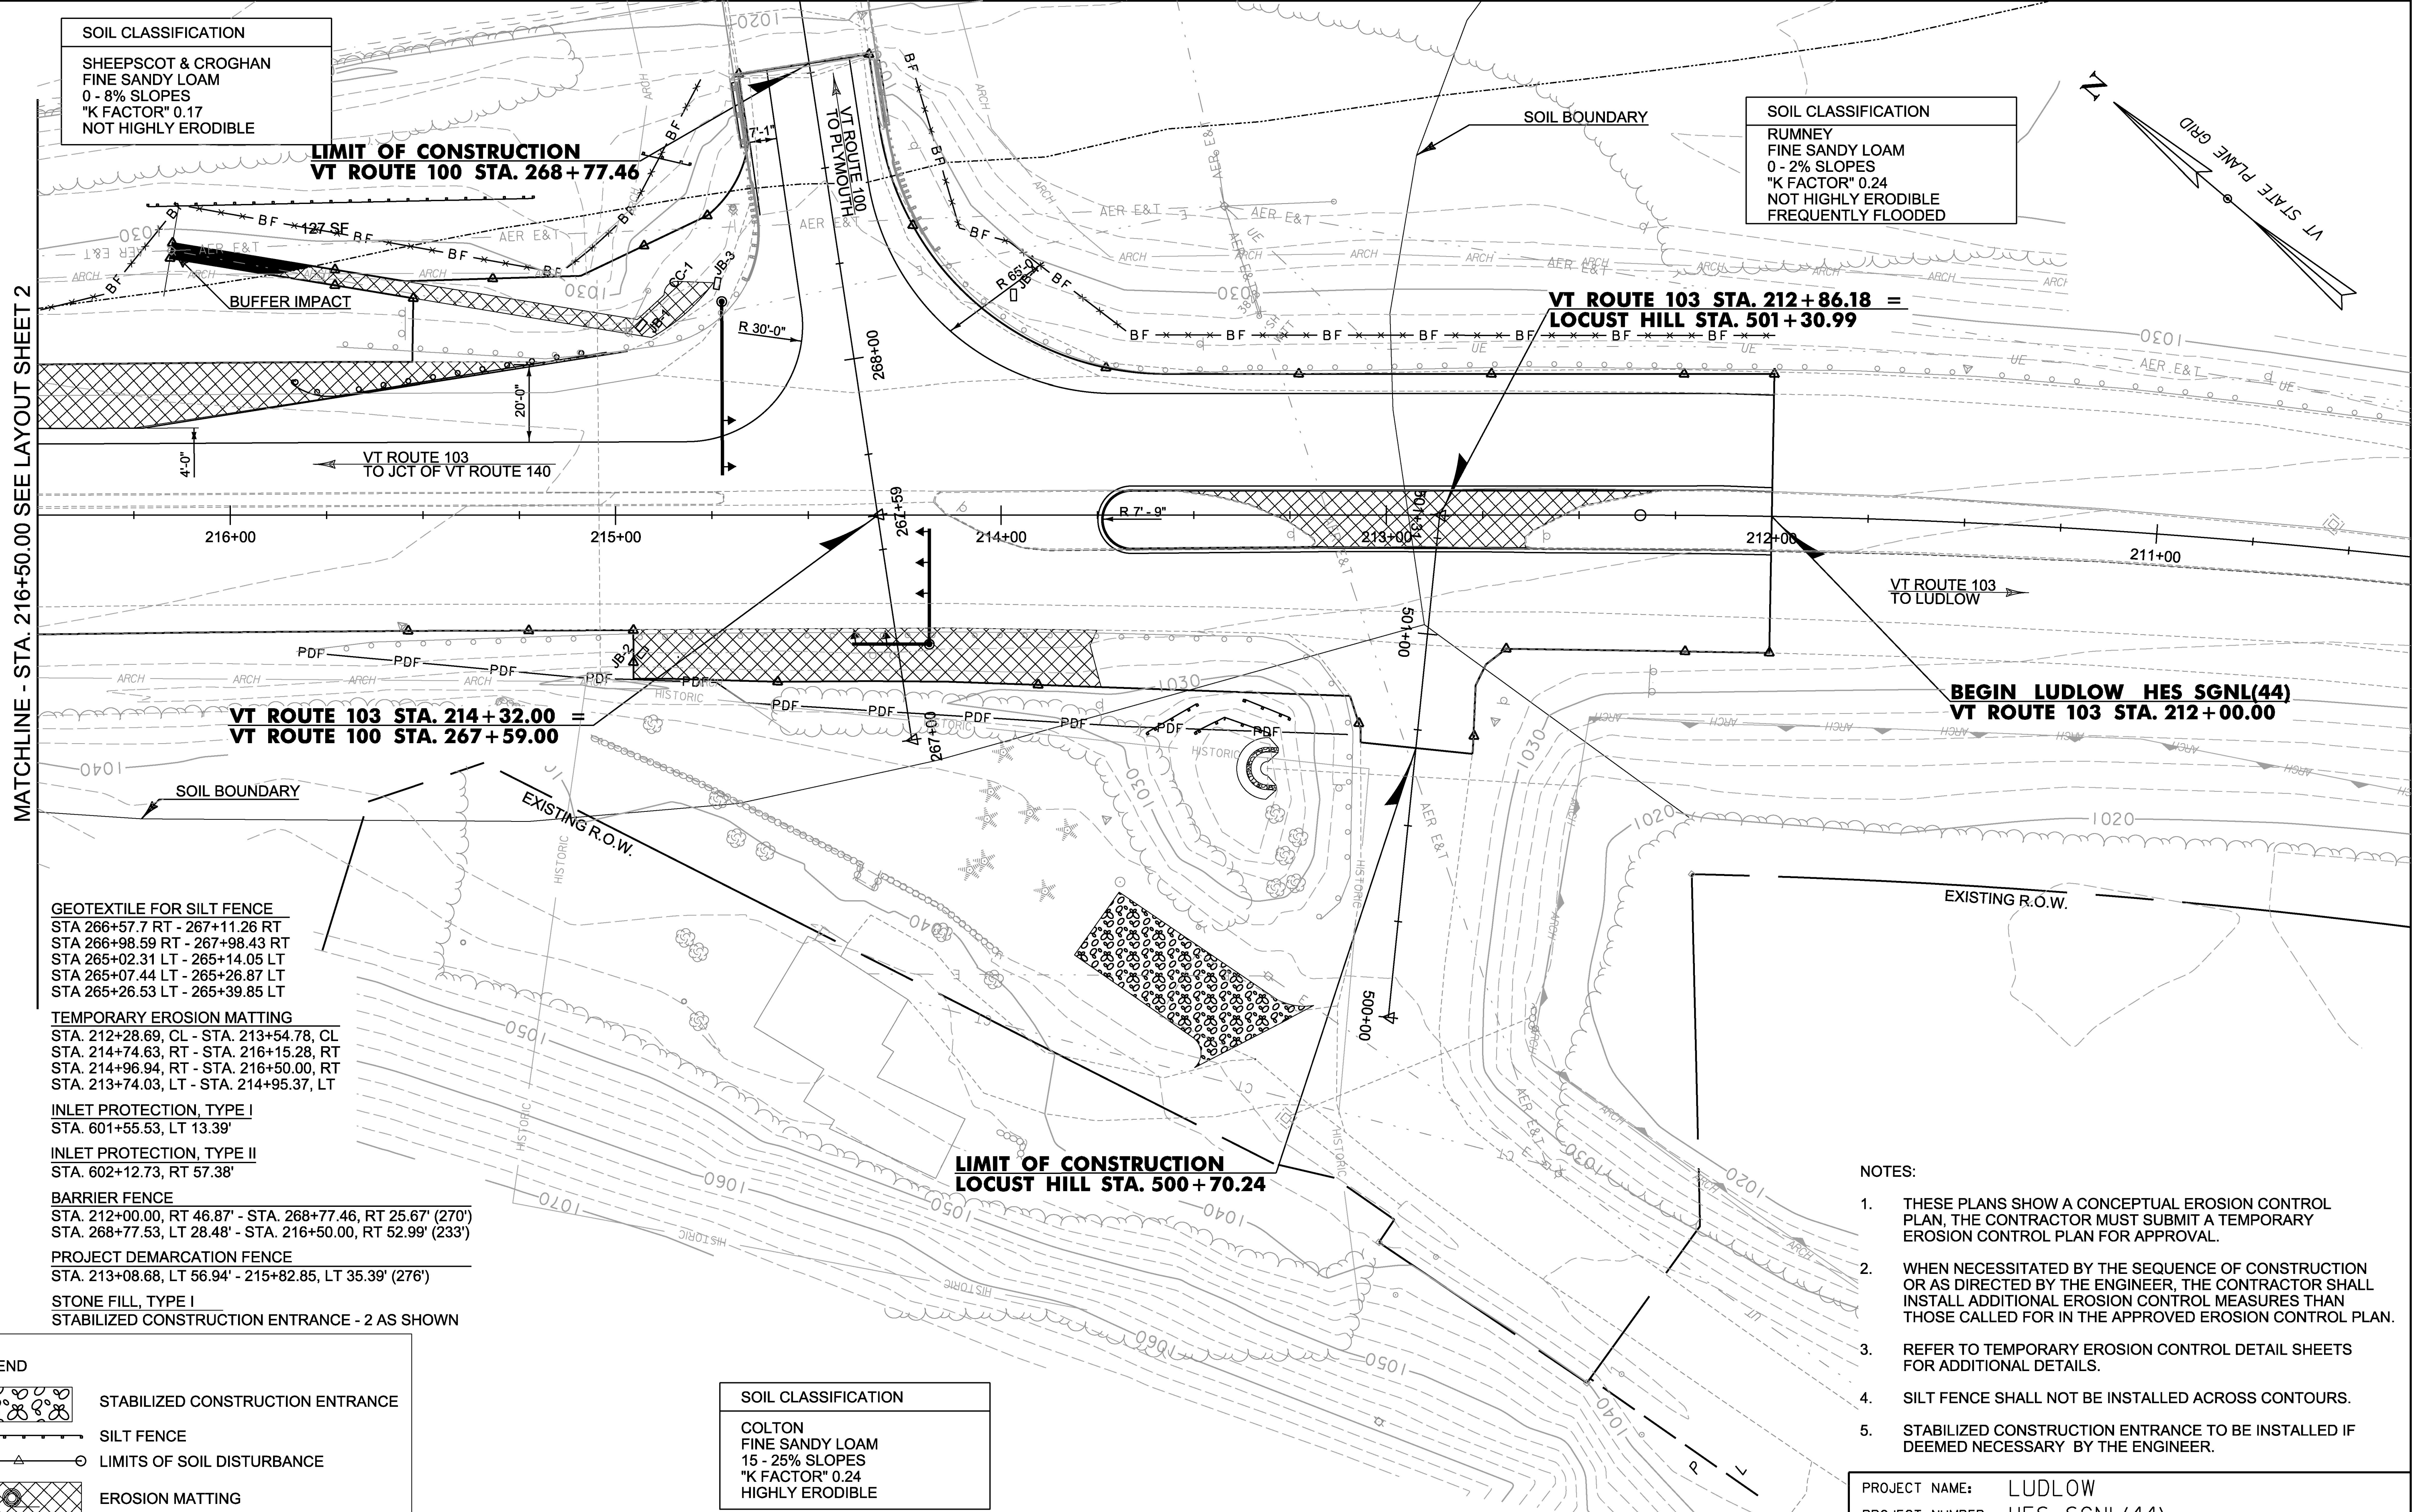


**SOIL CLASSIFICATION**  
 SHEEPSCOT & CROGHAN  
 FINE SANDY LOAM  
 0 - 8% SLOPES  
 "K FACTOR" 0.17  
 NOT HIGHLY ERODIBLE

**SOIL CLASSIFICATION**  
 RUMNEY  
 FINE SANDY LOAM  
 0 - 2% SLOPES  
 "K FACTOR" 0.24  
 NOT HIGHLY ERODIBLE  
 FREQUENTLY FLOODED

**SOIL CLASSIFICATION**  
 COLTON  
 FINE SANDY LOAM  
 15 - 25% SLOPES  
 "K FACTOR" 0.24  
 HIGHLY ERODIBLE


MATCHLINE - STA. 216+50.00 SEE LAYOUT SHEET 2

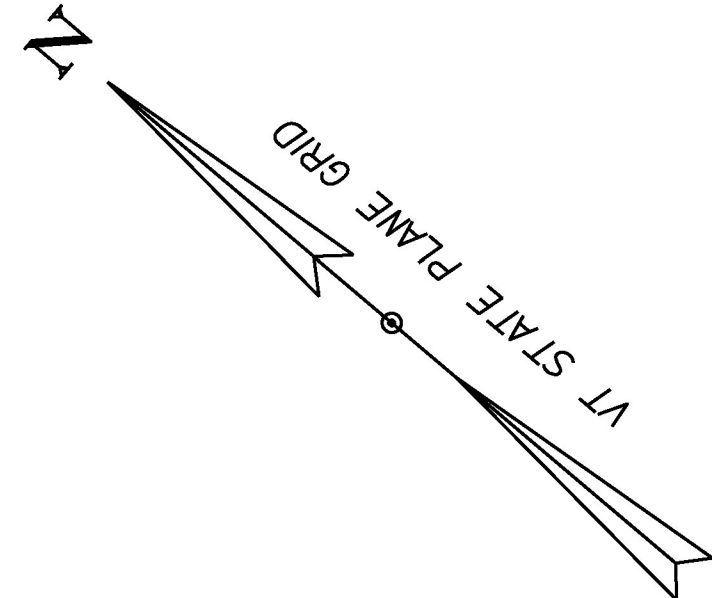

- GEOTEXTILE FOR SILT FENCE**  
 STA 266+57.7 RT - 267+11.26 RT  
 STA 266+98.59 RT - 267+98.43 RT  
 STA 265+02.31 LT - 265+14.05 LT  
 STA 265+07.44 LT - 265+26.87 LT  
 STA 265+26.53 LT - 265+39.85 LT
- TEMPORARY EROSION MATTING**  
 STA. 212+28.69, CL - STA. 213+54.78, CL  
 STA. 214+74.63, RT - STA. 216+15.28, RT  
 STA. 214+96.94, RT - STA. 216+50.00, RT  
 STA. 213+74.03, LT - STA. 214+95.37, LT
- INLET PROTECTION, TYPE I**  
 STA. 601+55.53, LT 13.39'
- INLET PROTECTION, TYPE II**  
 STA. 602+12.73, RT 57.38'
- BARRIER FENCE**  
 STA. 212+00.00, RT 46.87' - STA. 268+77.46, RT 25.67' (270')  
 STA. 268+77.53, LT 28.48' - STA. 216+50.00, RT 52.99' (233')
- PROJECT DEMARCATION FENCE**  
 STA. 213+08.68, LT 56.94' - 215+82.85, LT 35.39' (276')
- STONE FILL, TYPE I**  
 STABILIZED CONSTRUCTION ENTRANCE - 2 AS SHOWN

- LEGEND**
- STABILIZED CONSTRUCTION ENTRANCE
  - SILT FENCE
  - LIMITS OF SOIL DISTURBANCE
  - EROSION MATTING
  - BARRIER FENCE
  - PROJECT DEMARCATION FENCE

- NOTES:**
1. THESE PLANS SHOW A CONCEPTUAL EROSION CONTROL PLAN, THE CONTRACTOR MUST SUBMIT A TEMPORARY EROSION CONTROL PLAN FOR APPROVAL.
  2. WHEN NECESSITATED BY THE SEQUENCE OF CONSTRUCTION OR AS DIRECTED BY THE ENGINEER, THE CONTRACTOR SHALL INSTALL ADDITIONAL EROSION CONTROL MEASURES THAN THOSE CALLED FOR IN THE APPROVED EROSION CONTROL PLAN.
  3. REFER TO TEMPORARY EROSION CONTROL DETAIL SHEETS FOR ADDITIONAL DETAILS.
  4. SILT FENCE SHALL NOT BE INSTALLED ACROSS CONTOURS.
  5. STABILIZED CONSTRUCTION ENTRANCE TO BE INSTALLED IF DEEMED NECESSARY BY THE ENGINEER.

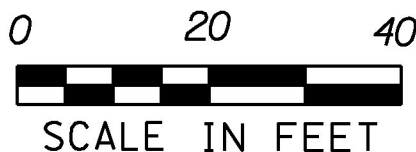

PROJECT NAME: LUDLOW  
 PROJECT NUMBER: HES SGNL(44)  
 FILE NAME: t13b020\_nul.dgn  
 PROJECT LEADER: P. COBURN  
 DESIGNED BY: M. BOGACZYK  
 EPSC CONSTRUCTION CONDITIONS SHEET 3  
 PLOT DATE: 4/25/2017  
 DRAWN BY: M. BOGACZYK  
 CHECKED BY: P. COBURN  
 SHEET 24 OF 43