

NOTES:


1. THESE PLANS SHOW A CONCEPTUAL EROSION CONTROL PLAN, THE CONTRACTOR MUST SUBMIT A TEMPORARY EROSION CONTROL PLAN FOR APPROVAL.
2. WHEN NECESSITATED BY THE SEQUENCE OF CONSTRUCTION OR AS DIRECTED BY THE ENGINEER, THE CONTRACTOR SHALL INSTALL ADDITIONAL EROSION CONTROL MEASURES THAN THOSE CALLED FOR IN THE APPROVED EROSION CONTROL PLAN.
3. REFER TO TEMPORARY EROSION CONTROL DETAIL SHEETS FOR ADDITIONAL DETAILS.
4. SILT FENCE SHALL NOT BE INSTALLED ACROSS CONTOURS.

SOIL CLASSIFICATION
PITS, SAND/PITS, GRAVEL

SOIL BOUNDARY

SOIL CLASSIFICATION
SHEEPSHOT & CROGHAN
FINE SANDY LOAM
0 - 8% SLOPES
"K FACTOR" 0.17
NOT HIGHLY ERODIBLE

SOIL CLASSIFICATION
COLTON
FINE SANDY LOAM
15 - 25% SLOPES
"K FACTOR" 0.24
HIGHLY ERODIBLE

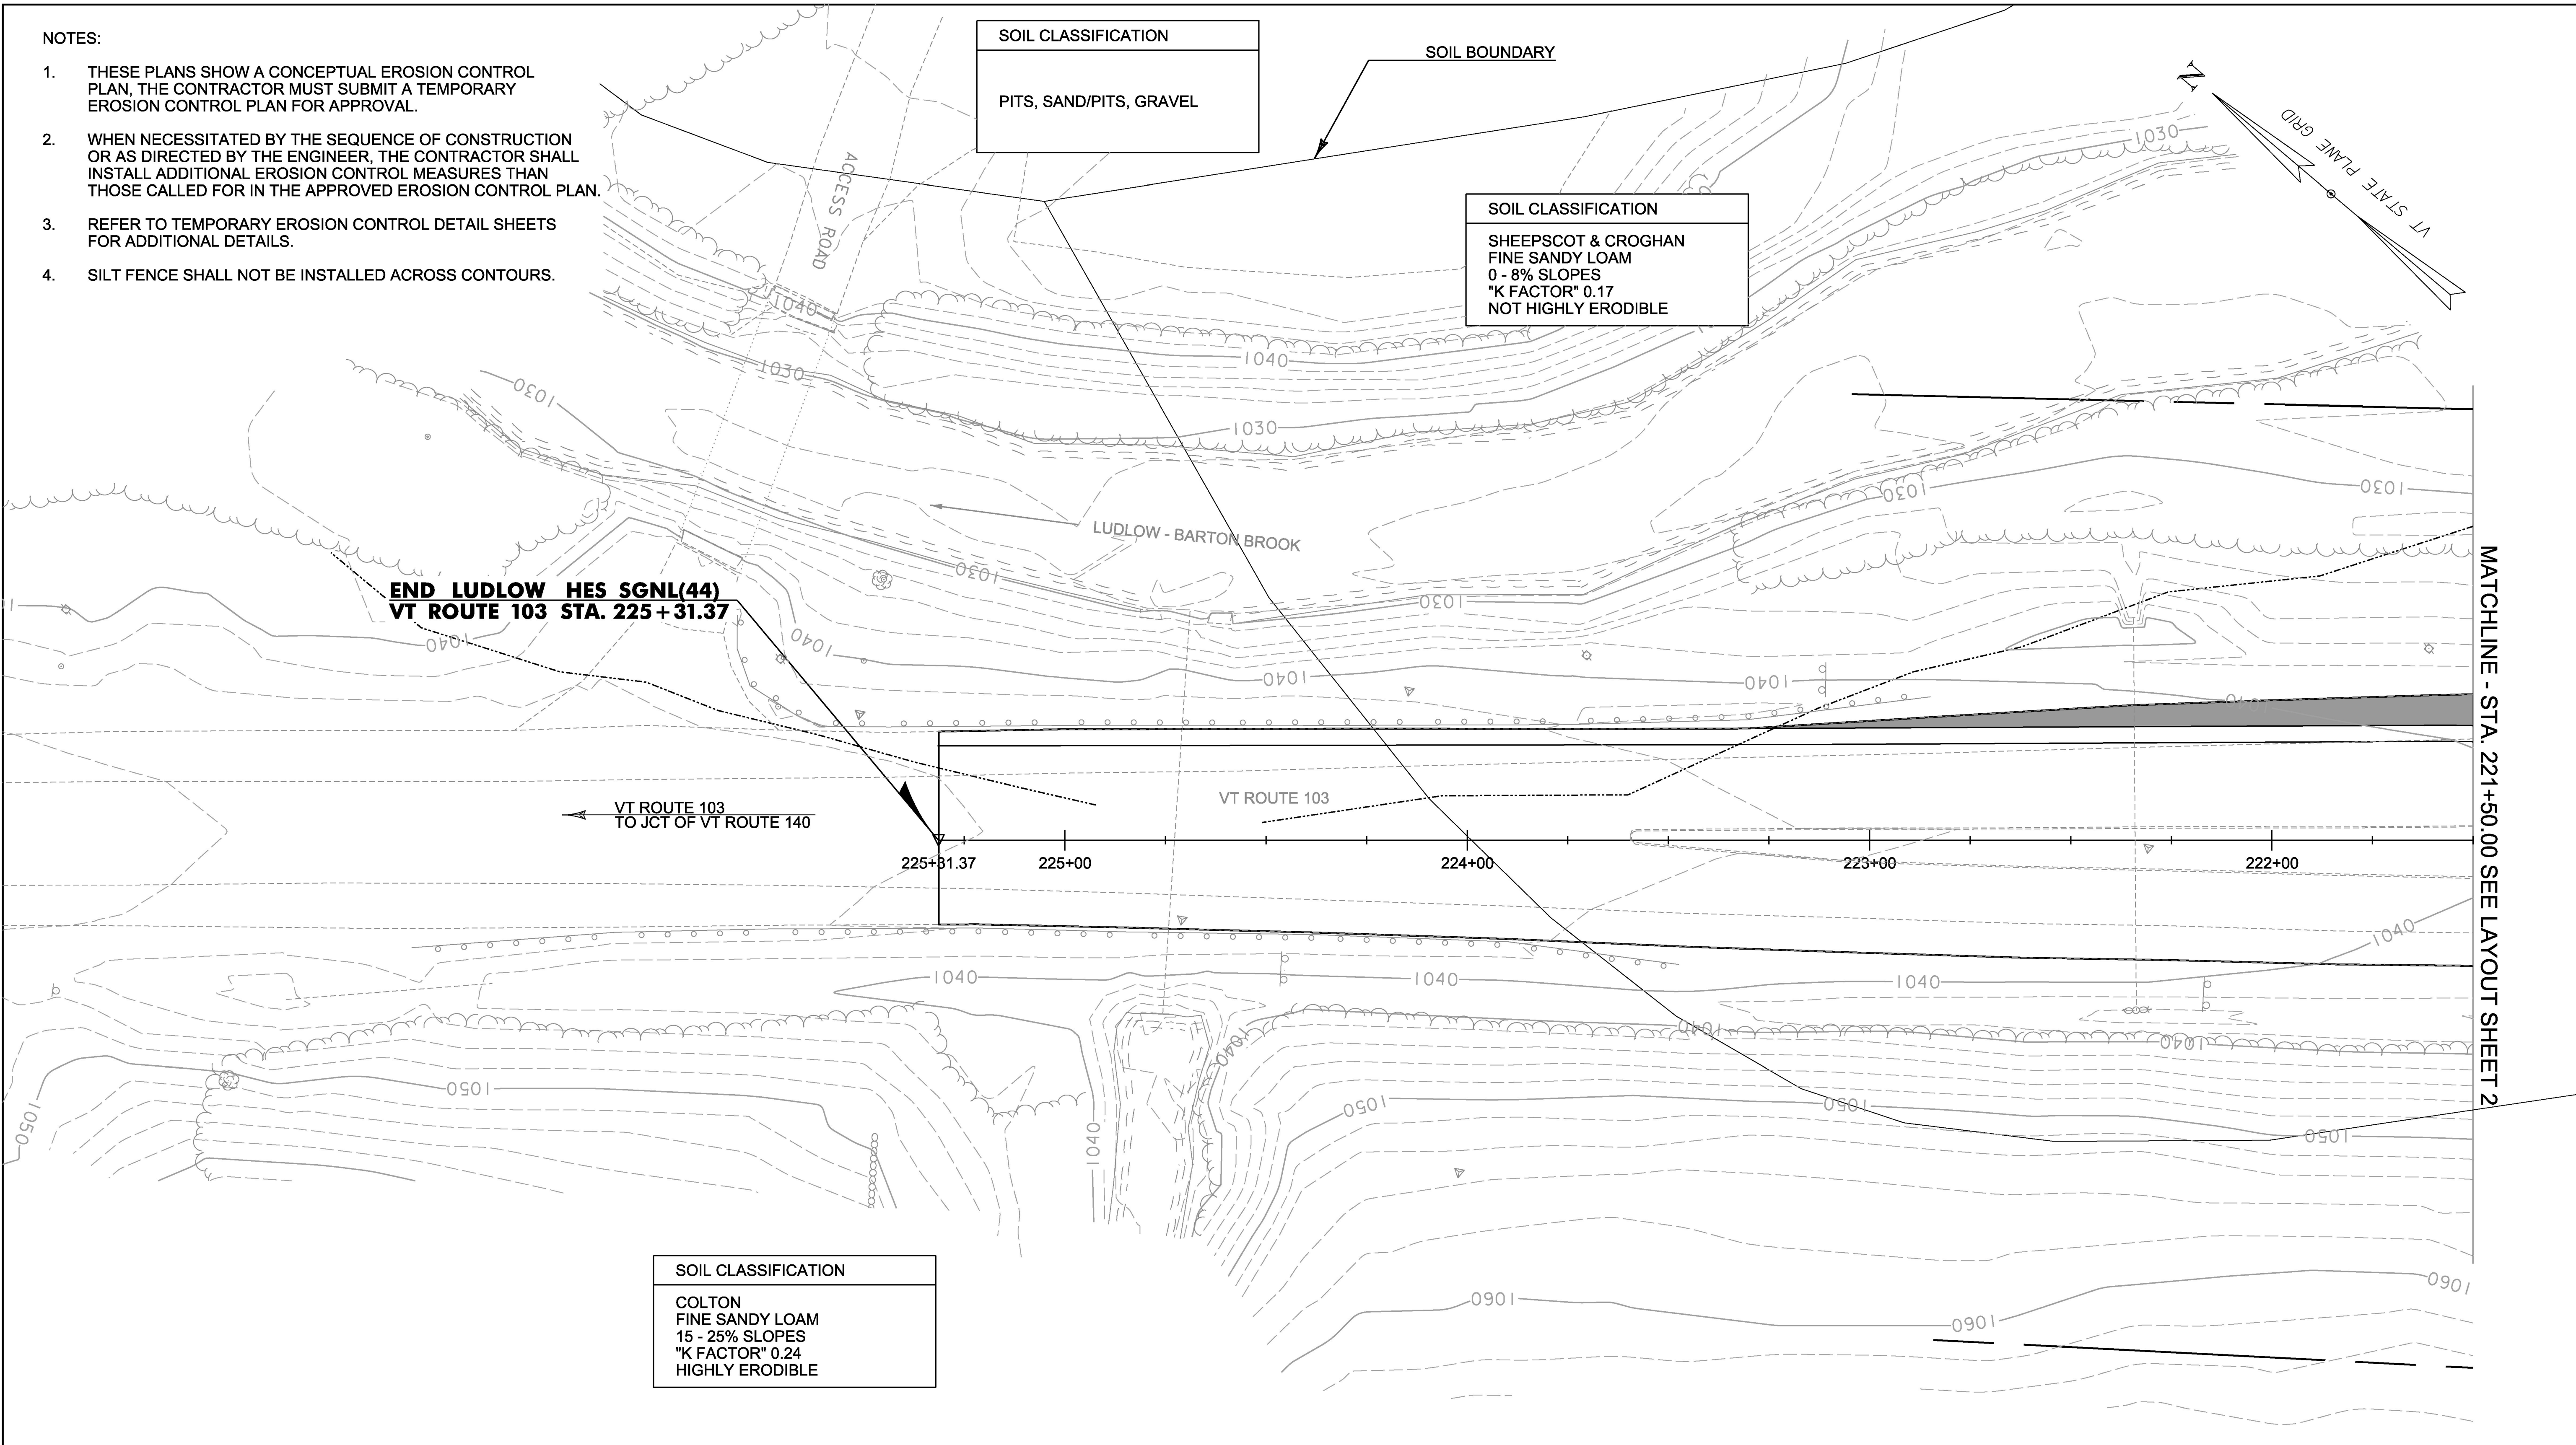

END LUDLOW HES SGNL(44)
VT ROUTE 103 STA. 225+31.37

VT ROUTE 103
TO JCT OF VT ROUTE 140

MATCHLINE - STA. 221+50.00 SEE LAYOUT SHEET 2

LEGEND

AREA REQUIRING REVEGETATION



PROJECT NAME: LUDLOW
PROJECT NUMBER: HES SGNL(44)

FILE NAME: t13b020_nul.dgn
PROJECT LEADER: P. COBURN
DESIGNED BY: M. BOGACZYK
EPSC FINAL CONDITIONS SHEET 1

PLOT DATE: 4/19/2017
DRAWN BY: M. BOGACZYK
CHECKED BY: P. COBURN
SHEET 25 OF 43