


MATCHLINE - STA. 216+50.00 SEE TRAFFIC SIGNS & MARKINGS SHEET 2

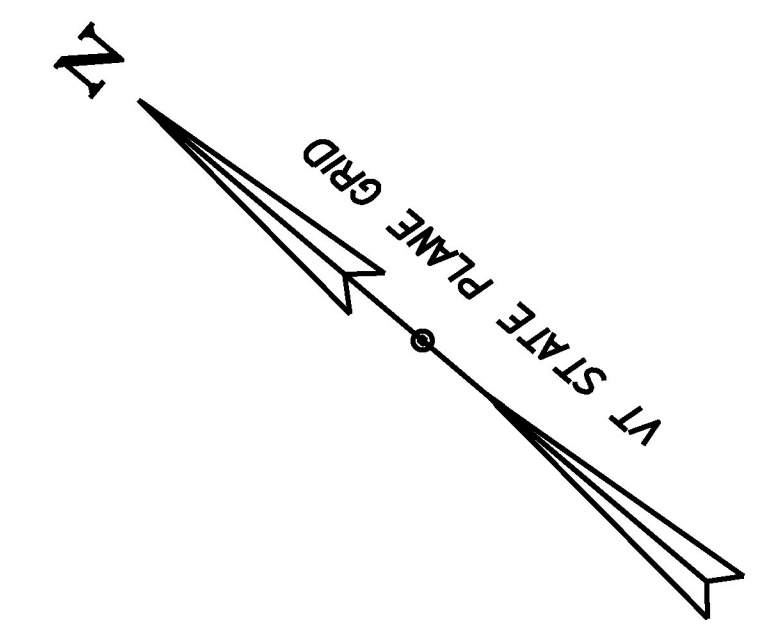

- REMOVING SIGNS**
 21 - AS SHOWN
 TRAFFIC SIGN, TYPE A
 19 - SEE TRAFFIC SIGN SUMMARY SHEET
 REMOVE STOP AHEAD SIGN (W3-1)
 STA. 275+72.16, LT (VT ROUTE 100)
 INSTALL SIGNAL AHEAD SIGN (W3-3)
 STA. 203+10.20, RT (VT ROUTE 103)
 STA. 275+72.16, LT (VT ROUTE 100)

Existing object marker was two signs back-to-back

A salvaged "Scenic Route 100 Byway" sign was moved to the same location.

A salvaged mile marker was moved to the same location.


- PAINTED CURB**
 STA. 212+28.69, RT 6.57' - STA. 213+73.86, LT 1.02' (150')
 STA. 212+62.41, LT 8.72' - STA. 213+73.86, LT 1.02' (116')
- 4 INCH WHITE LINE, WATERBORNE PAINT**
 STA. 268+77.46, LT 11.16' - STA. 216+50.00, RT 18.48' (SOLID) (555')
- 4 INCH YELLOW LINE, WATERBORNE PAINT**
 STA. 212+00.00, RT 7.41' - STA. 213+74.86, CL (SOLID)(182')
 STA. 212+00.00, LT 9.99' - STA. 213+74.86, CL (SOLID)(182')
 STA. 500+70.24, CL - STA. 500+95.24, CL (DOUBLE)(50')
- 8 INCH WHITE LINE, WATERBORNE PAINT**
 STA. 214+57.06, RT 31.67' - STA. 216+22.70, RT 18.58' (DIAGONAL)(352')
- 24 INCH STOP BAR, WATERBORNE PAINT**
 STA. 213+64.93, RT (24')
 STA. 214+74.06, LT (24')
 STA. 268+14.02, LT (11')
 STA. 500+94.48, RT (16')
- LETTER OR SYMBOL, WATERBORNE PAINT**
 STA. 213+56.68, RT "A"
 STA. 500+86.54, RT "P"



PROJECT NAME: LUDLOW
 PROJECT NUMBER: HES SGNL(44)
 FILE NAME: t13b020.tsl.dgn PLOT DATE: 4/19/2017
 PROJECT LEADER: P. COBURN DRAWN BY: M. BOGACZYK
 DESIGNED BY: M. BOGACZYK CHECKED BY: P. COBURN
 SIGNS & PAVEMENT MARKINGS SHEET 3 SHEET 30 OF 43

- REMOVAL OF EXISTING PAVEMENT MARKINGS**
 STA. 268+16.68, LT 8.33' "STOP"
 STA. 268+06.59, LT 1.10' - STA. 268+10.62, LT 27.09' (STOP BAR)
 STA. 268+77.46, LT 11.16' - STA. 216+22.70, RT 18.58' (4" WHITE LINE)
 STA. 275+75.00, LT "STOP AHEAD"
 STA. 212+06.08, RT "A"

SIGN LEGEND	
R	= REMOVE
S	= SALVAGE
N	= NEW
SS	= SET SALVAGED
B-B	= BACK TO BACK
EXISTING	=
NEW	=

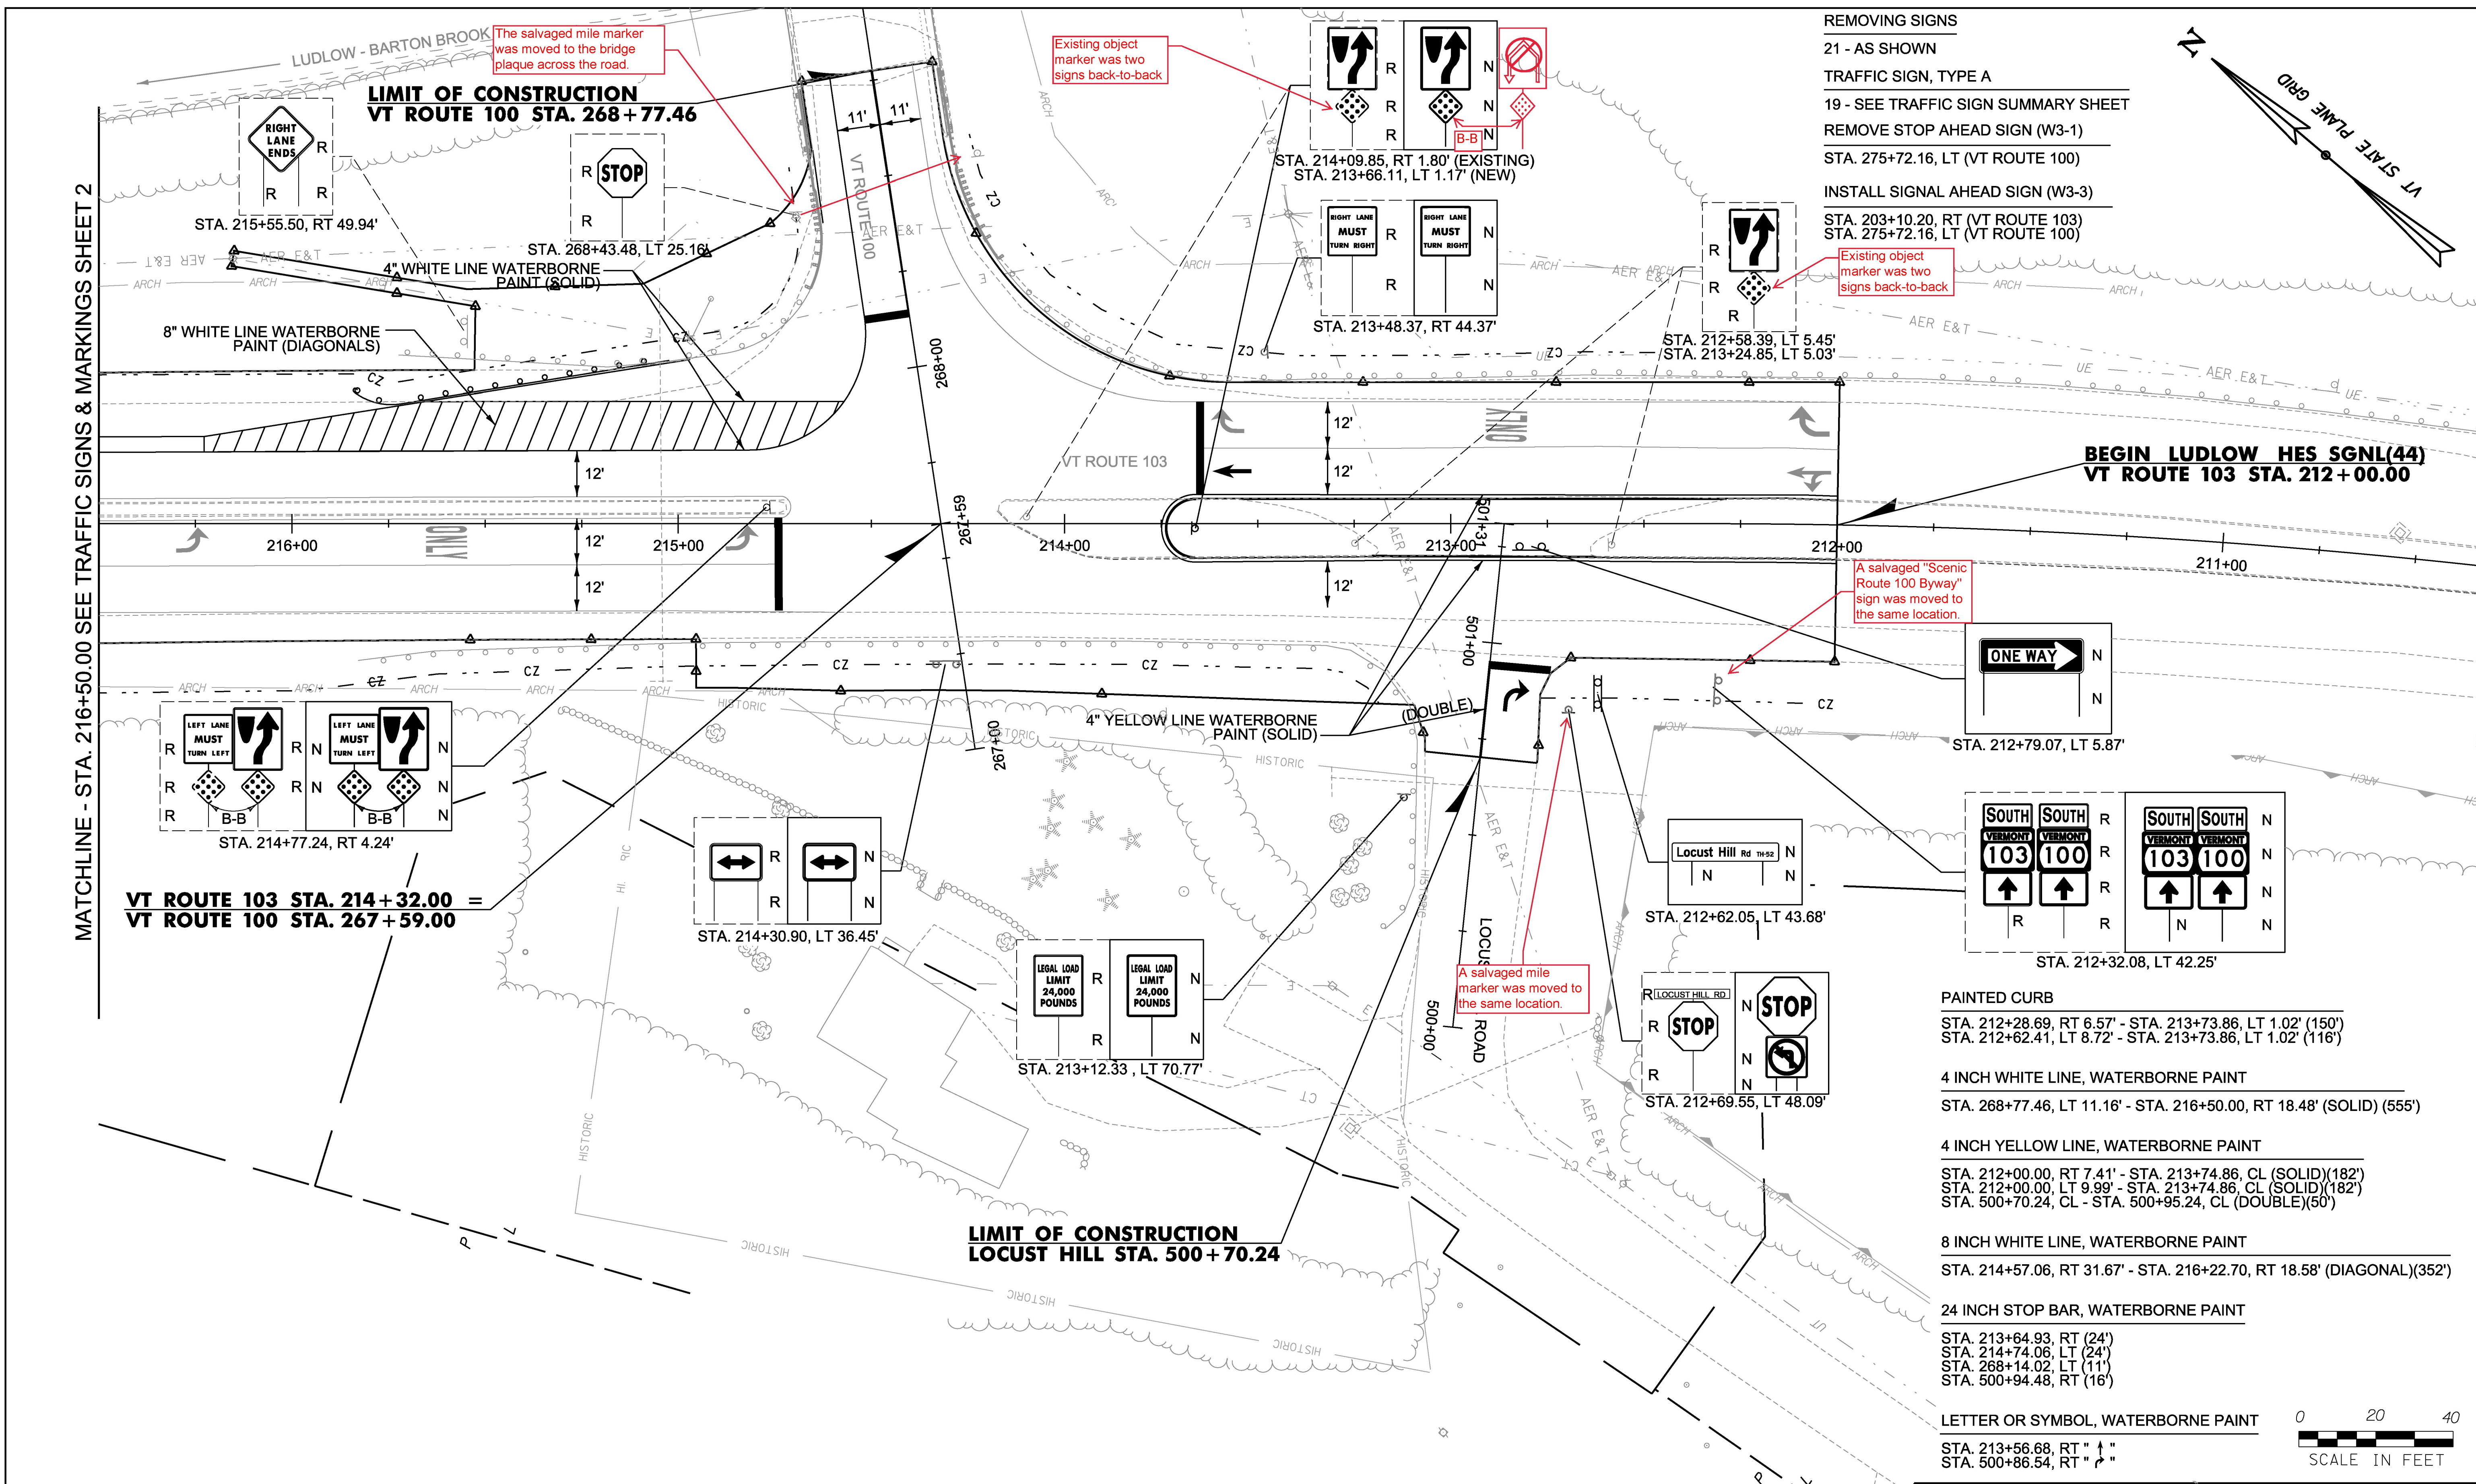

LIMIT OF CONSTRUCTION
 VT ROUTE 100 STA. 268 + 77.46

LIMIT OF CONSTRUCTION
 LOCUST HILL STA. 500 + 70.24

VT ROUTE 103 STA. 214 + 32.00 =
VT ROUTE 100 STA. 267 + 59.00

BEGIN LUDLOW HES SGNL(44)
 VT ROUTE 103 STA. 212 + 00.00