


# SPECIFICATIONS/DATA

## 13" x 24" PG Style (Stackable) Assembly

### Covers (Blank unless logo is specified)

DESCRIPTION	PART NO.	WEIGHT #	DESIGN/TEST LOAD #	ANSI TIER
W/2 Bolts	PG1324CA00	32 (14.5 kg)	8,000 / 12,000	8
Gasketed w/2 Bolts	PG1324CG00	32 (14.5 kg)	8,000 / 12,000	8
No Bolts	PG1324WA00	32 (14.5 kg)	8,000 / 12,000	8
Heavy Duty w/2 Bolts	PG1324HA00	49 (22.2 kg)	15,000 / 22,500	15
Gasketed Heavy Duty w/2 Bolts	PG1324HG00	49 (22.2 kg)	15,000 / 22,500	15
Extra Heavy Duty w/2 Bolts	PG1324HH00	49 (22.2 kg)	22,500 / 33,750	15*

- Covers with meter lids available upon request.
- Gasketed covers and bolt grommets must be used with a gasketed box. Gaskets reduce the inflow of fluids but do not make the enclosure water tight.
- \*Loadings for HH covers comply with all test provisions of ANSI/SCTE 77 except that the vertical design load is 22,500 lbs. with a test load of 33,750 lbs. over a 10" x 20" plate.

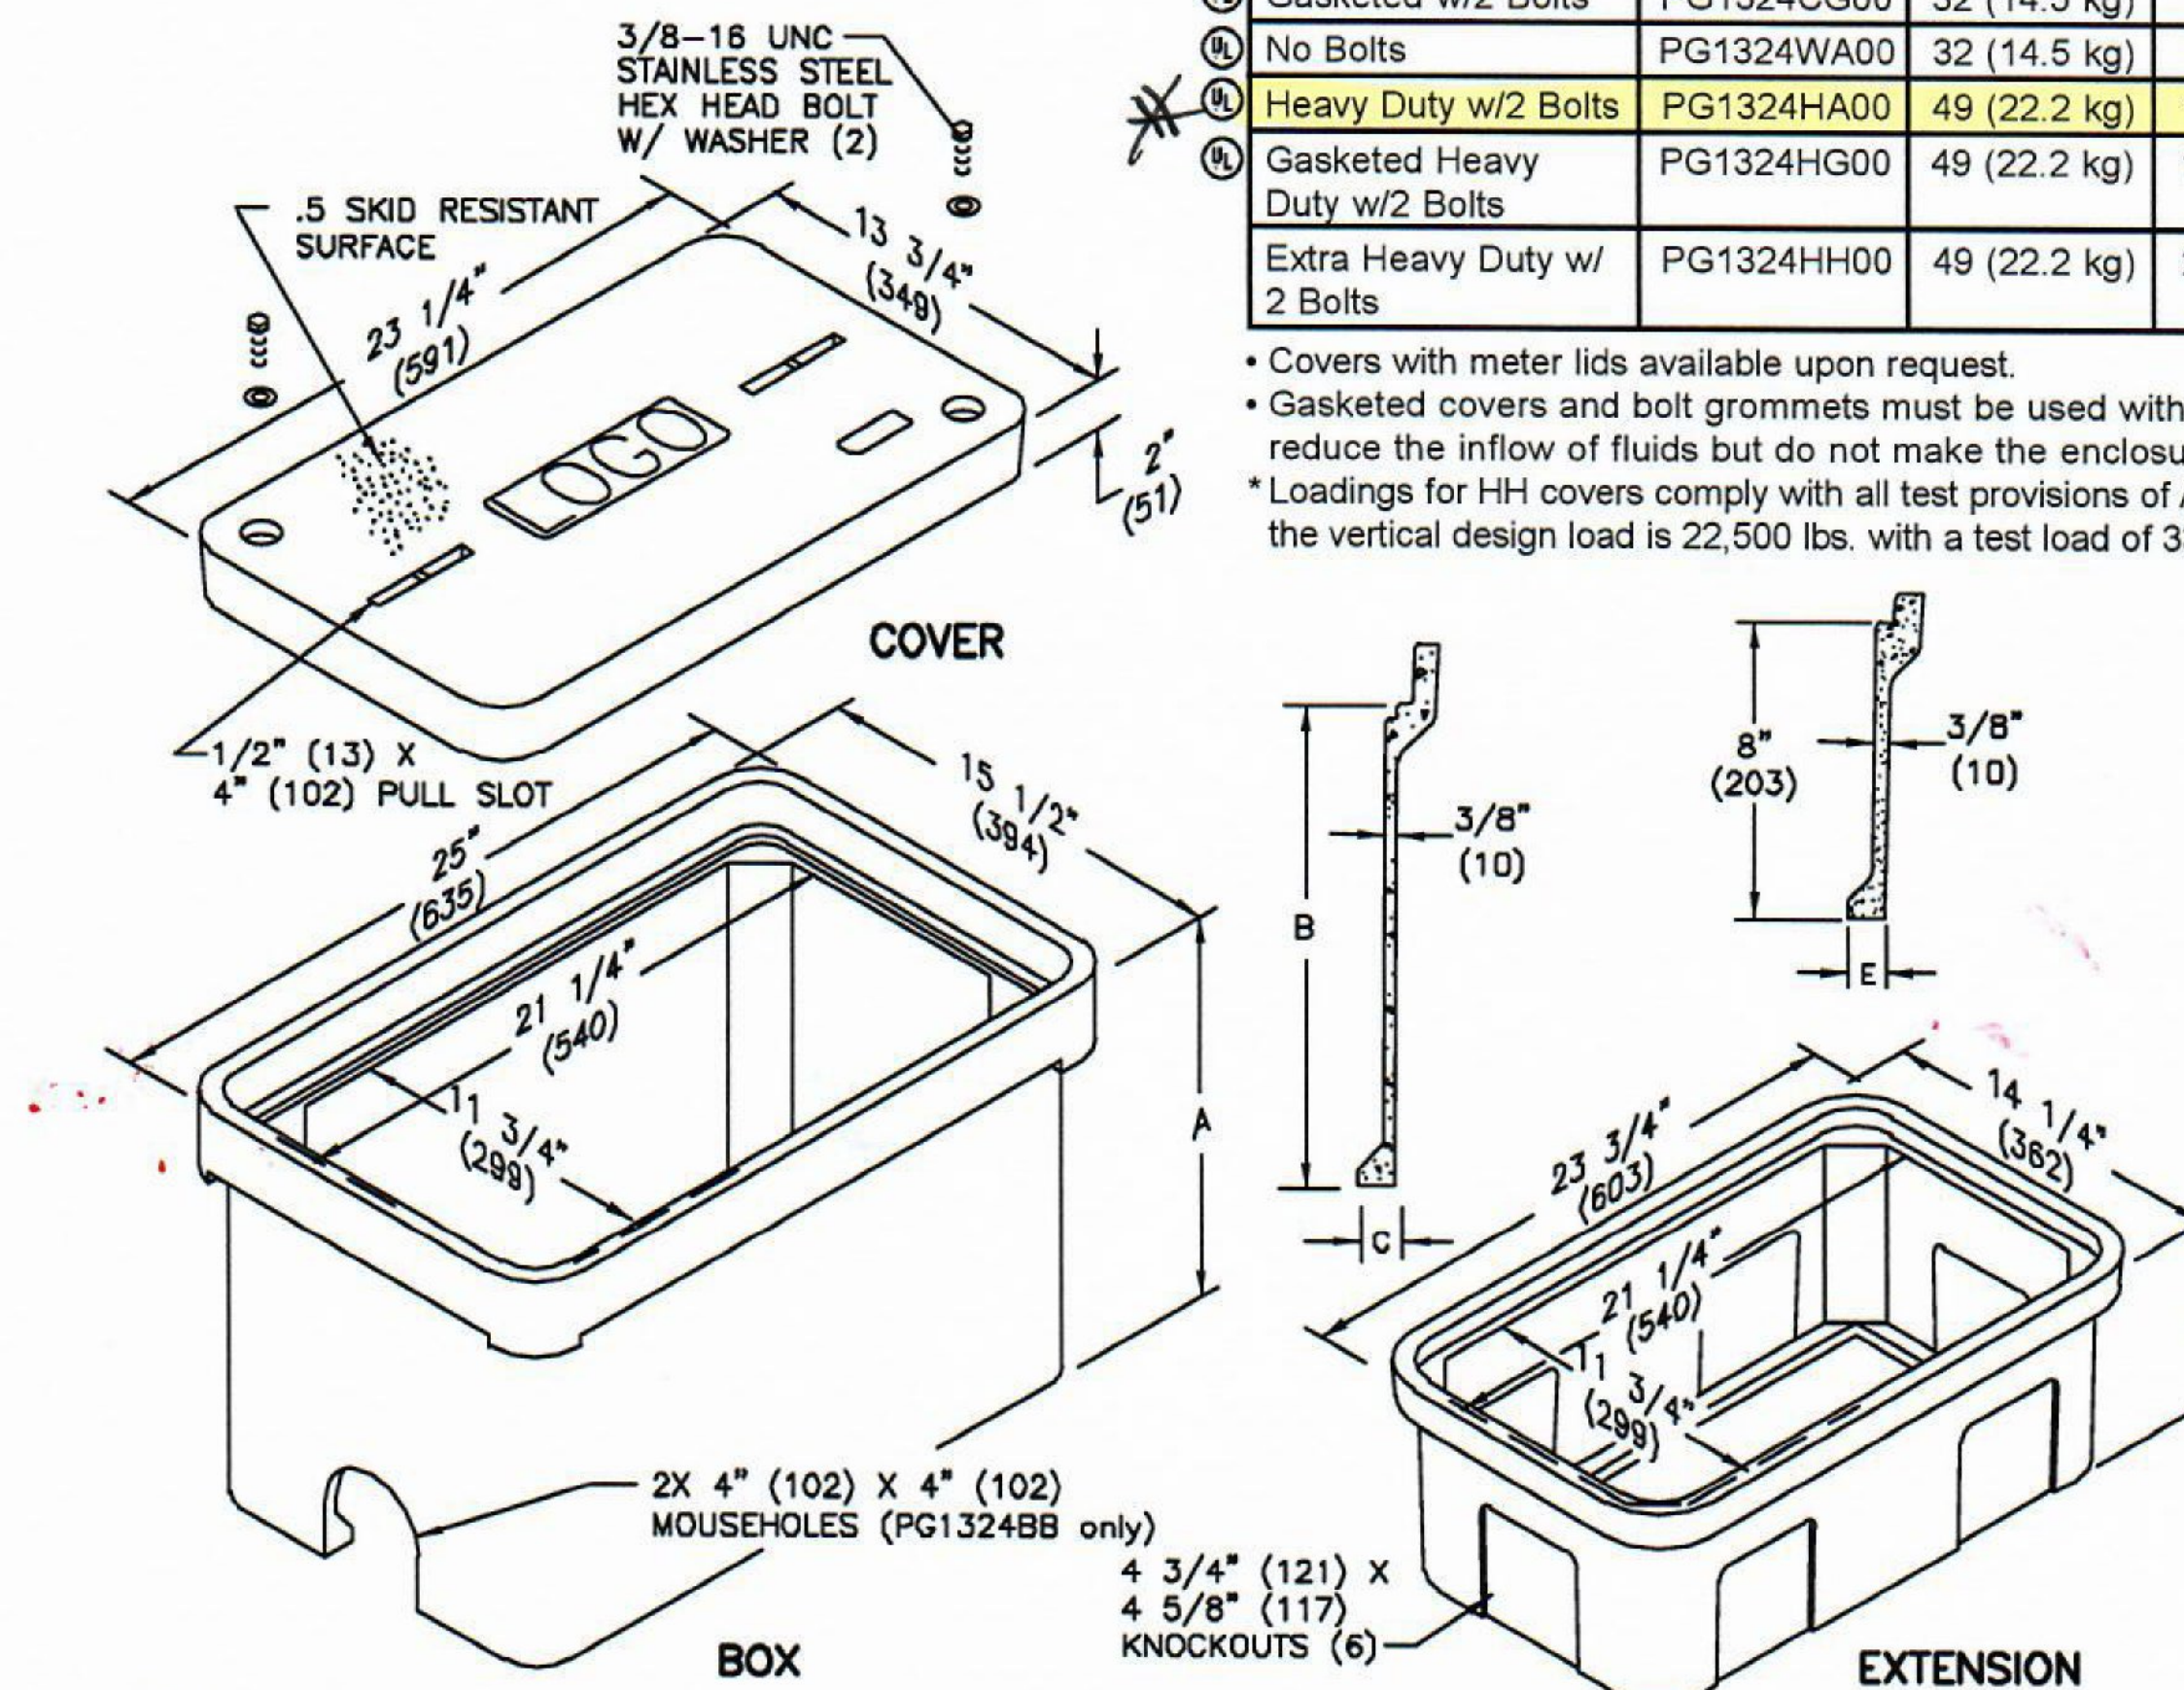

### Boxes (Stackable with self-aligning, replaceable EZ-Nut)

DESCRIPTION	PART NO.	WEIGHT #	DIMENSION A	DIMENSION B	DIMENSION C	DESIGN/TEST LOAD #	ANSI TIER
Open Bottom	PG1324BA12	53 (24.0 kg)	12" (305 mm)	10" (254 mm)	1 1/4" (32 mm)	22,500 / 33,750	15*
	PG1324BA18	72 (33 kg)	18" (457 mm)	16" (406 mm)	1 1/4" (32 mm)	22,500 / 33,750	15*
Open Bottom w/ Gasket	PG1324BG12	53 (24.0 kg)	12" (305 mm)	10" (254 mm)	1 1/4" (32 mm)	22,500 / 33,750	15*
	PG1324BG18	72 (33 kg)	18" (457 mm)	16" (406 mm)	1 1/4" (32 mm)	22,500 / 33,750	15*
Open Bottom w/ 2 Mouseholes	PG1324BB12	53 (24.0 kg)	12" (305 mm)	10" (254 mm)	1 1/4" (32 mm)	22,500 / 33,750	15*
	PG1324BB18	72 (33.0 kg)	18" (457 mm)	16" (406 mm)	1 1/4" (32 mm)	22,500 / 33,750	15*
Solid Bottom	PG1324DA12	63 (28.6 kg)	12 1/2" (318mm)	10" (254 mm)	N/A	22,500 / 33,750	15*
	PG1324DA18	85 (39 kg)	18 1/2" (470 mm)	16" (406 mm)	N/A	22,500 / 33,750	15*
Solid Bottom w/ Gasket	PG1324DG12	63 (28.6 kg)	12 1/2" (318mm)	10" (254 mm)	N/A	22,500 / 33,750	15*
	PG1324DG18	85 (39 kg)	18 1/2" (470 mm)	16" (406 mm)	N/A	22,500 / 33,750	15*

\* Loadings comply with ANSI/SCTE 77. These boxes meet and exceed ANSI Tier 15 test provisions.

### Extensions (For use under box only, one per box. For grade adjustable extension see page 44.)

DESCRIPTION	PART NO.	WEIGHT #	DIMENSION D	DIMENSION E	DESIGN/TEST LOAD #	ANSI TIER
Open Bottom	PG1324EA08	25 (11.3 kg)	8 3/4" (222 mm)	1" (25 mm)	22,500 / 33,750	15*
Solid Bottom	PG1324RA08	35 (15.9 kg)	9 1/4" (235 mm)	N/A	22,500 / 33,750	15*

\* Loadings comply with ANSI/SCTE 77. These extensions meet and exceed ANSI Tier 15 test provisions. Dimensions & weights in parentheses are metric equivalent.