
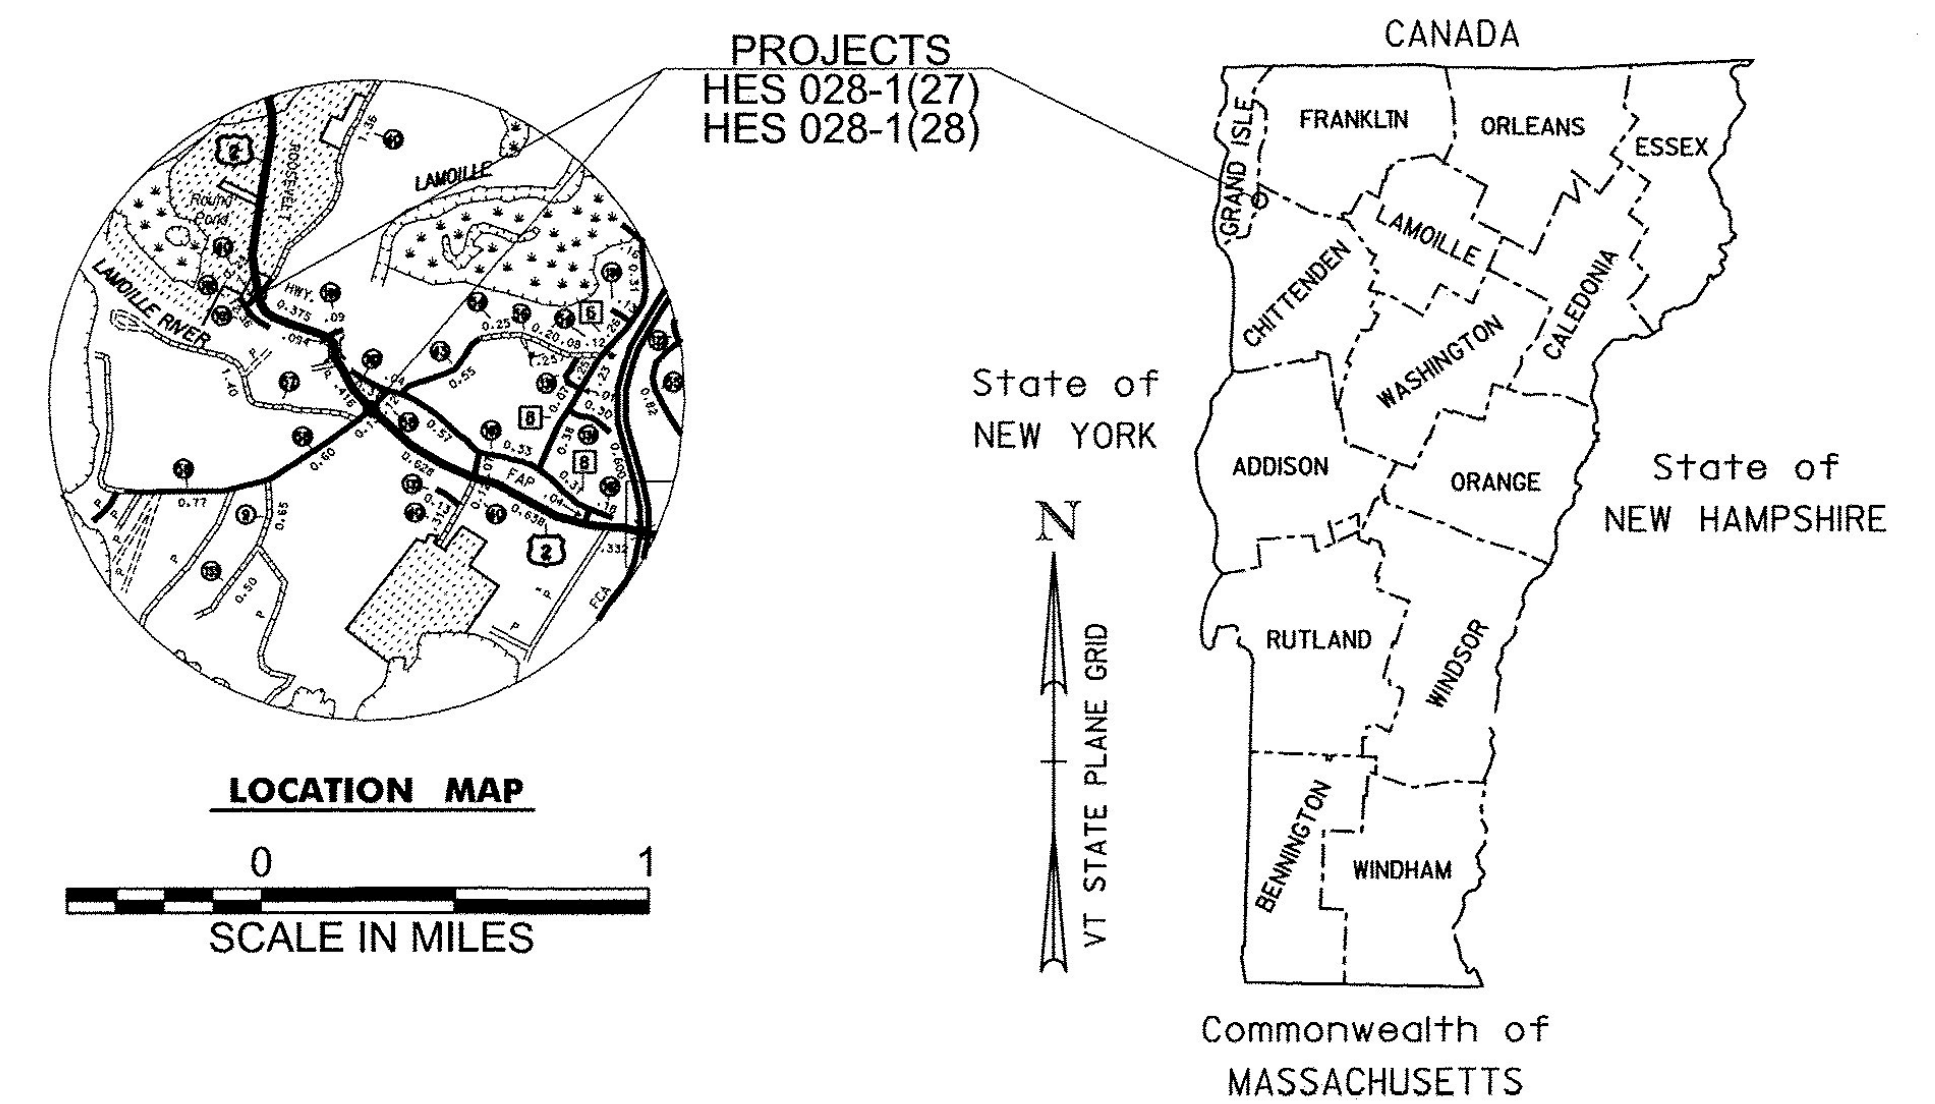


TABLE OF CONTENTS

SHEET 1	COMPOSITE TITLE SHEET
SHEET 2	CONVENTIONAL SYMBOLOGY SHEET
SHEET 3	TIE SHEET
SHEETS 4-5	COMPOSITE QUANTITY SHEETS
SHEETS 6-11	MILTON HES 028-1(27)
SHEETS 12-91	COLCHESTER HES 028-1(28)

STATE OF VERMONT AGENCY OF TRANSPORTATION

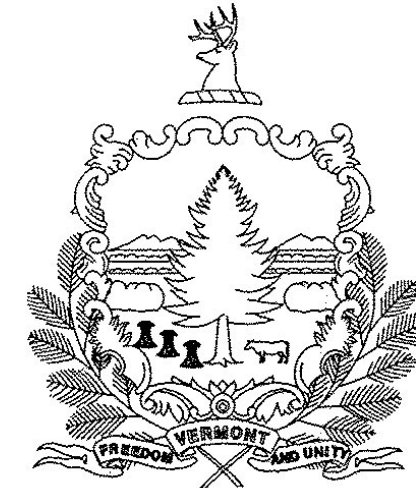

Record Plans
 Contractor: G.W. TATRO CONSTRUCTION, INC.
 Resident Engineer: CHRIS ACHILLES
 Construction Began: APRIL 18, 2016
 Construction Complete: NOVEMBER 23, 2016
 Record Plans By: CHRIS ACHILLES & JESSE IVES

I hereby certify that all construction required by this set of drawings has been accomplished as indicated herein.

E-SIGNED by Christopher Achilles on 2019-04-05 12:11:33 UTC
 BY: _____ Resident Engineer

Date: April 05, 2019

NOTE: Any further information concerning final quantities, amounts or other details relative to this project may be found at Central Files in the electronic archives.

PROPOSED IMPROVEMENT TOWNS OF MILTON AND COLCHESTER COUNTY OF CHITTENDEN US ROUTE 2 - (MINOR ARTERIAL)

RECORD PLANS
 See Changes on Pages 57, 60, 63-70

MILTON HES 028-1(27):
 BEGINNING IN THE TOWN OF MILTON ON US ROUTE 2 AT STATION 161+50.00 (MM 3.059) AND EXTENDING EASTERLY 0.317 MILES TO STATION 178+25.00 (MM 3.376)


TOTAL LENGTH OF PROJECT = 1675.00 FT = 0.317 MI

WORK TO BE PERFORMED UNDER THIS PROJECT INCLUDES THE INSTALLATION OF NEW TRAFFIC SIGNS.

COLCHESTER HES 028-1(28):
 BEGINNING IN THE TOWN OF COLCHESTER ON US ROUTE 2 AT STATION 12+82.04 (MM 0.243) EXTENDING EASTERLY 0.347 MILES TO STATION 31+11.91 (MM 0.589).


TOTAL LENGTH OF PROJECT = 1829.87 FT = 0.347 MI

WORK TO BE PERFORMED UNDER THIS PROJECT INCLUDES THE CONSTRUCTION OF TWO LEFT HAND TURN LANES, PAVEMENT MARKINGS, TRAFFIC SIGNS, AND OTHER HIGHWAY RELATED ITEMS.

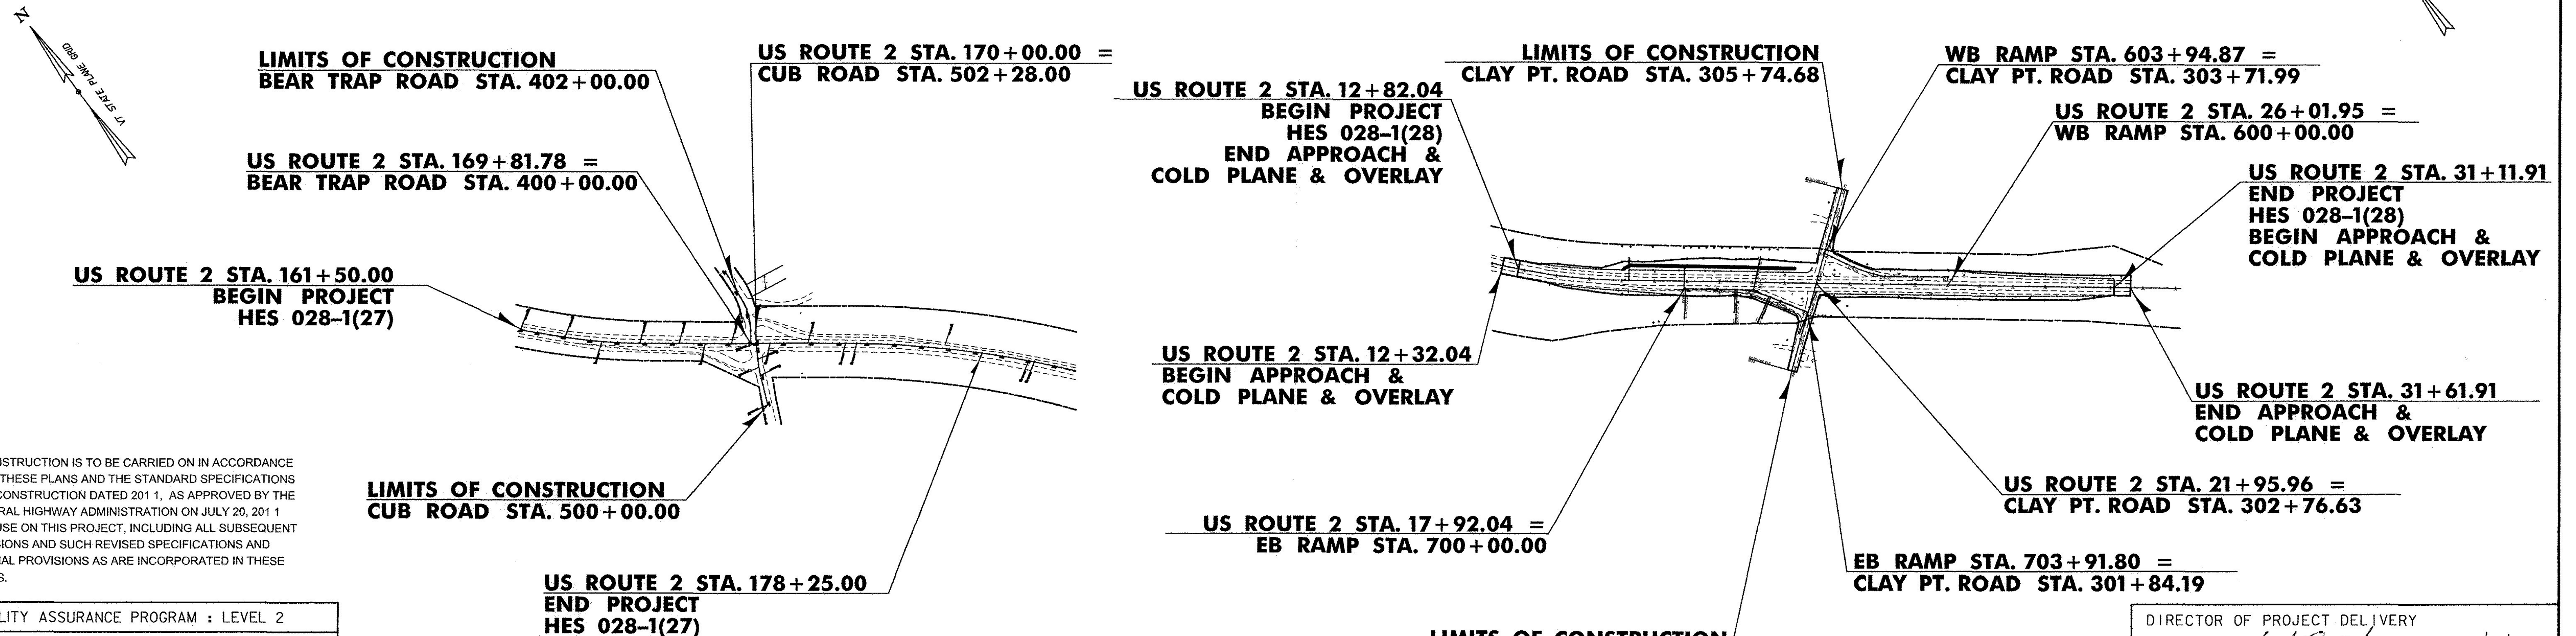

CONSTRUCTION IS TO BE CARRIED ON IN ACCORDANCE WITH THESE PLANS AND THE STANDARD SPECIFICATIONS FOR CONSTRUCTION DATED 2011, AS APPROVED BY THE FEDERAL HIGHWAY ADMINISTRATION ON JULY 20, 2011 FOR USE ON THIS PROJECT, INCLUDING ALL SUBSEQUENT REVISIONS AND SUCH REVISED SPECIFICATIONS AND SPECIAL PROVISIONS AS ARE INCORPORATED IN THESE PLANS.

QUALITY ASSURANCE PROGRAM : LEVEL 2	
SURVEYED BY :	VTRANS, L. ORVIS
SURVEYED DATE :	MARCH 2013
DATUM	
VERTICAL	NAVD 88 ORTHO
HORIZONTAL	NAD 83 (2011)

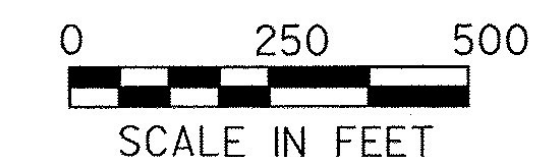

DIRECTOR OF PROJECT DELIVERY	
APPROVED: _____	DATE: 11/20/2015
PROJECT MANAGER : PATTI COBURN, P.E.	
PROJECT NAME : MILTON & COLCHESTER	
PROJECT NUMBER : HES 028-1(27) & 028-1(28)	
SHEET 1 OF 91 SHEETS	