
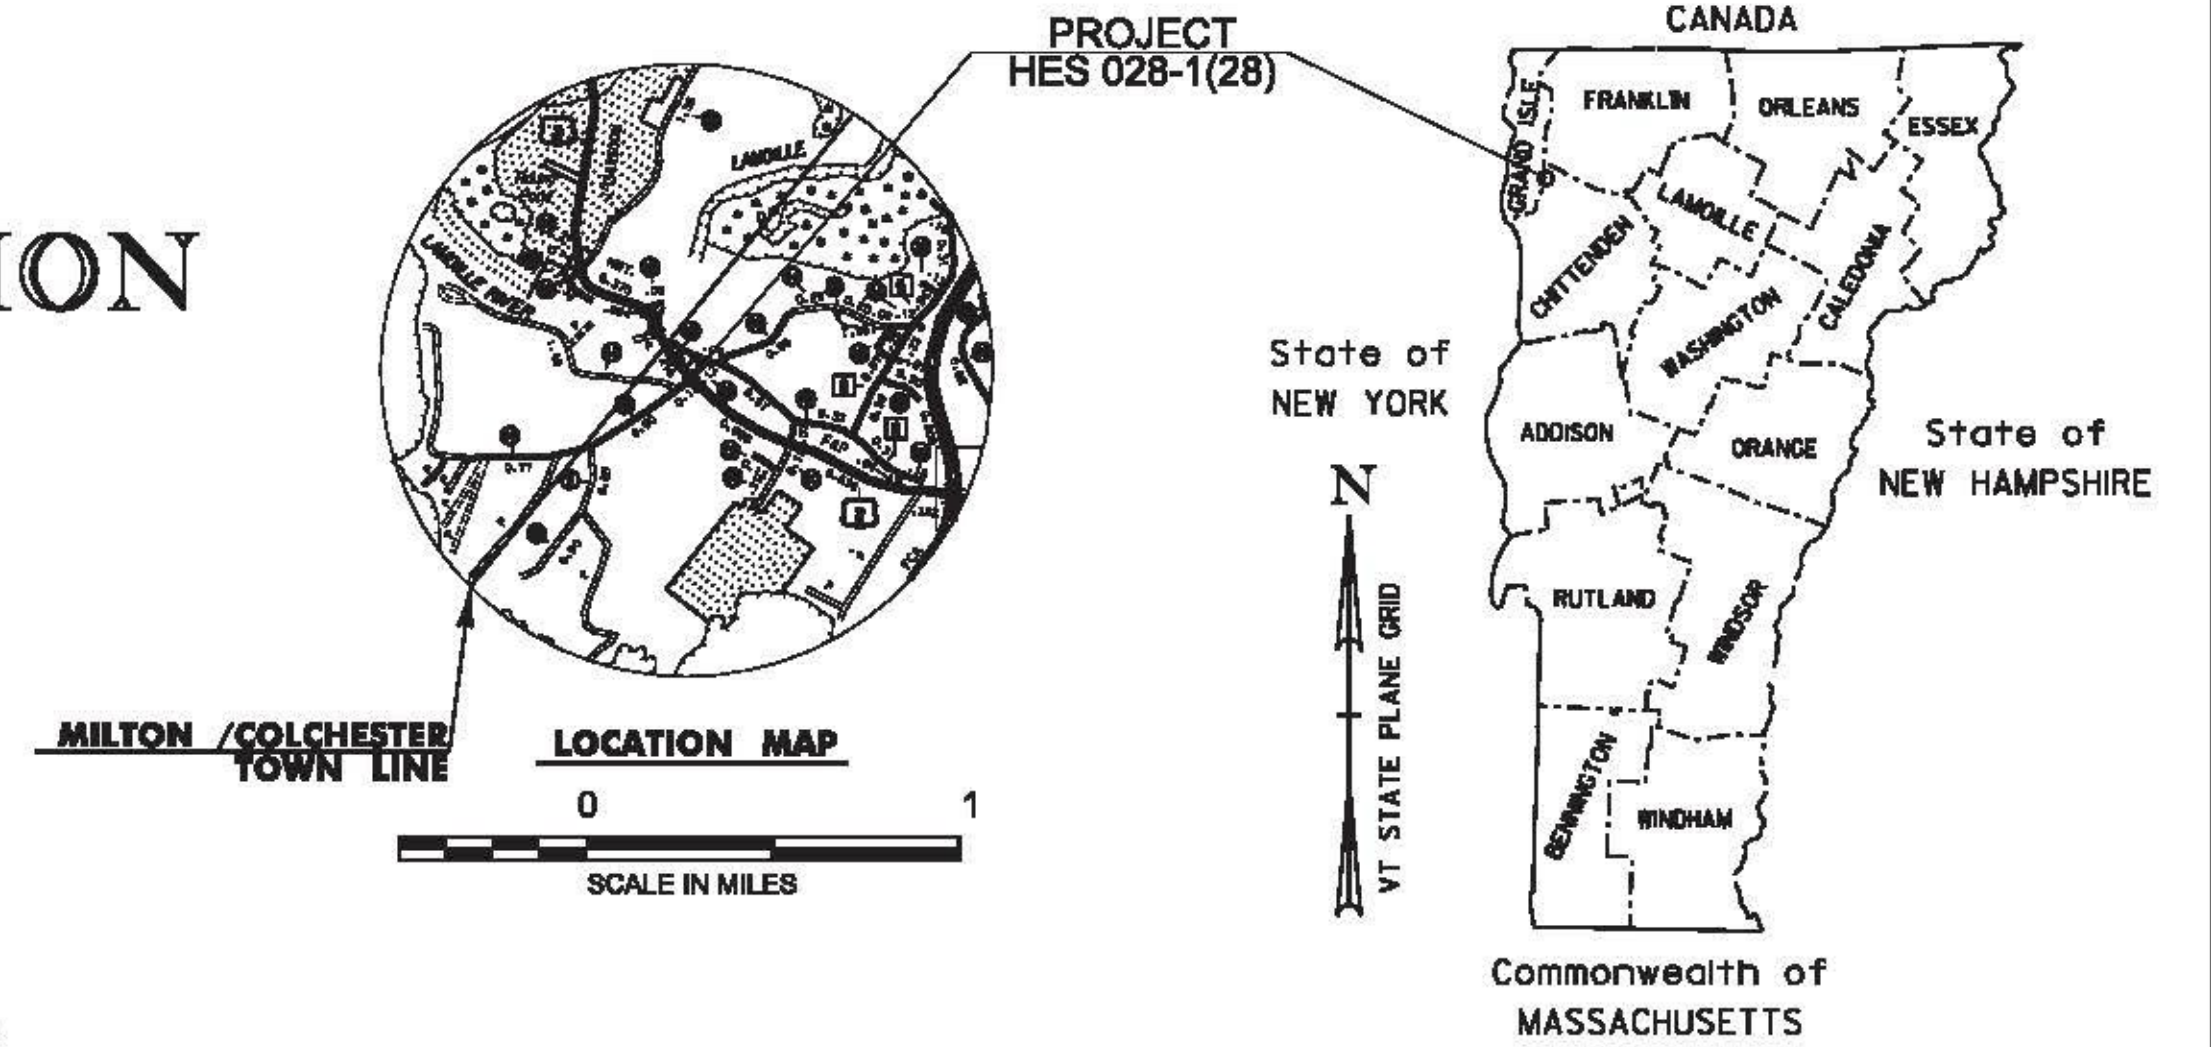


STATE OF VERMONT AGENCY OF TRANSPORTATION

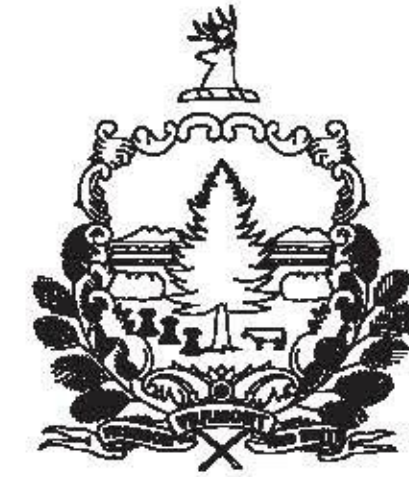

PROPOSED IMPROVEMENT TOWN OF COLCHESTER COUNTY OF CHITTENDEN US ROUTE 2 - (MINOR ARTERIAL)

BEGINNING IN THE TOWN OF COLCHESTER ON US ROUTE 2 AT STATION 12+82.04 (MM 0.243) EXTENDING
EASTERLY 0.347 MILES TO STATION 31+11.91 (MM 0.589).

TOTAL LENGTH OF PROJECT = 1829.87 FT = 0.347 MI

WORK TO BE PERFORMED UNDER THIS PROJECT INCLUDES THE CONSTRUCTION OF LEFT HAND TURN LANES,
PAVEMENT MARKINGS, TRAFFIC SIGNS, AND OTHER HIGHWAY RELATED ITEMS.

