
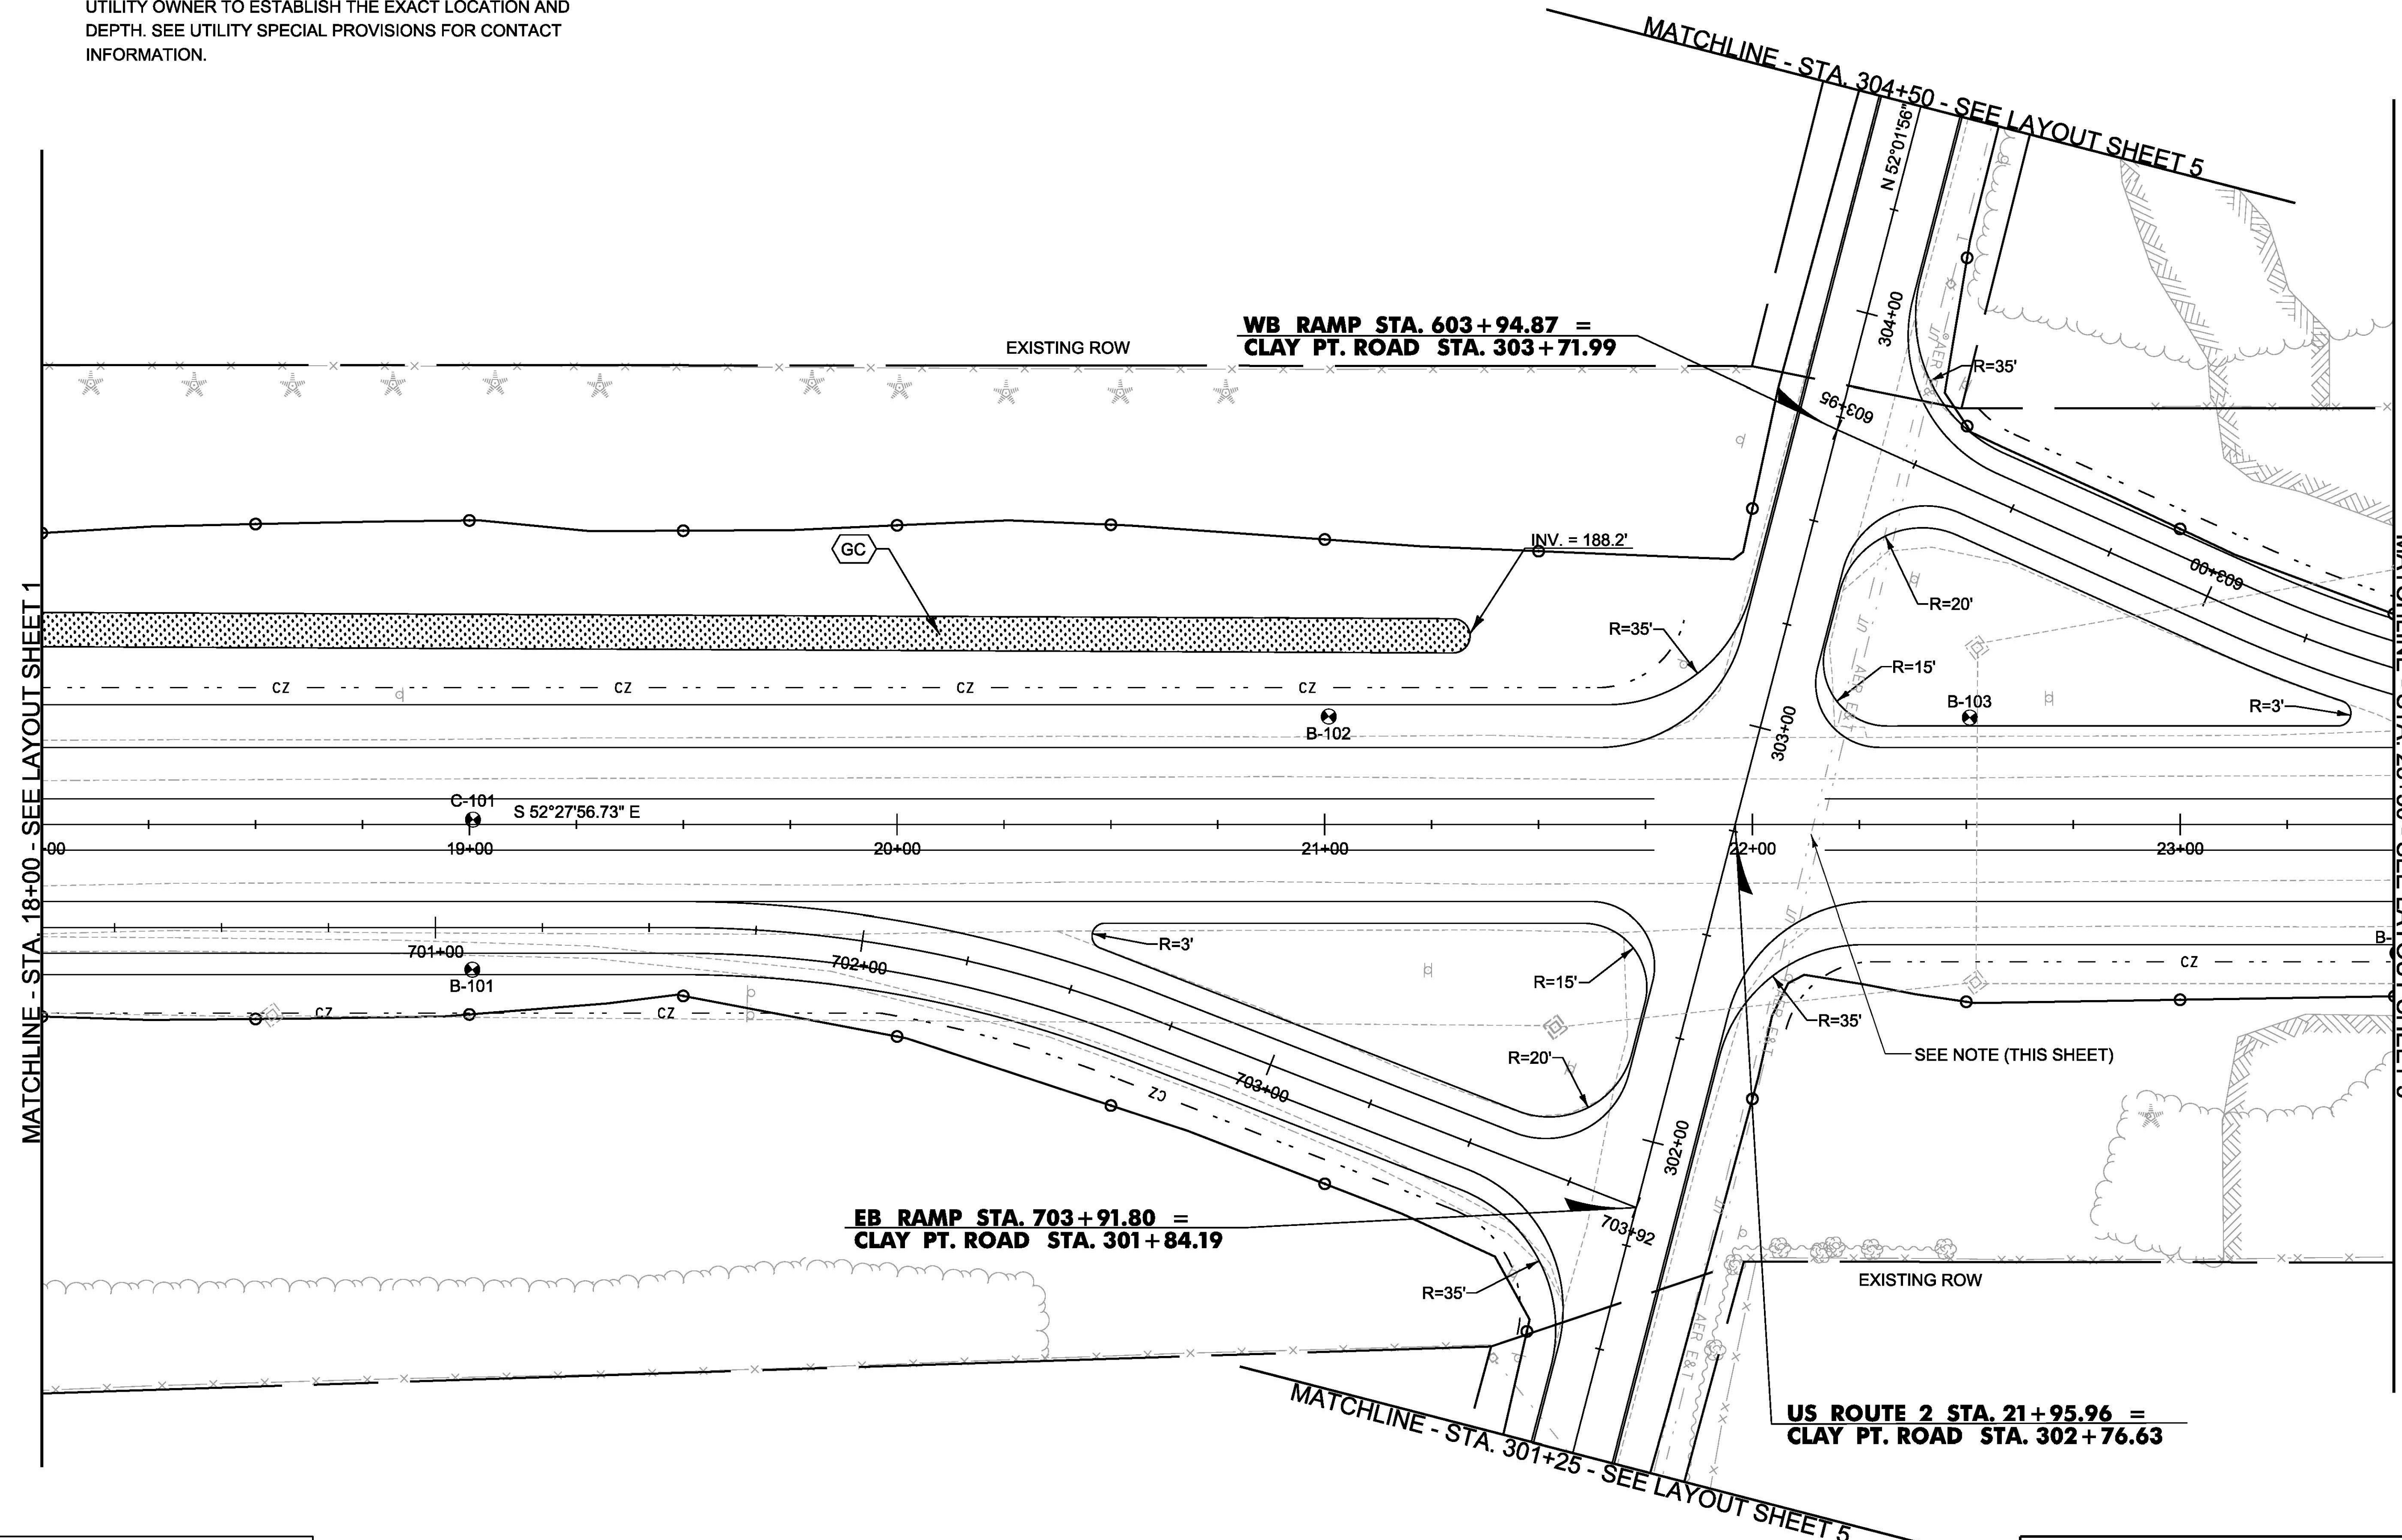


NOTE: THE CONTRACTOR SHALL USE EXTREME CAUTION TO AVOID IMPACT TO UNDERGROUND UTILITY LINE DURING CONSTRUCTION. THE CONTRACTOR SHALL CONTACT THE UTILITY OWNER TO ESTABLISH THE EXACT LOCATION AND DEPTH. SEE UTILITY SPECIAL PROVISIONS FOR CONTACT INFORMATION.

GC STA. 18+00.00, LT - STA. 21+33.96, LT
 CONSTRUCT 339' GRASS CHANNEL
 AVERAGE LONGITUDINAL SLOPE = 1.0%

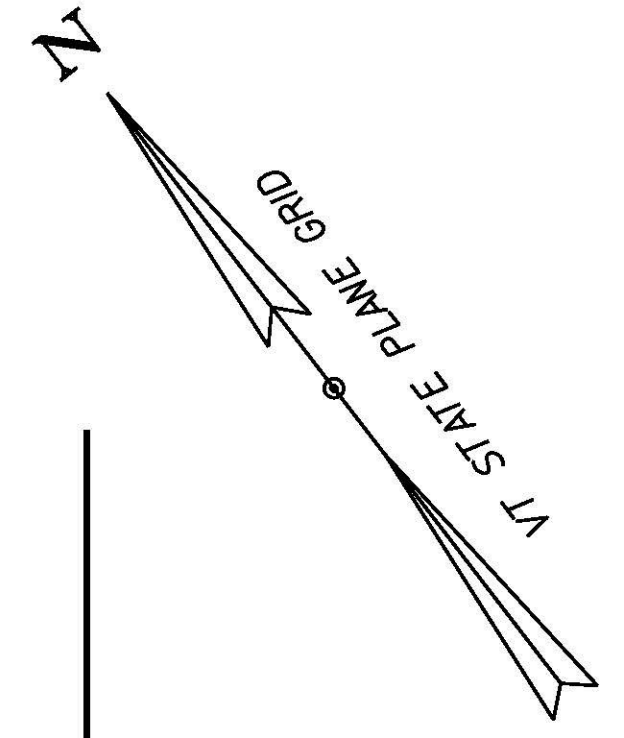

MATCHLINE - STA. 18+00 - SEE LAYOUT SHEET 1

MATCHLINE - STA. 23+50 - SEE LAYOUT SHEET 3

MATCHLINE - STA. 304+50 - SEE LAYOUT SHEET 5

MATCHLINE - STA. 301+25 - SEE LAYOUT SHEET 5

LEGEND

GRASS CHANNEL =



PROJECT NAME: COLCHESTER	PLOT DATE: 11/23/2015
PROJECT NUMBER: HES 028-1(28)	DRAWN BY: M. BOGACZYK
FILE NAME: t13b028nu1.dgn	CHECKED BY: M. LACROIX
PROJECT LEADER: P. COBURN	SHEET 28 OF 91
DESIGNED BY: M. BOGACZYK	
LAYOUT SHEET 2	