


**US ROUTE 2 STA. 26+01.95, 24.0 LT =  
US ROUTE 2 WB RAMP STA. 600+00.00**

**STA. 27+81.95**

**LEGEND**

GRASS CHANNEL = 

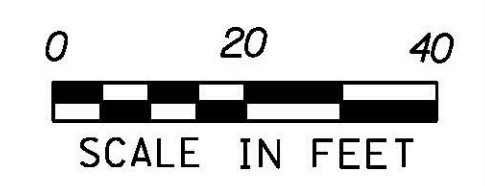

PROJECT NAME: COLCHESTER	PLOT DATE: 11/23/2015
PROJECT NUMBER: HES 028-1(28)	DRAWN BY: M. BOGACZYK
FILE NAME: t13b028nu1.dgn	CHECKED BY: M. LACROIX
PROJECT LEADER: P. COBURN	SHEET 29 OF 91
DESIGNED BY: M. BOGACZYK	
LAYOUT SHEET 3	