
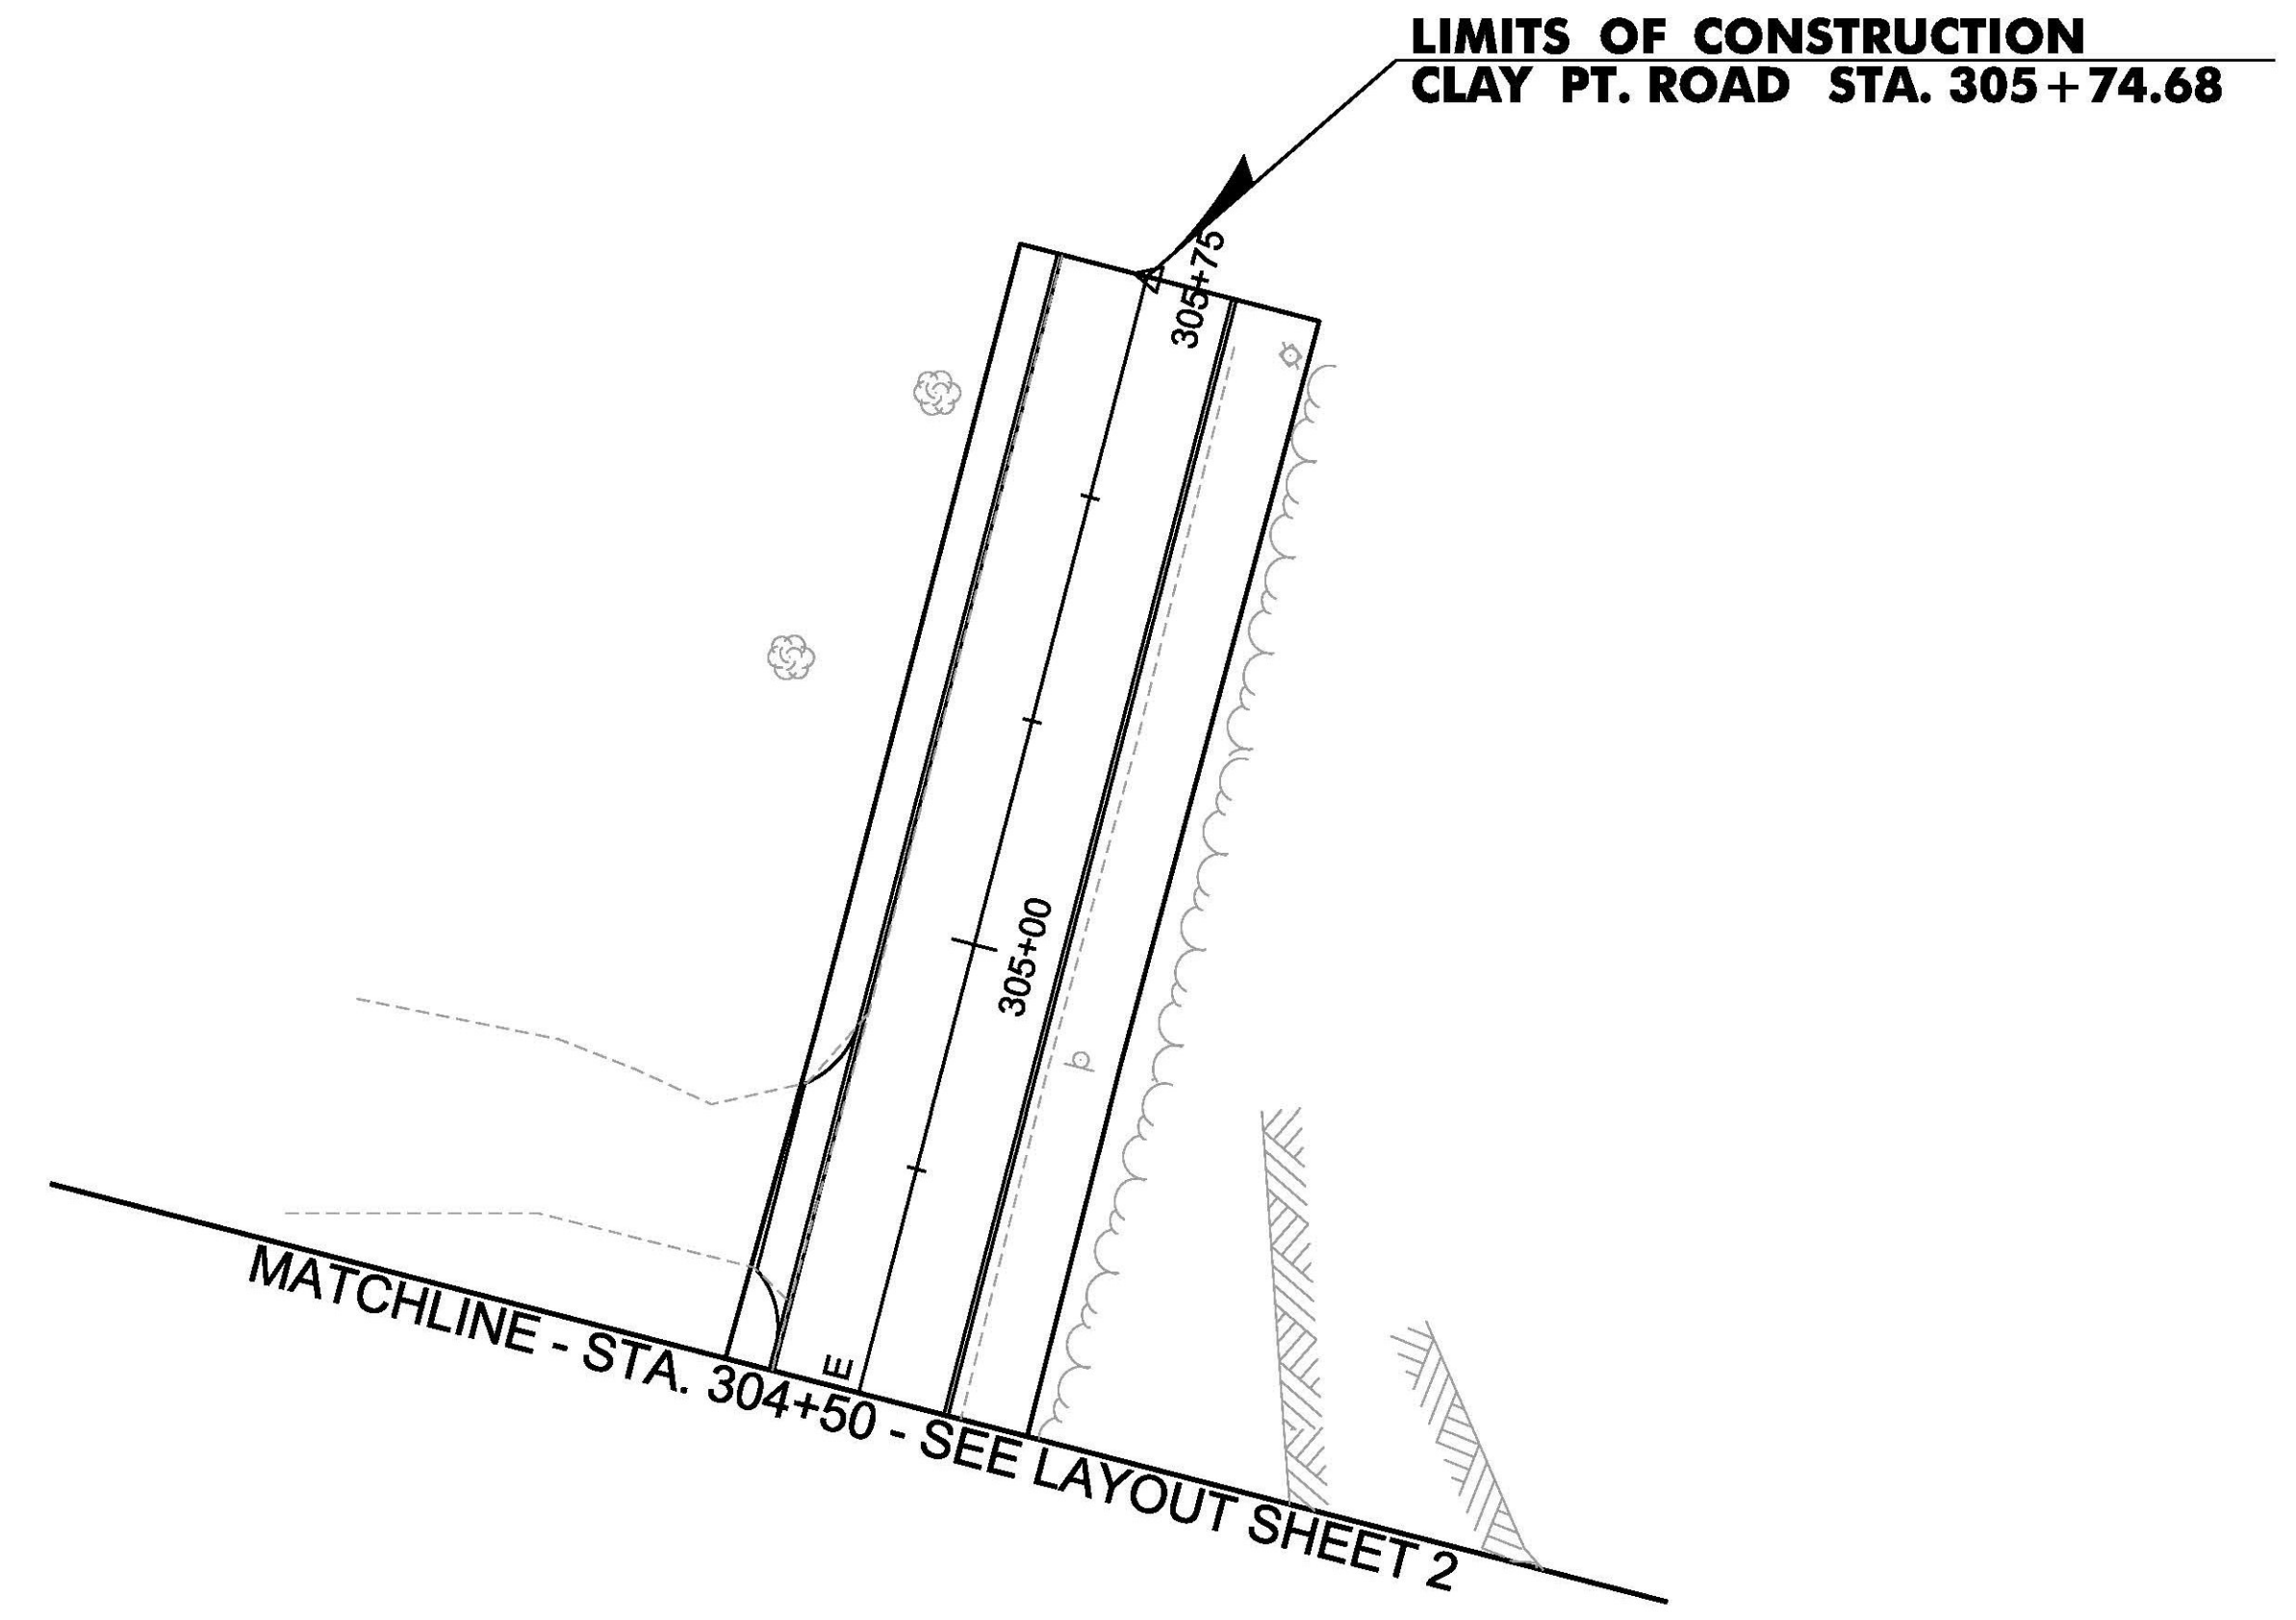
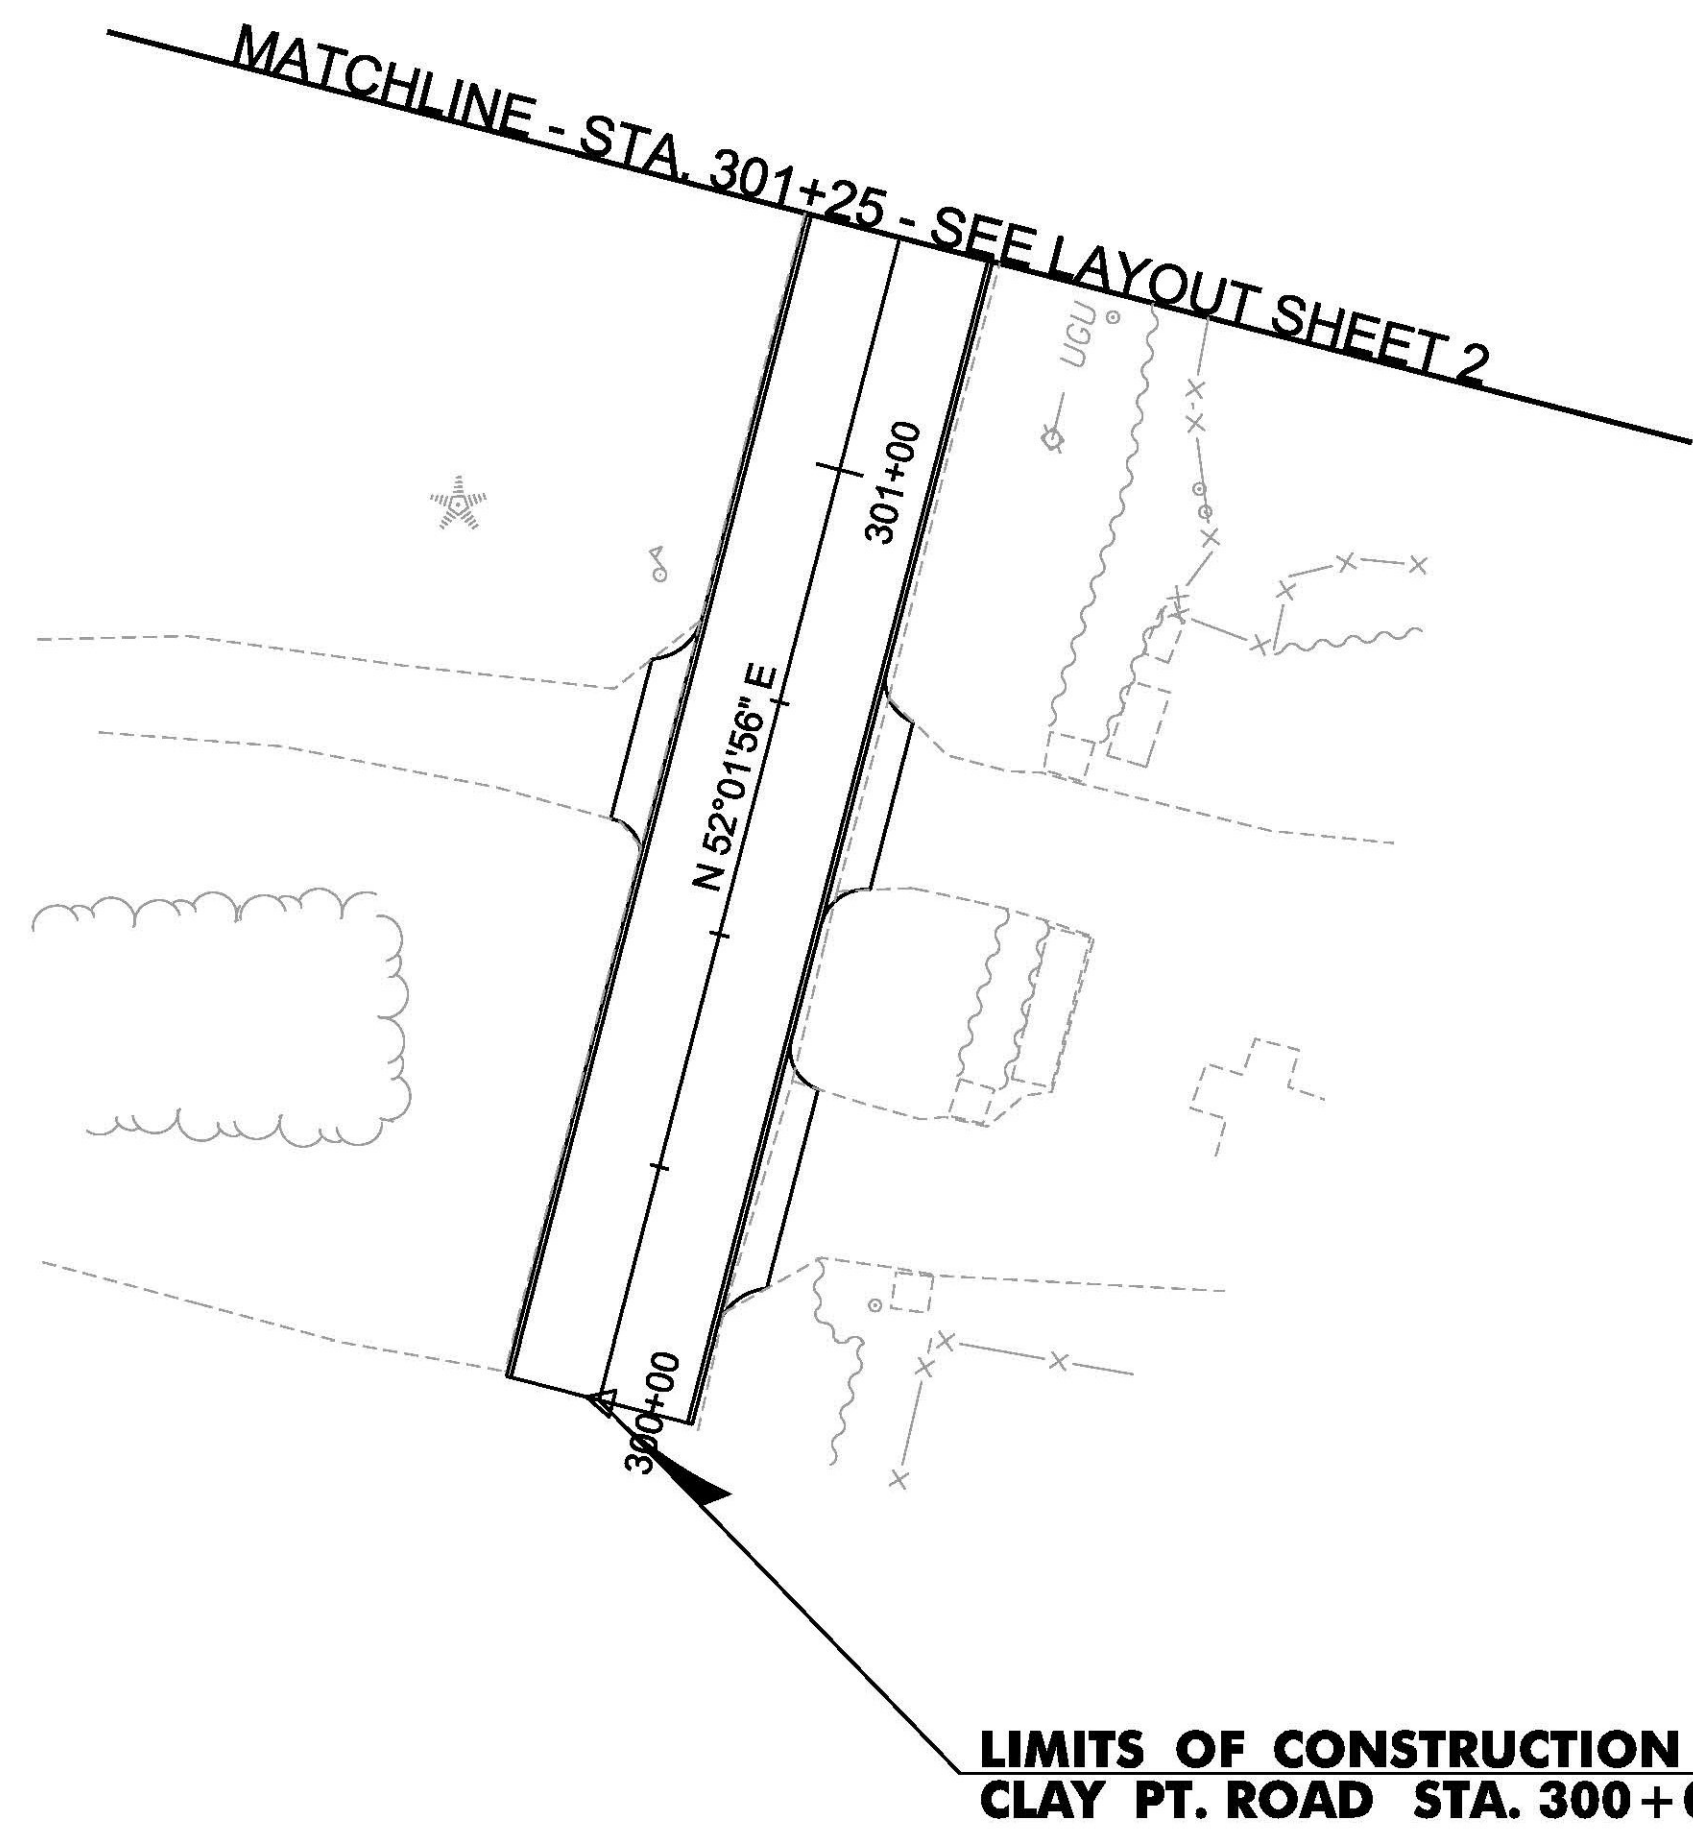


SPECIAL PROVISION
(HAND-PLACED BITUMINOUS CONCRETE MATERIAL, DRIVES)

STA. 300+25.00, RT STA. 300+65.00, RT
STA. 300+70.00, LT STA. 304+75.00, LT

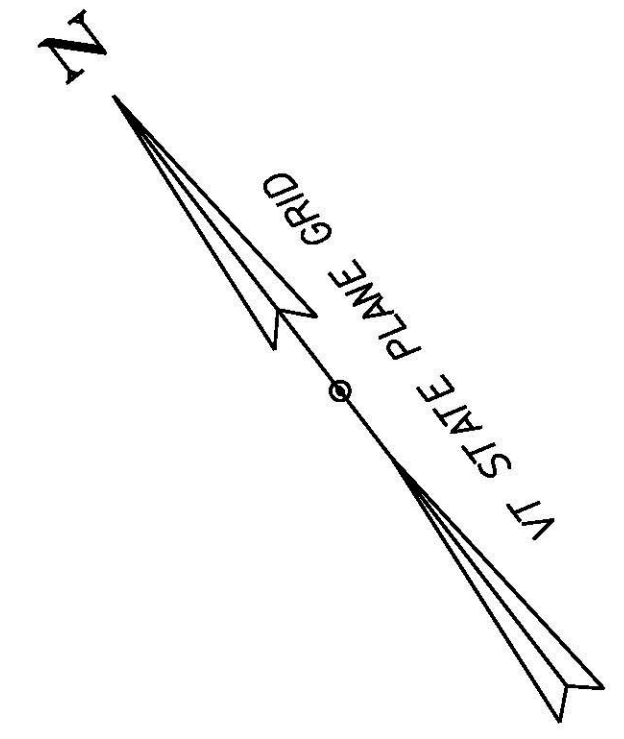

LEGEND

GRASS CHANNEL =



PROJECT NAME: COLCHESTER	PLOT DATE: 11/23/2015
PROJECT NUMBER: HES 028-1(28)	DRAWN BY: M. BOGACZYK
FILE NAME: t13b028nvl.dgn	CHECKED BY: M. LACROIX
PROJECT LEADER: P. COBURN	SHEET 31 OF 91
DESIGNED BY: M. BOGACZYK	
LAYOUT SHEET 5	