
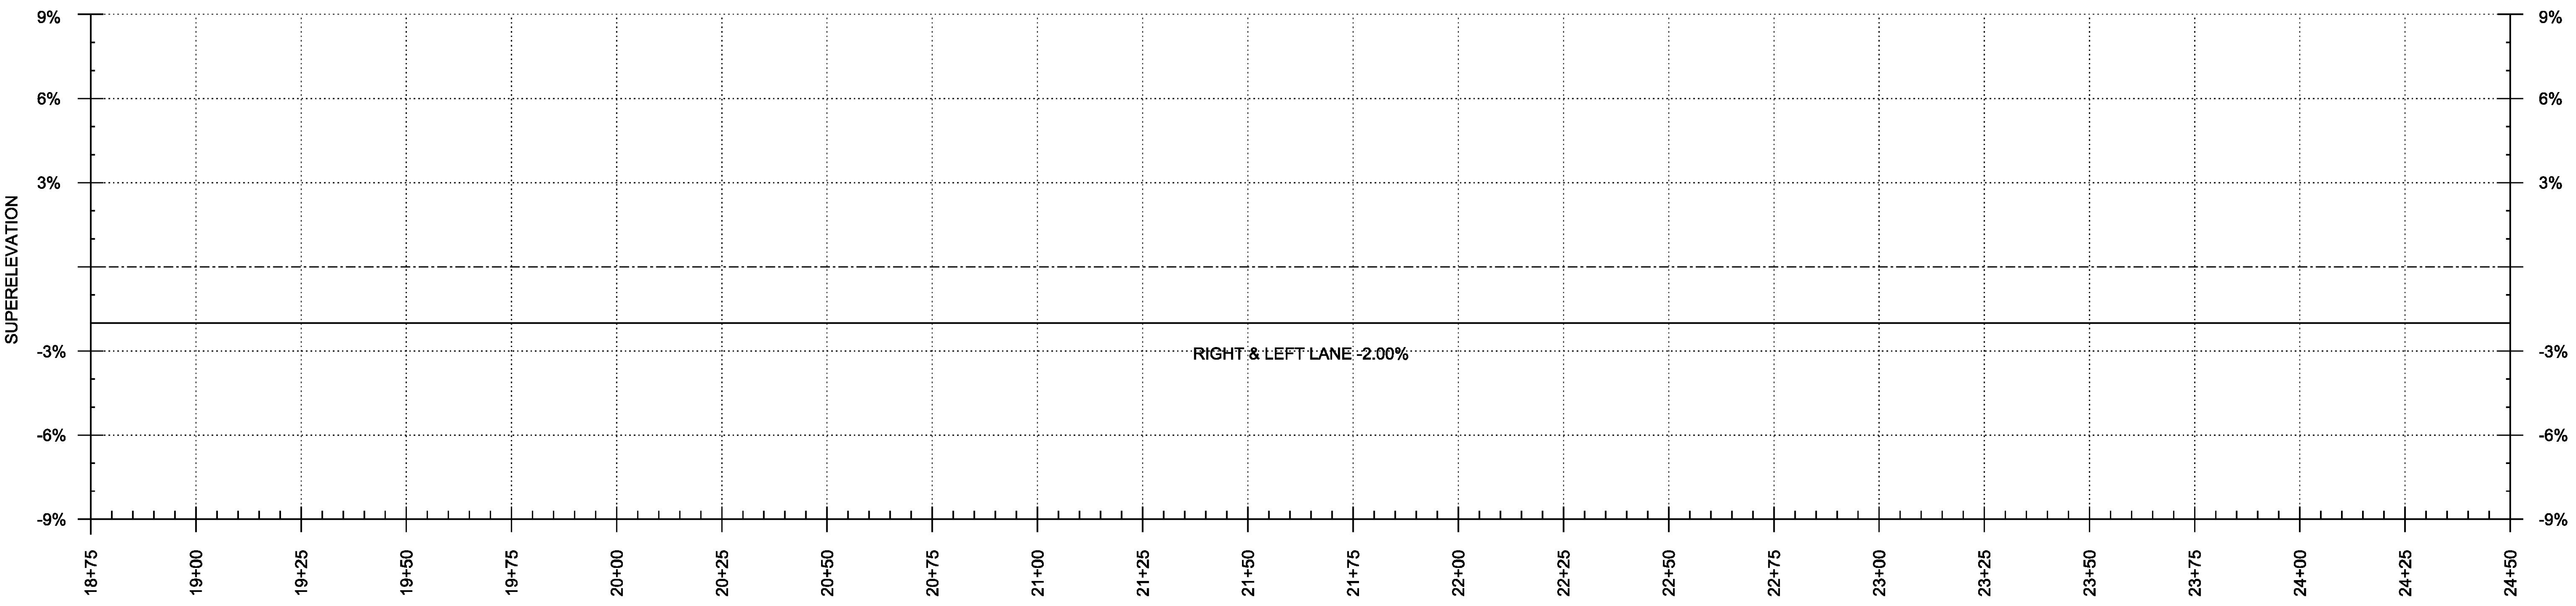


US ROUTE 2

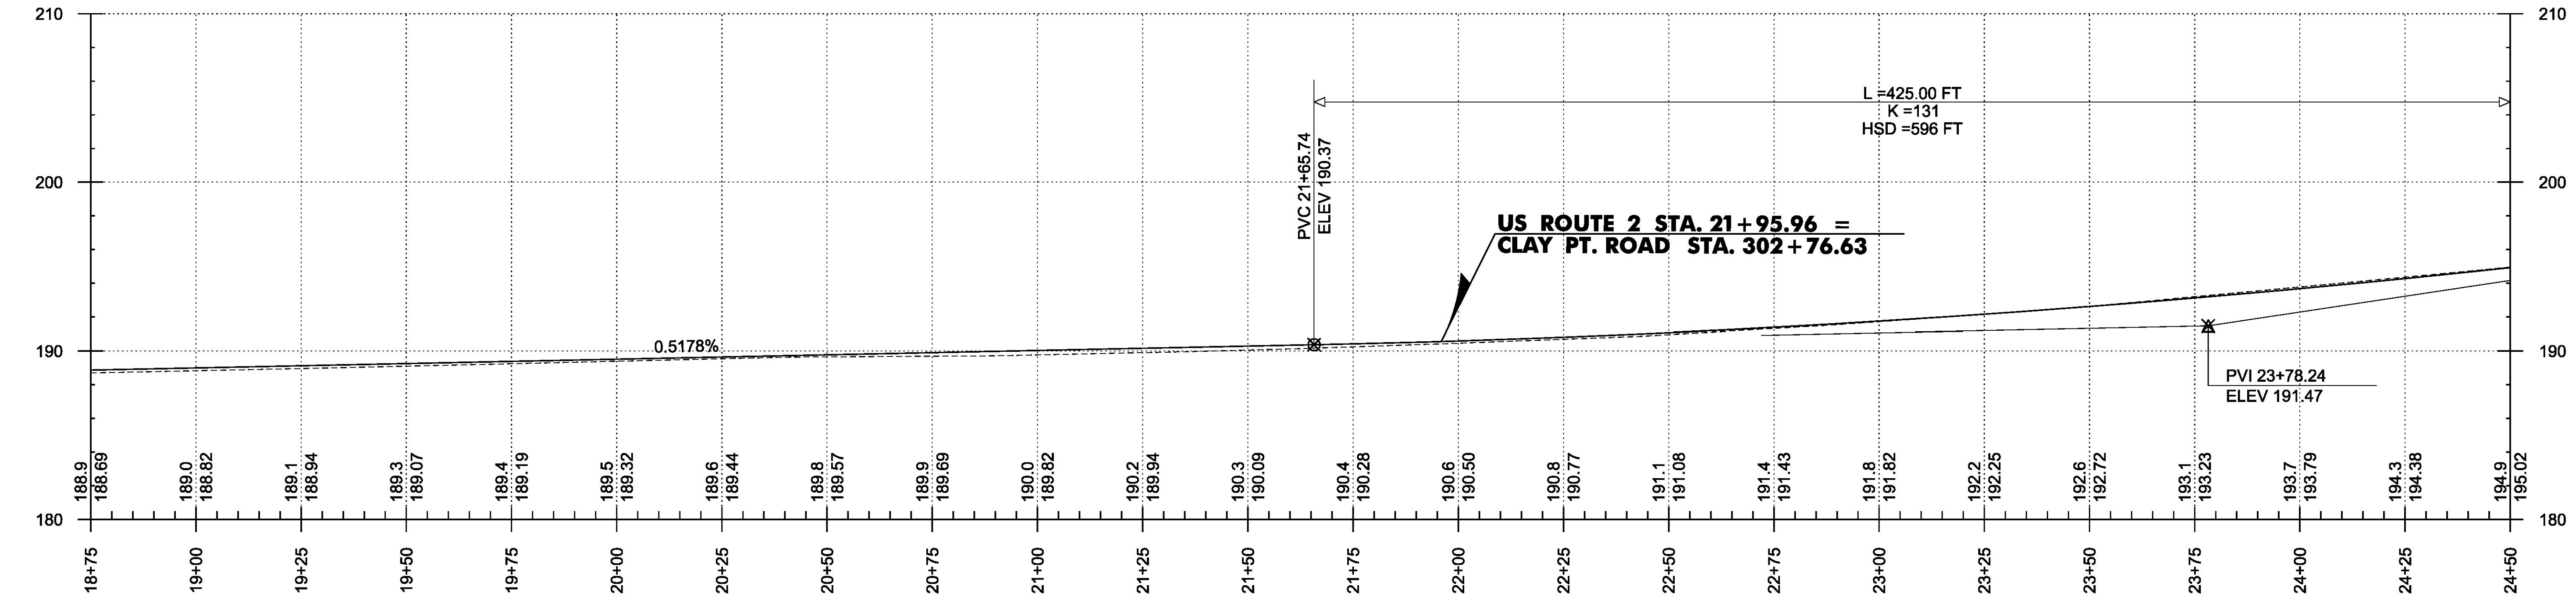

NOTE: ALL STATIONING AND ELEVATIONS IN FEET. GRADES TO ONE TENTH OF A FOOT ARE EXISTING. GRADES TO ONE HUNDRETH OF A FOOT ARE PROPOSED.

PROJECT NAME: COLCHESTER	
PROJECT NUMBER: HES 028-1(28)	
FILE NAME: t13b028pro.dgn	PLOT DATE: 11/23/2015
PROJECT LEADER: P. COBURN	DRAWN BY: M. BOGACZYK
DESIGNED BY: M. BOGACZYK	CHECKED BY: M. LACROIX
ROADWAY PROFILE & BANKING SHEET 2	SHEET 33 OF 91