



# EAST BOUND RAMP

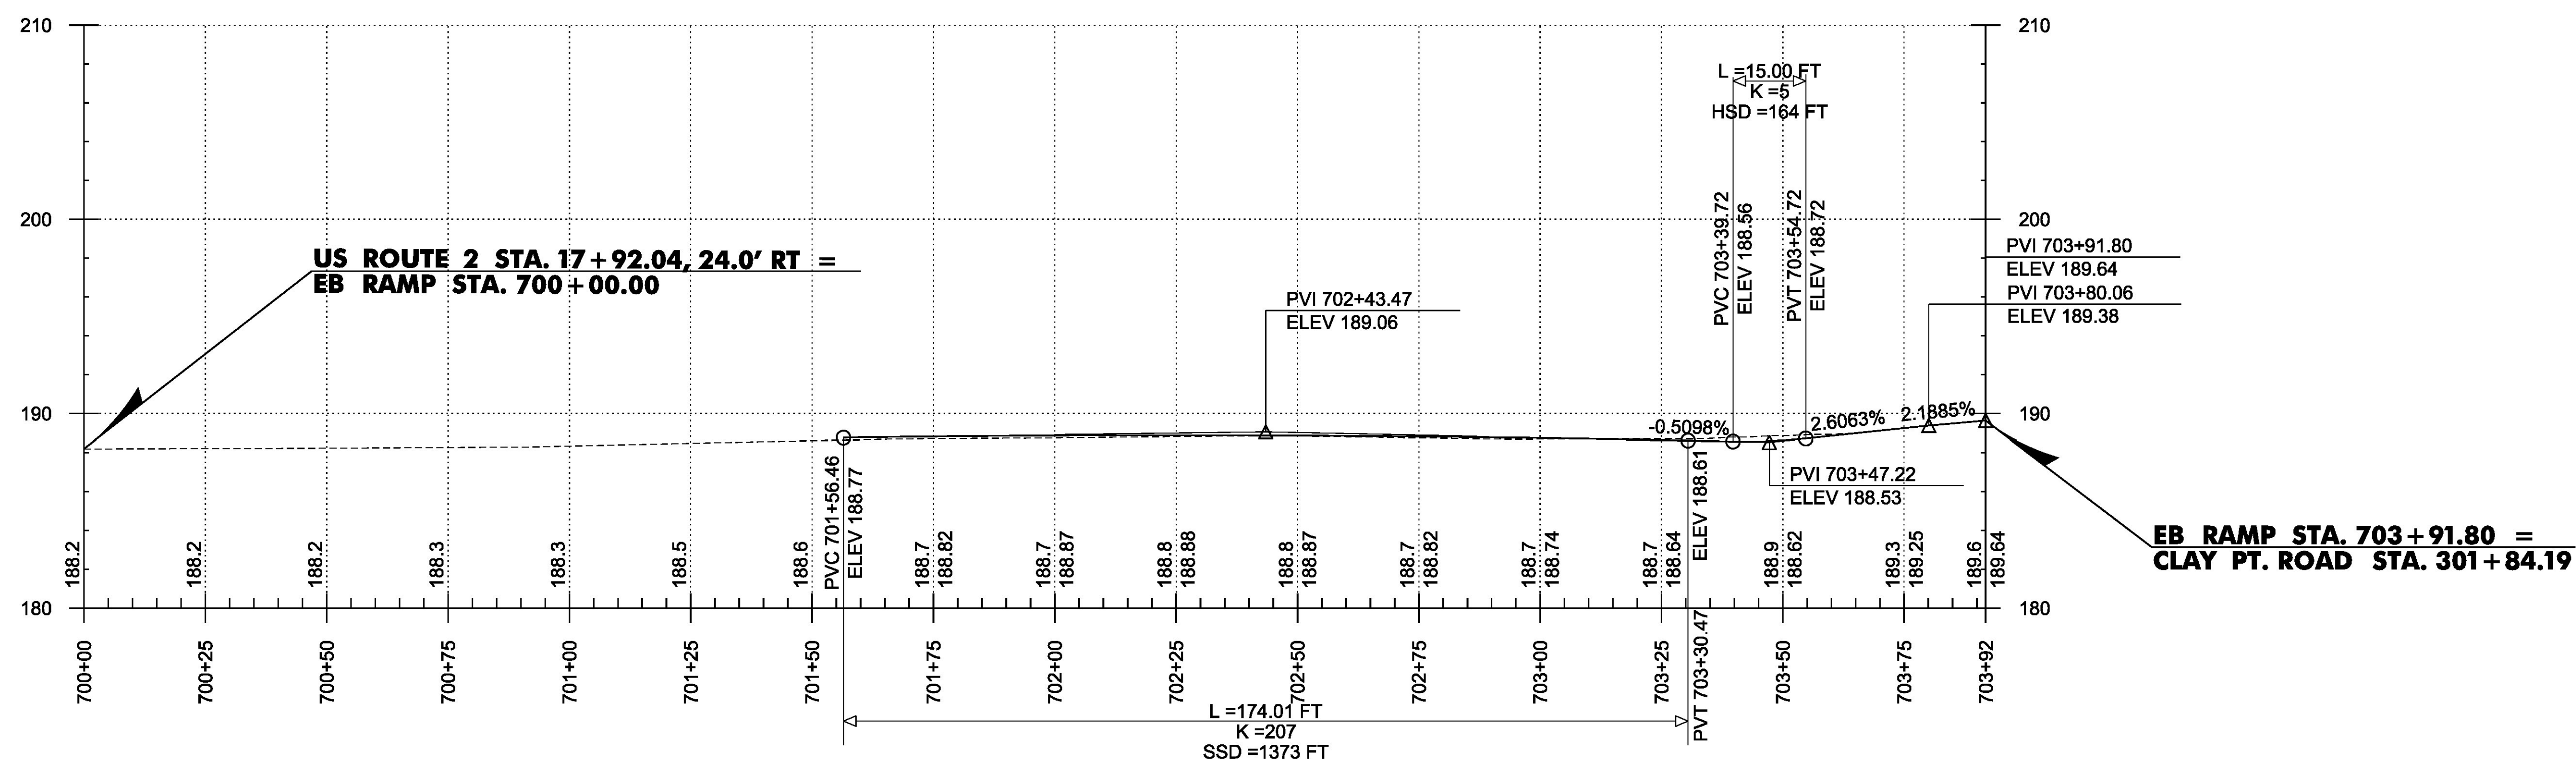

# WEST BOUND RAMP

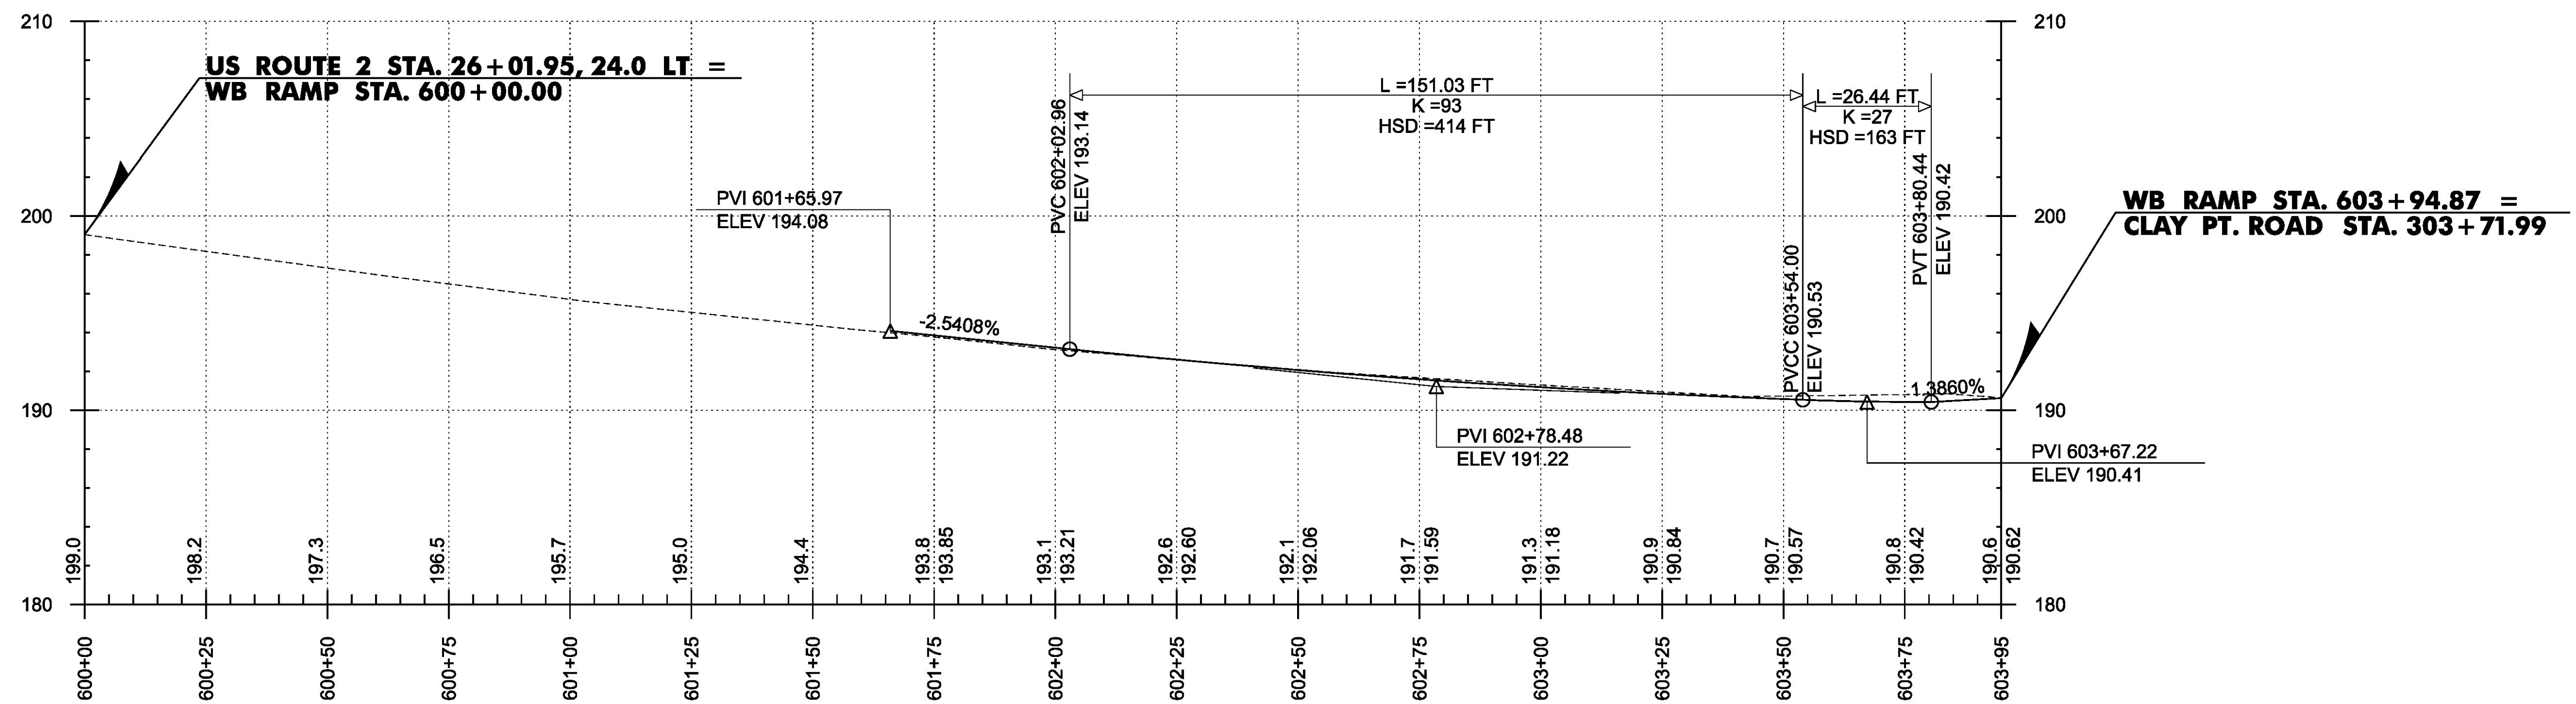

NOTE: ALL STATIONING AND ELEVATIONS IN FEET. GRADES TO ONE TENTH OF A FOOT ARE EXISTING. GRADES TO ONE HUNDRETH OF A FOOT ARE PROPOSED.

PROJECT NAME: COLCHESTER	PLOT DATE: 11/23/2015
PROJECT NUMBER: HES 028-1(28)	DRAWN BY: M. BOGACZYK
FILE NAME: t13b028pro.dgn	CHECKED BY: M. LACROIX
PROJECT LEADER: P. COBURN	DESIGNED BY: M. BOGACZYK
ROADWAY PROFILE & BANKING SHEET 6	SHEET 37 OF 91