

MATCHLINE - STA. 23+50 - SEE EPSC FINAL CONDITIONS SHEET 2

MATCHLINE - STA. 28+75 - SEE EPSC FINAL CONDITIONS SHEET 4

FARMINGTON EXTREMELY ROCKY
LOAM, 5 TO 20 PERCENT SLOPES
HYDRO. SOIL GROUP D
K = 0.32


FARMINGTON EXTREMELY ROCKY
LOAM, 20 TO 60 PERCENT SLOPES
HYDRO. SOIL GROUP D
K = 0.32

**US ROUTE 2 STA. 26+01.95, 24.0 LT =
US ROUTE 2 WB RAMP STA. 600+00.00**

FARMINGTON EXTREMELY ROCKY
LOAM, 20 TO 60 PERCENT SLOPES
HYDRO. SOIL GROUP D
K = 0.32

SCANTIC SILT LOAM,
2 TO 6 PERCENT SLOPES
HYDRO. SOIL GROUP D
K = 0.32

LEGEND	
	LIMITS OF CONSTRUCTION
	DISTURBED AREA REQUIRED RE-VEGETATION

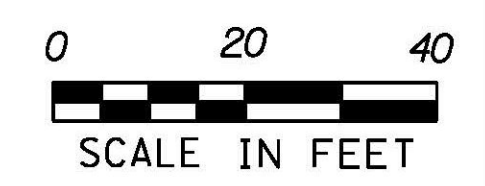

PROJECT NAME: COLCHESTER	PLOT DATE: 11/23/2015
PROJECT NUMBER: HES 028-1(28)	DRAWN BY: M. BOGACZYK
FILE NAME: t13b028ero.dgn	CHECKED BY: M. LACROIX
PROJECT LEADER: P. COBURN	SHEET 54 OF 91
DESIGNED BY: M. BOGACZYK	
EPSC FINAL CONDITIONS SHEET 3	