


ADAMS AND WINDSOR LOAMY SANDS,
 0 TO 5 PERCENT SLOPES
 HYRDO. SOIL GROUP A
 K = 0.17


MATCHLINE - STA. 301+25 - SEE EPSC FINAL CONDITIONS SHEET 2

ADAMS AND WINDSOR LOAMY SANDS,
 0 TO 5 PERCENT SLOPES
 HYRDO. SOIL GROUP A
 K = 0.17

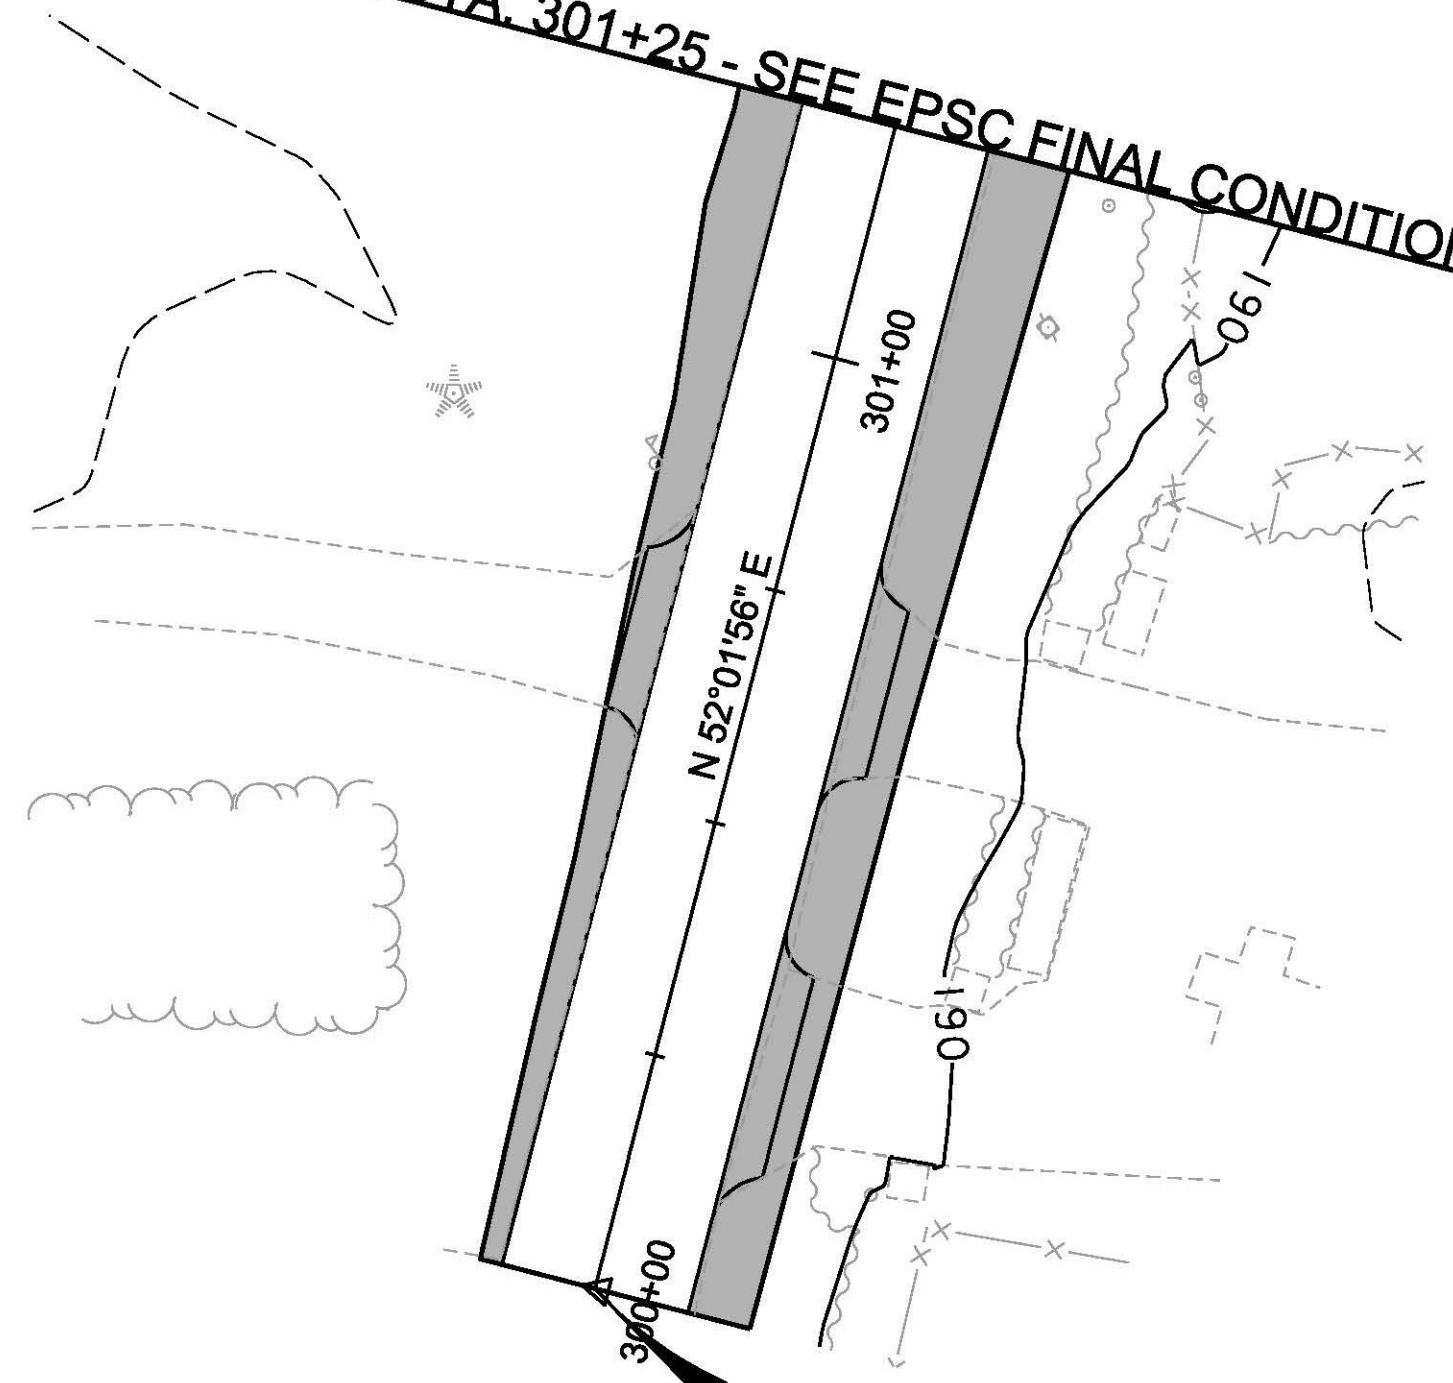

LIMITS OF CONSTRUCTION
 CLAY PT. ROAD STA. 300+00.00


LIMITS OF CONSTRUCTION
 CLAY PT. ROAD STA. 305+74.68

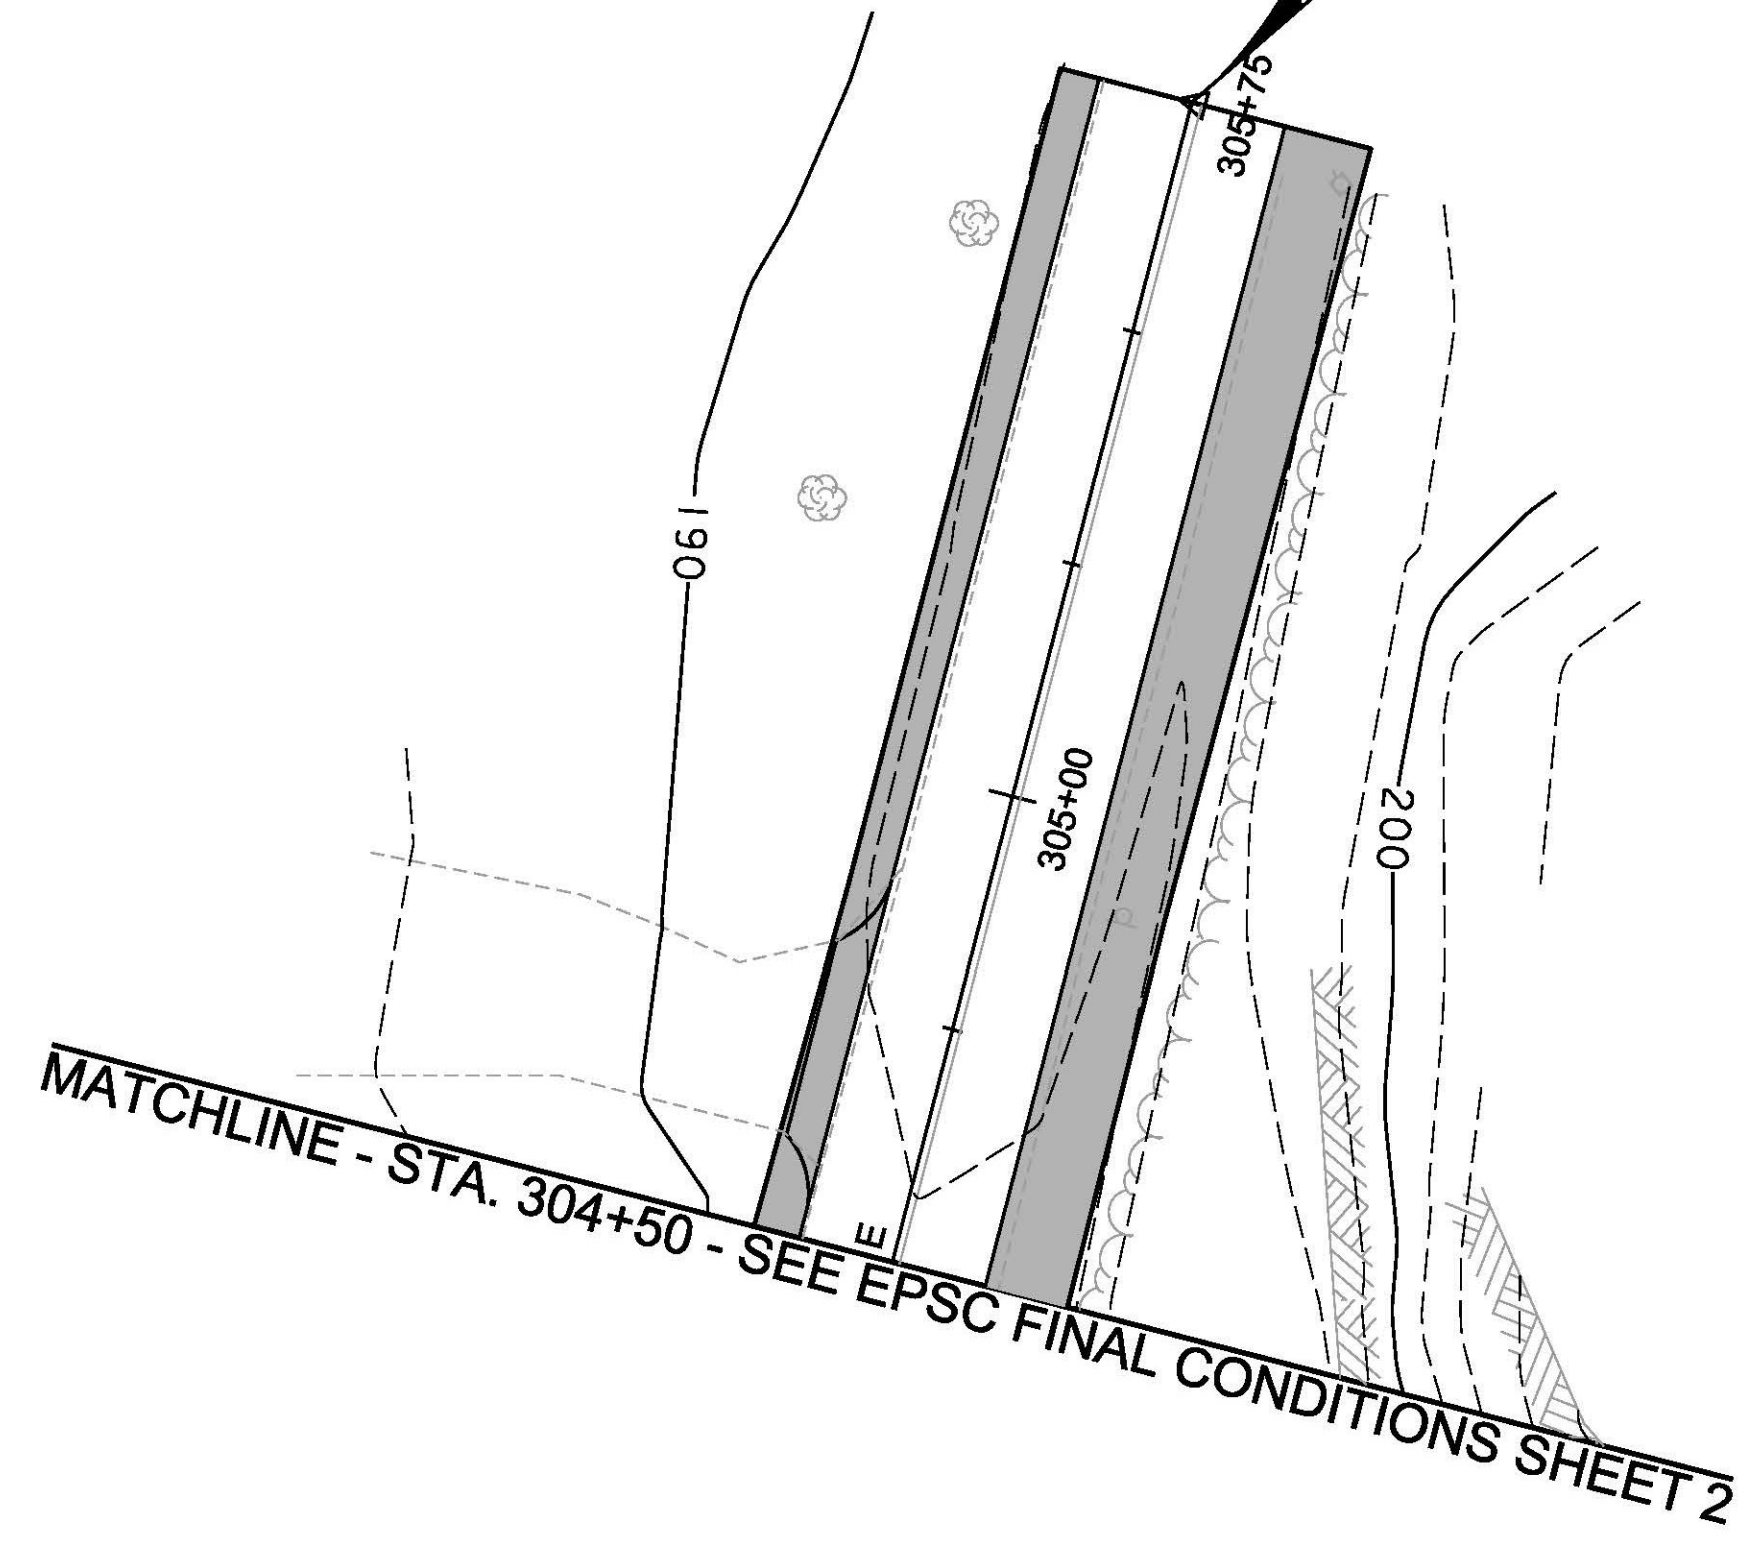

MATCHLINE - STA. 304+50 - SEE EPSC FINAL CONDITIONS SHEET 2

LEGEND

- LIMITS OF CONSTRUCTION
- DISTURBED AREA
REQUIRED RE-VEGETATION

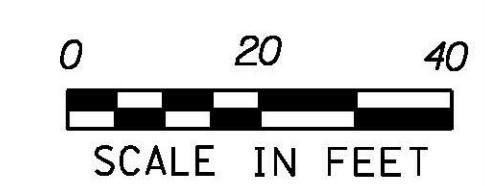

PROJECT NAME: COLCHESTER	PLOT DATE: 11/23/2015
PROJECT NUMBER: HES 028-1(28)	DRAWN BY: M. BOGACZYK
FILE NAME: t13b028ero.dgn	DESIGNED BY: M. BOGACZYK
PROJECT LEADER: P. COBURN	EPSC FINAL CONDITIONS SHEET 5
CHECKED BY: M. LACROIX	SHEET 56 OF 91